
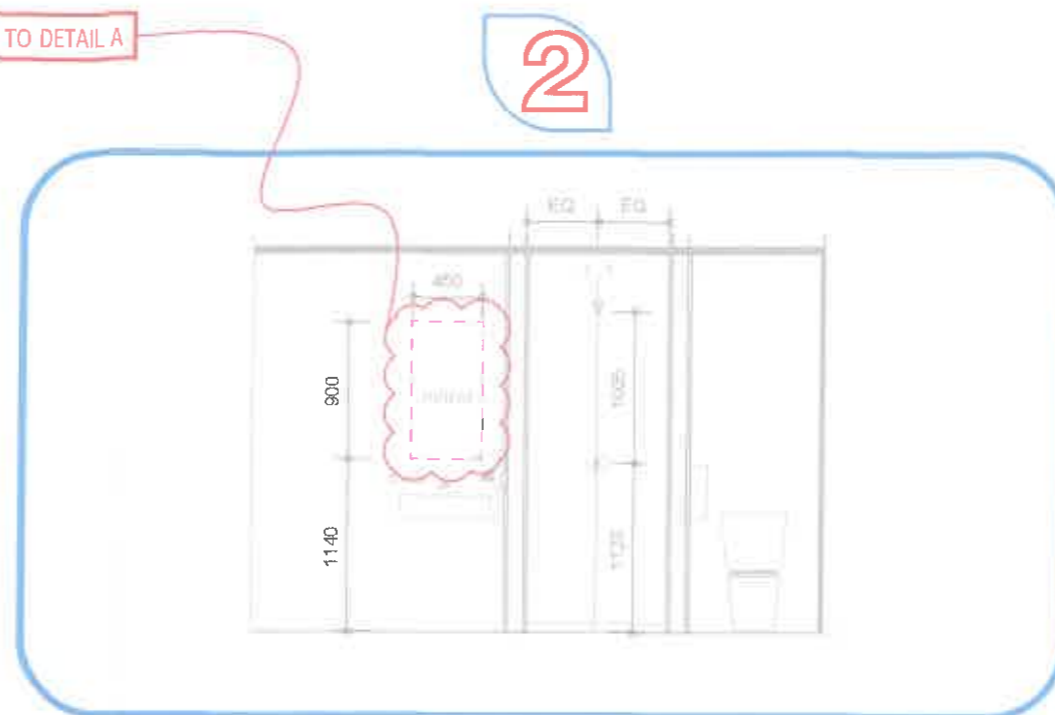


LIGHTING LEGEND


LEGEND	CODE	PHOTO
---	LED STRIP	
LAMP SPEC	COLOUR	
14.4W LED	WARM WHITE	
TYPE	IP RATING	
3000K	IP20	

GENERAL NOTES


20A SINGLE PHASE ISOLATOR @ INDICATED POSITION

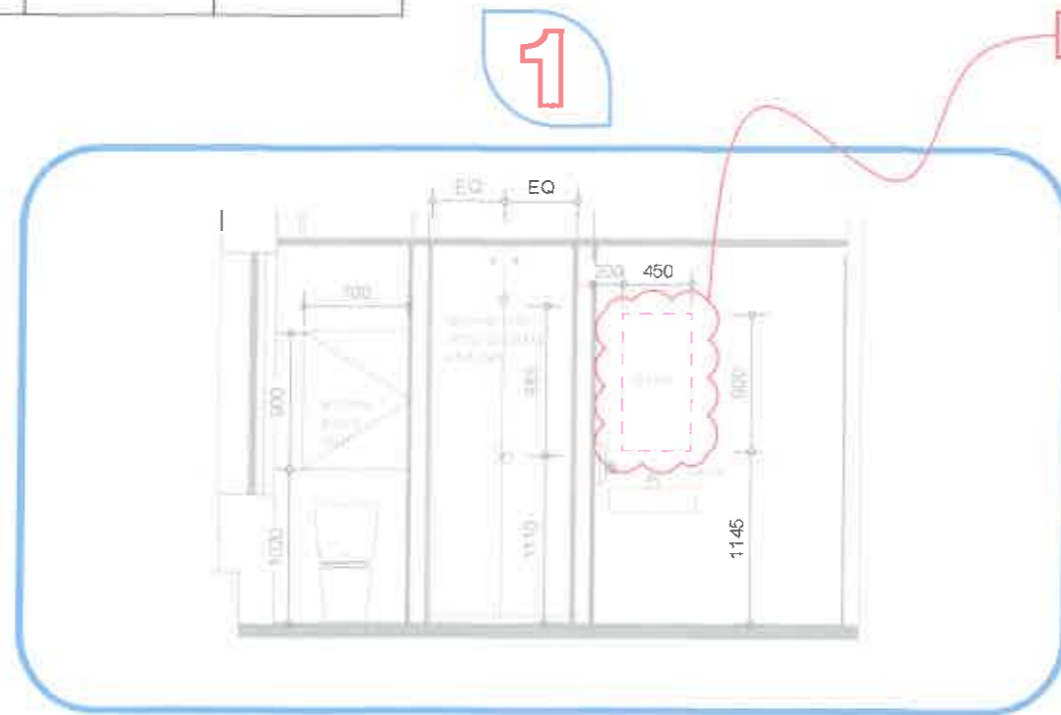

REFER TO DETAIL A

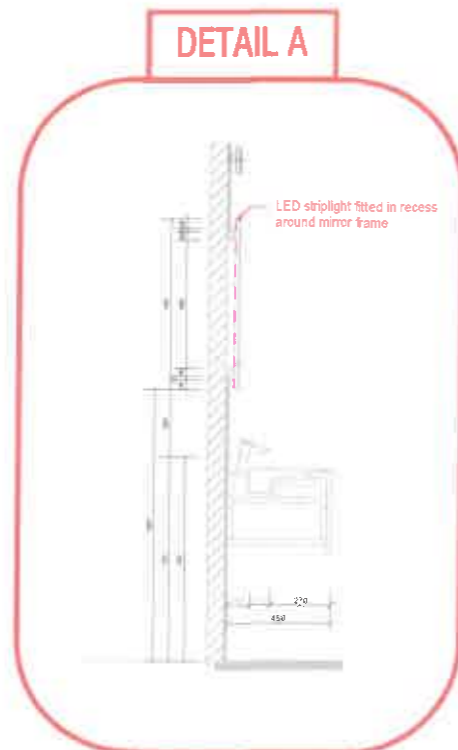


NOT TO SCALE

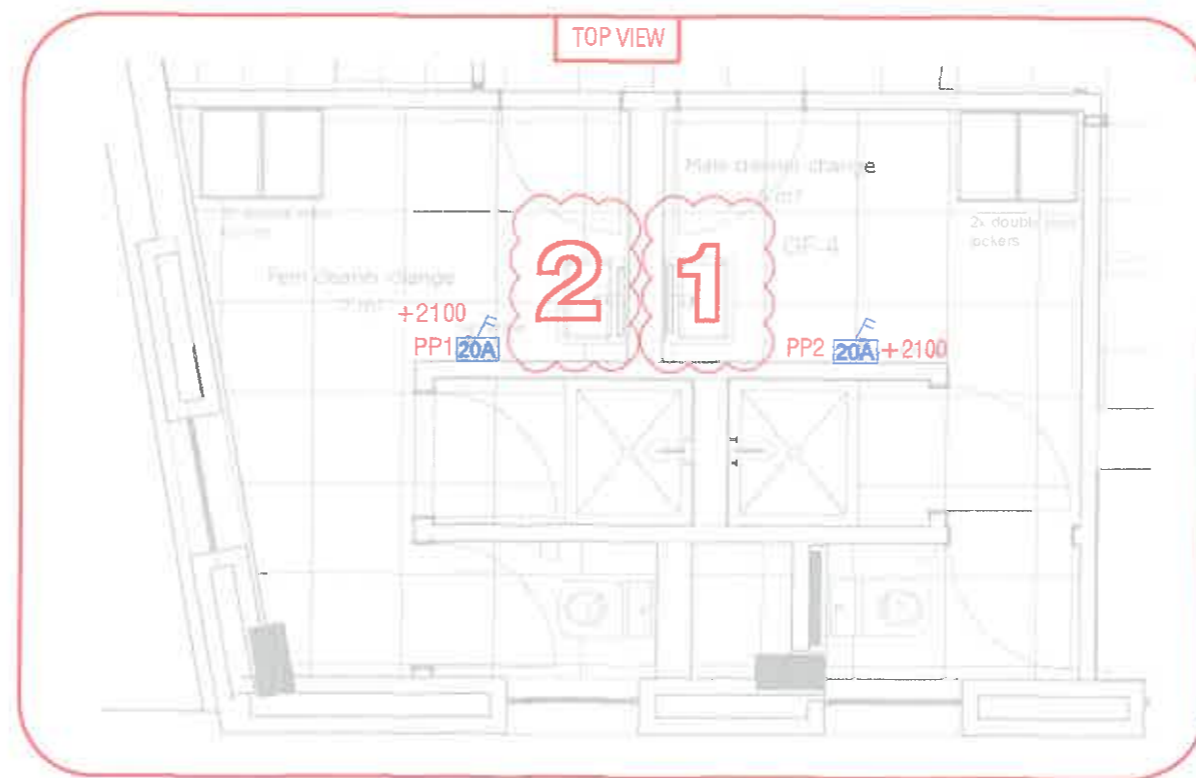

SMALL POWER LAYOUT

INGPLAN PRET. N/A
P.O. BOX 35555
MENLOPARK 0102

FIRST DRAWING ISSUE:	2017 - 08 - 28
PRELIMINARY	<input type="checkbox"/>
TENDERS	<input type="checkbox"/>
APPROVAL	<input type="checkbox"/>
CONSTRUCTION	<input type="checkbox"/>
COORDINATION	<input type="checkbox"/>
AS BUILT	<input checked="" type="checkbox"/>

COPYRIGHT IS VESTED IN THIS DRAWING AND NO USE, REPRODUCTION OR DUPLICATION HEREOF MAY OCCUR WITHOUT WRITTEN CONSENT OF INGPLAN GAUTENG (PTY) LTD. 

REVISIONS		
NO.	DESCRIPTION	APPROVED

CLIENT
**HUDSON AVENUE
Pty (Ltd)**


ELECTRICAL DESIGN	CAD DESIGN	APPROVED BY
L. MEIJSEN	W. DE KLERK	E. GENIS




INGPLAN HOUSE, SUITE 1, 462 ON SUSSEX,
CNR LYNWOOD & SUSSEX AVENUE, LYNWOOD, 0381
P.O. BOX 35555 MENLOPARK 0102
TEL: (012) 698-0855
FAX: (012) 698-0856
e-mail: info@ingplan.co.za

PROJECT
**LIBERTAS OFFICE PARK
- BLOCK D-**


DESCRIPTION OF DRAWING
**-GROUND FLOOR CLEANERS
ABLUTIONS-
SMALL POWER & LIGHTING
LAYOUT**

SCALE ON A3 PAPER:	SITE DETAIL:
1:50	EQUESTRIA X 198
ARCHITECT'S DRAWING NO: 1331-2-SANAS SHEET-454 ABLUTIONS DETAILS PLAN	NORTH: 
INGPLAN DRAWING NO: 07P060/BD/E21	INGPLAN'S REVISION NO: AB

TOP VIEW

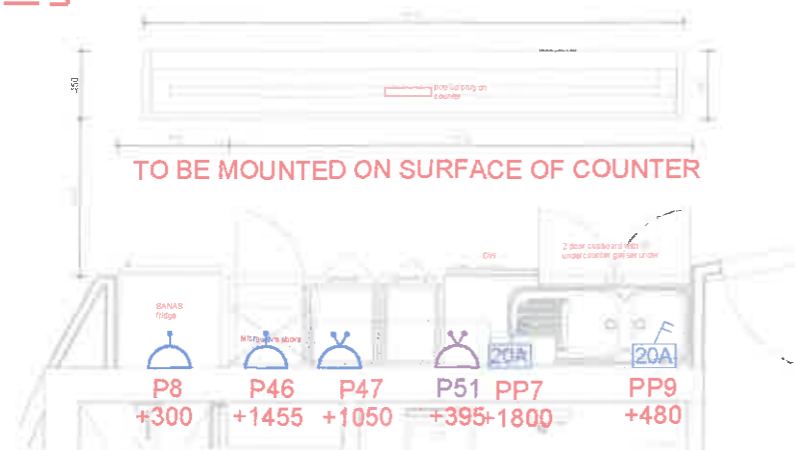


SIDE VIEW

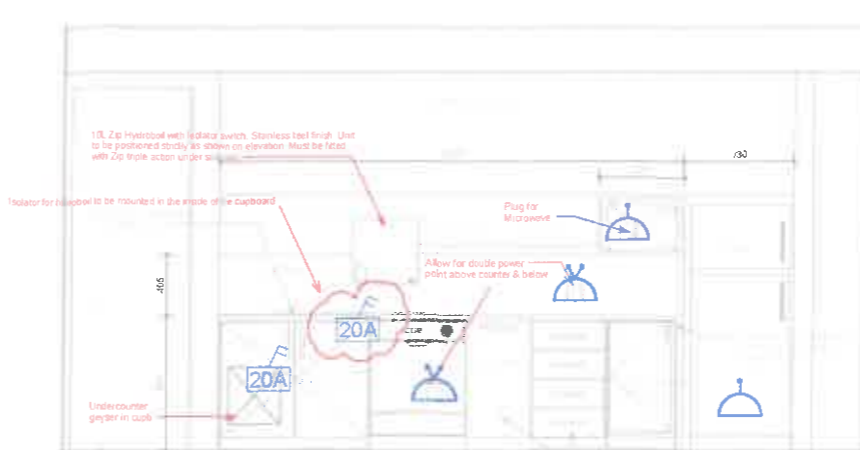


1

TOP VIEW

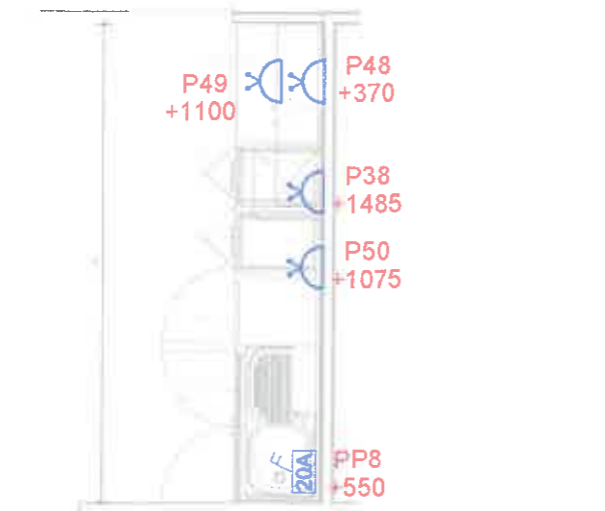


SIDE VIEW

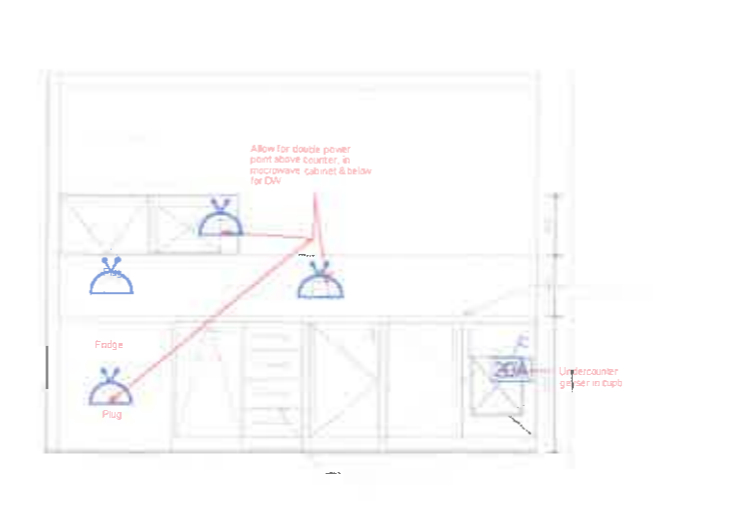

2

TOP VIEW

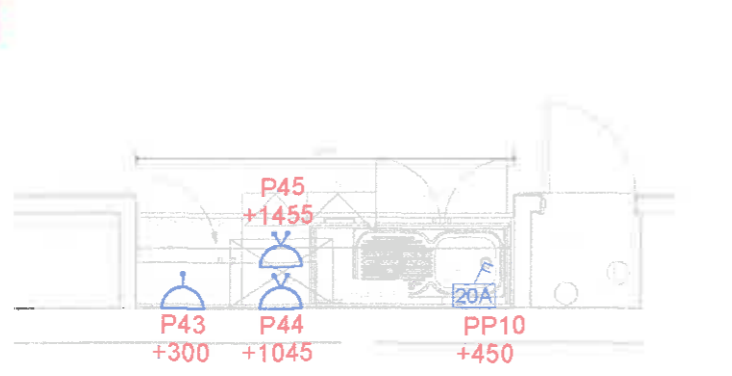

SIDE VIEW



3

INGPLAN PRETORIA
P.O. BOX 35585
MENLOPARK 0102

GENERAL NOTES

- 20A SINGLE PHASE ISOLATOR @ INDICATED POSITION
- 18A SSO @ INDICATED POSITION
- 16A DOUBLE SSO @ INDICATED POSITION
- POP UP CORPORATE CONNECTION @ INDICATED POSITION.



FIRST DRAWING ISSUE: 2017-08-30	
PRELIMINARY	TENDERS
APPROVAL	CONSTRUCTION
COORDINATION	AS BUILT

COPY RIGHT IS VESTED IN THIS DRAWING AND NO USE, REPRODUCTION OR DUPLICATION HEREOF MAY OCCUR WITHOUT WRITTEN CONSENT OF INGPLAN GALTENS (PTY) LTD

REVISIONS

NO.	DESCRIPTION	DATE

CLIENT
**HUDSON AVENUE
Pty (Ltd)**

ELECTRICAL DESIGN	CAD DESIGN	APPROVED BY
E. GENIS	W. DE KLERK	E. GENIS




INGPLAN HOUSE UNIT 1
452 SUSSEX AVENUE, C/O SUSSEX & LYNNWOOD ROAD
LYNNWOOD, PRETORIA 0091
P.O. BOX 35585, MENLO PARK 0102
TEL: (012) 340-2004
e-mail: admin@ingplan.co.za

PROJECT
**LIBERTAS OFFICE PARK
- BLOCK D-**


DESCRIPTION OF DRAWING
**-FIRST FLOOR
KITCHENETTE-
SMALL POWER
LAYOUT**

SCALE ON A3 PAPER: 1:50	SITE DETAIL: EQUESTRIA X 168
ARCHITECT'S DRAWING NO: 1331-2-SANAS SHEET-450 KITCHEN & COUNTER	NORTH ↑
INGPLAN DRAWING NO: 07P060/BD/E22	INGPLAN'S REVISION NO: AB

COFFEE STATION

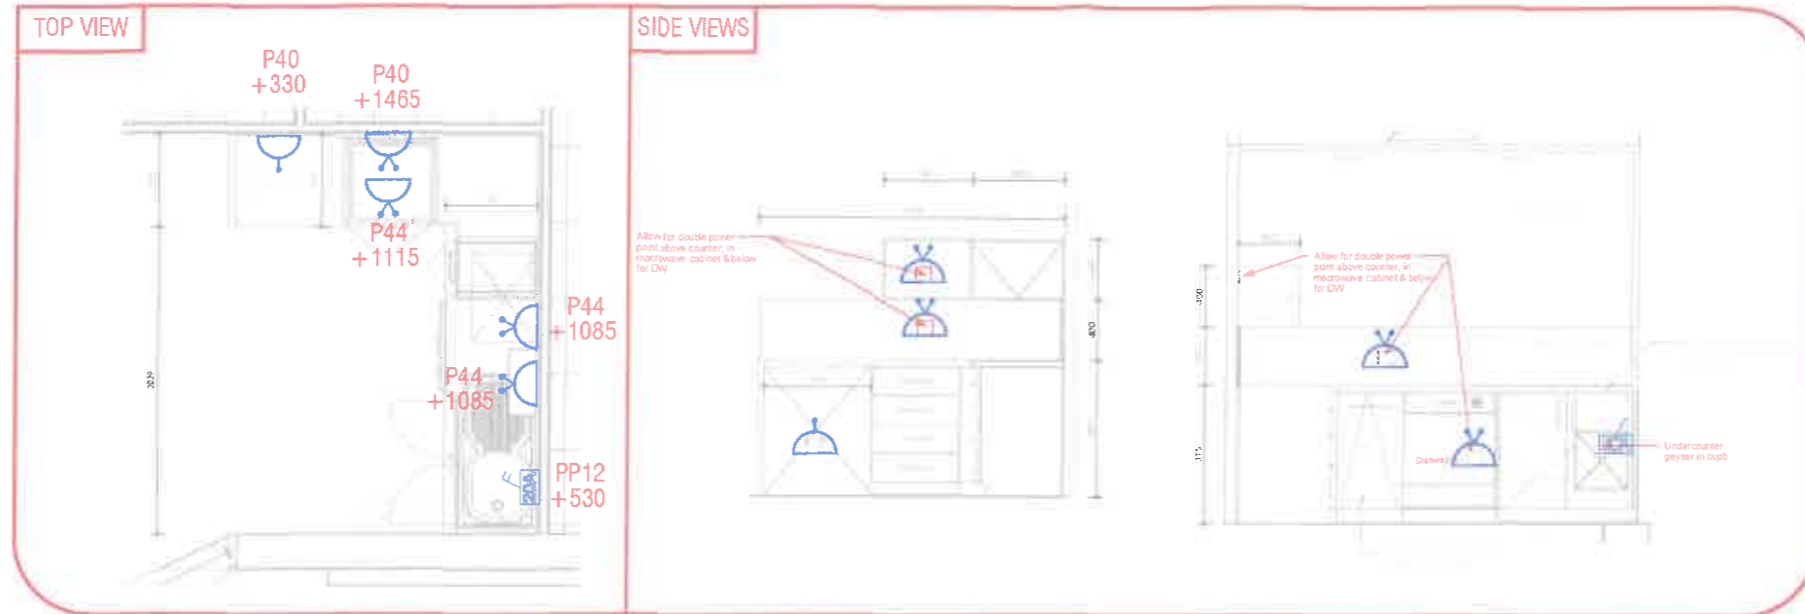

CLEANERS KITCHEN

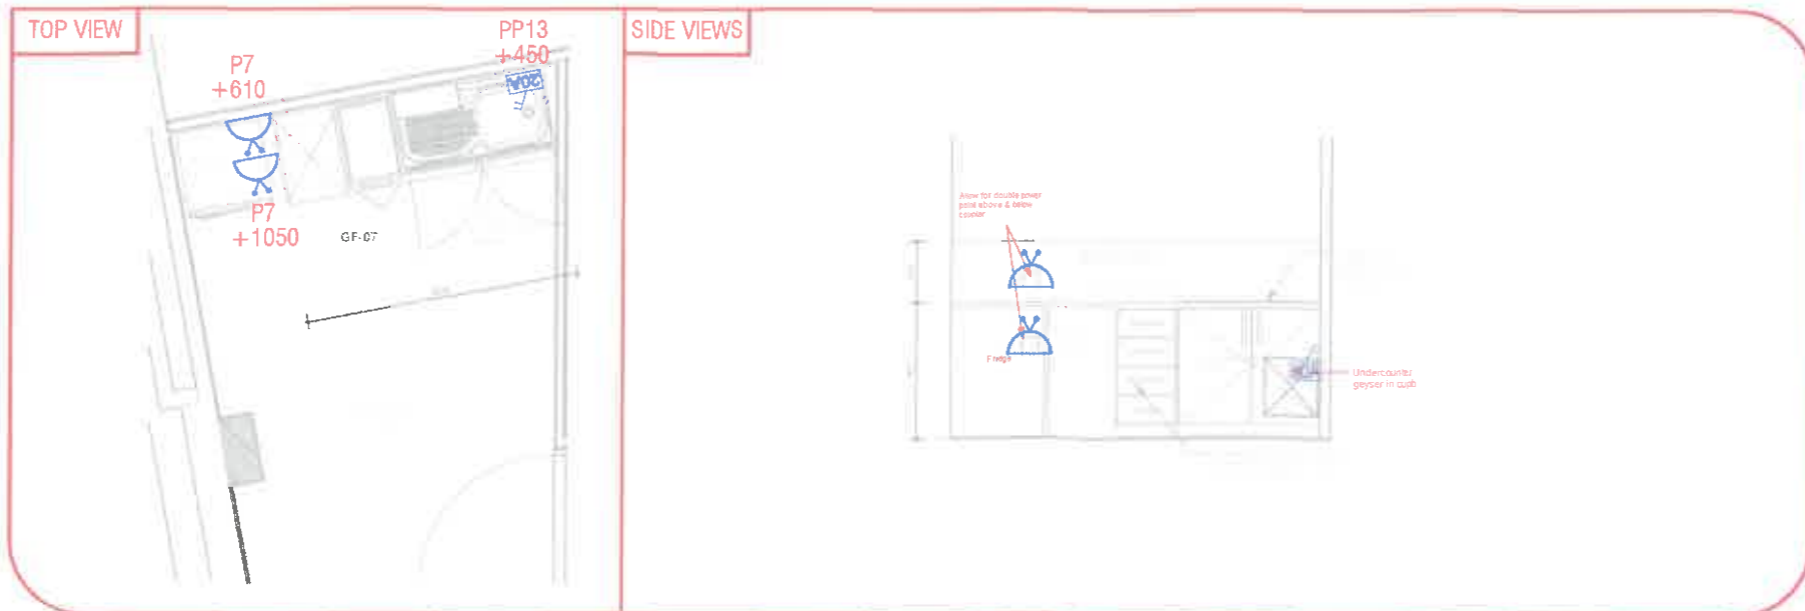

INGPLAN PRETORIA
P.O. BOX 35585
MENLOPARK 0102

GENERAL NOTES

- 20A SINGLE PHASE ISOLATOR @ INDICATED POSITION
- 16A SSO @ INDICATED POSITION
- 16A DOUBLE SSO @ INDICATED POSITION

FIRST DRAWING ISSUE: 2017 - 08 - 29	
PRELIMINARY <input type="checkbox"/>	TENDERS <input type="checkbox"/>
APPROVAL <input type="checkbox"/>	CONSTRUCTION <input type="checkbox"/>
COORDINATION <input type="checkbox"/>	AS BUILT <input checked="" type="checkbox"/>

COPYRIGHT IS VESTED IN THIS DRAWING AND NO USE, REPRODUCTION OR DUPLICATION HEREOF MAY OCCUR WITHOUT WRITTEN CONSENT OF INGPLAN GAUTENG (PTY) LTD.

REVISIONS

NO.	DATE	DESCRIPTION	BY

CLIENT

HUDSON AVENUE
Pty (Ltd)

ELECTRICAL DESIGN E. GENIS Pr. Eng	CAD DESIGN W. DE KLERK	APPROVED BY E. GENIS Pr. Eng
--	---------------------------	------------------------------------



INGPLAN HOUSE UNIT 1
462 BUSSEK AVENUE, DO BUISSEK & LYNNWOOD ROAD
LYNNWOOD, PRETORIA 0091
P.O. BOX/POSBUS 35585 MENLO PARK 0102
TEL: (012) 349-2084
e-mail: admin@ingplan.co.za

PROJECT

LIBERTAS OFFICE PARK
- BLOCK D-

DESCRIPTION OF DRAWING

-GROUND FLOOR COFFEE
STATION & CLEANERS
KITCHEN-
SMALL POWER
LAYOUT

SCALE ON A3 PAPER: 1:50	SITE DETAIL: EQUESTRIA X 100
ARCHITECT'S DRAWING NO: 1331-2-SANAS SHEET-450 KITCHEN & COUNTER DL	NORTH
INGPLAN DRAWING NO: 07P060/BD/E20	INGPLAN'S REVISION NO: AB