
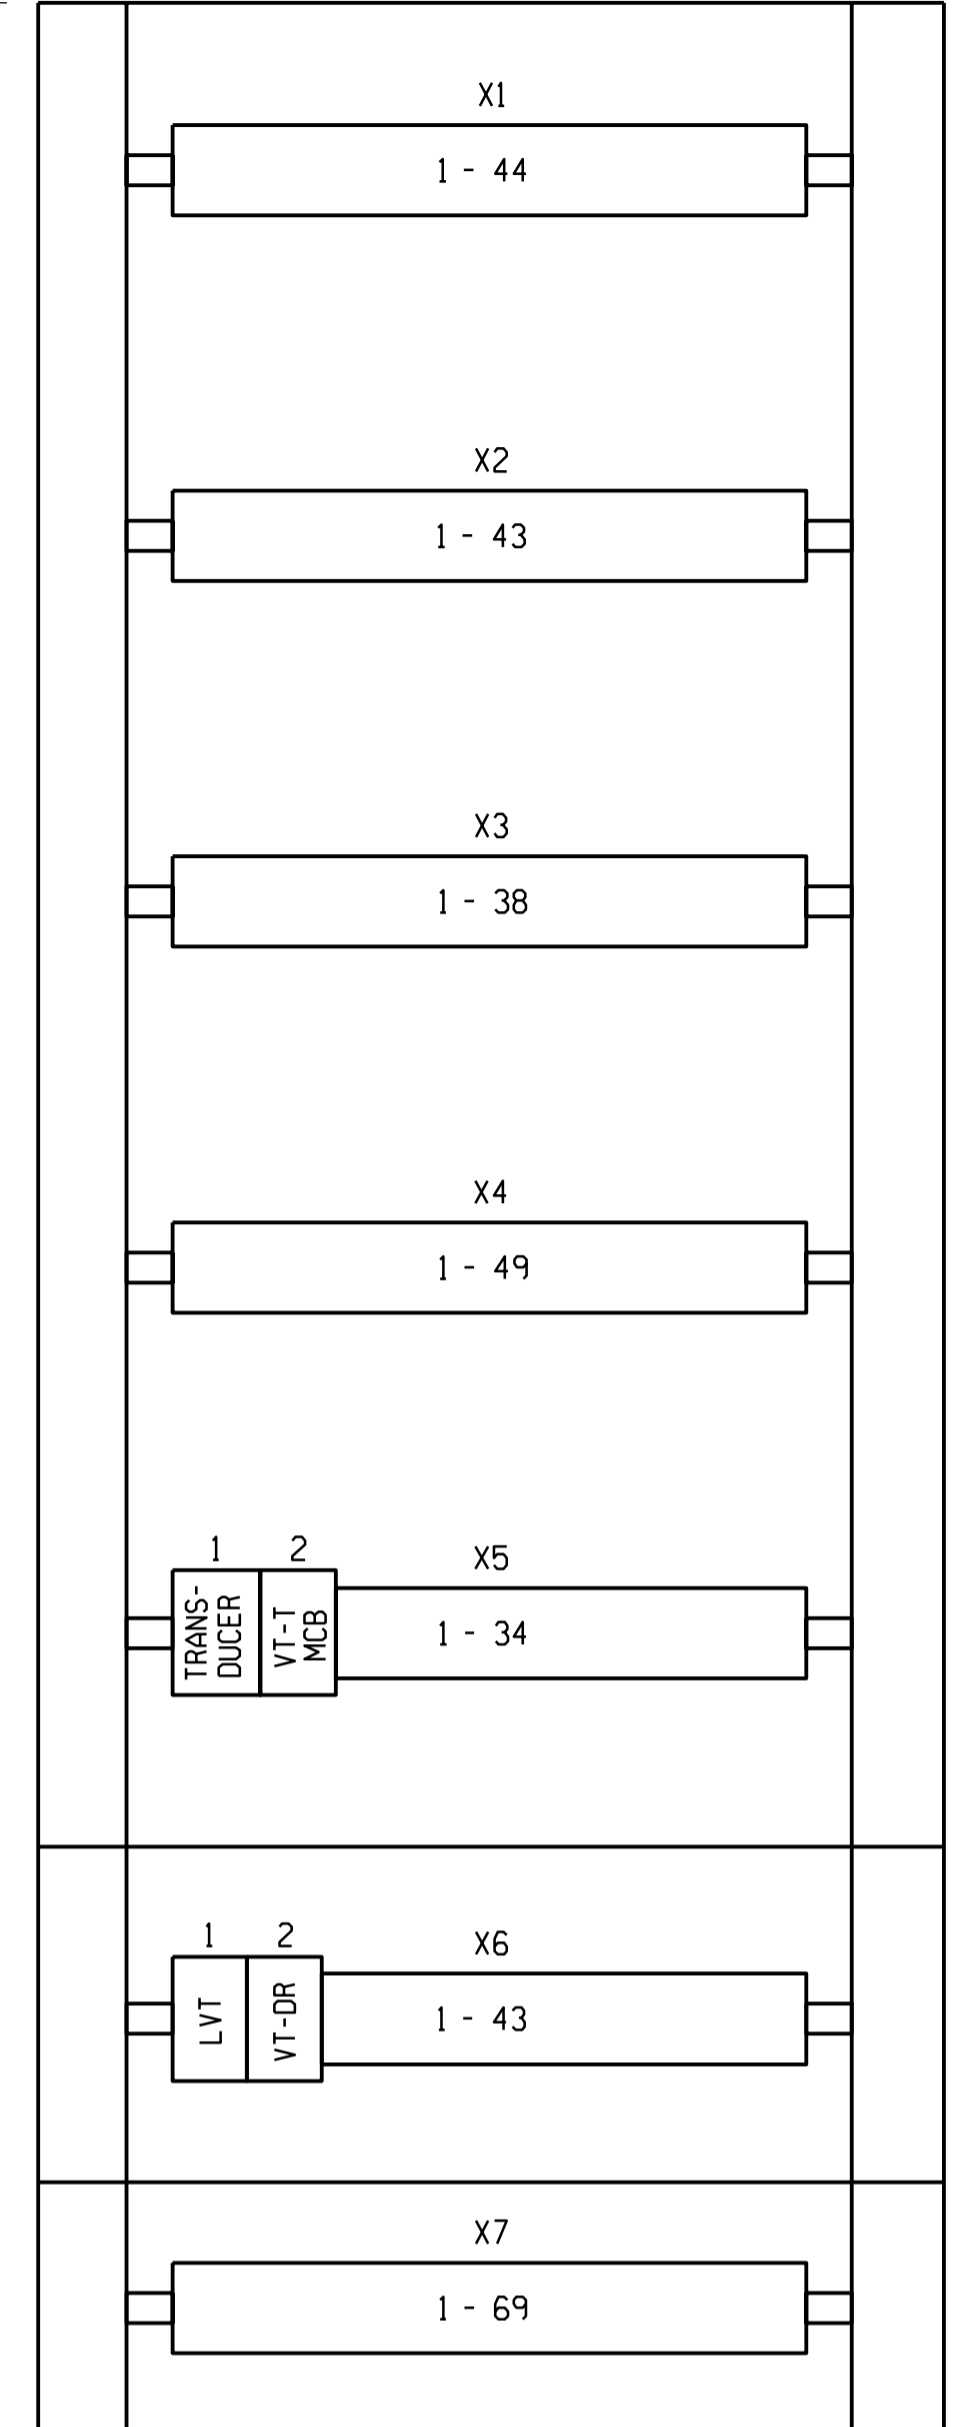


FRONT OF MODULE


TERMINAL PLATE OF MODULE (TOP)

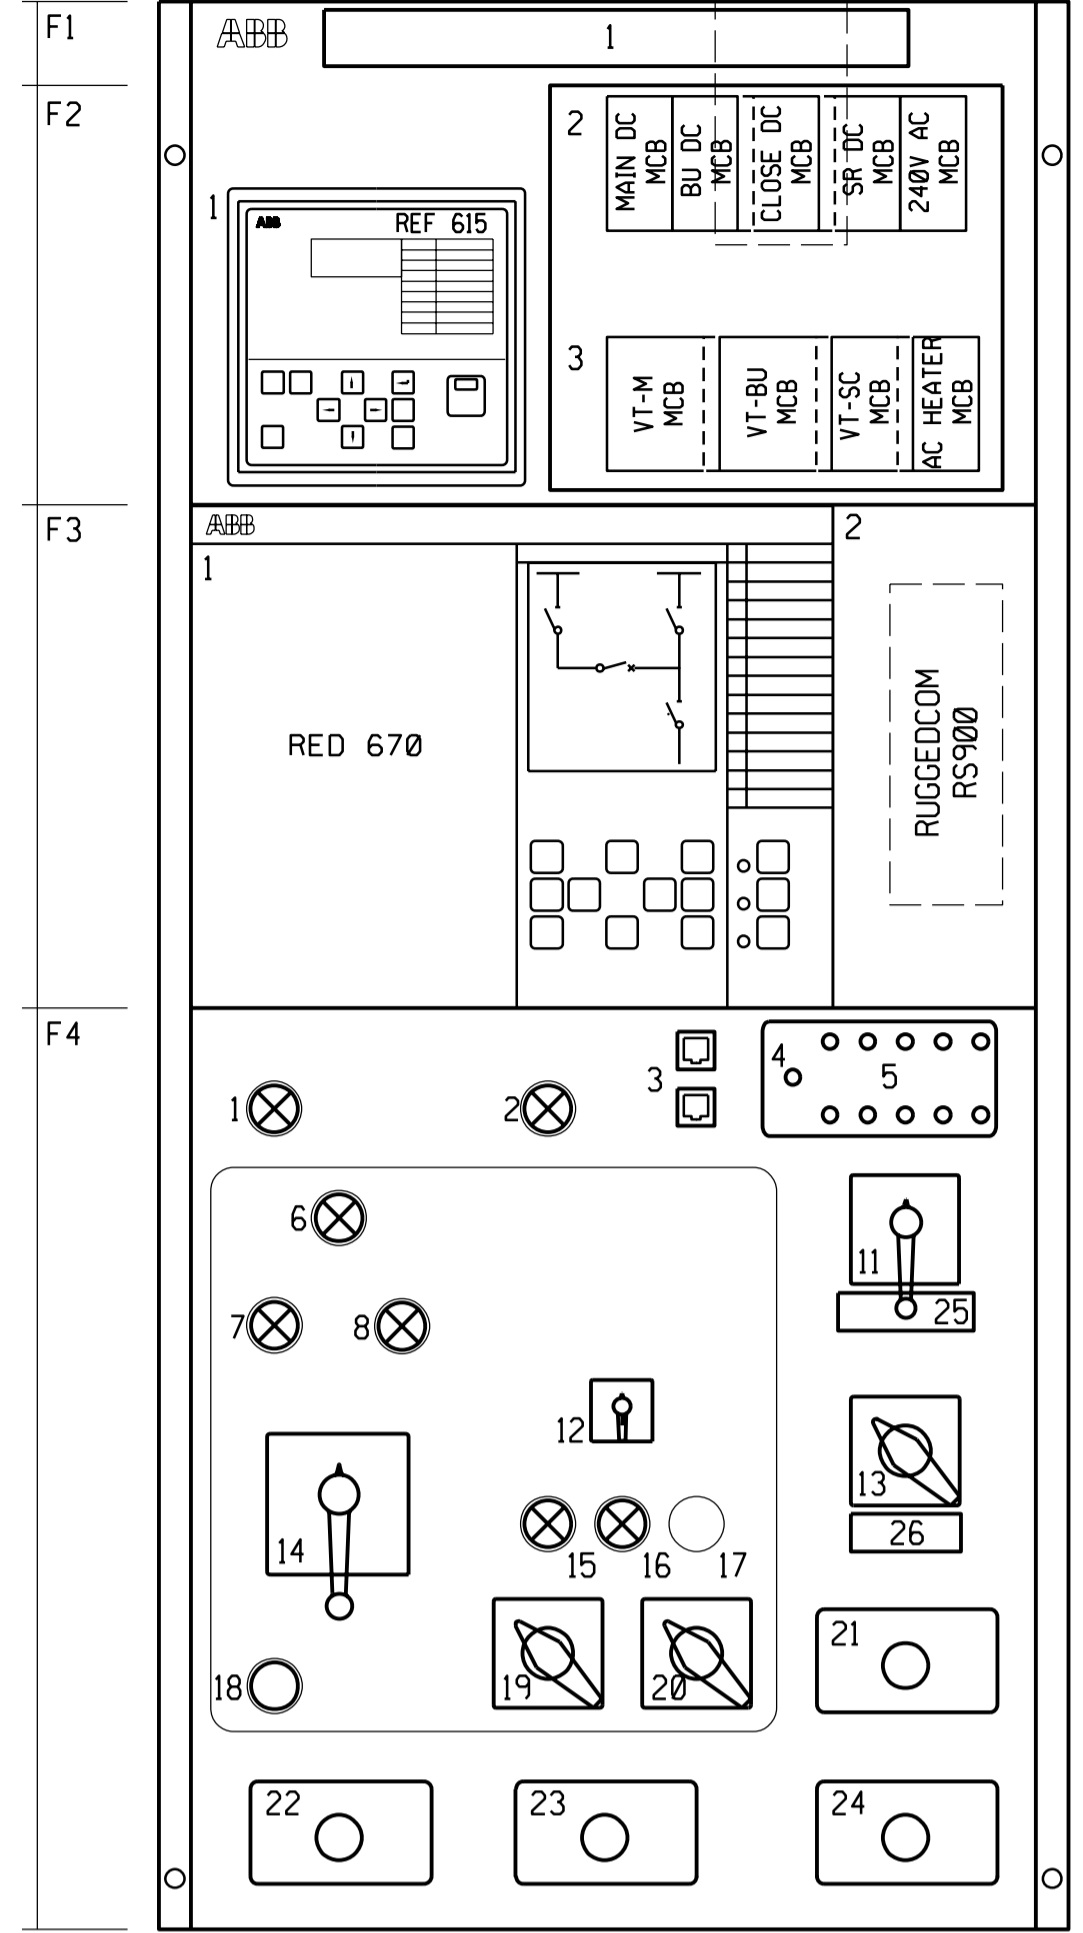


DISTURBANCE RECORDER TERMINALS (OPTIONAL)

SUPERVISORY HARDWIRED TERMINALS (OPTIONAL)

REAR OF MODULE

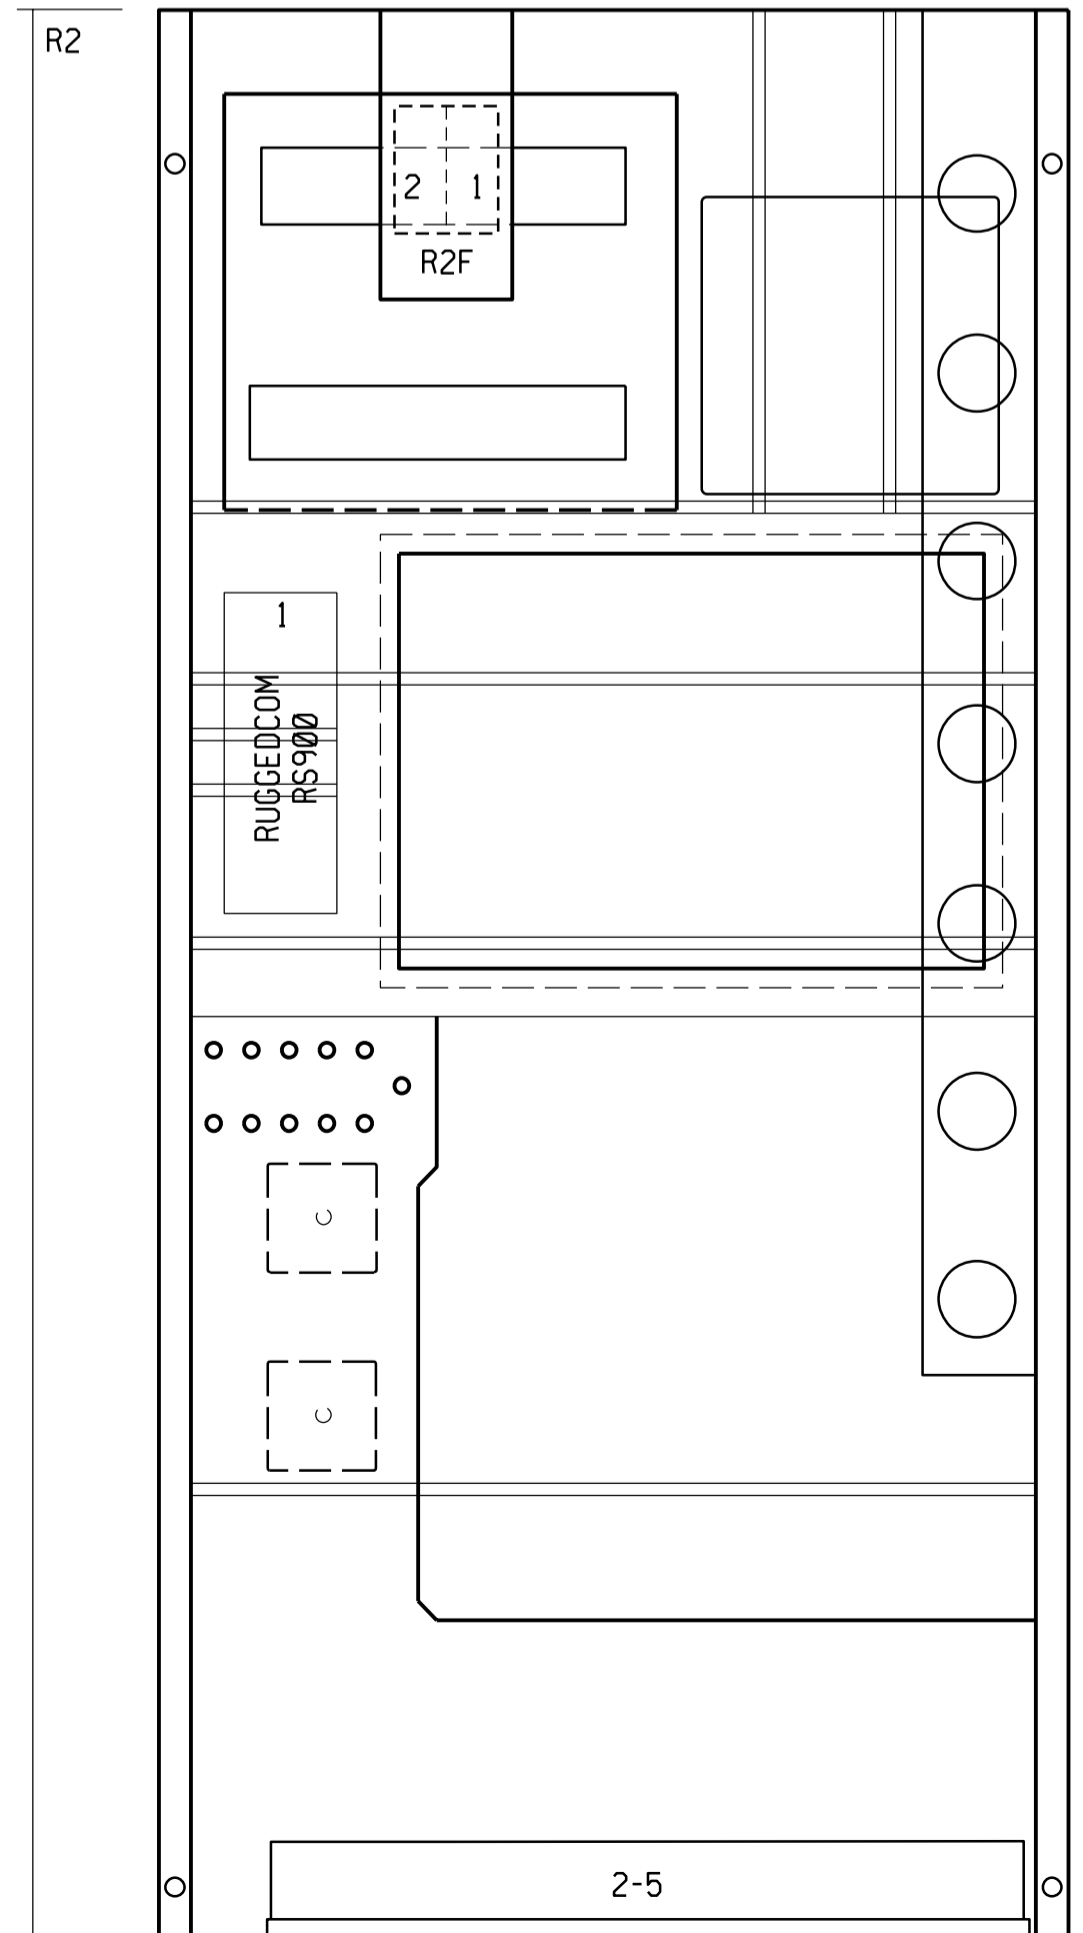


INTERNAL TO MODULE

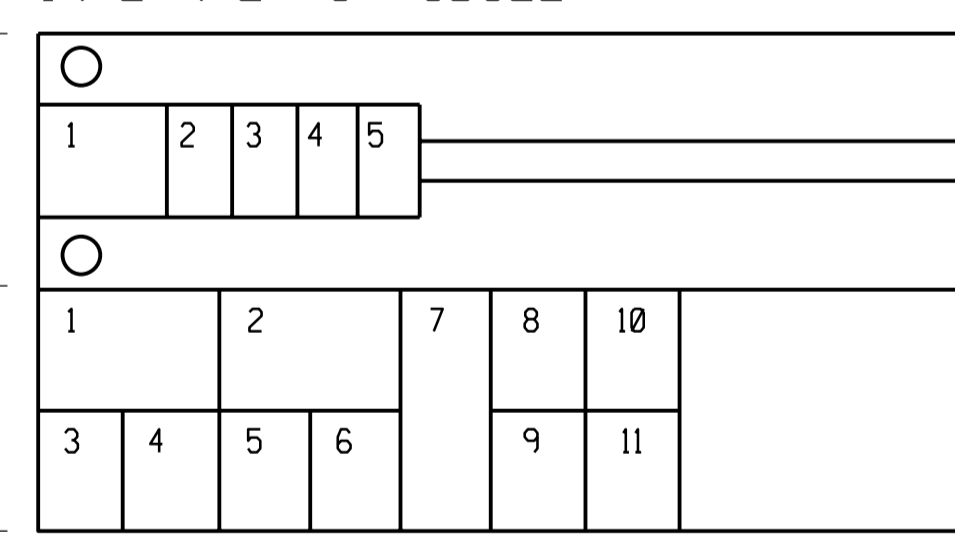


LAYOUT FOR 110V AND 220V DC SCHEME (FRONT VIEW)

INTERNAL TO MODULE

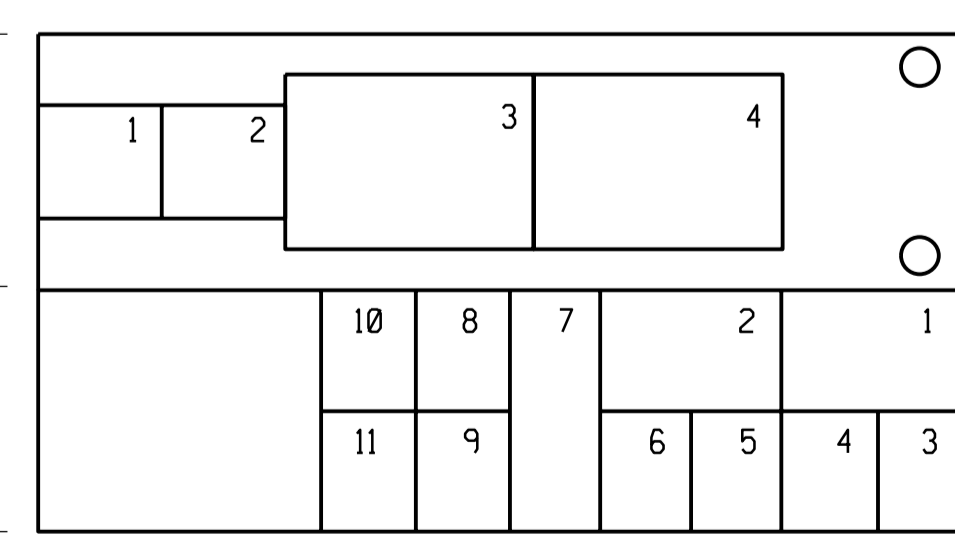


LAYOUT FOR 110V AND 220V DC SCHEME (REAR VIEW)

INTERNAL TO MODULE

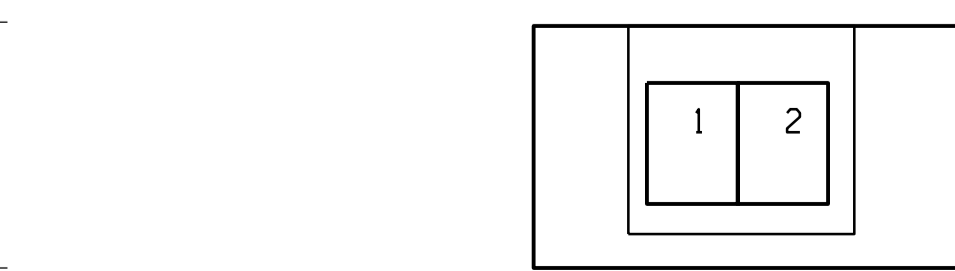

LAYOUT FOR 110V AND 220V DC SCHEME (FRONT ACCESS VIA MCB (F2) DOOR)

LOCATION	DESIGNATION	DESCRIPTION	TYPE	MANUFACTURER
FRONT OF MODULE				
F1	1	LABEL		
F2	1	BACK-UP IED	DIRECTIONAL BACK-UP PROTECTION	REF615
	2	MCB(M)	MAIN DC SUPPLY MCB (110V, 220V SCHEME) (16 AMP)	S282-UC B16
	3	MCB(BU)	BACK-UP DC SUPPLY MCB (110V, 220V SCHEME) (16 AMP)	S282-UC B16
	4	MCB(CL)	CLOSE DC SUPPLY MCB AUXILIARY CONTACT (110V, 220V SCHEME) (10 AMP)	S282-UC B10
	5	MCB(SR)	SPRING REWIND DC SUPPLY MCB AUXILIARY CONTACT (110V, 220V SCHEME) (20 AMP)	S282-UC B20
	6	MCB(SR)	SPRING REWIND DC SUPPLY MCB (110V, 220V SCHEME) (10 AMP)	S282-UC B10
	7	MCB(AC)	MAIN AC SUPPLY MCB (3 POLE) (2 AMP)	S203-C 2
F3	1	MCB(VT-M)	VT SUPPLY MAIN PROTECTION MCB (3 POLE) (2 AMP)	S203-C 2
	2	MCB(VT-M)	VT SUPPLY MAIN PROTECTION MCB AUXILIARY CONTACT	S2C-H6R
	3	MCB(VT-BU)	VT SUPPLY BACK-UP PROTECTION MCB (3 POLE) (2 AMP)	S203-C 2
	4	MCB(VT-BU)	VT SUPPLY BACK-UP PROTECTION MCB AUXILIARY CONTACT	S2C-H6R
	5	MCB(VT-SC)	VT SUPPLY SYNCH CHECK MCB (2 AMP)	S202-C 2
	6	MCB(VT-SC)	VT SUPPLY SYNCH CHECK MCB AUXILIARY CONTACT	S2C-H6R
	7	MCB(H)	HEATER SUPPLY MCB (6 AMP)	S282-UC B6
F3	1	MAIN IED	INTERGRATED DISTANCE/DIFFERENTIAL FEEDER PROTECTION RELAY	RED670
F4	1	PNH	PROTECTION NOT HEALTHY INDICATION (AMBER)	CL523Y
	2	ARC-OFF/LOCKED-OUT	AUTO RECLOSE OFF & CLOSE LOCK-OUT INDICATION (AMBER) (CL520 = 240V DC)	CL515Y
	3	IEC61850 RELAY COM PORTS	IEC61850 RELAY TEST ETHERNET COMMUNICATION PORTS	
	4	ESD	ELECTROSTATIC DISCHARGE POINT	SOCKET (BLUE)
	5	1	TEST POINT 1 - MAIN PROTECTION TRIP (RED PHASE)	SOCKET (RED)
		2	TEST POINT 2 - MAIN PROTECTION TRIP (WHITE PHASE)	SOCKET (RED)
		3	TEST POINT 3 - MAIN PROTECTION TRIP (BLUE PHASE)	SOCKET (RED)
		4	TEST POINT 4 - BREAKER FAIL BUS STRIP	SOCKET (RED)
		5	TEST POINT 5 - MAIN DC NEGATIVE SUPPLY	SOCKET (BLACK)
		6	TEST POINT 6 - BREAKER FAIL RETRIP CROSS TRIP	SOCKET (RED)
		7	TEST POINT 7 - SUPERVISORY TRIP	SOCKET (RED)
		8	TEST POINT 8 - BACK-UP PROTECTION TRIP	SOCKET (RED)
		9	TEST POINT 9 - ARC OR EXTERNAL CLOSE	SOCKET (RED)
		10	TEST POINT 10 - BACK-UP DC NEGATIVE SUPPLY	SOCKET (BLACK)
	6	CBNH	CIRCUIT BREAKER NOT HEALTHY INDICATION (AMBER)	CL515Y
	7	CBO	CIRCUIT BREAKER OPEN INDICATION (GREEN)	CL515C
	8	CBC	CIRCUIT BREAKER CLOSE INDICATION (RED)	CL515R
	11	TNS	TEST NORMAL SWITCH	CR0867
	12	LCS	LAMP CHECK SWITCH	CA4 A321-621
	13	TPIS	TELEPROTECTION ISOLATOR SWITCH	CR-0866
	14	CBSC	CIRCUIT BREAKER CONTROL SWITCH	CR-0604
	15	ARC OFF	AUTO RECLOSE SELECTION STATE PUSH BUTTON (AMBER) (110V DC)	MP3-11Y, MBH-101
	16	ARC 3 POLE	AUTO RECLOSE SELECTION STATE PUSH BUTTON (AMBER) (110V DC)	MP3-11Y, MBH-101
	17		(BLANK)	
	18	TTPB	TRIP TEST PUSH BUTTON/ PROTECTIVE COVER	CP10-10R-10/ YSF
	19	BFIS	BREAKER FAIL ISOLATOR SWITCH	CR-0866A
	20	SIS	SUPERVISORY ISOLATOR SWITCH	CR-0316
	21	CTTB-BU	CT TEST BLOCK (BACK-UP)	PK2 (4 WAY)
	22	CTTB-M	CT TEST BLOCK (MAIN)	PK2 (4 WAY)
	23	VTTB-M	VT TEST BLOCK (MAIN)	PK2 (4 WAY)
	24	VTTB-BU	VT TEST BLOCK (BACK-UP)	PK2 (4 WAY)
	25	M.O.T. - LINK A CLOSED = NO SYNCH CHECK	LABEL INDICATING EMERGENCY CLOSE CONTROL WITHOUT SYNCH CHECK WHEN LINK A IS CLOSED, AND TNS SELECTED TO MAIN ON TEST	
	26	REMOTE DIFF ISOLATION	LABEL INDICATING TPIS BLOCKS REMOTE DIFF UNIT	
INTERNAL TO MODULE				
RI	1	VSR-1	ISOLATOR 1 REPEAT RELAY (• AN=110V DC, AS=220V DC) (NOT INSTALLED)	RXMBV 2 RK 251205-•
	2	VSR-2	ISOLATOR 2 REPEAT RELAY (• AN=110V DC, AS=220V DC) (NOT INSTALLED)	RXMBV 2 RK 251205-•
	3		(BLANK)	
	4		(BLANK)	
	5	RCPM.C/T	SNUBBER CIRCUIT	RCPM1 PR56512029-AA
	6	CT-X	BACK-UP TO MAIN CROSS TRIP AUXILIARY RELAY	RXMA 1 RK 211072-AN
	7	PSU	48 VOLT DC POWER SUPPLY UNIT (NOT INSTALLED)	RXTUC
	8	TCS-M	TRIP CIRCUIT SUPERVISION MAIN (MAIN)	BTCS110
	9		(BLANK)	
	10		(BLANK)	
	11	TCS-BU	TRIP CIRCUIT SUPERVISION BACK-UP (BACK-UP)	BTCS110
R3F	1	D1	LAMP CHECK DIODES	PR56592018
	2	D2	CROSS TRIP DIODES	PR56512033,BA
	3	D3	CROSS TRIP DIODES	PR56512033,BA
	4	D4	BLOCKING DIODE (MEASURING POINTS)	PR56592018/4,PNH
	5	D5	BLOCKING DIODE (TRIP CIRCUIT SUPERVISION 3 POLE)	PR56512033,BA
R3R	1	DCF-M	DC FAIL RELAY (MAIN) (• 110=110V DC, 220=220V DC)	CR-U110DC3L
	2	DCF-BU	DC FAIL RELAY (BACKUP) (• 110=110V DC, 220=220V DC)	CR-U110DC3L
	3	MCTS	MAIN CT SHORTING RELAY (• 110=110V DC, 220=220V DC) (NOT INSTALLED)	BJ8-110V DC
	4	BCTS	BACK-UP CT SHORTING RELAY (• 110=110V DC, 220=220V DC) (NOT INSTALLED)	BJ8-110V DC
R2F	1	CBC-CR	CIRCUIT BREAKER CLOSE AUXILIARY RELAY (• AN = 110V DC, AS = 220V DC)	RXMB1 1MRK 000 803-•
	2		(BLANK)	
REAR OF MODULE				
R2	1	ROUTER	IEC61850 ROUTER	RS900-HI-D-MTMTMT
	2	CBOS-X1	CIRCUIT BREAKER OPEN SUPERVISORY AUXILIARY 1 RELAY (48V DC)	CR-U048DC3
	3	CBOS-X1	CIRCUIT BREAKER CLOSE SUPERVISORY AUXILIARY 1 RELAY (48V DC)	CR-U048DC3
	4	PNH-X1	PROTECTION NOT HEALTHY AUXILIARY 1 RELAY (• 110=110V DC, 220=220V DC)	CR-U110DC3L
	5	PNH-X2	PROTECTION NOT HEALTHY AUXILIARY 2 RELAY (• 110=110V DC, 220=220V DC)	CR-U110DC3L
R4	X5.1	TRANSDUCER	MEASUREMENTS TRANSDUCER & INTERFACE (NOT INSTALLED)	SINEAX CAM/STAT15MT
	X5.2	MCB (VT-T)	TRANSUCER VT SUPPLY MCB (3 POLE) (2 AMP)	S203-C 2
	X6.1	MCB (LVT)	DISTURBANCE RECORDER LVT SUPPLY MCB (NOT INSTALLED) (1 AMP)	S202-C 1
	X6.2	MCB (VT-DR)	DISTURBANCE RECORDER VT SUPPLY MCB (3 POLE) (NOT INSTALLED) (1 AMP)	S203-C 1

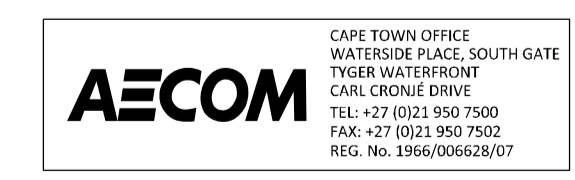

1	66kV VT & CB ADDED, FEEDER RENAMED.	KS	BH	CP	25/06/2021	153272156-00003
REV	REVISION DESCRIPTION	BY	CHKD	AUTH	DATE	PROJECT NUMBER

Eskom

**ISCOR SUBSTATION
66kV FEEDER 1
PANEL EQUIPMENT LAYOUT**

D-WC-7104

SET NUMBER: 61, SHEET NUMBER: 01, REVISION: 1

PANEL TYPE DESIGNATION: 4FZD-3920

REV	AUTH	DATE	REVISION TO MASTER	BY	CHKD	SCALE
-	-	-	-	-	-	-

MASTER TRACING FILED UNDER D-DT-15007 SHEET 01 OF 28 REVISION 2

66/11kV TRANSFORMER 1 SIDE

66kV CIRCUIT BREAKER

CORE 1
MAIN PROTECTION
CLASS TPS
M.R. 2400/1
USE 400/1

CORE 2
BUSZONE (MAIN)
CLASS TPS
M.R. 1600T/1
(NOT USED)

CORE 3
BUSZONE (CHECK)
CLASS TPS
M.R. 1600T/1
(NOT USED)

CORE 4
BACK-UP PROTECTION
CLASS TPS
M.R. 2400/1
USE 600/1

CORE 5
MEASUREMENTS
CLASS 0.2
M.R. 2400/1
NOT USED

CORE 6
MEASUREMENTS
CLASS 0.2
M.R. 2400/1
USE 400/1


- NOTES:
- IF THE FEEDER HAS OUTBOARD PRIMARY PLANT BYPASS CAPABILITY THEN SWITCH ON DRAWING LEVEL 18 (I.E. THE CT SHORTING OPTION IS TO THEN BE ORDERED AND USED).
 - AN EXTERNAL DISTURBANCE RECORDER MAY BE CONNECTED HERE IF NO DISTURBANCE RECORDER CT CORE IS AVAILABLE.
 - THE BACK-UP IED FEATURES AN AUTOMATIC CT SHORT-CIRCUIT CONNECTOR WHEN THE PLUG-IN UNIT IS WITHDRAWN.
 - FOR THE CASE OF DOUBLE CIRCUIT LINES WITH REGARD TO THE FAULT LOCATOR ACCURACY, THE INFLUENCE OF THE ZERO-SEQUENCE MUTUAL IMPEDANCE IS COMPENSATED FOR BY CONSIDERING THE RESIDUAL CURRENT ON THE PARALLEL LINE. FOR THIS CASE, USE THESE RELAY CT INPUTS.
 - PULLING CTTB-M WILL ALSO REMOVE THE REF 615 FROM SERVICE. IN THE EVENT THAT THE MAIN IED NEEDS TO BE REMOVED FROM SERVICE, RETURN CTTB-M TO SERVICE AND INSTALL JUMPERS.



REV	AUTH	DATE	REVISION TO MASTER	BY	CHKD	SCALE


1	66kV VT & CB ADDED, FEEDER RENAMED.	KS	BH	CP	25/06/2021	153272156-00003
REV	REVISION DESCRIPTION	BY	CHKD	AUTH	DATE	PROJECT NUMBER
PROJECT APPROVED C. PYM		DESIGN APPROVED A. CRAIB				
DATE 25/06/21		DATE 13/13/10				
PROJECT CHECKED B. HOMANN		DESIGN CHECKED N. MATHONSI				
DATE 25/06/21		DATE 13/12/10				
DRAWN BY K. STEYNBERG		DRAWN BY C. CANNON				
DATE 25/06/21		DATE 26/02/10				
PROJECT APPROVED				SET NUMBER	SHEET NUMBER	REVISION
Eskom				61	04	1
ISCOR SUBSTATION 66kV FEEDER 1 AC KEY DIAGRAM						
D-WC-7104						
PANEL TYPE DESIGNATION 4FZD-3920						

TERMINAL DESCRIPTION	
CT	CURRENT TRANSFORMER
CTJB	CURRENT TRANSFORMER JUNCTION BOX
RP	RELAY PANEL TERMINAL

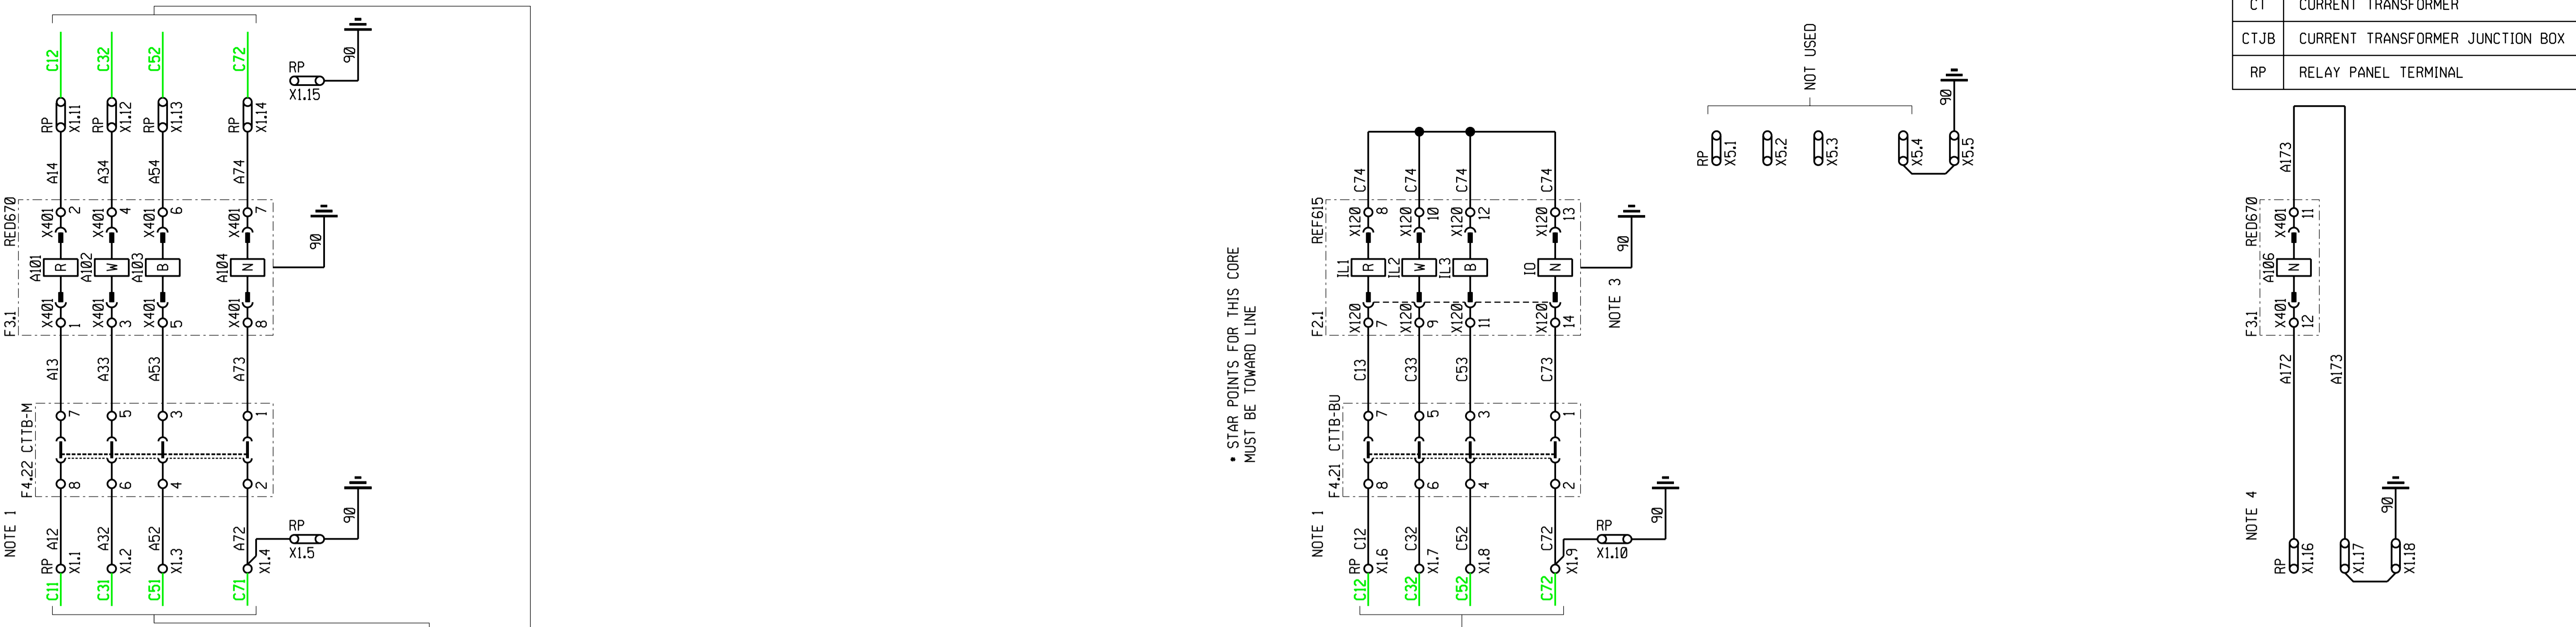

MASTER TRACING FILED UNDER D-DT-15007 SHEET 04 OF 28 REVISION 2

LINE VOLTS
(LINE VT JB)
(NOT USED)

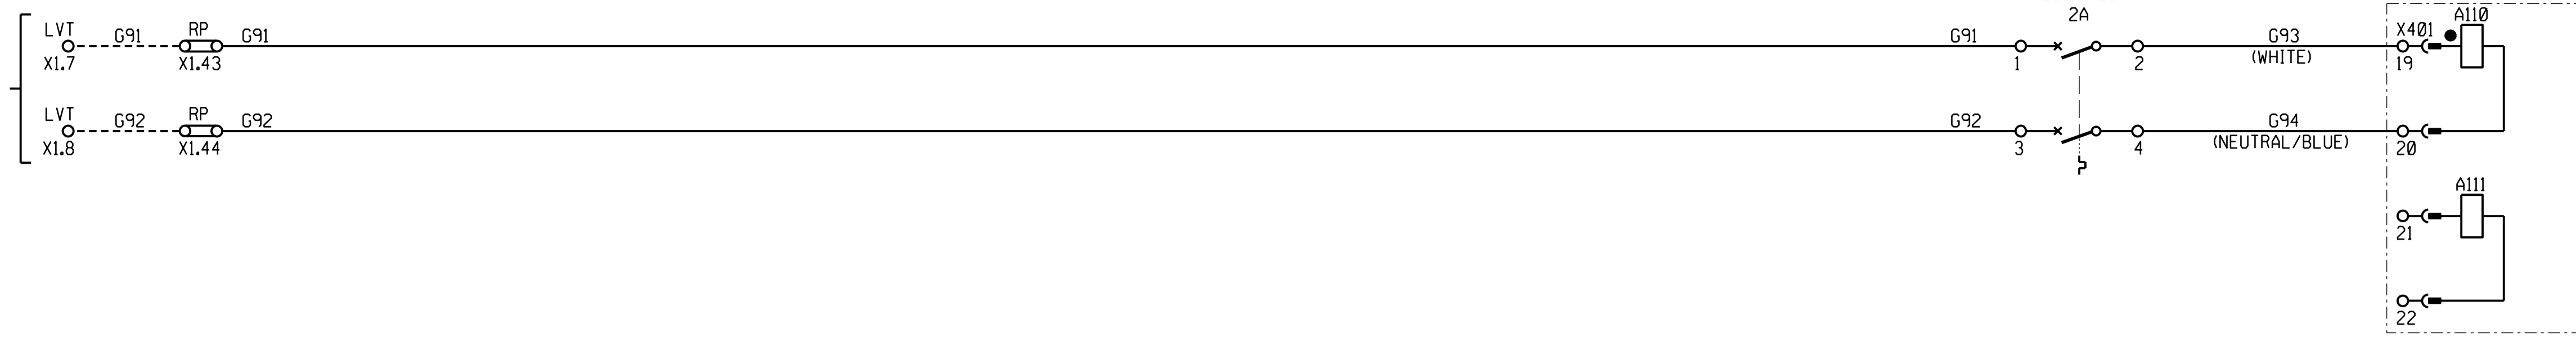

SYNCHRONISING
CHECK VOLTAGE
(NOTE 3)
(NOTE 4)

DIRECTIONAL EARTH
FAULT FUNCTION
(INTERNALLY DERIVED)

DIRECTIONALITY
(ZERO SEQUENCE)
VOLTAGE INPUT
(INTERNALLY DERIVED)


DIRECTIONALITY RED
VOLTAGE INPUT

DIRECTIONALITY WHITE
VOLTAGE INPUT

DIRECTIONALITY BLUE
VOLTAGE INPUT

IMPEDANCE VT AND
RUNNING VOLTS
(NOTE 4)

- NOTE:**
- ALL OPTIONS ARE WIRED IN, ONLY THE OPTIONAL RELAYS NEED TO BE INSERTED TO SELECT THE SPECIFIC OPTION.
 - RELAY VSR WITH ASSOCIATED WIRING IS ONLY REQUIRED WHEN THE MULTIPLE BUSBAR OPTION IS TAKEN.
IF THE MULTIPLE BUSBAR OPTION IS NOT TAKEN, THE VT'S ARE TO BE CONNECTED AS FOLLOWS :-
MEASUREMENTS - X1.31, X1.32, X1.33 AND X1.34
PROTECTION - X1.19, X1.20, X1.21 AND X1.22
ADD LOOPS FROM X1.19 TO X1.27
X1.20 TO X1.28
X1.21 TO X1.29 } PROTECTION VT CIRCUIT
AND X1.31 TO X1.39
X1.32 TO X1.40
X1.33 TO X1.61 } MEASUREMENTS VT CIRCUIT
 - SELECT THE PREFERRED VOLTAGE FOR THE SYNCHRONISING CHECK OPTION, THE RELAY CAN USE THE FOLLOWING VOLTAGES: R-N, W-N, B-N, R-W, W-B, B-R.
 - THE IMPEDANCE VOLTS ARE DESIGNATED THE 'BUS' VOLTS AND THE SYNCH CHECK VOLTS ARE DESIGNATED THE 'LINE' VOLTS WITHIN THE ABB RED670 RELAY. THIS IS IDENTICAL TO THE DISTRIBUTION STANDARD OF 'BUS' VOLTS AND 'LINE' VOLTS, AS DEPICTED ON SHEETS 3 AND 5.

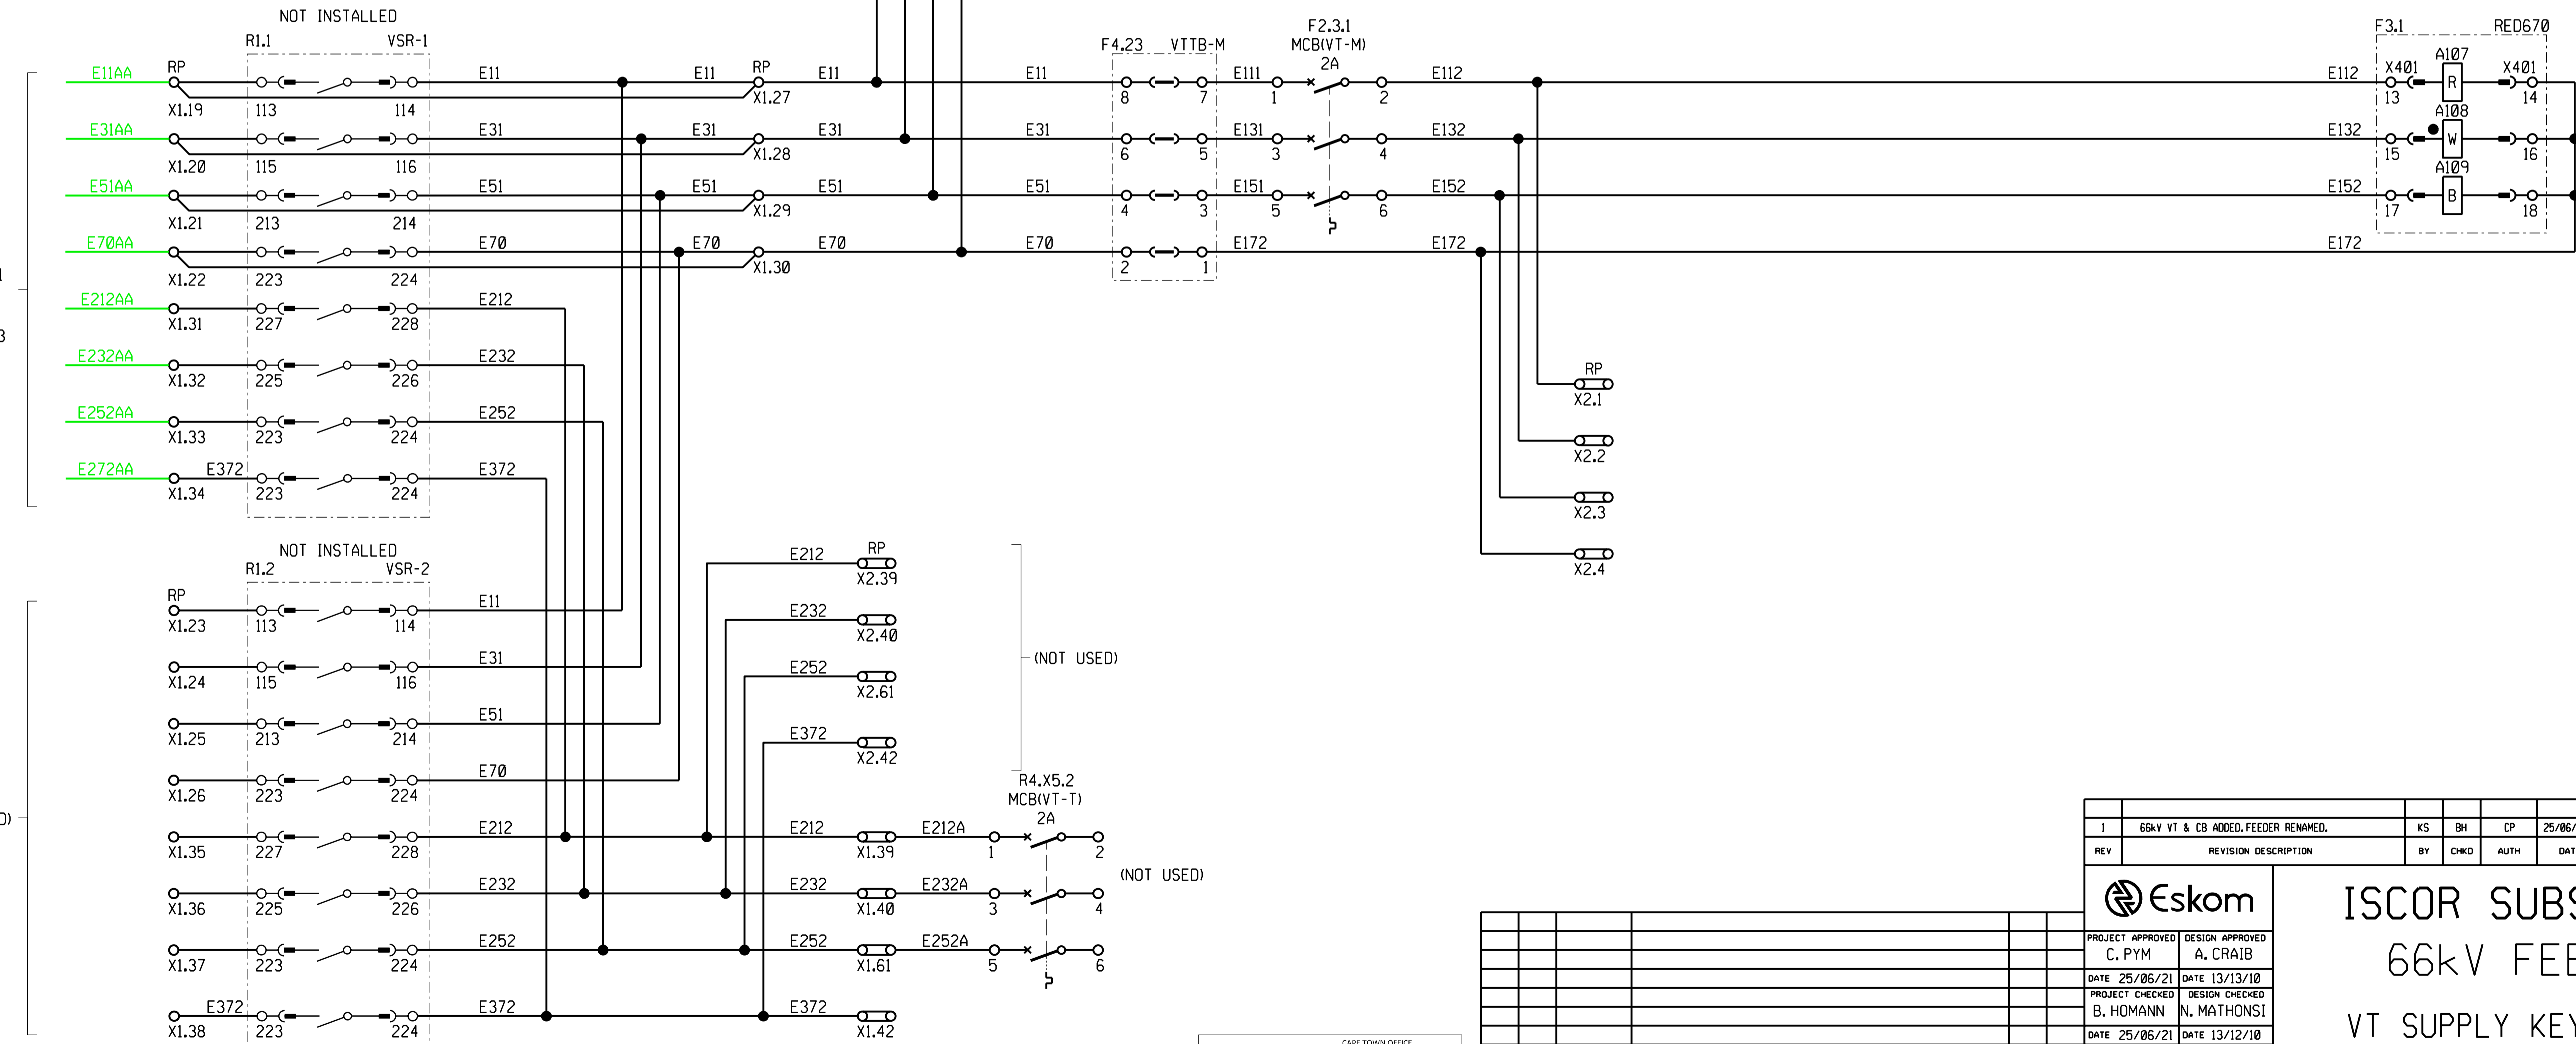

FROM 66kV
TRANSFORMER 1
VTJB 1
SEE DW-7104
SET 48 SHT 03

NOT INSTALLED

NOT INSTALLED

(NOT USED)

(NOT USED)

SHT 28	ISOLATOR JB
SHT 27	CABLE BLOCK
SHT 26	LINE VT DIAGRAM
SHT 25	CT JB CABLING
SHT 24	CABLING DIAGRAM
SHT 23	CABLING DIAGRAM
SHT 22	CABLING DIAGRAM
SHT 21	REFERENCE DIAG
SHT 20	REFERENCE DIAG
SHT 19	REFERENCE DIAG
SHT 18	DISTUR RECORDER
SHT 17	SUP ALARMS KEY
SHT 16	SUP STATUS, CONT
SHT 15	REA & MEAS KEY
SHT 14	SPR REW, AC KEY
SHT 13	INDICAT, DC KEY
SHT 12	CLOSE DC KEY
SHT 11	BACK-UP DC KEY
SHT 10	BACK-UP DC KEY
SHT 09	BACK-UP DC KEY
SHT 08	TELEPROT DC KEY
SHT 07	MAIN DC KEY
SHT 06	MAIN DC KEY
SHT 05	VT SUPPLY KEY
SHT 04	AC KEY DIAGRAM
SHT 03	SINGLE LINE
SHT 02	LOGIC DIAGRAM
SHT 01	PANEL LAYOUT
DRG No.	REFERENCE DRAWINGS:

1	66kV VT & CB ADDED, FEEDER RENAMED.	KS	BH	CP	25/06/2021	153272156-00003
REV	REVISION DESCRIPTION	BY	CHKD	AUTH	DATE	PROJECT NUMBER

Eskom

PROJECT APPROVED
C. PYM

DESIGN APPROVED
A. CRAIB

DATE 25/06/21 DATE 13/13/10

PROJECT CHECKED
B. HOMANN

DESIGN CHECKED
N. MATHONSI

DATE 25/06/21 DATE 13/12/10

DRAWN BY
K. STEYNBERG

DATE 25/06/21 DATE 26/02/10

ISCOR SUBSTATION

66kV FEEDER 1

VT SUPPLY KEY DIAGRAM

D-WC-7104

SET NUMBER	SHEET NUMBER	REVISION
61	05	1

PANEL TYPE DESIGNATION 4FZD-3920

AECOM

CAPE TOWN OFFICE
WATERSIDE PLACE, SOUTH GATE
TYGER WATERFRONT
CARL CRONIE DRIVE
TEL: +27 (0)21 950 7500
FAX: +27 (0)21 950 7502
REG. No. E966/006428/07

REV	AUTH	DATE	REVISION TO MASTER	BY	CHKD	SCALE

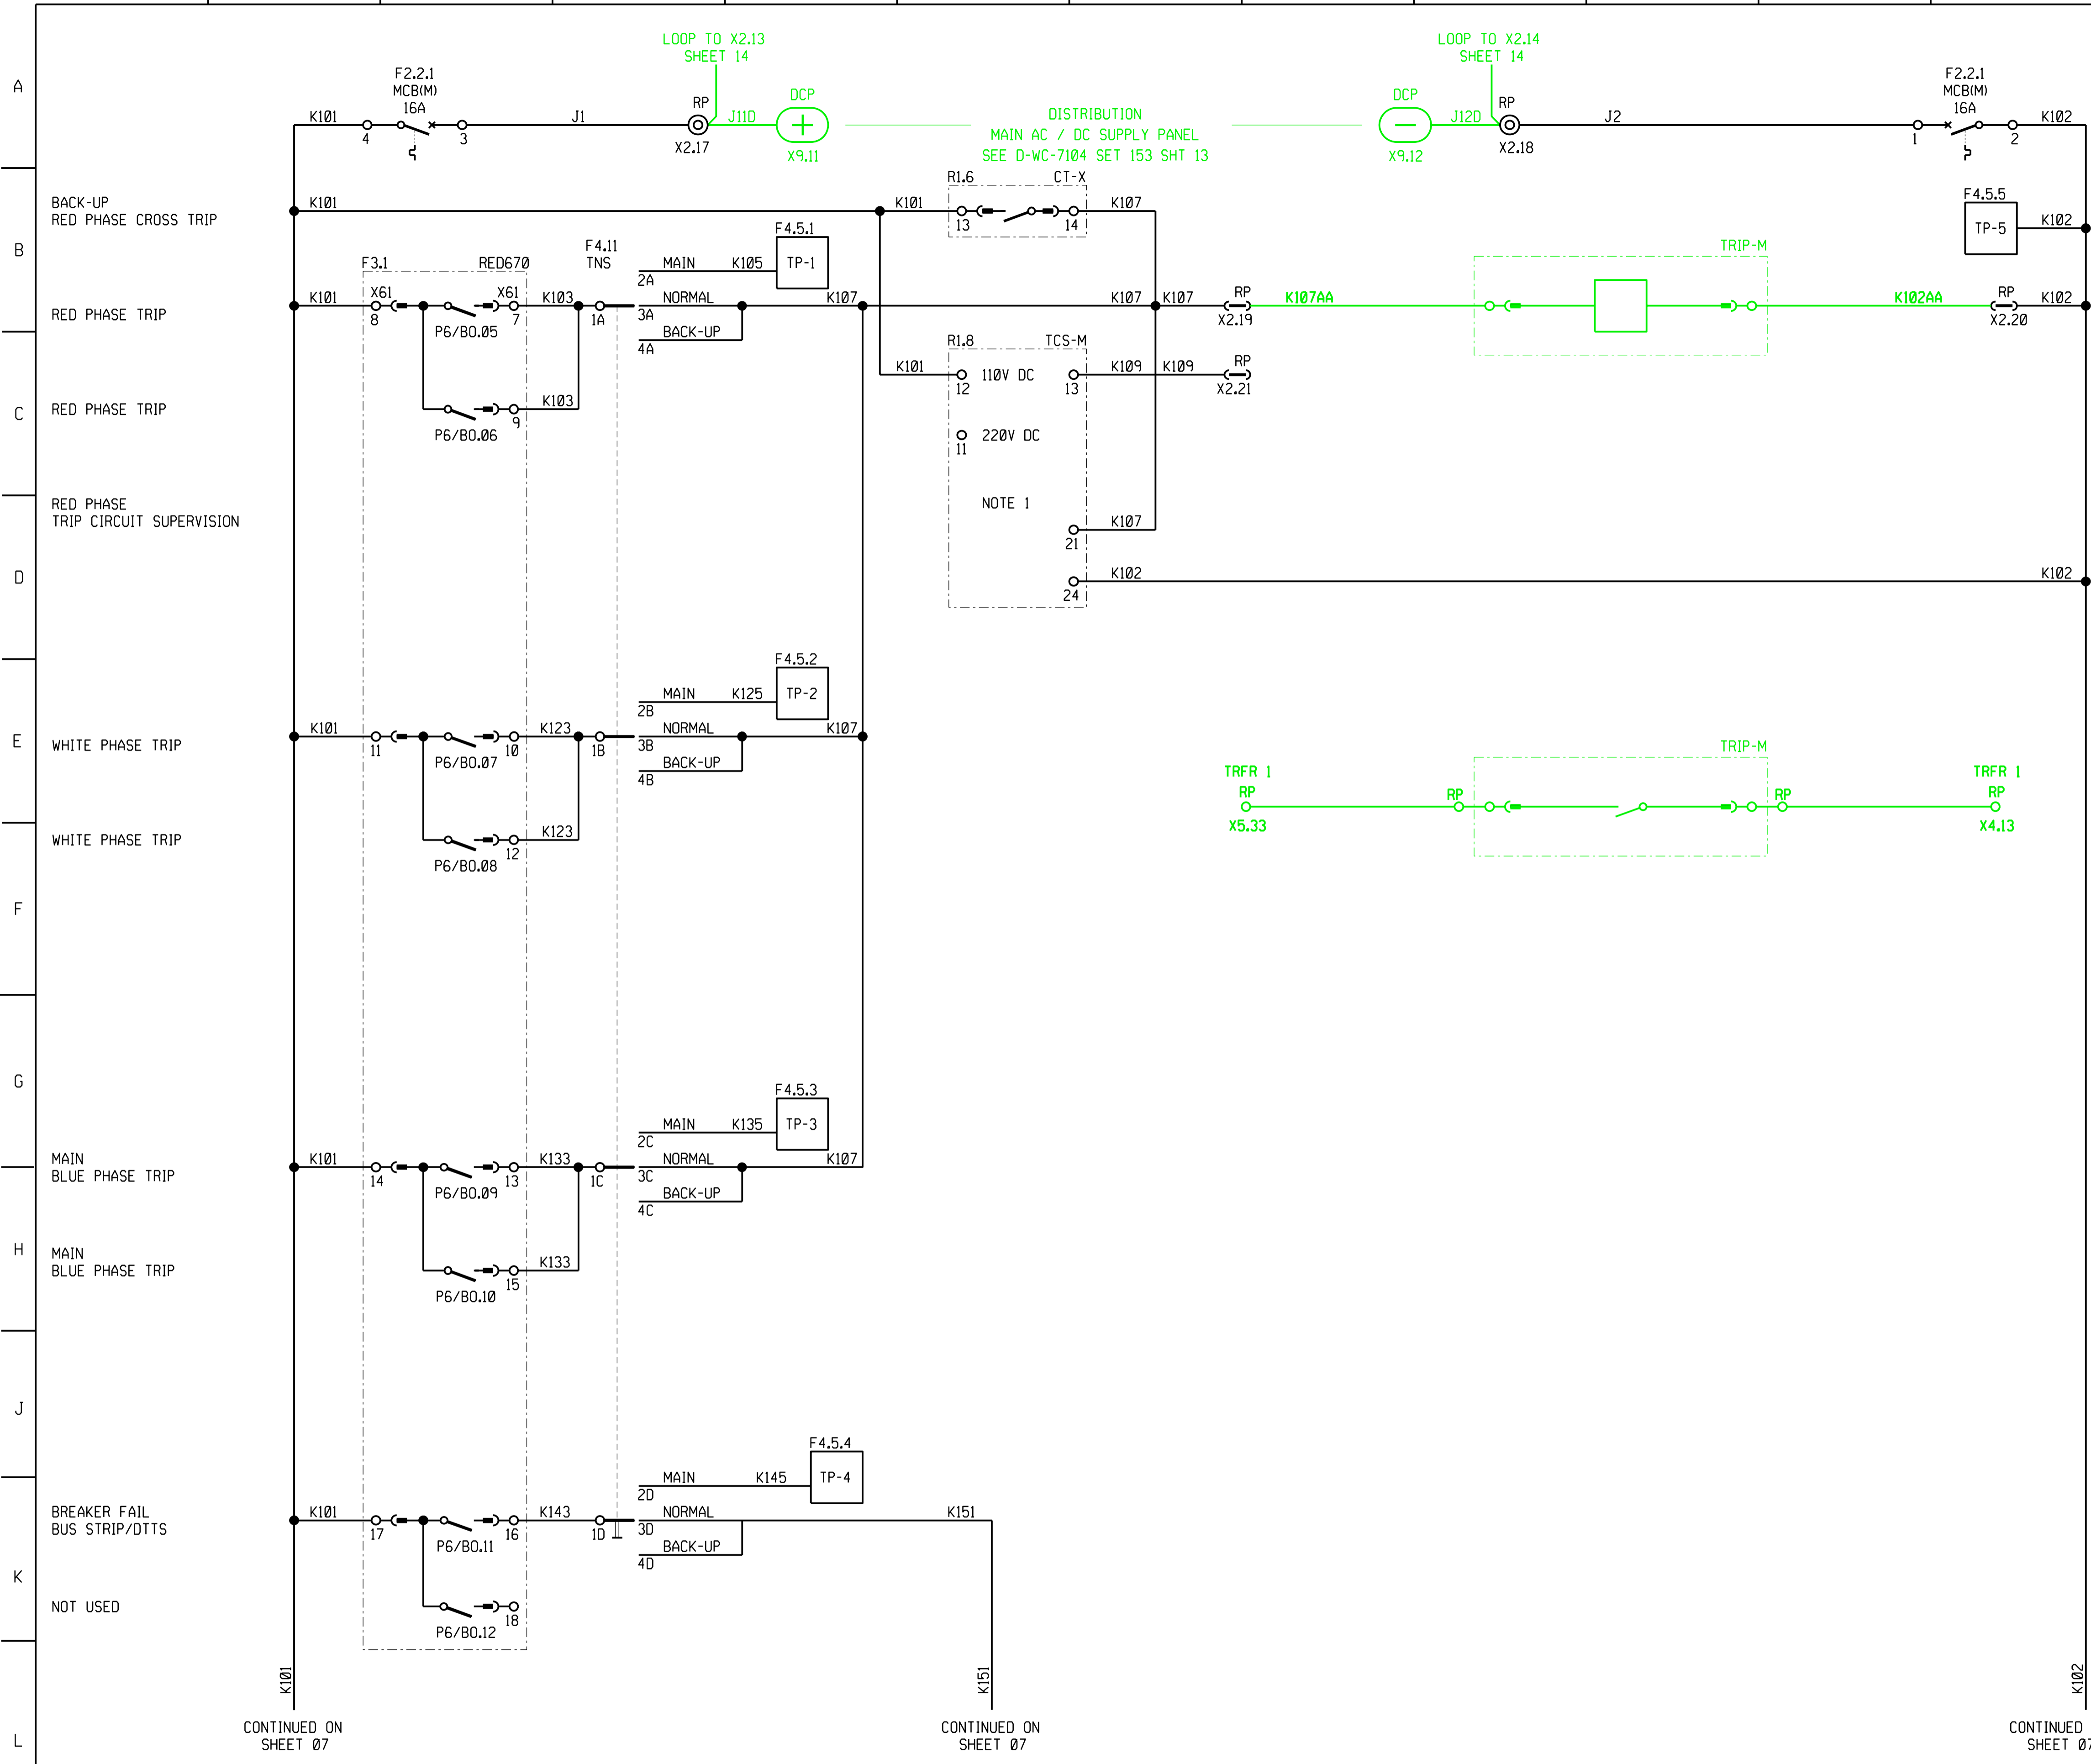


ABB 132kv THREE POLE BREAKER LEGEND	
ITEM	DESCRIPTION
BD1	DENSITY SWITCH
BG1	BREAKER AUXILIARY CONTACTS
BT1	HEATER THERMOSTAT
BW1	SPRING LIMIT SWITCH
E1	HEATER (PERMANENTLY CONNECTED)
E2	HEATER (THERMOSTAT CONTROLLED)
F1	DIRECT ON LINE MOTOR STARTER MCB
F2	MINATURE CIRCUIT BREAKER (HEATER)
K1	AUXILIARY RELAY (SPRING LIMIT SWITCH)
K3	ANTIPUMPING RELAY
K9	SF6 INTERLOCKING RELAY (CLOSE)
K10	SF6 INTERLOCKING RELAY (MAIN TRIP)
K19	AUXILIARY RELAY (THERMOSTAT)
K19.1 & K19.2	CURRENT RELAY (HEATER)
K25	SF6 AUXILIARY RELAY (SF6 LOW GAS ALARM)
KT1	TIME DELAYED RELAY (SPRING CHARGE FAILURE)
M1	SPRING REWIND MOTOR
S4	BREAKER ISOLATOR SWITCH (LOR)
SX11 - SX22	CONNECTION TERMINALS
SXY1 - SXY3	CONNECTION TERMINALS
X1	TERMINAL BLOCK FOR CONNECTIONS
X11 - X22	CONNECTION TERMINALS
XC1 - XC7	CONNECTION POINT
Y1	MAIN TRIP COIL
Y2	BACK-UP TRIP COIL
Y3	CLOSE COIL

NOTE:
 1. REMOVE TCS-M TRIP CIRCUIT SUPERVISION RELAY IN ORDER TO PREVENT TCS FAIL ALARM. CIRCUIT BREAKER HEALTH IS MONITORED BY THE TRANSFORMER PROTECTION.

SHT 28	ISOLATOR JB
SHT 27	CABLE BLOCK
SHT 26	LINE VT DIAGRAM
SHT 25	CT JB CABLING
SHT 24	CABLING DIAGRAM
SHT 23	CABLING DIAGRAM
SHT 22	CABLING DIAGRAM
SHT 21	REFERENCE DIAG
SHT 20	REFERENCE DIAG
SHT 19	REFERENCE DIAG
SHT 18	DISTUR RECORDER
SHT 17	SUP ALARMS KEY
SHT 16	SUP STATUS, CONT
SHT 15	REA & MEAS KEY
SHT 14	SPR REW, AC KEY
SHT 13	INDICAT, DC KEY
SHT 12	CLOSE DC KEY
SHT 11	BACK-UP DC KEY
SHT 10	BACK-UP DC KEY
SHT 09	BACK-UP DC KEY
SHT 08	TELEPROT DC KEY
SHT 07	MAIN DC KEY
SHT 06	MAIN DC KEY
SHT 05	VT SUPPLY KEY
SHT 04	AC KEY DIAGRAM
SHT 03	SINGLE LINE
SHT 02	LOGIC DIAGRAM
SHT 01	PANEL LAYOUT
DRG No.	REFERENCE DRAWINGS:

1	66kV VT & CB ADDED, FEEDER RENAMED.	KS	BH	CP	25/06/2021	153272156-00003
REV	REVISION DESCRIPTION	BY	CHKD	AUTH	DATE	PROJECT NUMBER

Eskom

PROJECT APPROVED
C. PYM

DESIGN APPROVED
A. CRAIB

DATE 25/06/21 DATE 13/13/10

PROJECT CHECKED
B. HOMANN

DESIGN CHECKED
N. MATHONSI

DATE 25/06/21 DATE 13/12/10

DRAWN BY
K. STEYBERG

DATE 25/06/21 DATE 26/02/10

SCALE

ISCOR SUBSTATION

66kV FEEDER 1

MAIN DC KEY DIAGRAM

D-WC-7104


SET NUMBER	SHEET NUMBER	REVISION
61	06	1

PANEL TYPE DESIGNATION 4FZD-3920



REV	AUTH	DATE	REVISION TO MASTER	BY	CHKD	SCALE

MASTER TRACING FILED UNDER D-DT-15007 SHEET 06 OF 28 REVISION 2

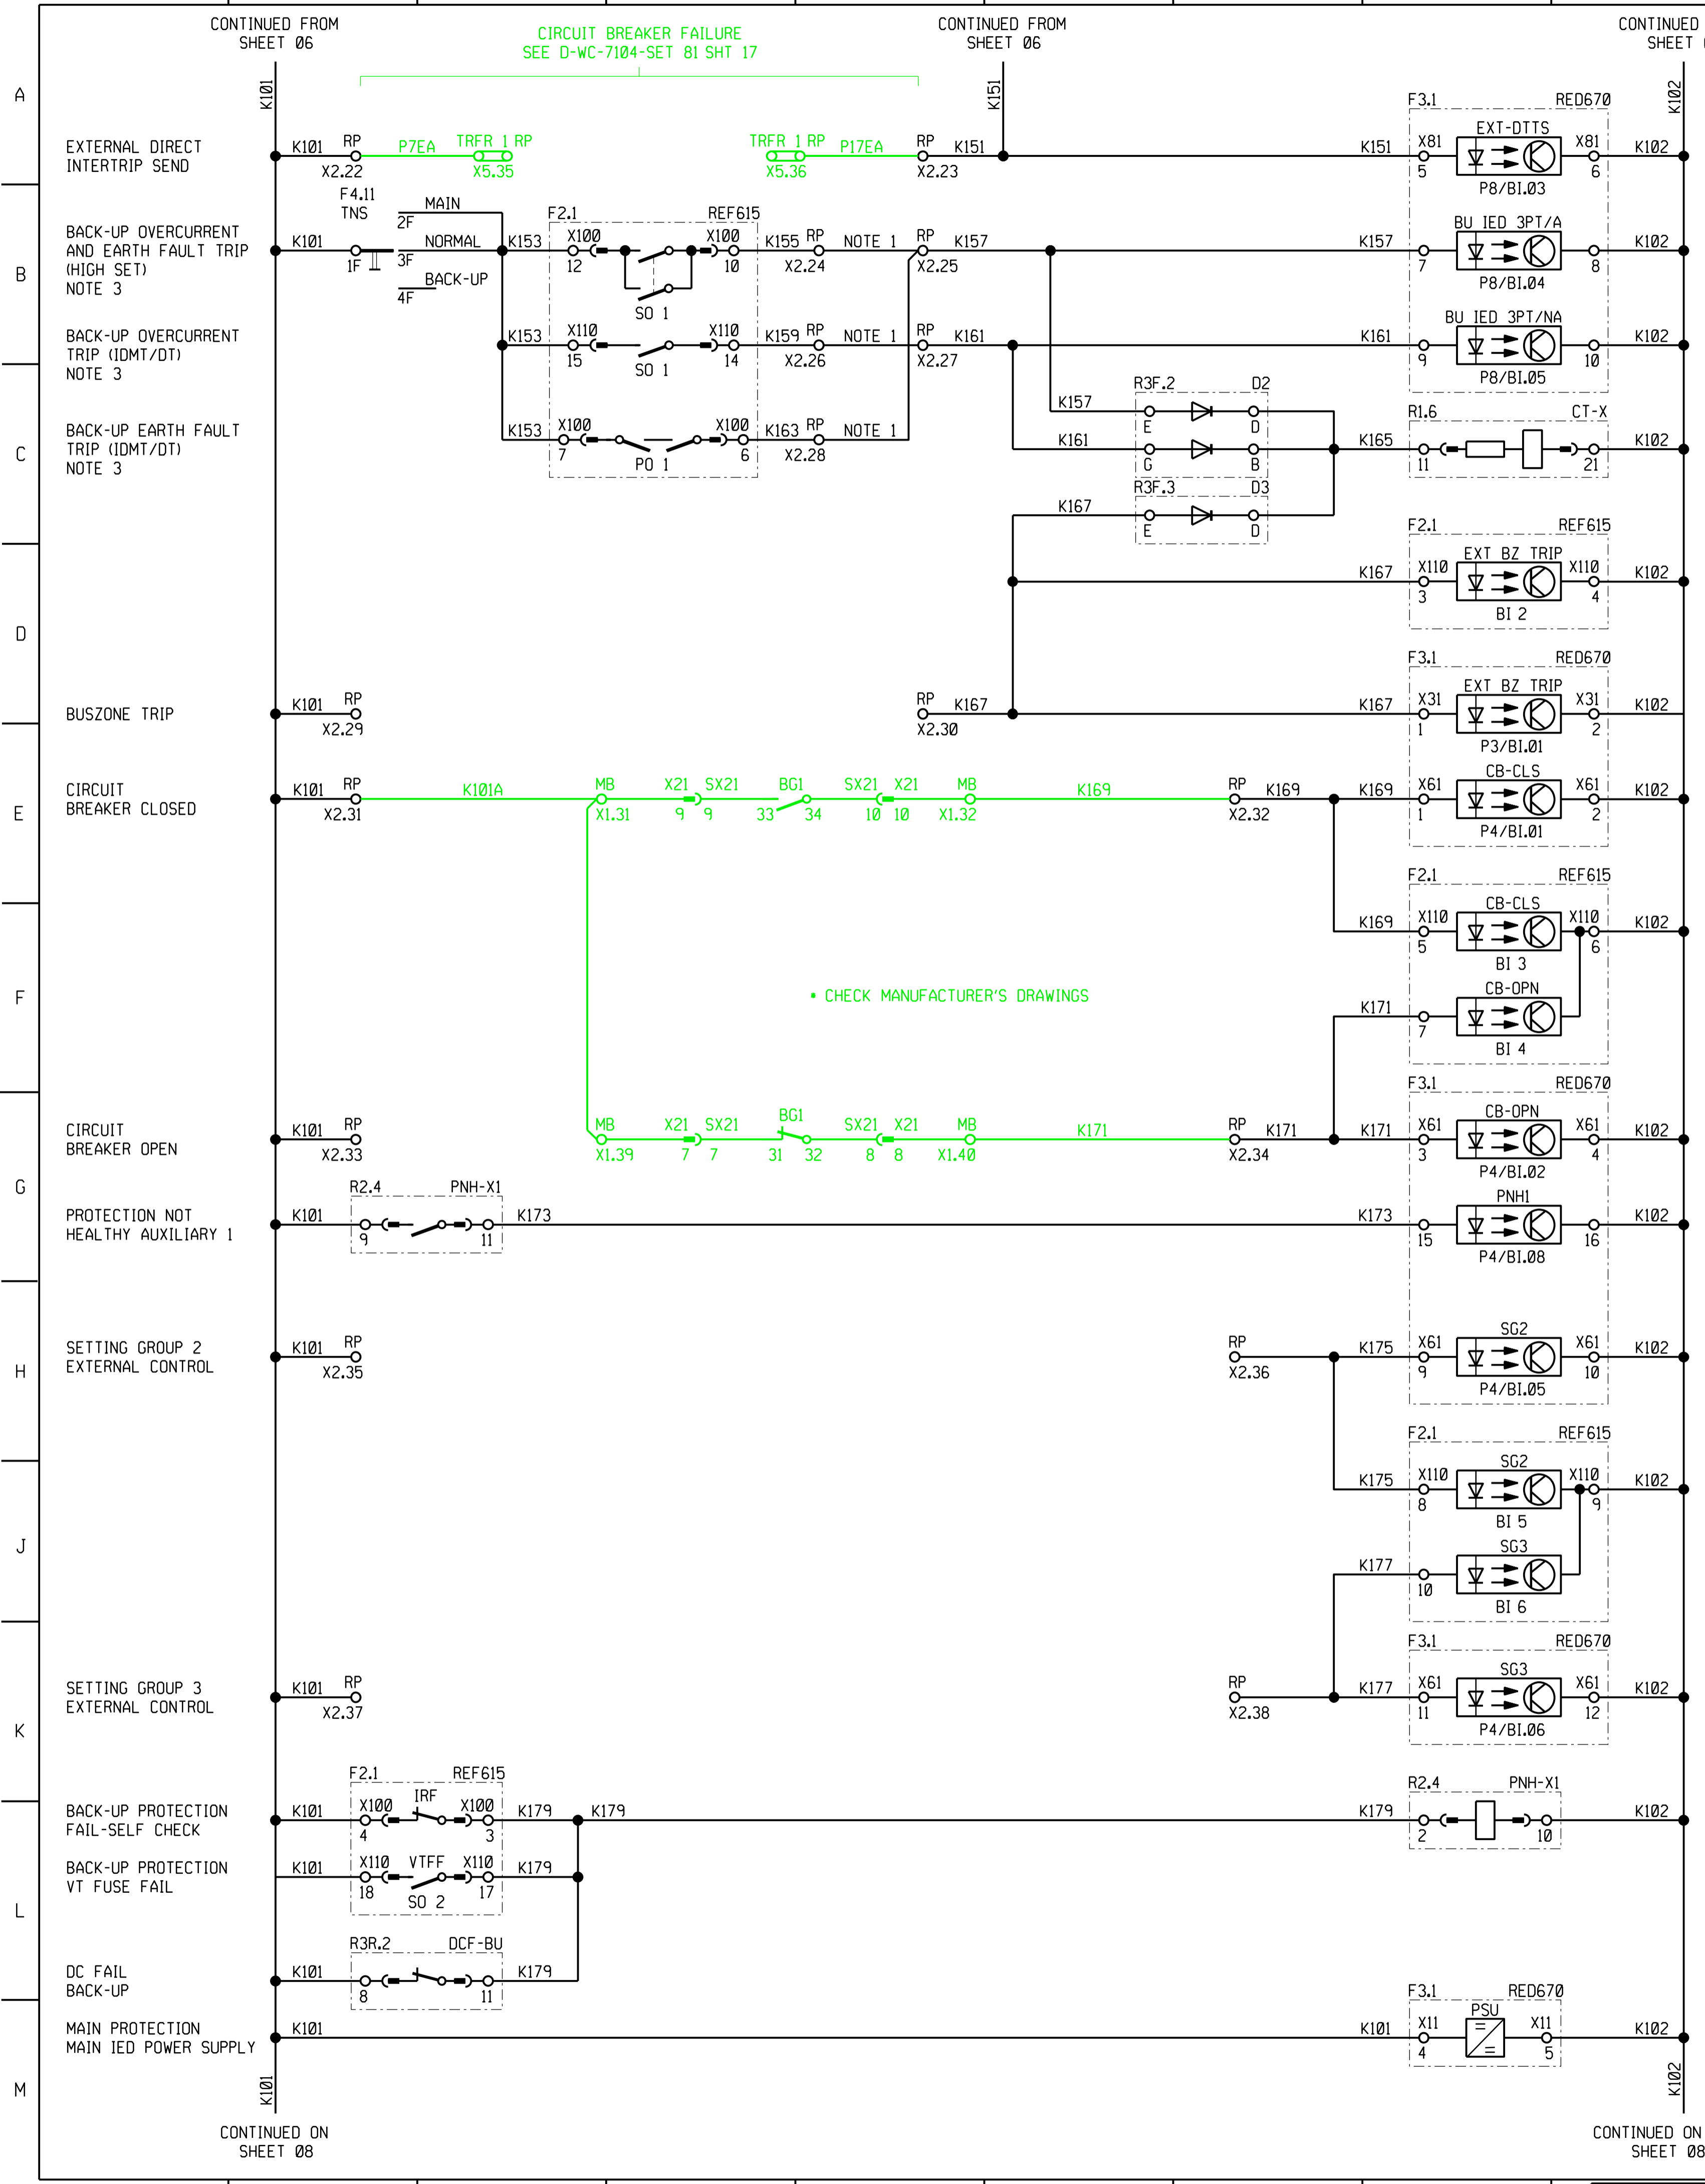

NOTE:

- CONNECT RELAY PANEL TERMINALS AS REQUIRED FOR INITIATION OF AUTO RECLOSE.
- FOR RED670 IMPEDANCE FUNCTION, ZONE 2 INITIATED AUTO-RECLOSE SET GATE 12 TO 'ON' (DEFAULT = 'OFF').
- THESE OUTPUTS OF THE BACK-UP IED (REF615) ARE MASKED/ SET TO 'NON-LATCHED'.

ABB 132kV THREE POLE BREAKER LEGEND	
ITEM	DESCRIPTION
BD1	DENSITY SWITCH
BG1	BREAKER AUXILIARY CONTACTS
BT1	HEATER THERMOSTAT
BW1	SPRING LIMIT SWITCH
E1	HEATER (PERMANENTLY CONNECTED)
E2	HEATER (THERMOSTAT CONTROLLED)
F1	DIRECT ON LINE MOTOR STARTER MCB
F2	MINATURE CIRCUIT BREAKER (HEATER)
K1	AUXILIARY RELAY (SPRING LIMIT SWITCH)
K3	ANTIPUMPING RELAY
K9	SF6 INTERLOCKING RELAY (CLOSE)
K10	SF6 INTERLOCKING RELAY (MAIN TRIP)
K19	AUXILIARY RELAY (THERMOSTAT)
K19.1 & K19.2	CURRENT RELAY (HEATER)
K25	SF6 AUXILIARY RELAY (SF6 LOW GAS ALARM)
KT1	TIME DELAYED RELAY (SPRING CHARGE FAILURE)
MI	SPRING REWIND MOTOR
S4	BREAKER ISOLATOR SWITCH (LOR)
SX11 - SX22	CONNECTION TERMINALS
SXY1 - SXY3	CONNECTION TERMINALS
X1	TERMINAL BLOCK FOR CONNECTIONS
X11 - X22	CONNECTION TERMINALS
XC1 - XC7	CONNECTION POINT
Y1	MAIN TRIP COIL
Y2	BACK-UP TRIP COIL
Y3	CLOSE COIL

SHT 28	ISOLATOR JB
SHT 27	CABLE BLOCK
SHT 26	LINE VT DIAGRAM
SHT 25	CT JB CABLING
SHT 24	CABLING DIAGRAM
SHT 23	CABLING DIAGRAM
SHT 22	CABLING DIAGRAM
SHT 21	REFERENCE DIAG
SHT 20	REFERENCE DIAG
SHT 19	REFERENCE DIAG
SHT 18	DISTUR RECORDER
SHT 17	SUP ALARMS KEY
SHT 16	SUP STATUS, CONT
SHT 15	REA & MEAS KEY
SHT 14	SPR REW, AC KEY
SHT 13	INDICAT, DC KEY
SHT 12	CLOSE DC KEY
SHT 11	BACK-UP DC KEY
SHT 10	BACK-UP DC KEY
SHT 09	BACK-UP DC KEY
SHT 08	TELEPROT DC KEY
SHT 07	MAIN DC KEY
SHT 06	MAIN DC KEY
SHT 05	VT SUPPLY KEY
SHT 04	AC KEY DIAGRAM
SHT 03	SINGLE LINE
SHT 02	LOGIC DIAGRAM
SHT 01	PANEL LAYOUT
DRG No.	REFERENCE DRAWINGS:

AECOM
 CAPE TOWN OFFICE
 WATERSIDE PLACE, SOUTH GATE
 TYGER WATERFRONT
 CARL CRONJE DRIVE
 TEL: +27 (0)21 950 7500
 FAX: +27 (0)21 950 7502
 REG. No. 1966/00628/07

REV	1	66kV VT & CB ADDED, FEEDER RENAMED.	KS	BH	CP	25/06/2021	153272156-00003
REV		REVISION DESCRIPTION	BY	CHKD	AUTH	DATE	PROJECT NUMBER

Eskom

**ISCOR SUBSTATION
66kV FEEDER 1
MAIN DC KEY DIAGRAM**

PROJECT APPROVED	DESIGN APPROVED
C. PYM	A. CRAIB
DATE 25/06/21	DATE 13/13/10
PROJECT CHECKED	DESIGN CHECKED
B. HOMANN	N. MATHONSI
DATE 25/06/21	DATE 13/12/10
DRAWN BY	DRAWN BY
K. STEYNBERG	C. CANNON
DATE 25/06/21	DATE 26/02/10

D-WC-7104 61 07 1

PANEL TYPE DESIGNATION 4FZD-3920

LEVELS 1 2 5 10 11 12 20 21 22 25 28


MASTER TRACING FILED UNDER D-OT-15007 SHEET 07 OF 28 REVISION 2

A
B
C
D
E
F
G
H
J
K
L
M

A
B
C
D
E
F
G
H
J
K
L
M

CONTINUED FROM SHEET 07


CONTINUED FROM SHEET 07

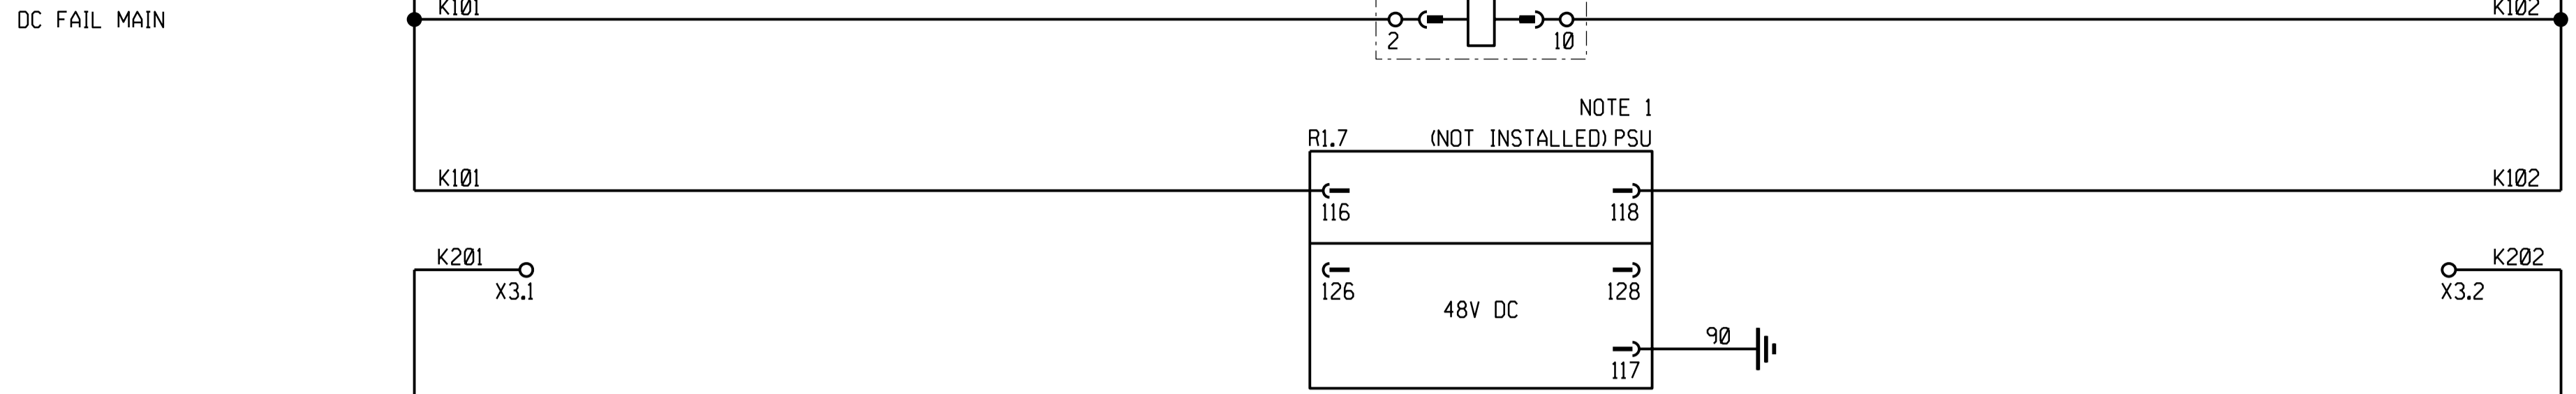


POWER LINE CARRIER OR NSD570 EXTERNAL TELEPROTECTION OR SIMILAR ITEM

X21 INTERNAL COMMUNICATION/TELEPROTECTION (NOT USED)

- PERMISSIVE INTERTRIP RECEIVED
- DIRECT INTERTRIP RECEIVED
- CARRIER GUARD SIGNAL ON NOTE 3
- DIRECTIONAL EARTH - FAULT RECEIVED (NOT USED)
- PERMISSIVE INTERTRIP SEND
- DIRECT INTERTRIP SEND
- DIRECTIONAL EARTH FAULT SEND (NOT USED)
- NOT USED (DEF_TX TEST OUTPUT)

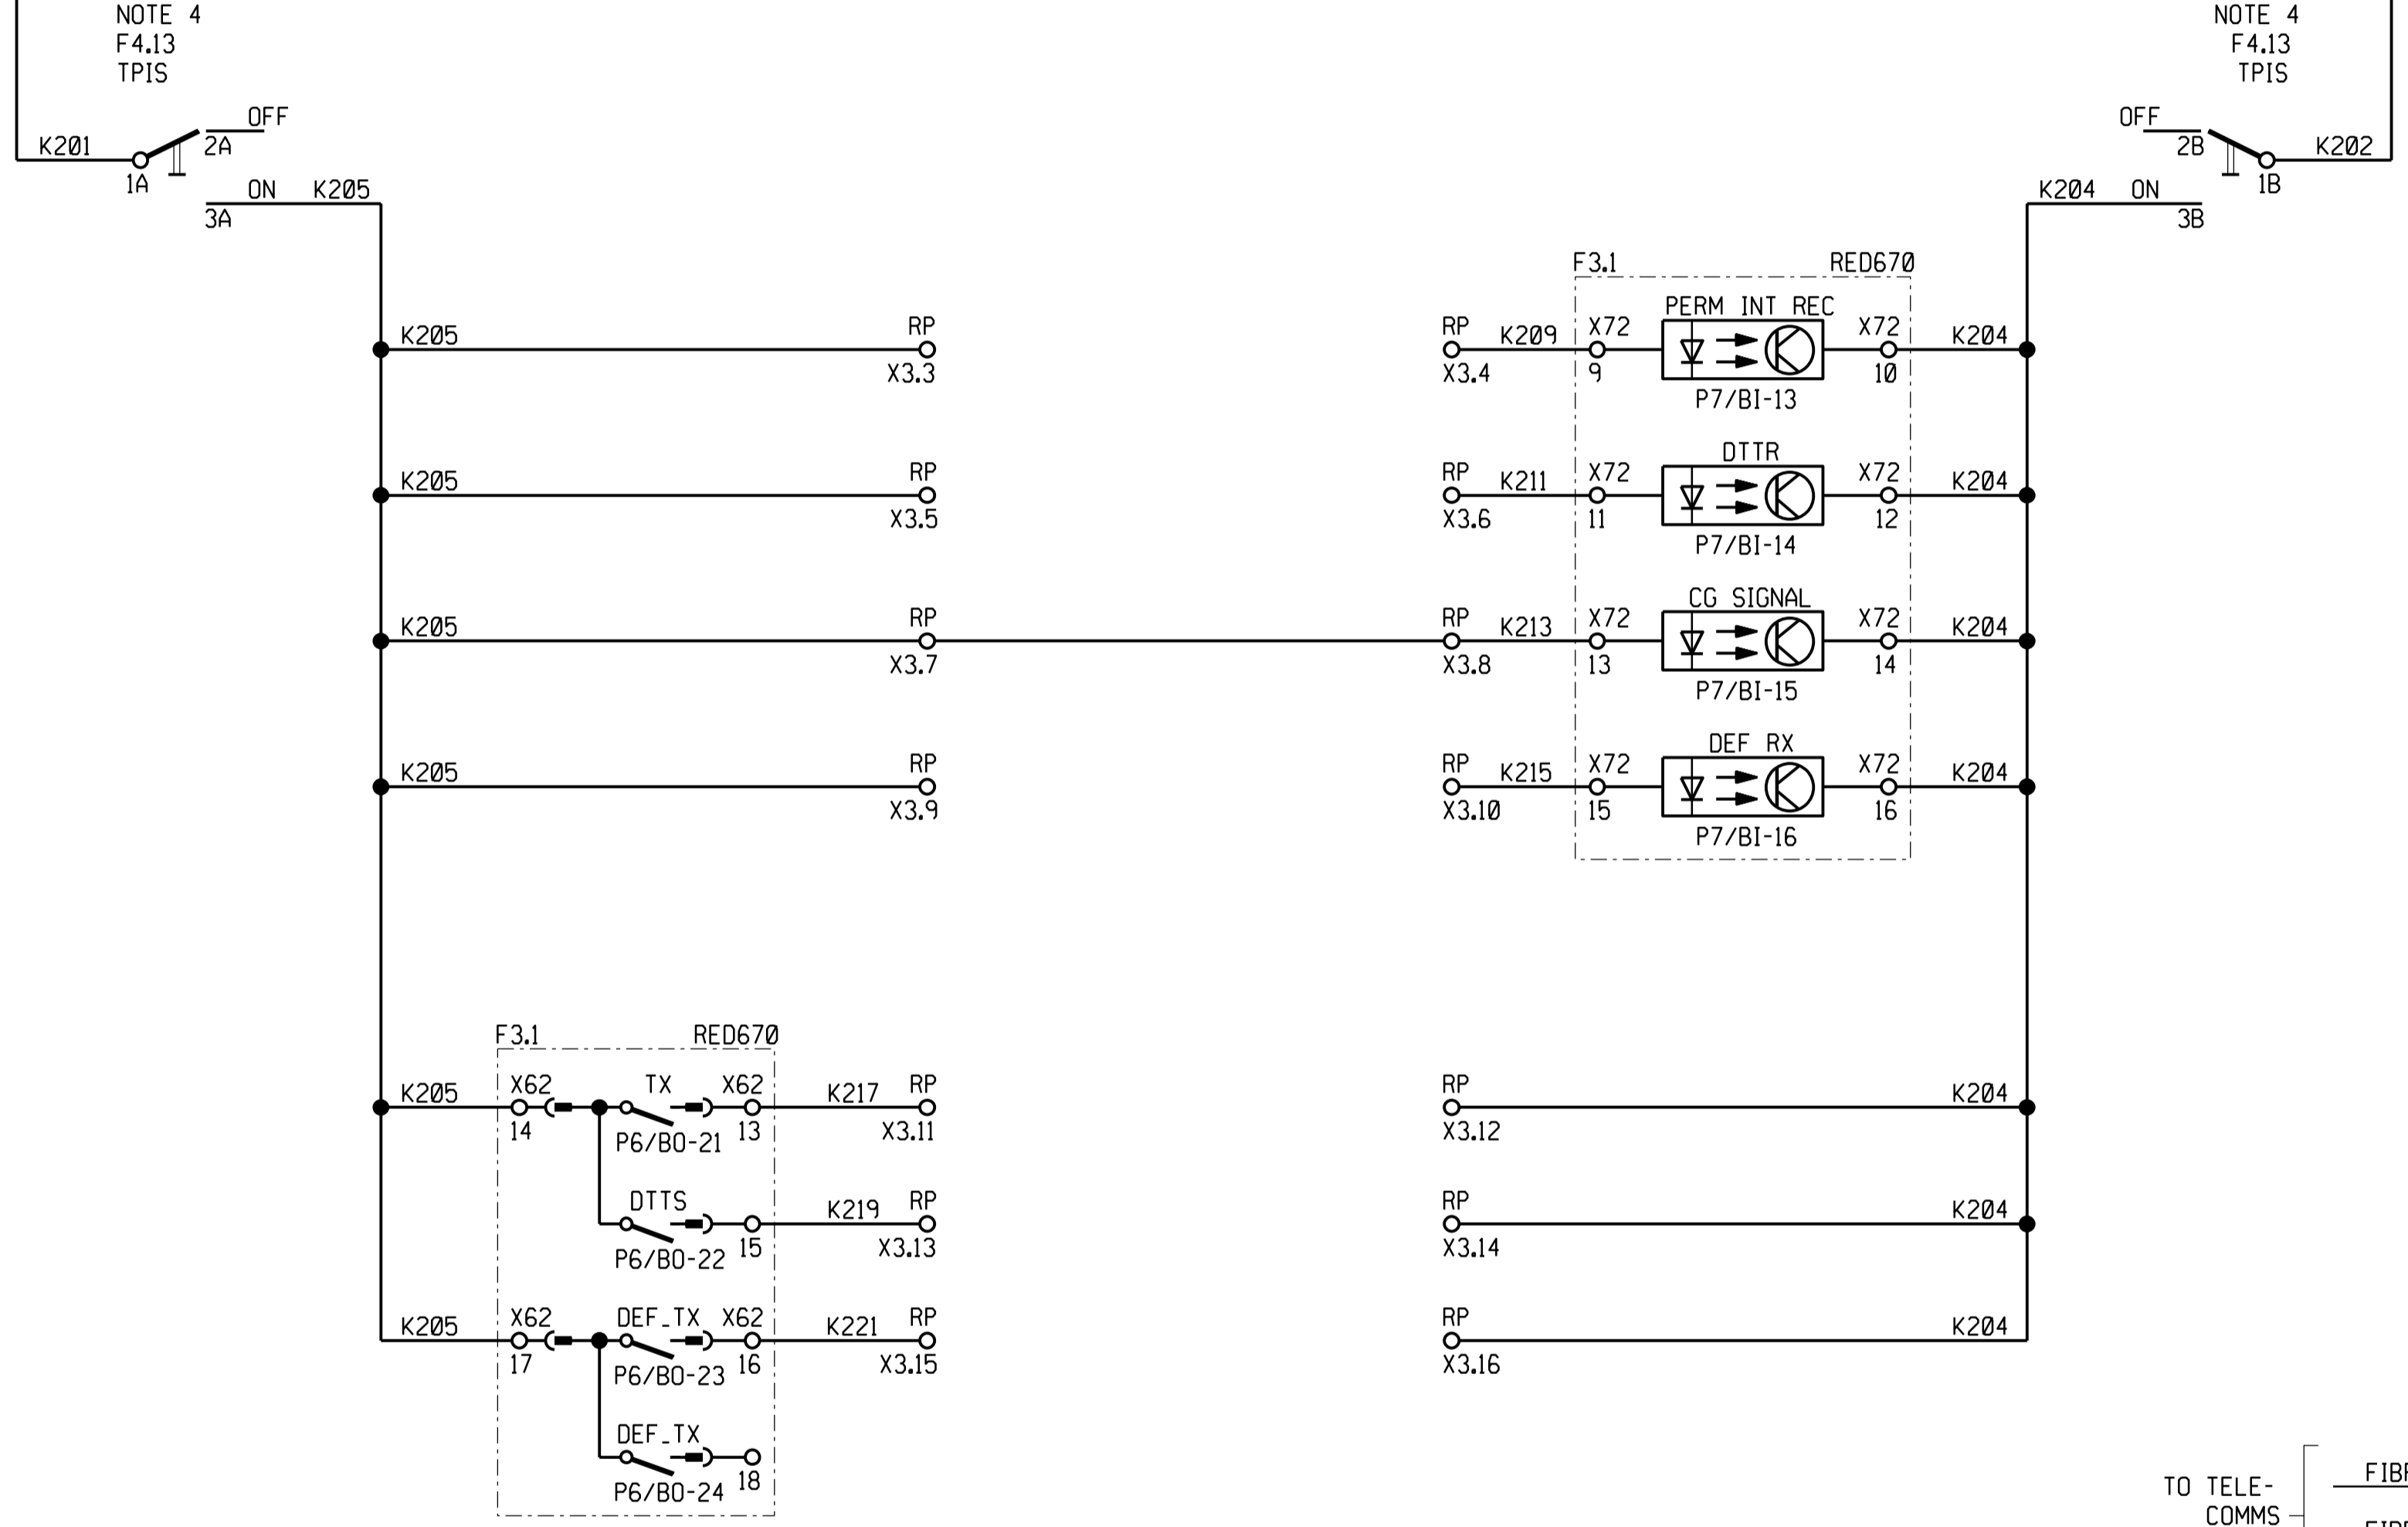

FIBRE INTERNAL COMMUNICATION/TELEPROTECTION AND/ OR DIFFERENTIAL

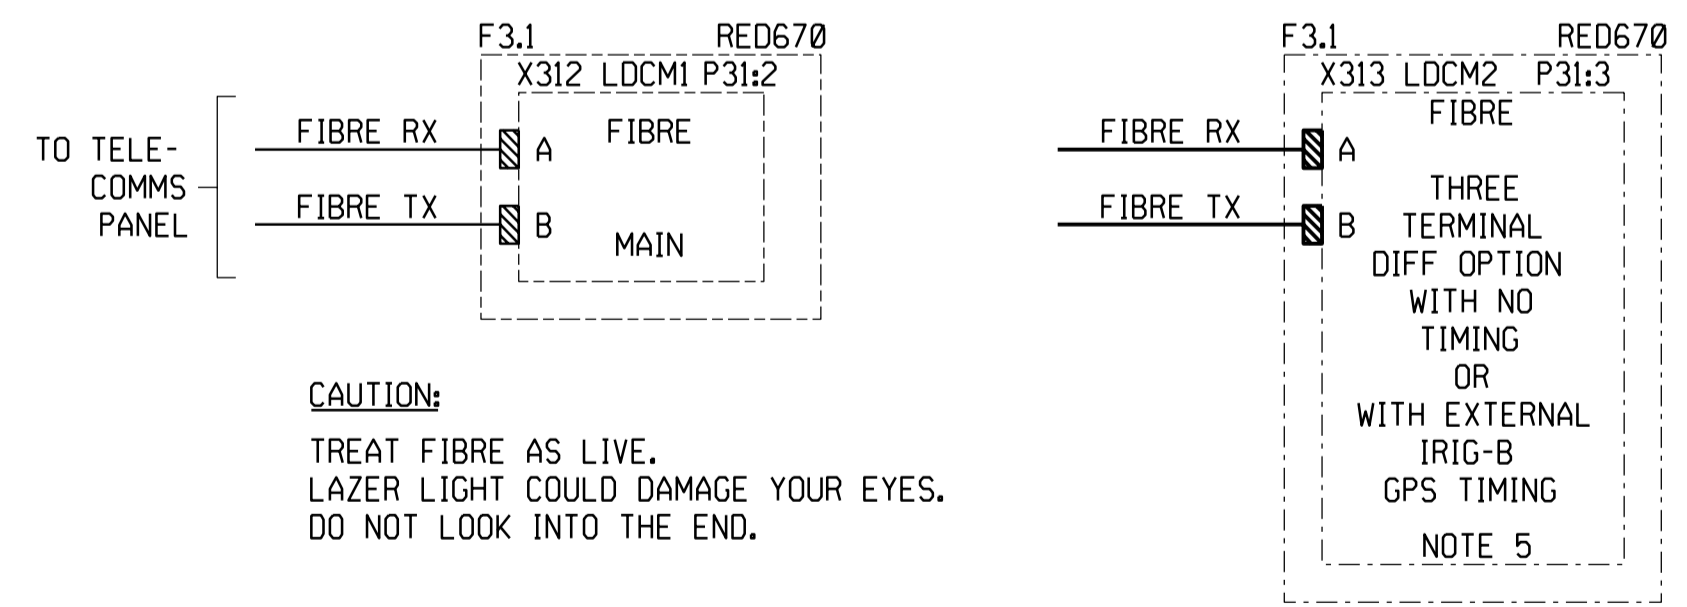

CAUTION:
TREAT FIBRE AS LIVE.
LAZER LIGHT COULD DAMAGE YOUR EYES.
DO NOT LOOK INTO THE END.

- NOTE:
- THE 110/48 VOLT DC/DC CONVERTER IS OPTIONAL. THE SUBSTATION 48 VOLT DC SUPPLY CAN BE USED IF AVAILABLE.
 - NO GROUND - LEAVE CONNECTOR WITHOUT ANY CONNECTION
DIRECT GROUND - CONNECT PIN 2 DIRECTLY TO EARTH
SOFT GROUND - CONNECT PIN 1 TO PIN 2
 - SET GATE 1 IN SETTINGS TO 'ON' TO ENABLE INTERNAL COMMUNICATION/ TELEPROTECTION
FAIL LOGIC ('ON' IS THE DEFAULT). SET GATE 1 TO 'OFF' IF THE EXTERNAL CARRIER GUARD IS USED OR IF THE INT.COMM/TELEPROTECTION CARD IS NOT USED.
 - REMOTE DIFF ISOLATION:
SIMULTANEOUSLY SWITCH THE LOCAL & REMOTE TPIS SWITCHES TO 'OFF',
ALTERNATIVELY, REMOVE THE TX & RX FIBRES FROM ONE IED.
 - THE INTERNAL GPS TIMING CARD (OPTIONAL) USES SLOT P31:3 X313.
THE EXTERNAL GPS TIMING INPUT CARD (OPTIONAL) USES SLOT P30:2 X302.
DEPENDANT ON IF ONE OF THE ABOVE CARDS ARE ORDERED, THE THREE TERMINAL DIFF COMMUNICATION CARD (OPTIONAL), WOULD BE PLACED IN THE UNUSED SLOT (i.e. SLOT P31:3 X313 OR P30:2 X302). IF NEITHER TIMING CARD IS ORDERED BUT THE THREE TERMINAL DIFF COMMUNICATION CARD IS ORDERED, IT WILL BE PLACED IN SLOT P31:3 X313.

SHT 28	ISOLATOR JB
SHT 27	CABLE BLOCK
SHT 26	LINE VT DIAGRAM
SHT 25	CT JB CABLING
SHT 24	CABLING DIAGRAM
SHT 23	CABLING DIAGRAM
SHT 22	CABLING DIAGRAM
SHT 21	REFERENCE DIAG
SHT 20	REFERENCE DIAG
SHT 19	REFERENCE DIAG
SHT 18	DISTUR RECORDER
SHT 17	SUP ALARMS KEY
SHT 16	SUP STATUS, CONT
SHT 15	REA & MEAS KEY
SHT 14	SPR REW, AC KEY
SHT 13	INDICAT, DC KEY
SHT 12	CLOSE DC KEY
SHT 11	BACK-UP DC KEY
SHT 10	BACK-UP DC KEY
SHT 09	BACK-UP DC KEY
SHT 08	TELEPROT DC KEY
SHT 07	MAIN DC KEY
SHT 06	MAIN DC KEY
SHT 05	VT SUPPLY KEY
SHT 04	AC KEY DIAGRAM
SHT 03	SINGLE LINE
SHT 02	LOGIC DIAGRAM
SHT 01	PANEL LAYOUT
DRG No.	REFERENCE DRAWINGS:

REV				REVISION DESCRIPTION				BY	CHKD	AUTH	DATE	PROJECT NUMBER																							
												153272156-00003																							
PROJECT APPROVED				DESIGN APPROVED																															
C. PYM				A. BRAIB																															
DATE 25/06/21				DATE 13/13/10																															
PROJECT CHECKED				DESIGN CHECKED																															
B. HOMANN				N. MATHONSI																															
DATE 25/06/21				DATE 13/12/10																															
DRAWN BY				DRAWN BY																															
K. STEYBERG				C. CONNON																															
DATE 25/06/21				DATE 26/02/10																															
<table border="1"> <tr> <td>REV</td> <td>AUTH</td> <td>DATE</td> <td>REVISION TO MASTER</td> <td>BY</td> <td>CHKD</td> <td>SCALE</td> </tr> <tr> <td>-</td> <td>-</td> <td>-</td> <td>-</td> <td>-</td> <td>-</td> <td>-</td> </tr> </table>												REV	AUTH	DATE	REVISION TO MASTER	BY	CHKD	SCALE	-	-	-	-	-	-	-	<table border="1"> <tr> <td>SET NUMBER</td> <td>SHEET NUMBER</td> <td>REVISION</td> </tr> <tr> <td>D-WC-7104</td> <td>61</td> <td>08</td> </tr> <tr> <td></td> <td></td> <td>0</td> </tr> </table>	SET NUMBER	SHEET NUMBER	REVISION	D-WC-7104	61	08			0
REV	AUTH	DATE	REVISION TO MASTER	BY	CHKD	SCALE																													
-	-	-	-	-	-	-																													
SET NUMBER	SHEET NUMBER	REVISION																																	
D-WC-7104	61	08																																	
		0																																	
												<table border="1"> <tr> <td>LEVELS</td> <td>1</td> <td>2</td> <td>4</td> <td>5</td> <td>10</td> <td>11</td> <td>12</td> <td>20</td> <td>21</td> <td>22</td> <td>25</td> <td>28</td> </tr> </table>	LEVELS	1	2	4	5	10	11	12	20	21	22	25	28										
LEVELS	1	2	4	5	10	11	12	20	21	22	25	28																							
<p>PANEL TYPE DESIGNATION 4FZD-3920</p>												<p>SIZE GROOTTE A1L</p>																							

MASTER TRACING FILED UNDER D-DT-15007 SHEET 08 OF 28 REVISION 2



CONTINUED FROM SHEET 10

CONTINUED FROM SHEET 10

- NOTE:**
1. A PERMANENT INPUT IS REQUIRED TO BLOCK AN EXTERNAL CLOSE.
 2. THIS BYPASS LOGIC IS USED FOR THE SUPERVISORY DNP3 STATUS, THE HMI DISPLAY AND THE AUTOMATED REMOTE ARC BYPASS AND DIFF OUT OF SERVICE SELECTION LOGIC. NOTE THAT A 'G' ISOLATOR CONTACT MUST BE USED FOR THE 'ON' SELECTION AND A 'N' ISOLATOR CONTACT MUST BE USED FOR THE 'OFF' SELECTION.

ABB 132kV THREE POLE BREAKER LEGEND	
ITEM	DESCRIPTION
BD1	DENSITY SWITCH
BG1	BREAKER AUXILIARY CONTACTS
BT1	HEATER THERMOSTAT
BW1	SPRING LIMIT SWITCH
E1	HEATER (PERMANENTLY CONNECTED)
E2	HEATER (THERMOSTAT CONTROLLED)
F1	DIRECT ON LINE MOTOR STARTER MCB
F2	MINATURE CIRCUIT BREAKER (HEATER)
K1	AUXILIARY RELAY (SPRING LIMIT SWITCH)
K3	ANTI-PUMPING RELAY
K9	SF6 INTERLOCKING RELAY (CLOSE)
K10	SF6 INTERLOCKING RELAY (MAIN TRIP)
K19	AUXILIARY RELAY (THERMOSTAT)
K19.1 & K19.2	CURRENT RELAY (HEATER)
K25	SF6 AUXILIARY RELAY (SF6 LOW GAS ALARM)
KT1	TIME DELAYED RELAY (SPRING CHARGE FAILURE)
M1	SPRING REWIND MOTOR
S4	BREAKER ISOLATOR SWITCH (LOR)
SX11 - SX22	CONNECTION TERMINALS
SXY1 - SXY3	CONNECTION TERMINALS
X1	TERMINAL BLOCK FOR CONNECTIONS
X11 - X22	CONNECTION TERMINALS
XC1 - XC7	CONNECTION POINT
Y1	MAIN TRIP COIL
Y2	BACK-UP TRIP COIL
Y3	CLOSE COIL

SHT 28	ISOLATOR JB
SHT 27	CABLE BLOCK
SHT 26	LINE VT DIAGRAM
SHT 25	CT JB CABLING
SHT 24	CABLING DIAGRAM
SHT 23	CABLING DIAGRAM
SHT 22	CABLING DIAGRAM
SHT 21	REFERENCE DIAG
SHT 20	REFERENCE DIAG
SHT 19	REFERENCE DIAG
SHT 18	DISTUR RECORDER
SHT 17	SUP ALARMS KEY
SHT 16	SUP STATUS, CONT
SHT 15	REA & MEAS KEY
SHT 14	SPR REW, AC KEY
SHT 13	INDICAT, DC KEY
SHT 12	CLOSE DC KEY
SHT 11	BACK-UP DC KEY
SHT 10	BACK-UP DC KEY
SHT 09	BACK-UP DC KEY
SHT 08	TELEPROT DC KEY
SHT 07	MAIN DC KEY
SHT 06	MAIN DC KEY
SHT 05	VT SUPPLY KEY
SHT 04	AC KEY DIAGRAM
SHT 03	SINGLE LINE
SHT 02	LOGIC DIAGRAM
SHT 01	PANEL LAYOUT
DRG No.	REFERENCE DRAWINGS:

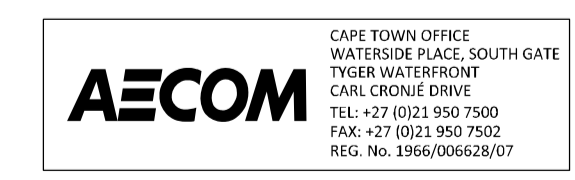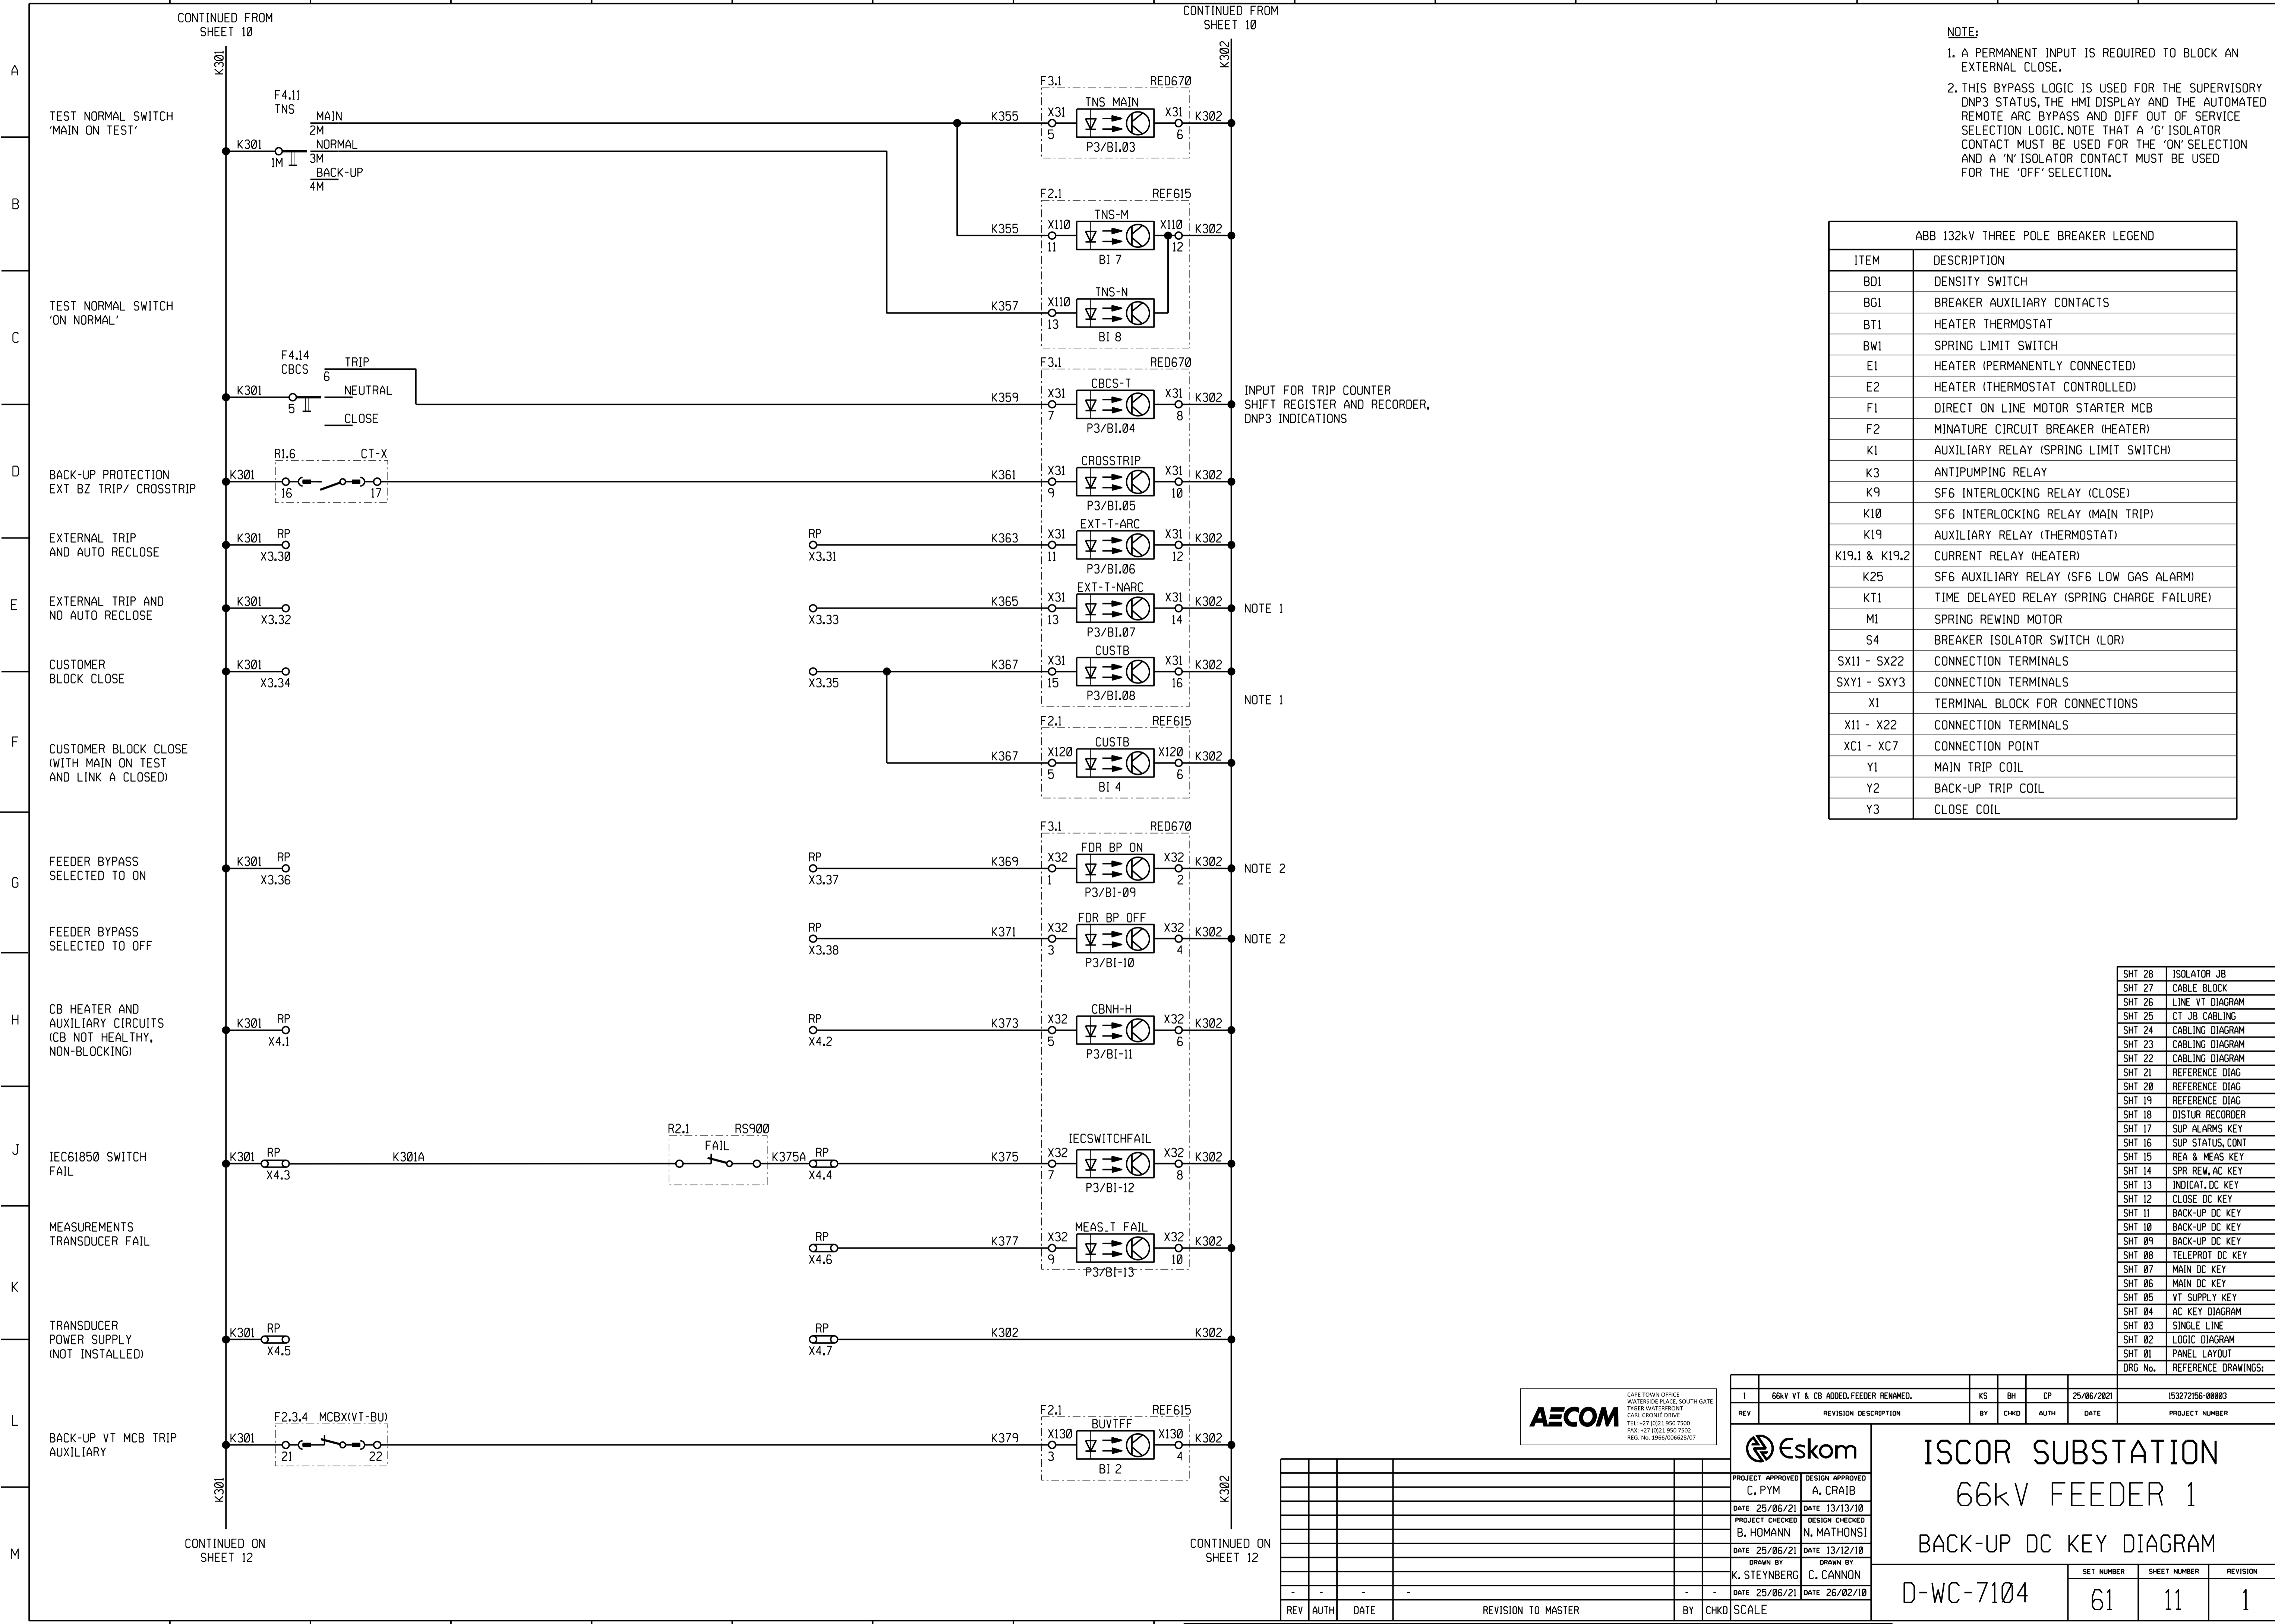


1	66kV VT & CB ADDED, FEEDER RENAMED.	KS	BH	CP	25/06/2021	153272156-00003
REV	REVISION DESCRIPTION	BY	CHKD	AUTH	DATE	PROJECT NUMBER

ISCOR SUBSTATION
66kV FEEDER 1
BACK-UP DC KEY DIAGRAM

PROJECT APPROVED	A. CRAIB
DESIGN APPROVED	
DATE 25/06/21	DATE 13/13/10
PROJECT CHECKED	B. HOMANN
DESIGN CHECKED	N. MATHONSI
DATE 25/06/21	DATE 13/12/10
DRAWN BY	C. CANNON
DATE 25/06/21	DATE 26/02/10

REV	AUTH	DATE	REVISION TO MASTER	BY	CHKD	SCALE
-	-	-	-	-	-	-


MASTER TRACING FILED UNDER D-DT-15007 SHEET 11 OF 28 REVISION 2

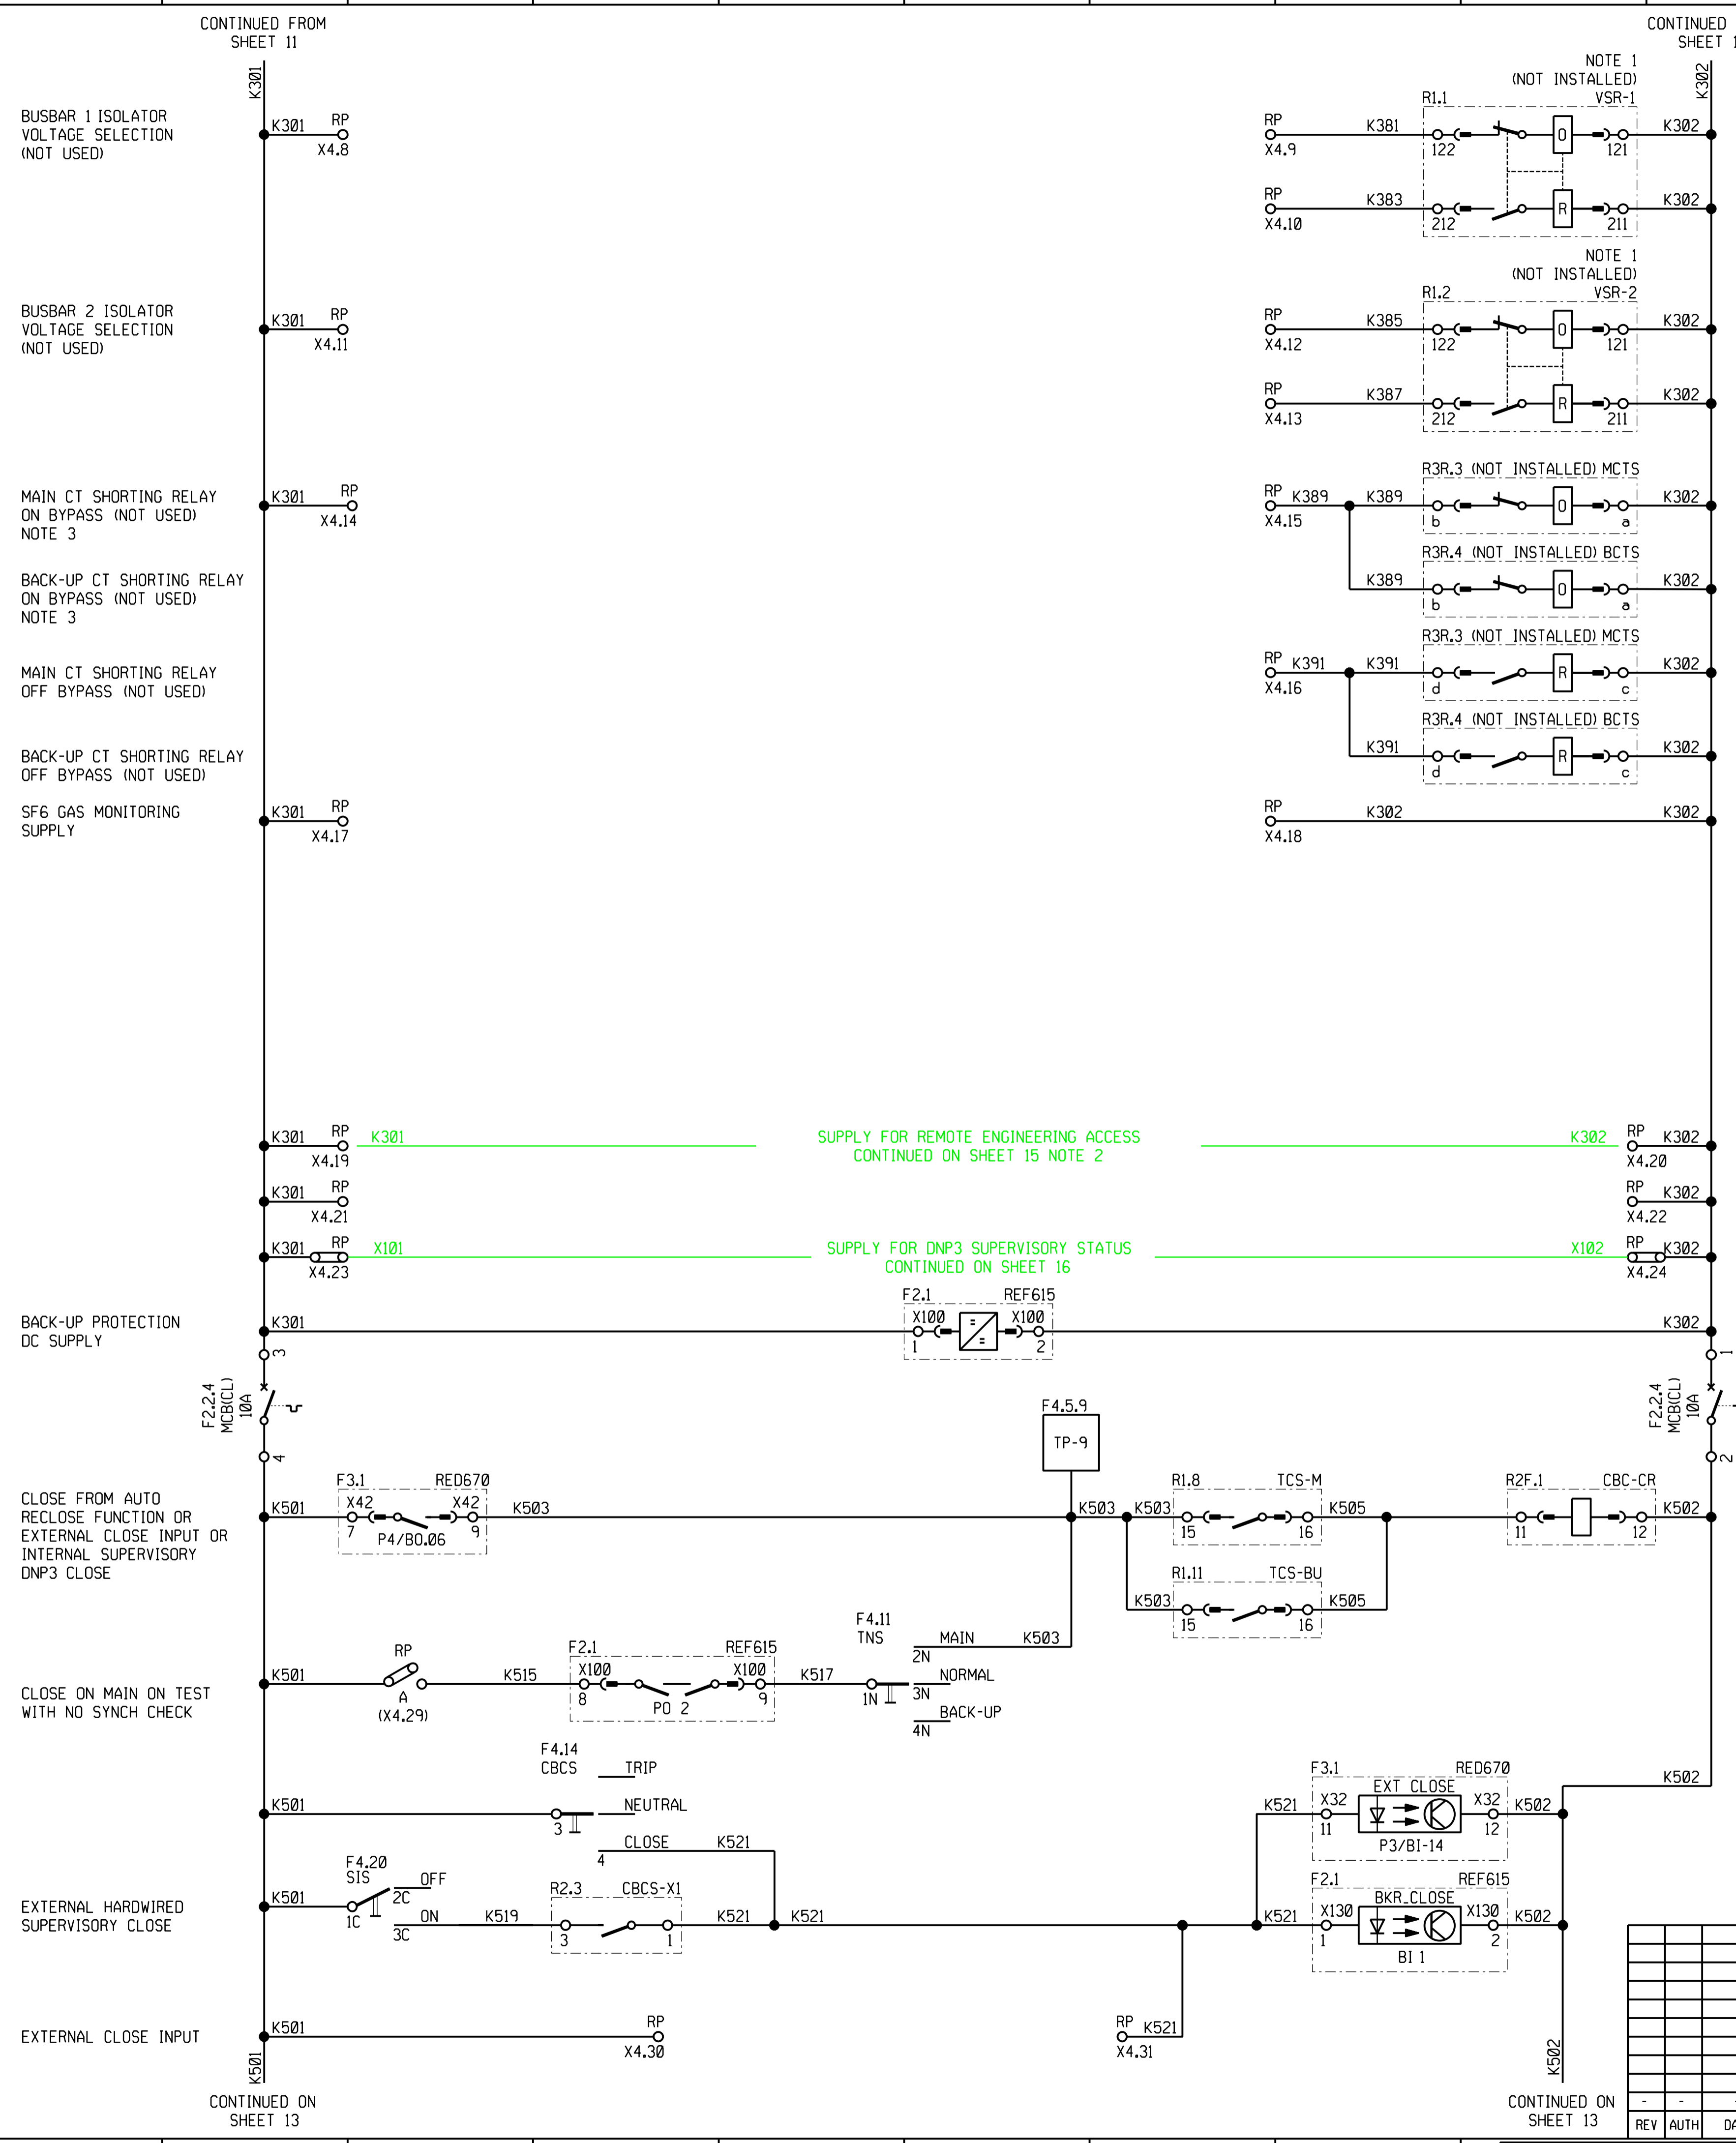

- NOTE:**
1. ALL OPTIONS ARE WIRED IN, ONLY THE OPTIONAL RELAYS NEED TO BE INSERTED TO SELECT THE SPECIFIC OPTION.
 2. ESKOM TO INSTALL JUMPERS TO BACKPLATE MODULES ON SITE IF THE OPTION IS ORDERED.
 3. FOR CT SHORTING ON BYPASS, 'GS' CONTACTS AND 'N' CONTACTS OF THE ISOLATOR MUST BE USED.

ABB 132kV THREE POLE BREAKER LEGEND	
ITEM	DESCRIPTION
BD1	DENSITY SWITCH
BG1	BREAKER AUXILIARY CONTACTS
BT1	HEATER THERMOSTAT
BW1	SPRING LIMIT SWITCH
E1	HEATER (PERMANENTLY CONNECTED)
E2	HEATER (THERMOSTAT CONTROLLED)
F1	DIRECT ON LINE MOTOR STARTER MCB
F2	MINIATURE CIRCUIT BREAKER (HEATER)
K1	AUXILIARY RELAY (SPRING LIMIT SWITCH)
K3	ANTI-PUMPING RELAY
K9	SF6 INTERLOCKING RELAY (CLOSE)
K10	SF6 INTERLOCKING RELAY (MAIN TRIP)
K19	AUXILIARY RELAY (THERMOSTAT)
K19.1 & K19.2	CURRENT RELAY (HEATER)
K25	SF6 AUXILIARY RELAY (SF6 LOW GAS ALARM)
KT1	TIME DELAYED RELAY (SPRING CHARGE FAILURE)
M1	SPRING REWIND MOTOR
S4	BREAKER ISOLATOR SWITCH (LOR)
SX11 - SX22	CONNECTION TERMINALS
SXY1 - SXY3	CONNECTION TERMINALS
X1	TERMINAL BLOCK FOR CONNECTIONS
X11 - X22	CONNECTION TERMINALS
XC1 - XC7	CONNECTION POINT
Y1	MAIN TRIP COIL
Y2	BACK-UP TRIP COIL
Y3	CLOSE COIL

SHT 28	ISOLATOR JB
SHT 27	CABLE BLOCK
SHT 26	LINE VT DIAGRAM
SHT 25	CT JB CABLING
SHT 24	CABLING DIAGRAM
SHT 23	CABLING DIAGRAM
SHT 22	CABLING DIAGRAM
SHT 21	REFERENCE DIAG
SHT 20	REFERENCE DIAG
SHT 19	REFERENCE DIAG
SHT 18	DISTUR RECORDER
SHT 17	SUP ALARMS KEY
SHT 16	SUP STATUS, CONT
SHT 15	REA & MEAS KEY
SHT 14	SPR REW, AC KEY
SHT 13	INDICAT, DC KEY
SHT 12	CLOSE DC KEY
SHT 11	BACK-UP DC KEY
SHT 10	BACK-UP DC KEY
SHT 09	BACK-UP DC KEY
SHT 08	TELEPROT DC KEY
SHT 07	MAIN DC KEY
SHT 06	MAIN DC KEY
SHT 05	VT SUPPLY KEY
SHT 04	AC KEY DIAGRAM
SHT 03	SINGLE LINE
SHT 02	LOGIC DIAGRAM
SHT 01	PANEL LAYOUT
DRG No.	REFERENCE DRAWINGS:

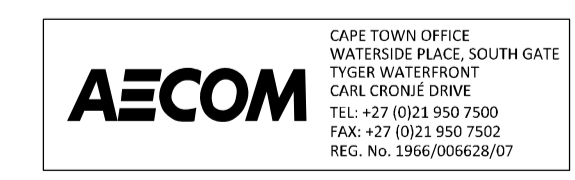

1	66kV VT & CB ADDED, FEEDER RENAMED.	KS	BH	CP	25/06/2021	153272156-00003
REV	REVISION DESCRIPTION	BY	CHKD	AUTH	DATE	PROJECT NUMBER

Eskom

ISCOR SUBSTATION 66kV FEEDER 1 CLOSE DC KEY DIAGRAM

D-WC-7104 SET NUMBER: 61 SHEET NUMBER: 12 REVISION: 1

PANEL TYPE DESIGNATION 4FZD-3920 SIZE GRID/TITLE A1L



PROJECT APPROVED	C. PYM	DESIGN APPROVED	A. CRAIB
DATE	25/06/21	DATE	13/13/10
PROJECT CHECKED	B. HOMANN	DESIGN CHECKED	N. MATHONSI
DATE	25/06/21	DATE	13/12/10
DRAWN BY	K. STEYNBERG	DRAWN BY	C. CANNON
DATE	25/06/21	DATE	26/02/10

MASTER TRACING FILED UNDER D-DT-15007 SHEET 12 OF 28 REVISION 2

CONTINUED FROM SHEET 12

CONTINUED FROM SHEET 12

ABB 132kV THREE POLE BREAKER LEGEND	
ITEM	DESCRIPTION
BD1	DENSITY SWITCH
BG1	BREAKER AUXILIARY CONTACTS
BT1	HEATER THERMOSTAT
BW1	SPRING LIMIT SWITCH
E1	HEATER (PERMANENTLY CONNECTED)
E2	HEATER (THERMOSTAT CONTROLLED)
F1	DIRECT ON LINE MOTOR STARTER MCB
F2	MINATURE CIRCUIT BREAKER (HEATER)
K1	AUXILIARY RELAY (SPRING LIMIT SWITCH)
K3	ANTI-PUMPING RELAY
K9	SF6 INTERLOCKING RELAY (CLOSE)
K10	SF6 INTERLOCKING RELAY (MAIN TRIP)
K19	AUXILIARY RELAY (THERMOSTAT)
K19.1 & K19.2	CURRENT RELAY (HEATER)
K25	SF6 AUXILIARY RELAY (SF6 LOW GAS ALARM)
KT1	TIME DELAYED RELAY (SPRING CHARGE FAILURE)
M1	SPRING REWIND MOTOR
S4	BREAKER ISOLATOR SWITCH (LDR)
SX11 - SX22	CONNECTION TERMINALS
SXY1 - SXY3	CONNECTION TERMINALS
X1	TERMINAL BLOCK FOR CONNECTIONS
X11 - X22	CONNECTION TERMINALS
XC1 - XC7	CONNECTION POINT
Y1	MAIN TRIP COIL
Y2	BACK-UP TRIP COIL
Y3	CLOSE COIL

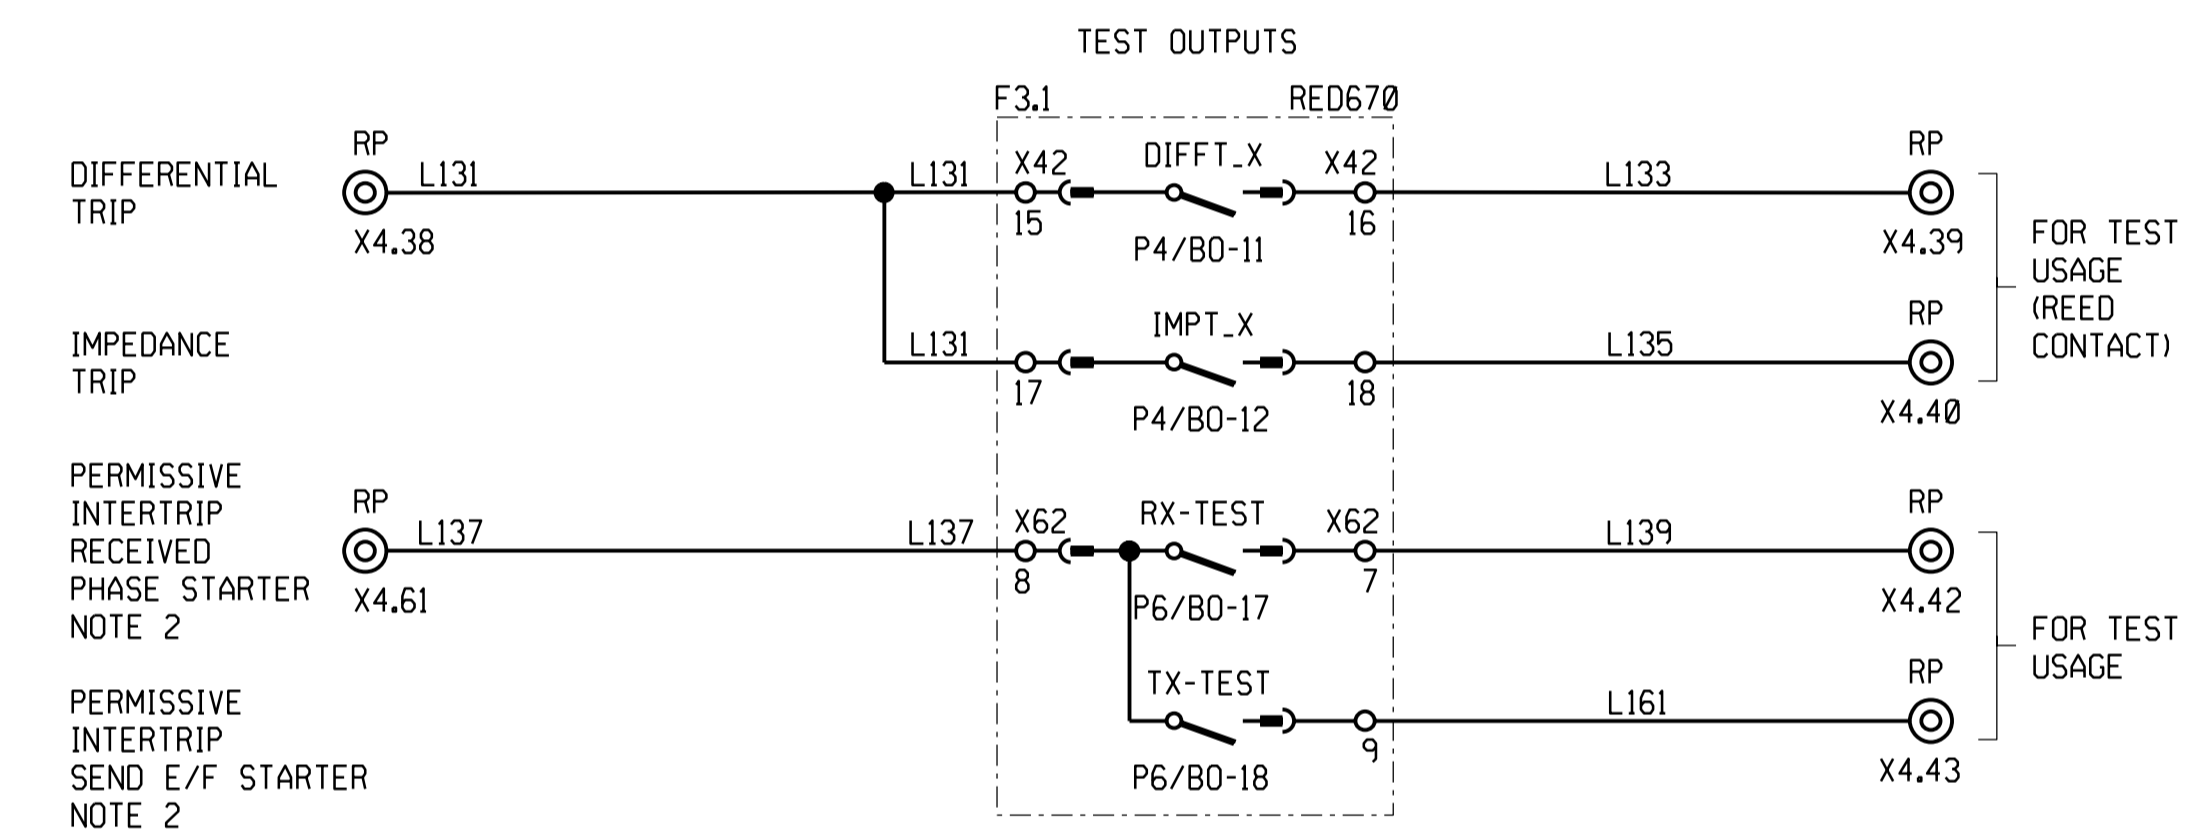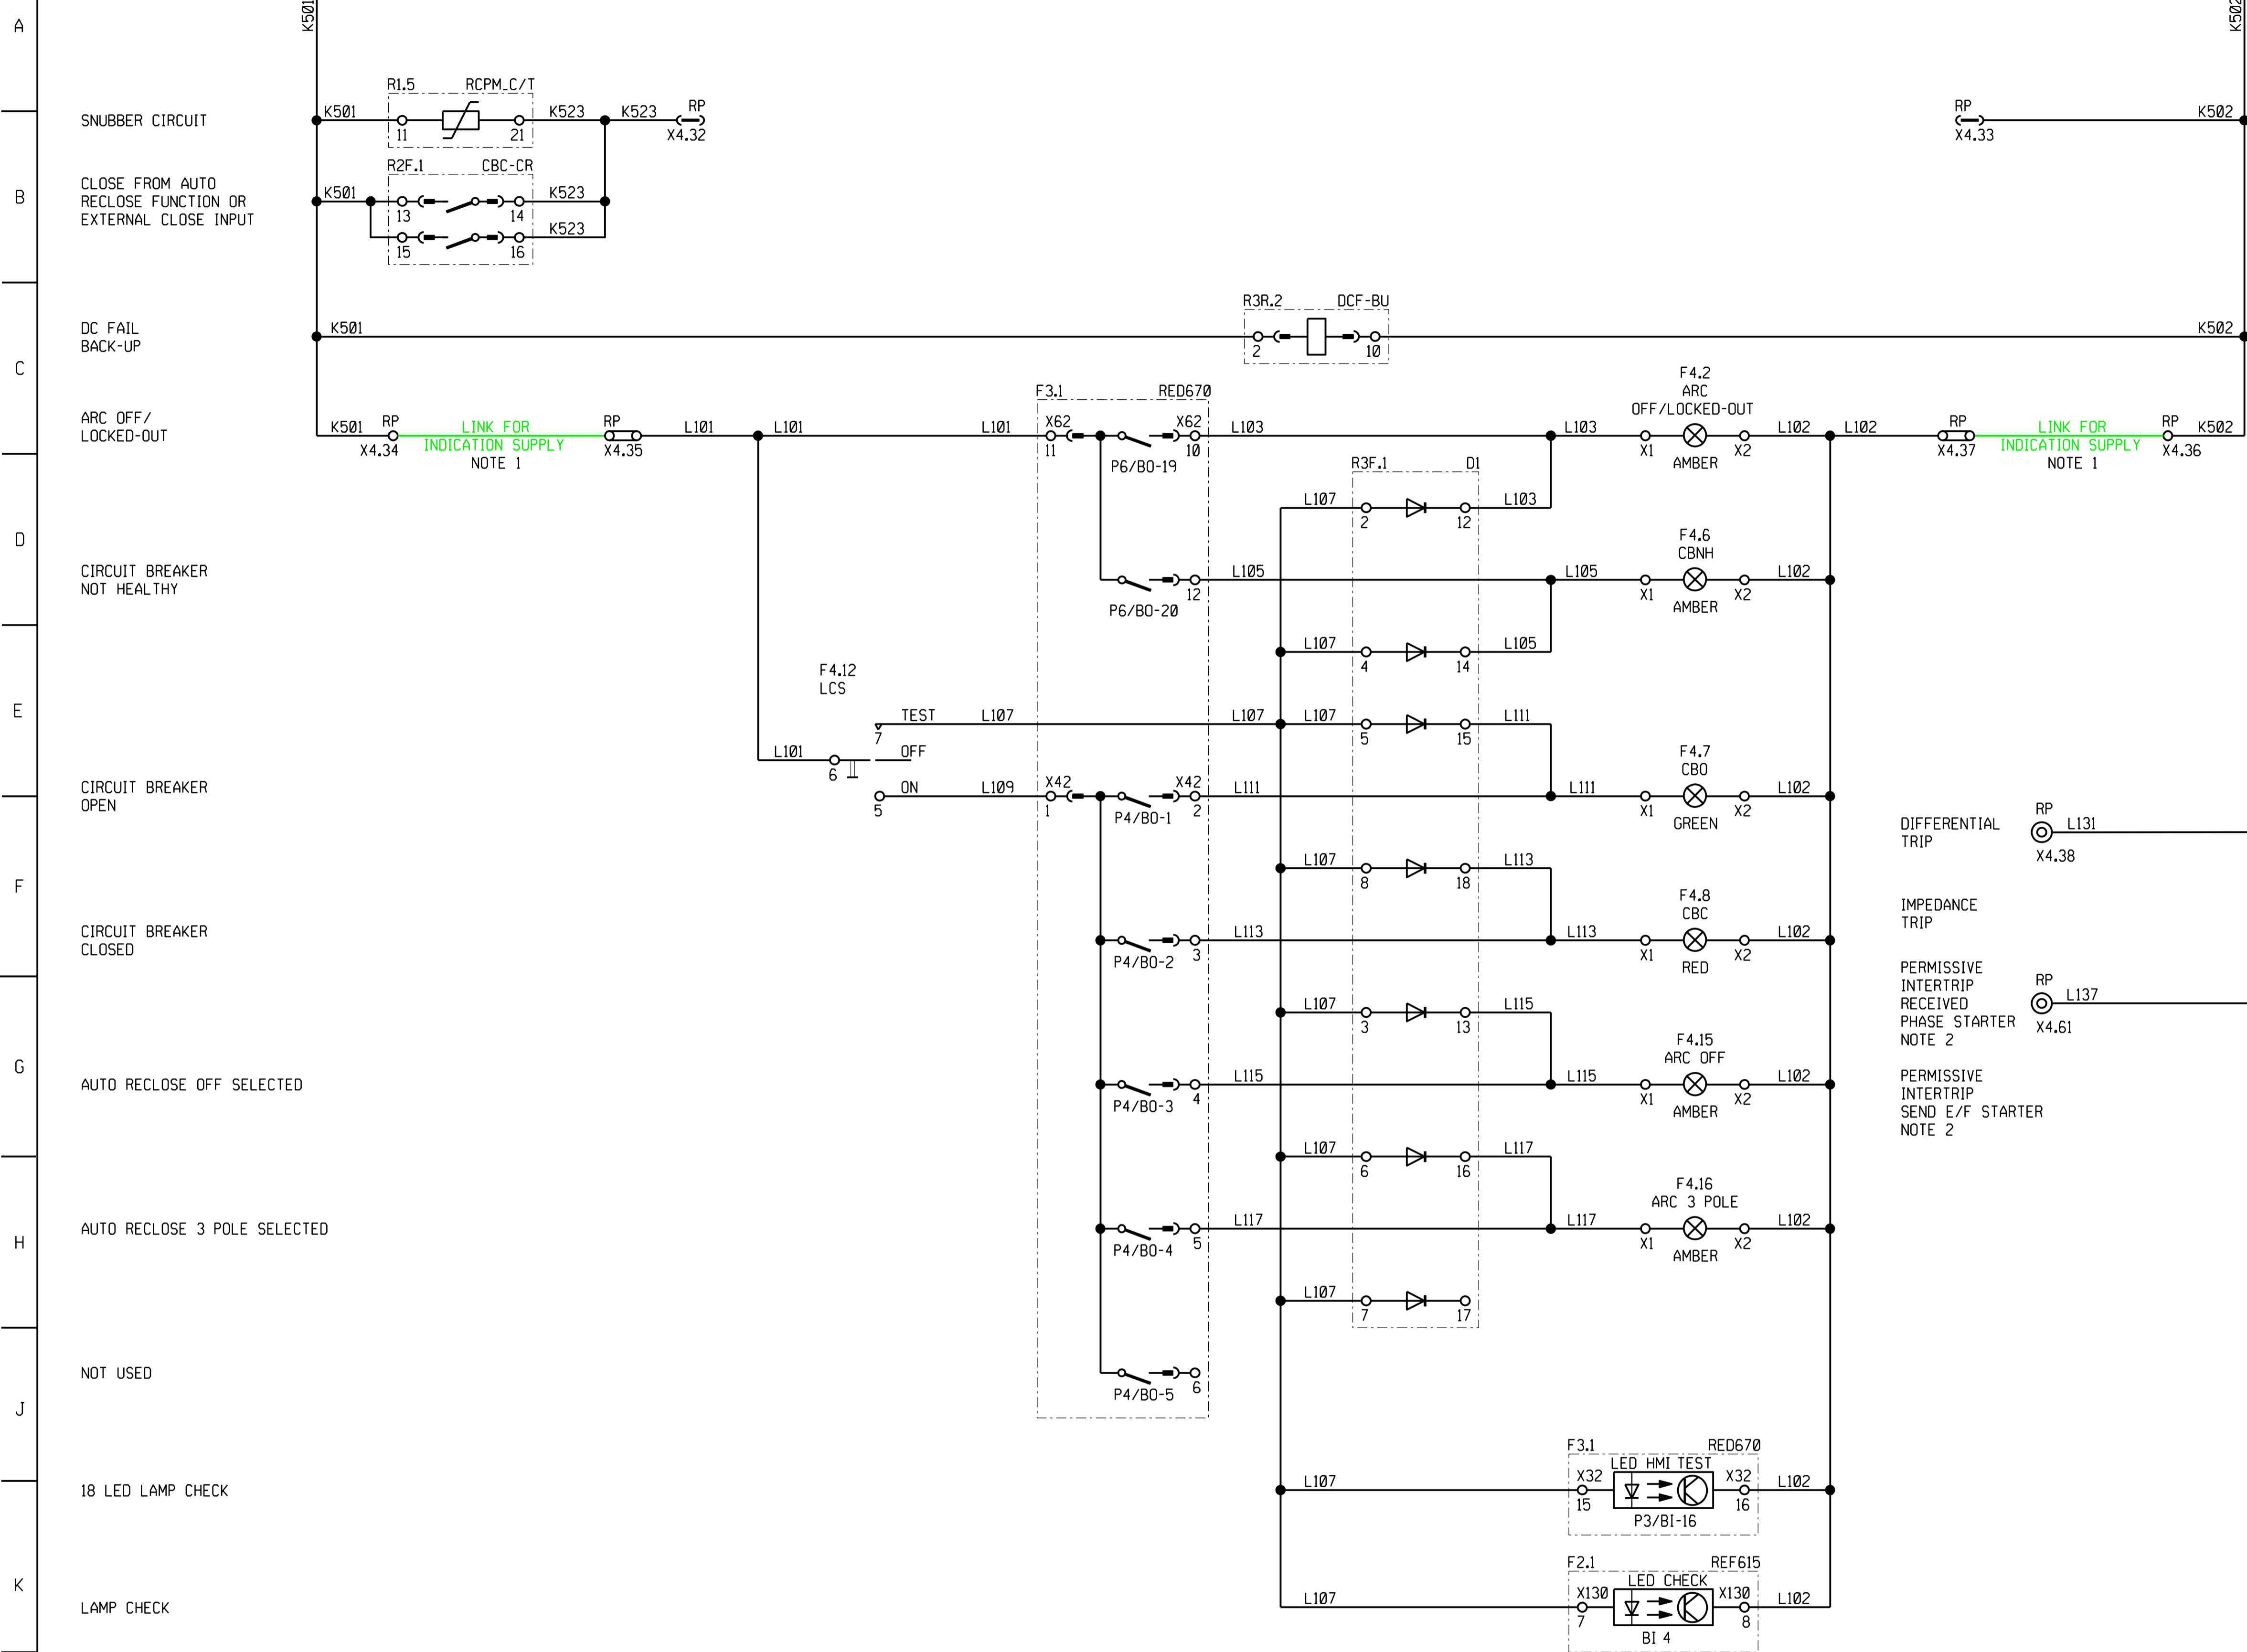

SHT 28	ISOLATOR JB
SHT 27	CABLE BLOCK
SHT 26	LINE VT DIAGRAM
SHT 25	CT JB CABLING
SHT 24	CABLING DIAGRAM
SHT 23	CABLING DIAGRAM
SHT 22	CABLING DIAGRAM
SHT 21	REFERENCE DIAG
SHT 20	REFERENCE DIAG
SHT 19	REFERENCE DIAG
SHT 18	DISTUR RECORDER
SHT 17	SUP ALARMS KEY
SHT 16	SUP STATUS, CONT
SHT 15	REA & MEAS KEY
SHT 14	SPR REW, AC KEY
SHT 13	INDICAT, DC KEY
SHT 12	CLOSE DC KEY
SHT 11	BACK-UP DC KEY
SHT 10	BACK-UP DC KEY
SHT 09	BACK-UP DC KEY
SHT 08	TELEPROT DC KEY
SHT 07	MAIN DC KEY
SHT 06	MAIN DC KEY
SHT 05	VT SUPPLY KEY
SHT 04	AC KEY DIAGRAM
SHT 03	SINGLE LINE
SHT 02	LOGIC DIAGRAM
SHT 01	PANEL LAYOUT
DRG No.	REFERENCE DRAWINGS:

NOTE:
 1. JUMPERS TO BE INSTALLED BY ESKOM PERSONNEL OR AN ALTERNATIVE DC SUPPLY TO BE CONNECTED.
 2. TO OBTAIN DISTANCE PHASE AND EARTH-FAULT STARTERS DURING TESTING, SET GATE 2 TO 'ON'. TO OBTAIN PERMISSIVE TEST POINTS, SET GATE 2 TO 'OFF' (THE DEFAULT).



1	66kV VT & CB ADDED, FEEDER RENAMED.	KS	BH	CP	25/06/2021	153272156-00003
REV	REVISION DESCRIPTION	BY	CHKD	AUTH	DATE	PROJECT NUMBER

Eskom

ISCOR SUBSTATION
66kV FEEDER 1
INDICATION DC KEY DIAGRAM

D-WC-7104

SET NUMBER	SHEET NUMBER	REVISION
61	13	1

PANEL TYPE DESIGNATION 4FZD-3920

PROJECT APPROVED	DESIGN APPROVED					
C. PYM	A. CRAIB					
DATE 25/06/21	DATE 13/13/10					
PROJECT CHECKED	DESIGN CHECKED					
B. HOMANN	N. MATHONSI					
DATE 25/06/21	DATE 13/12/10					
DRAWN BY	DRAWN BY					
K. STEYNBERG	C. CANNON					
DATE 25/06/21	DATE 26/02/10					
REV	AUTH	DATE	REVISION TO MASTER	BY	CHKD	SCALE

MASTER TRACING FILED UNDER D-DT-15007 SHEET 13 OF 28 REVISION 2



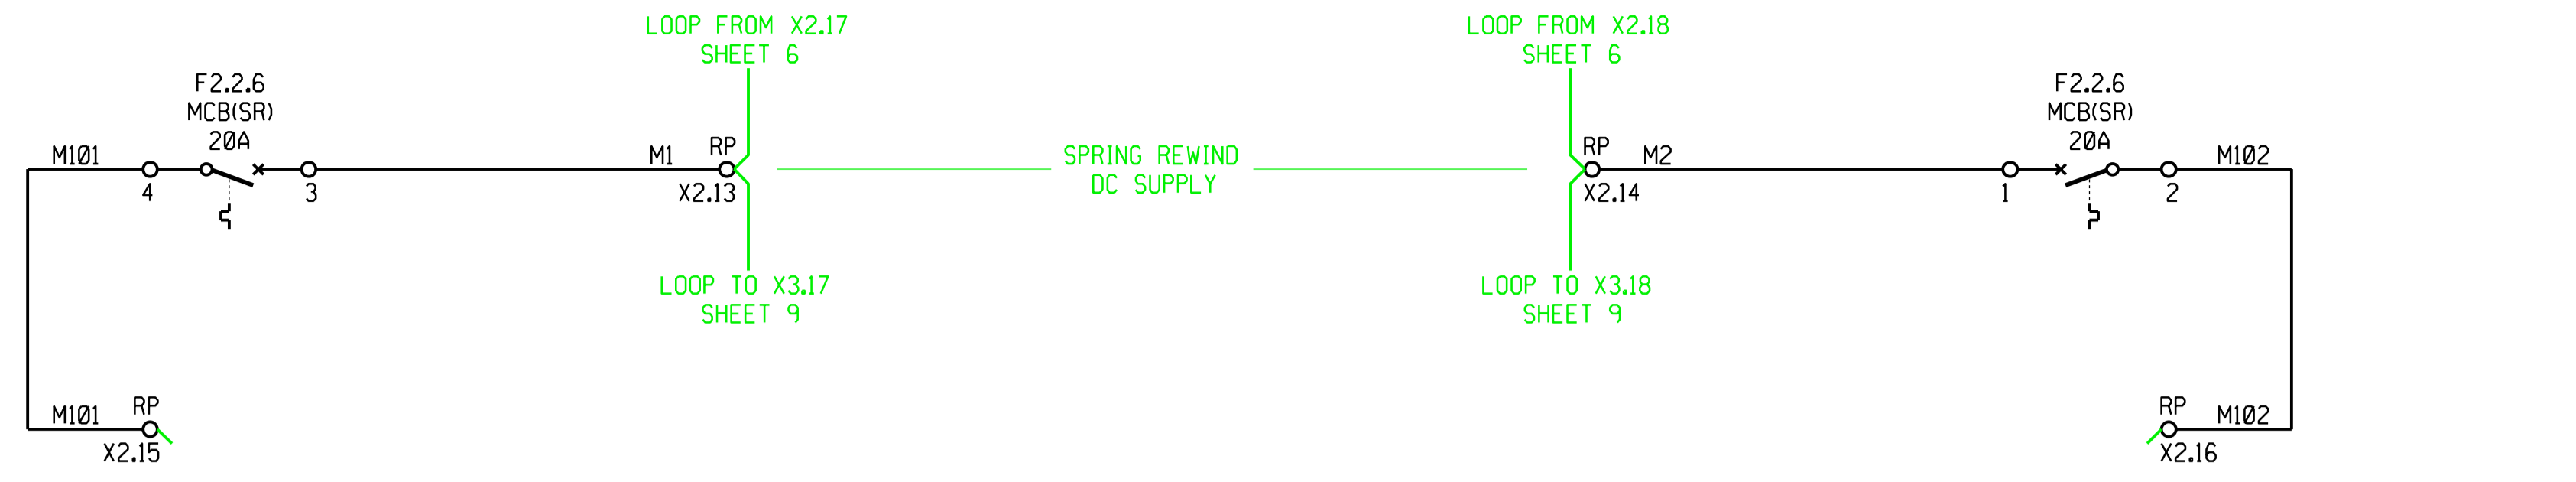


ABB 132kV THREE POLE BREAKER LEGEND	
ITEM	DESCRIPTION
BD1	DENSITY SWITCH
BG1	BREAKER AUXILIARY CONTACTS
BT1	HEATER THERMOSTAT
BW1	SPRING LIMIT SWITCH
E1	HEATER (PERMANENTLY CONNECTED)
E2	HEATER (THERMOSTAT CONTROLLED)
F1	DIRECT ON LINE MOTOR STARTER MCB
F2	MINATURE CIRCUIT BREAKER (HEATER)
K1	AUXILIARY RELAY (SPRING LIMIT SWITCH)
K3	ANTIPUMPING RELAY
K9	SF6 INTERLOCKING RELAY (CLOSE)
K10	SF6 INTERLOCKING RELAY (MAIN TRIP)
K19	AUXILIARY RELAY (THERMOSTAT)
K19.1 & K19.2	CURRENT RELAY (HEATER)
K25	SF6 AUXILIARY RELAY (SF6 LOW GAS ALARM)
KT1	TIME DELAYED RELAY (SPRING CHARGE FAILURE)
M1	SPRING REWIND MOTOR
S4	BREAKER ISOLATOR SWITCH (LOR)
SX11 - SX22	CONNECTION TERMINALS
SXY1 - SXY3	CONNECTION TERMINALS
X1	TERMINAL BLOCK FOR CONNECTIONS
X11 - X22	CONNECTION TERMINALS
XC1 - XC7	CONNECTION POINT
Y1	MAIN TRIP COIL
Y2	BACK-UP TRIP COIL
Y3	CLOSE COIL

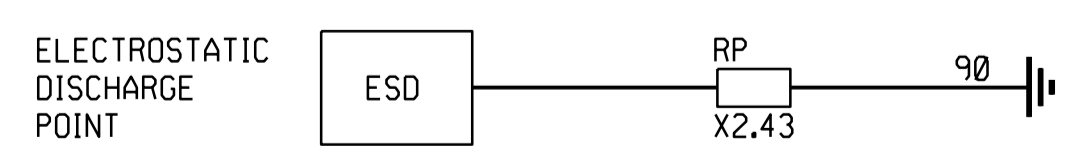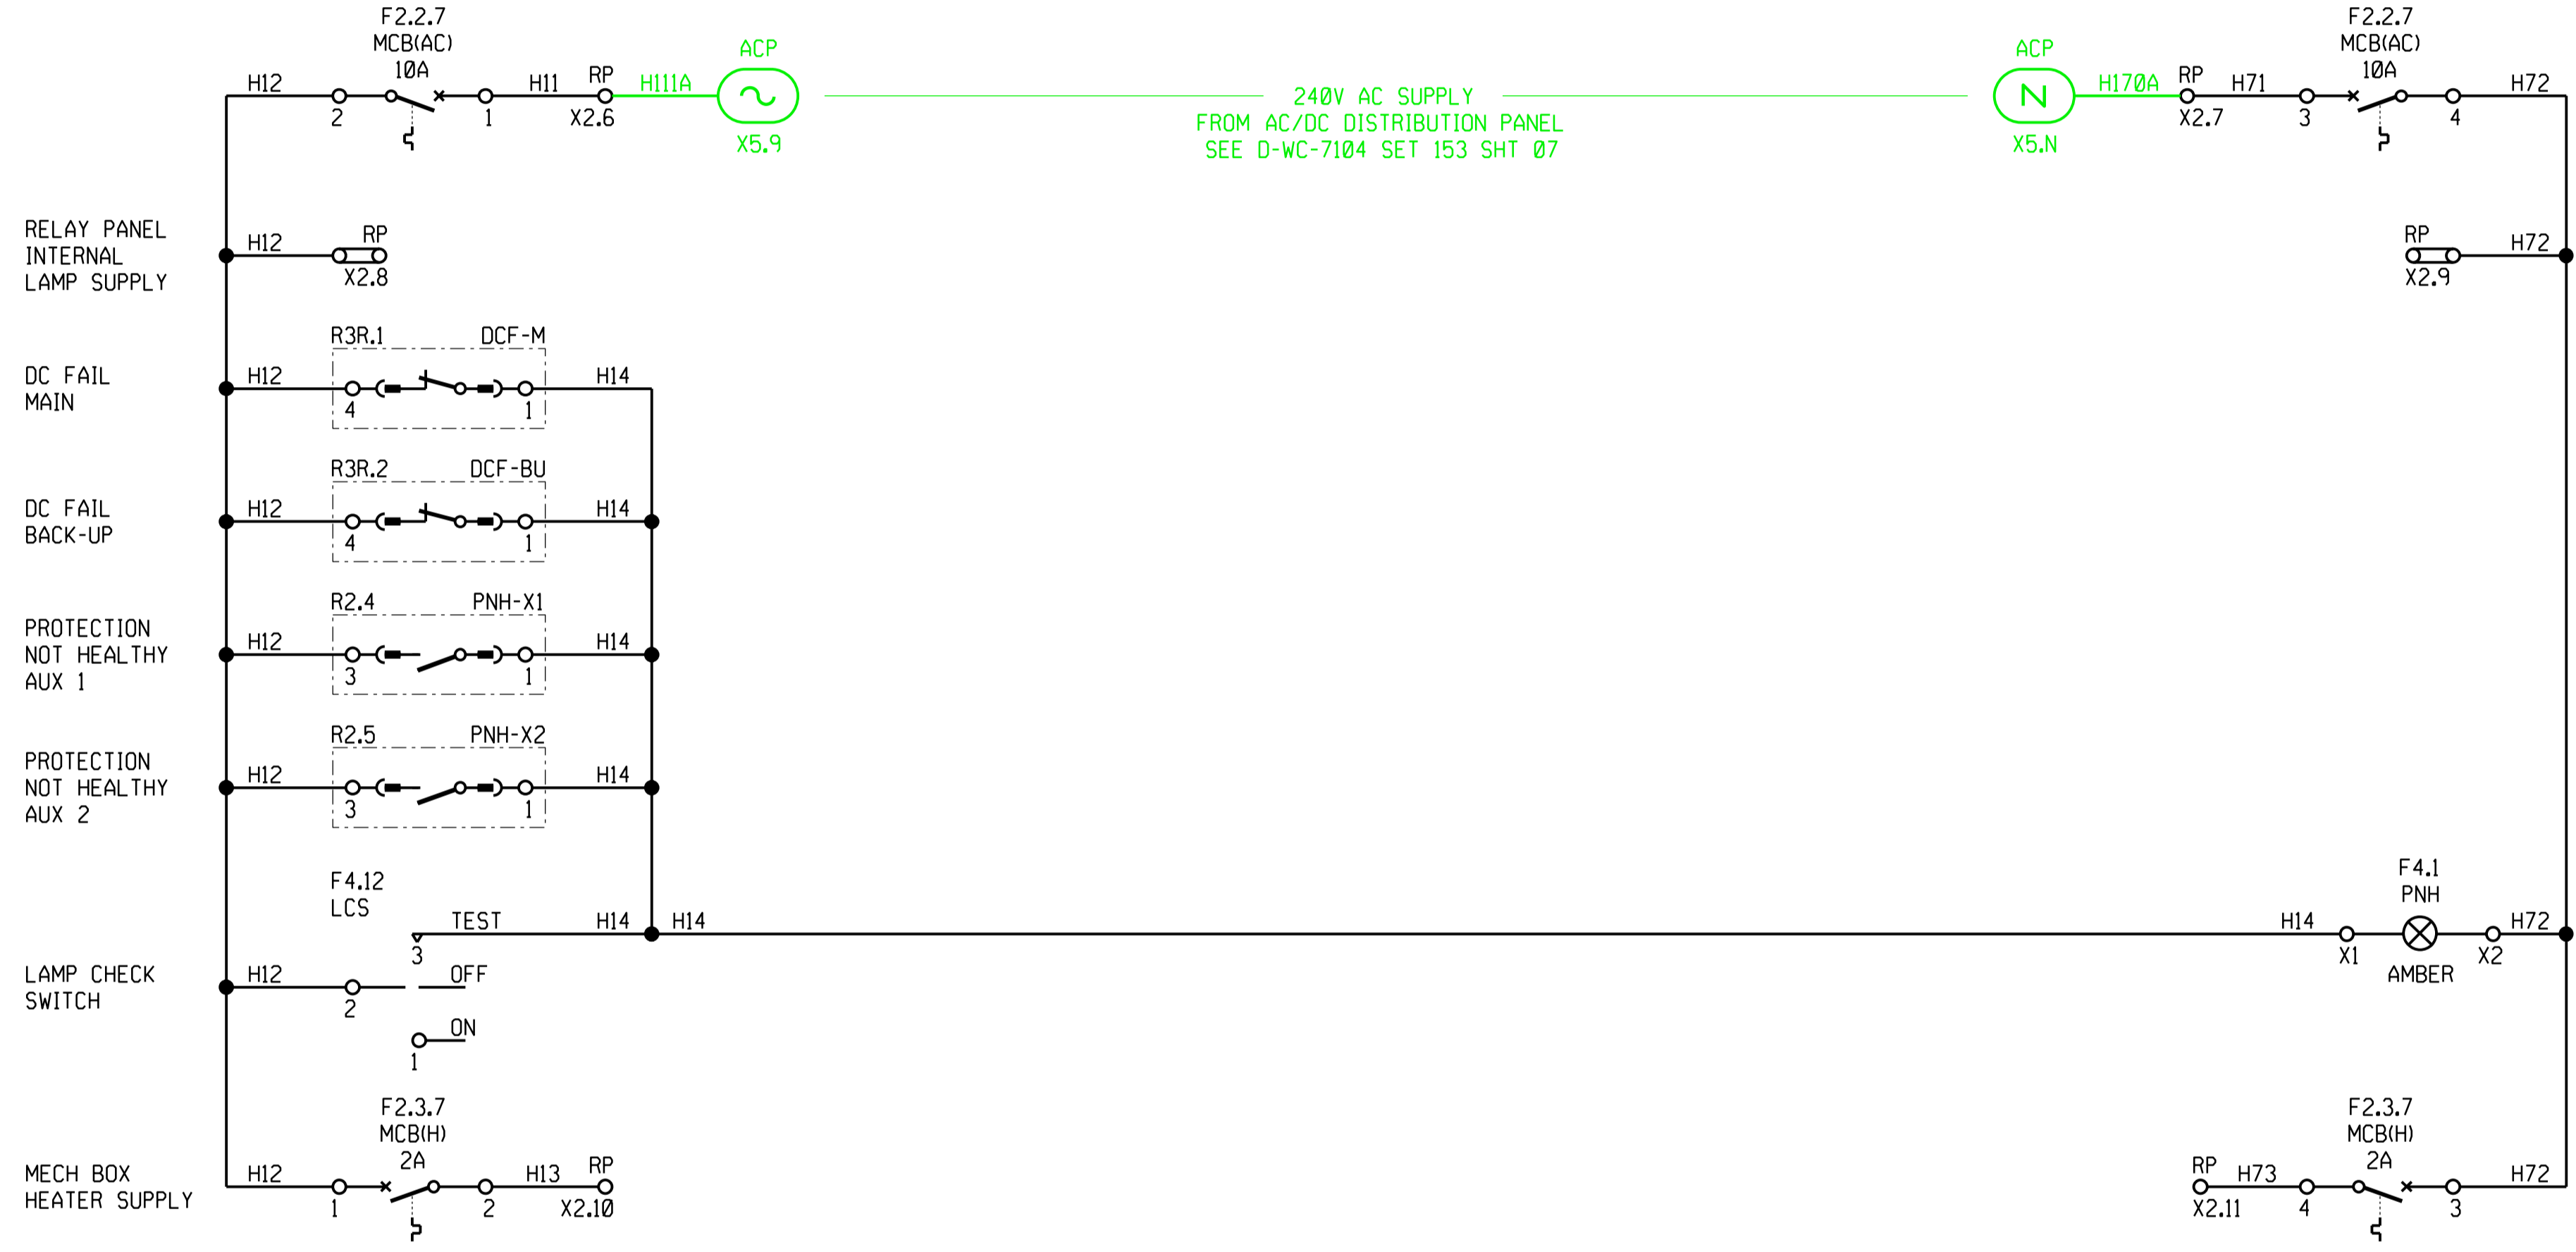

SHT 28	ISOLATOR JB
SHT 27	CABLE BLOCK
SHT 26	LINE VT DIAGRAM
SHT 25	CT JB CABLING
SHT 24	CABLING DIAGRAM
SHT 23	CABLING DIAGRAM
SHT 22	CABLING DIAGRAM
SHT 21	REFERENCE DIAG
SHT 20	REFERENCE DIAG
SHT 19	REFERENCE DIAG
SHT 18	DISTUR RECORDER
SHT 17	SUP ALARMS KEY
SHT 16	SUP STATUS, CONT
SHT 15	REA & MEAS KEY
SHT 14	SPR REW, AC KEY
SHT 13	INDICAT, DC KEY
SHT 12	CLOSE DC KEY
SHT 11	BACK-UP DC KEY
SHT 10	BACK-UP DC KEY
SHT 09	BACK-UP DC KEY
SHT 08	TELEPROT DC KEY
SHT 07	MAIN DC KEY
SHT 06	MAIN DC KEY
SHT 05	VT SUPPLY KEY
SHT 04	AC KEY DIAGRAM
SHT 03	SINGLE LINE
SHT 02	LOGIC DIAGRAM
SHT 01	PANEL LAYOUT
DRG No.	REFERENCE DRAWINGS:

1	66kV VT & CB ADDED, FEEDER RENAMED.	KS	BH	CP	25/06/2021	153272156-00003
REV	REVISION DESCRIPTION	BY	CHKD	AUTH	DATE	PROJECT NUMBER

ISCOR SUBSTATION
66kV FEEDER 1
SPRING REWIND AND AC KEY DIAGRAM


SET NUMBER	SHEET NUMBER	REVISION
D-WC-7104	61	14
		1





REV	AUTH	DATE	REVISION TO MASTER	BY	CHKD	SCALE
-	-	-	-	-	-	-

MASTER TRACING FILED UNDER D-DT-15007 SHEET 14 OF 28 REVISION 2

REMOTE ENGINEERING ACCESS IEC61850

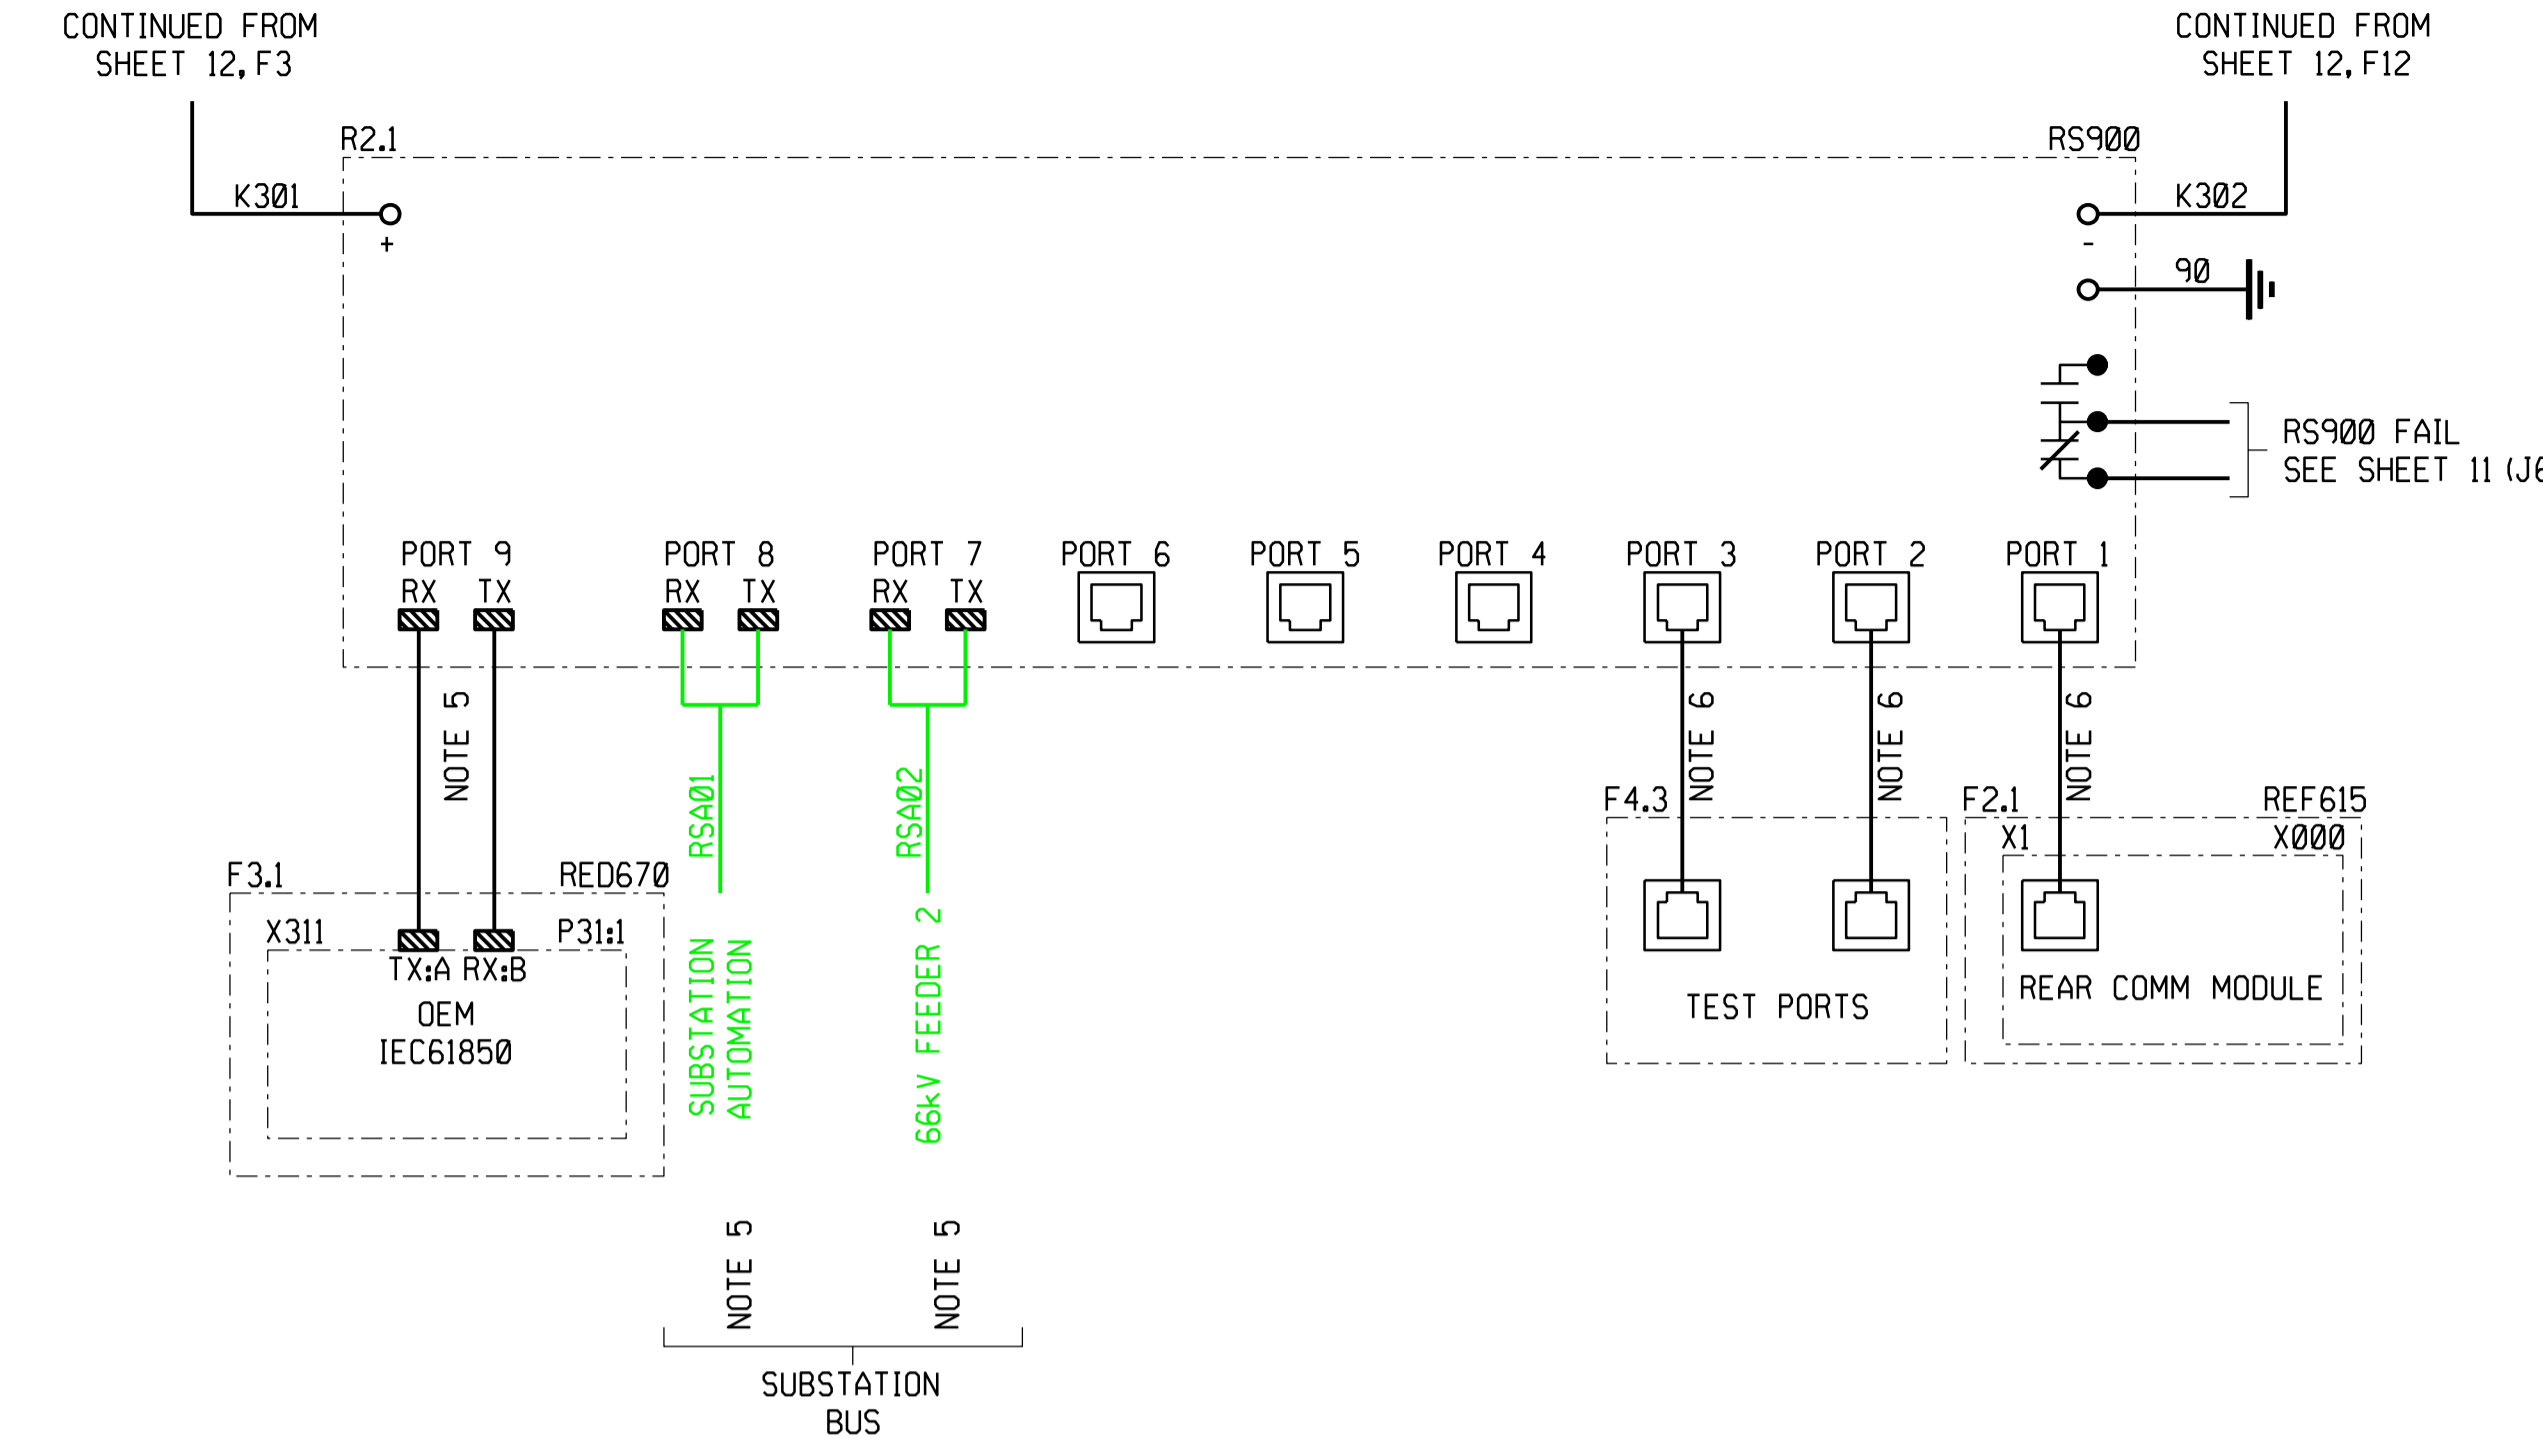

TIME SYNCHRONISATION NOTE 4

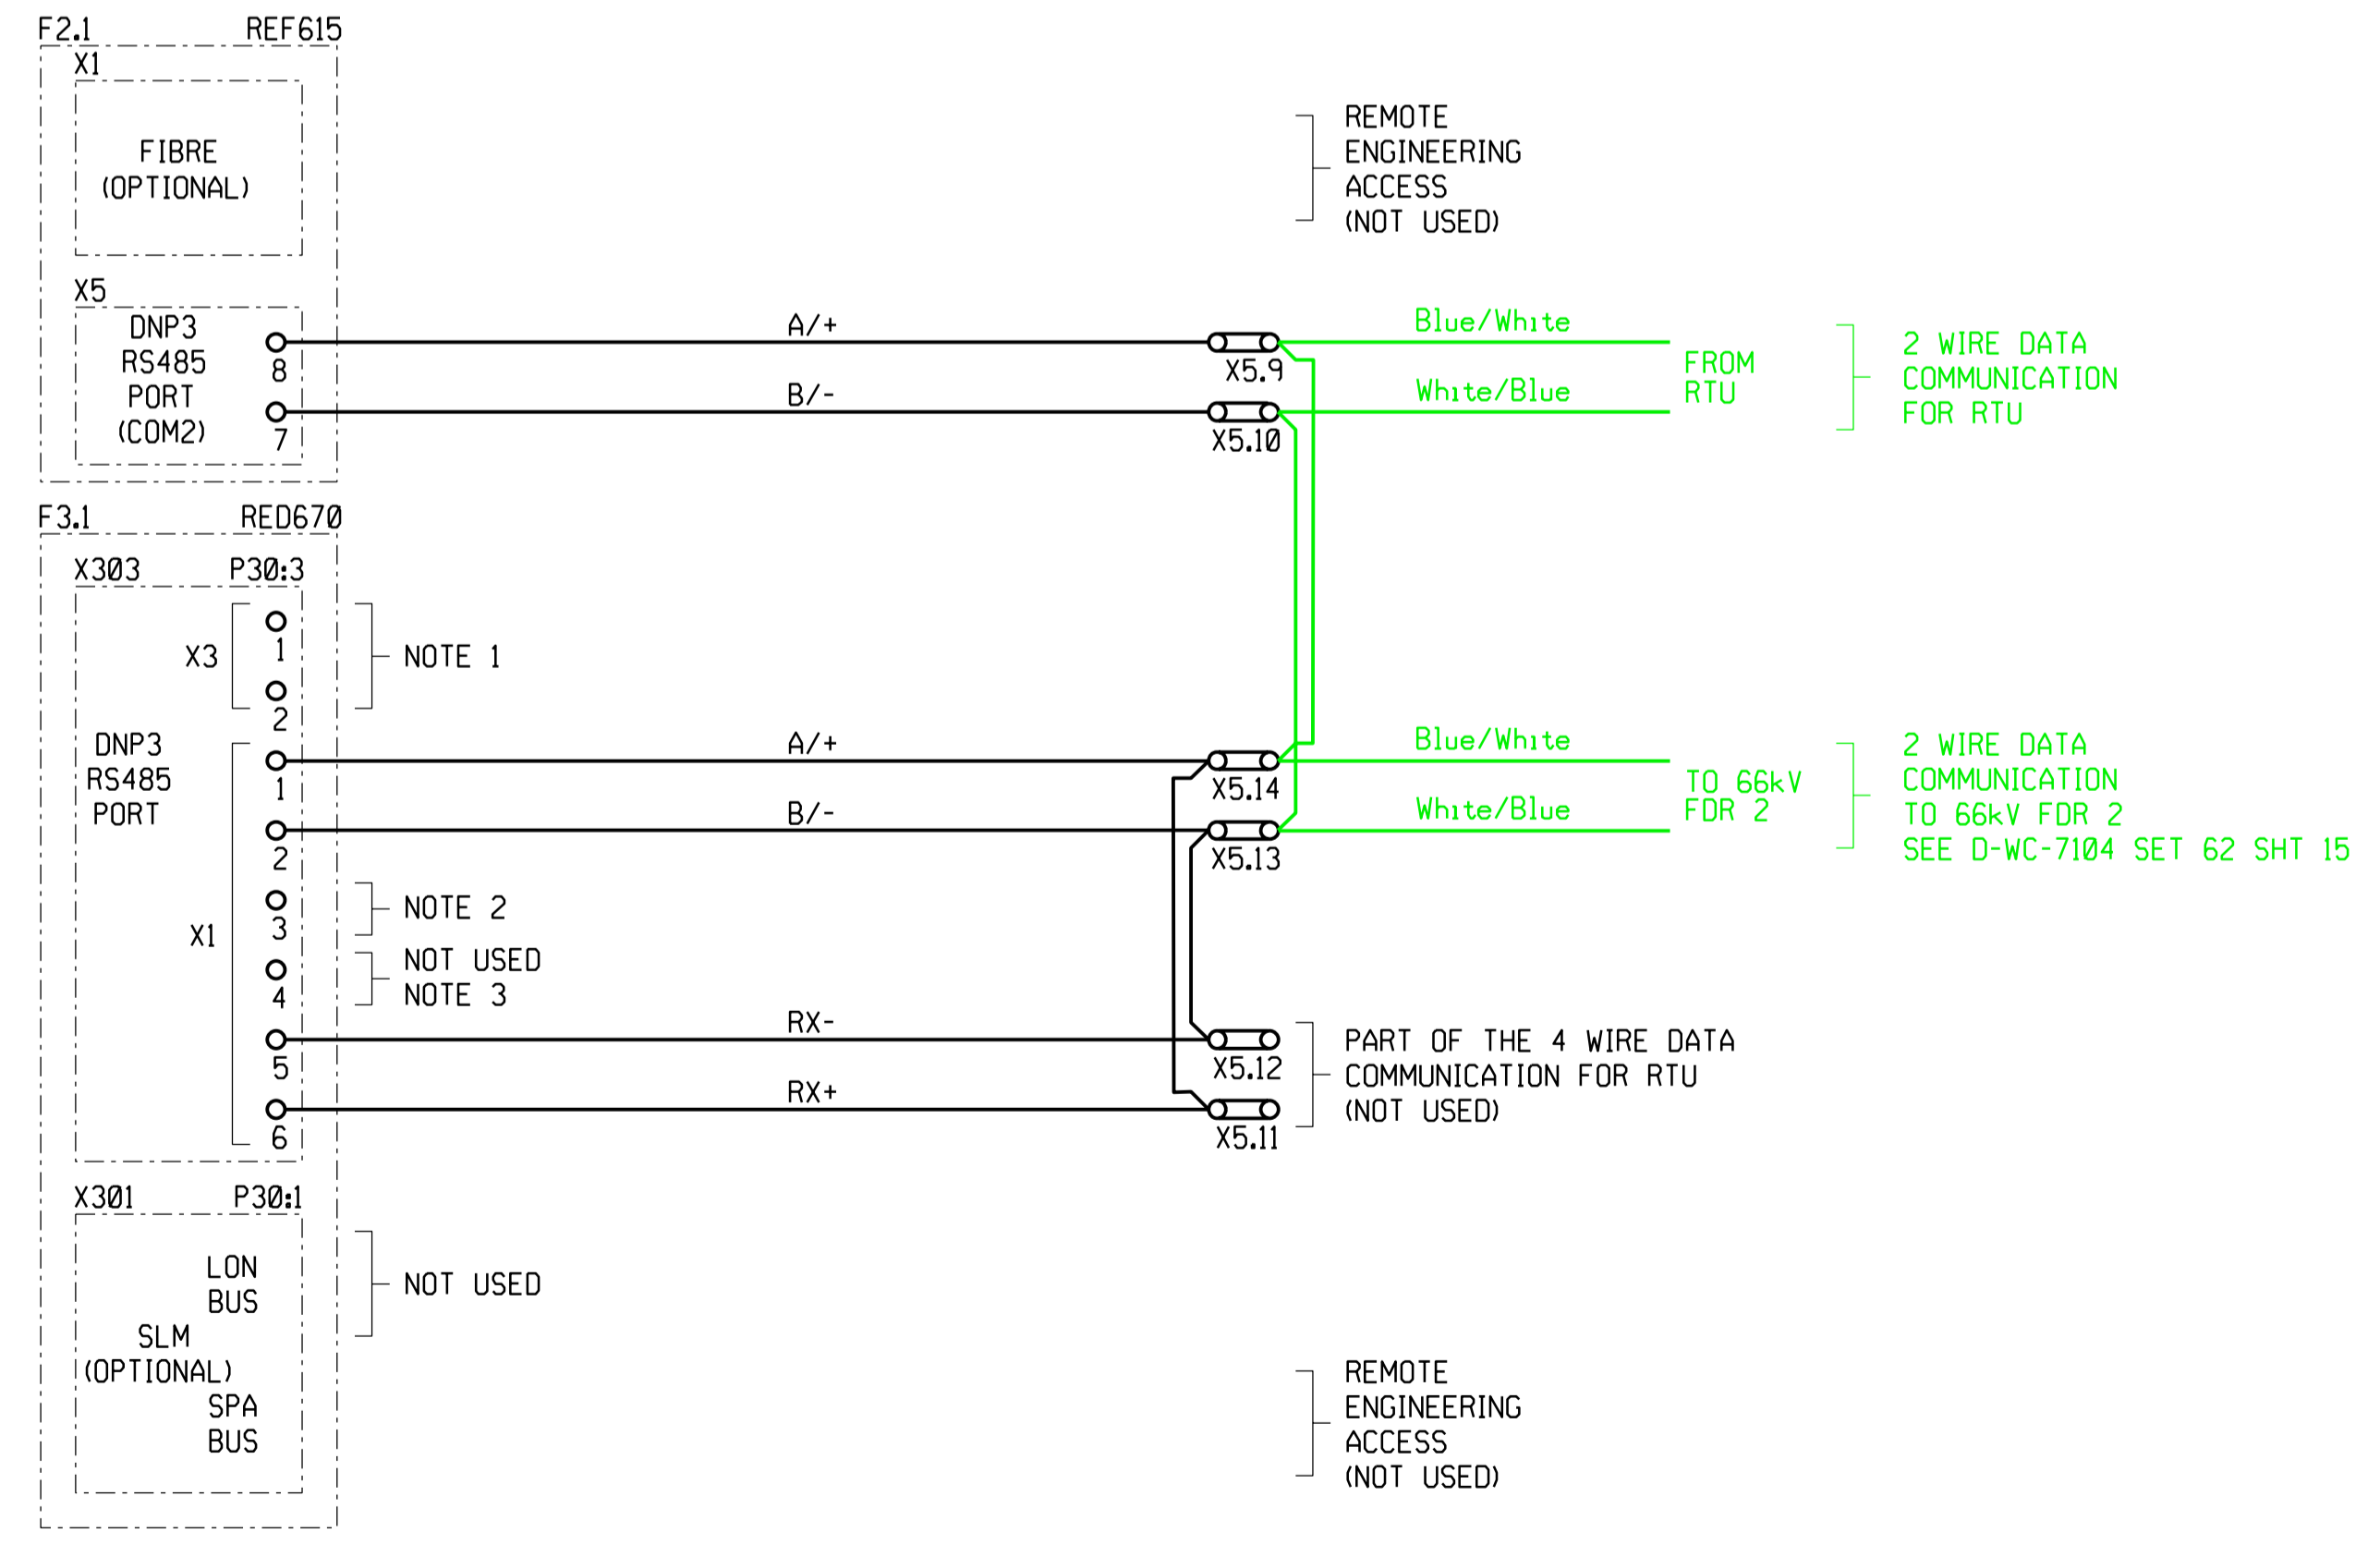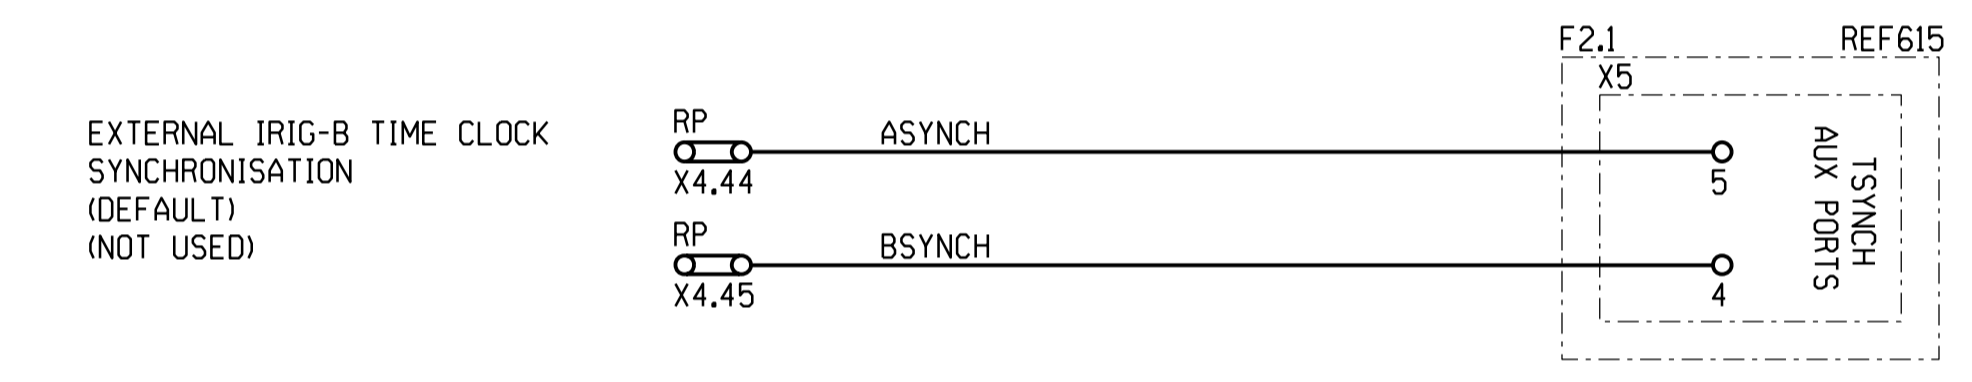

- NOTE:**
- X3 OF THE RED670 IS THE SOFT GROUND CONNECTOR. IT MAY BE UNCONNECTED OR IT CAN BE CONNECTED TO THE GND WITH AN RC NET PARALLEL WITH A MOV.
 - TERMINATION RESISTOR FOR TRANSMITTER AND RECEIVER. ESKOM PERSONNEL TO CONNECT TO A/+ IF USED.
 - TERMINATION RESISTOR FOR RECEIVER IN THE 4 WIRE CASE (CONNECT TO RX+).
 - IF ACCURATE TIMING IS STILL REQUIRED BUT NEITHER OF THE GPS TIMING OPTIONS ARE CHOSEN, THEN USE SNTP TIMING VIA THE IEC61850 OPTIONAL CONNECTION (NOT AS ACCURATE AS GPS TIMING).
 - 100 BASE FX MULTIMODE 1300nm (GLASS), ST CONNECTORS
 - STANDARD RJ45 PORT 100 BASE TX

SHT 28	ISOLATOR JB
SHT 27	CABLE BLOCK
SHT 26	LINE VT DIAGRAM
SHT 25	CT JB CABLING
SHT 24	CABLING DIAGRAM
SHT 23	CABLING DIAGRAM
SHT 22	CABLING DIAGRAM
SHT 21	REFERENCE DIAG
SHT 20	REFERENCE DIAG
SHT 19	REFERENCE DIAG
SHT 18	DISTUR RECORDER
SHT 17	SUP ALARMS KEY
SHT 16	SUP STATUS, CONT
SHT 15	REA & MEAS KEY
SHT 14	SPR REW, AC KEY
SHT 13	INDICAT, DC KEY
SHT 12	CLOSE DC KEY
SHT 11	BACK-UP DC KEY
SHT 10	BACK-UP DC KEY
SHT 09	BACK-UP DC KEY
SHT 08	TELEPROT DC KEY
SHT 07	MAIN DC KEY
SHT 06	MAIN DC KEY
SHT 05	VT SUPPLY KEY
SHT 04	AC KEY DIAGRAM
SHT 03	SINGLE LINE
SHT 02	LOGIC DIAGRAM
SHT 01	PANEL LAYOUT
DRG No.	REFERENCE DRAWINGS:

1	66kV VT & CB ADDED, FEEDER RENAMED.	KS	BH	CP	25/06/2021	153272156-00003
REV	REVISION DESCRIPTION	BY	CHKD	AUTH	DATE	PROJECT NUMBER

Eskom

ISCOR SUBSTATION
66kV FEEDER 1
REA AND MEASUREMENTS KEY DIAG

D-WC-7104

SET NUMBER	SHEET NUMBER	REVISION
61	15	1


PANEL TYPE DESIGNATION 4FZD-3920

REV	AUTH	DATE	REVISION TO MASTER	BY	CHKD	SCALE
-	-	-	-	-	-	-




SUPERVISORY STATUS 48V DC (DNP3 OPTIONAL & HMI DISPLAY)

SUPERVISORY STATUS (HARDWIRED OPTIONAL)

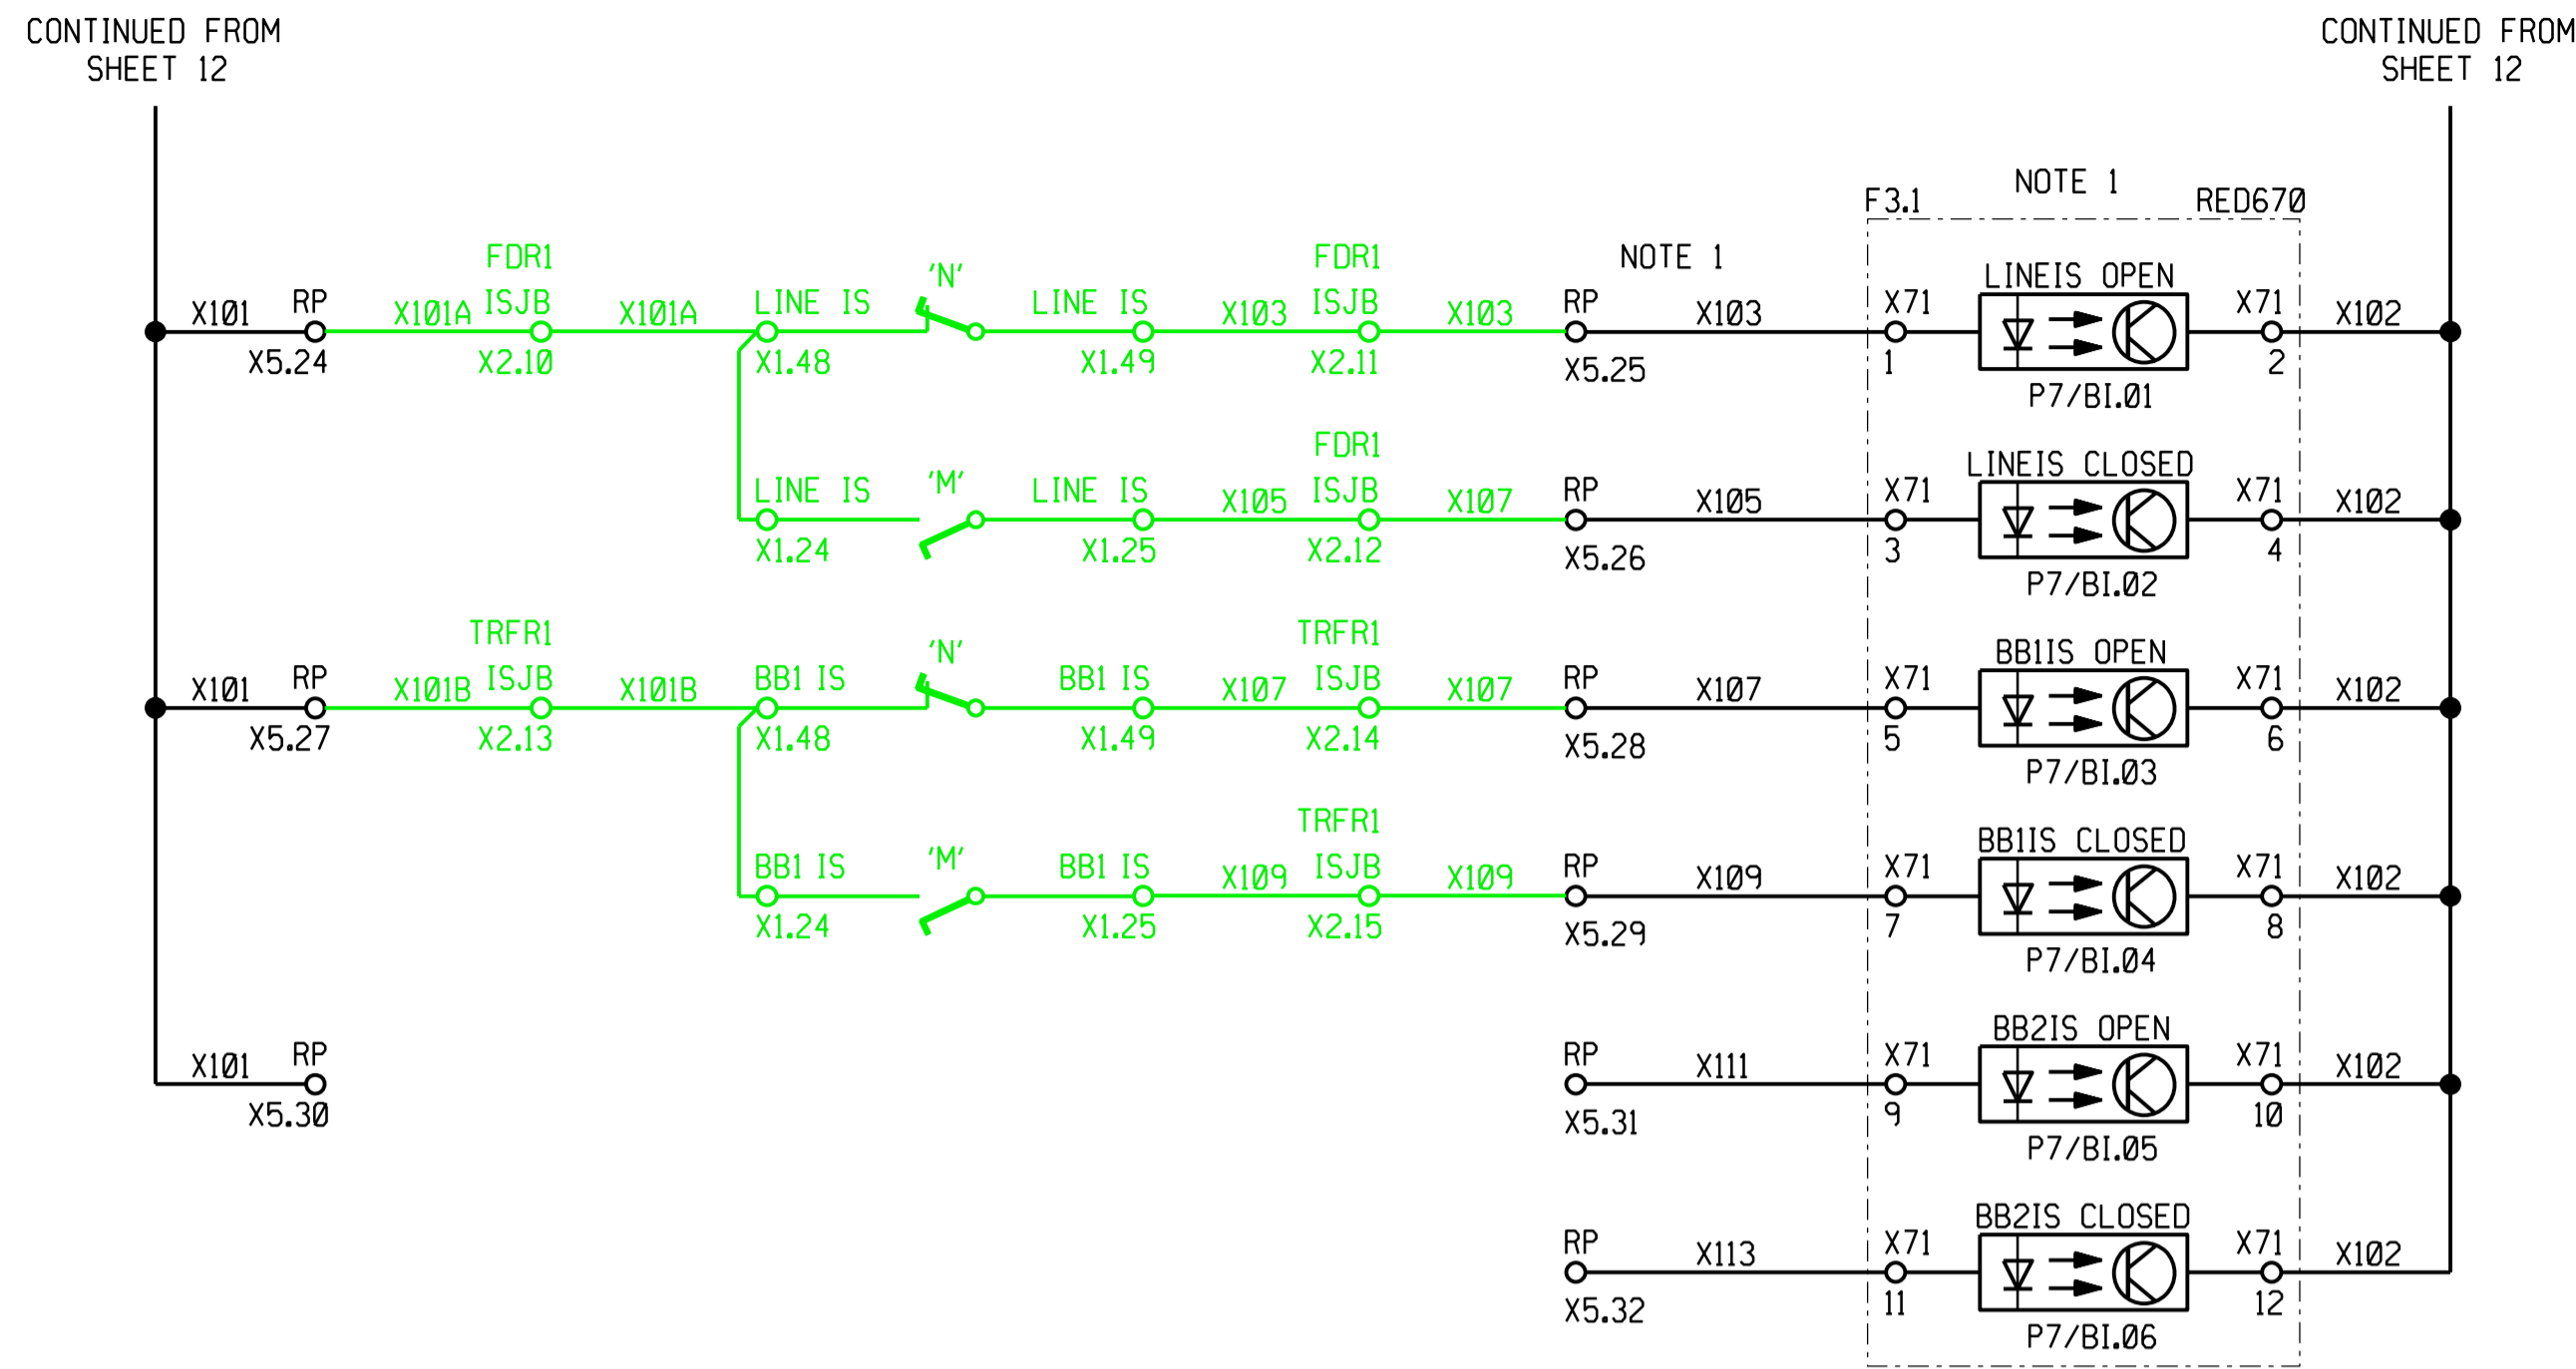

- RP X7.11
- RP X7.12
- RP X7.13
- RP X7.14
- RP X7.15
- RP X7.16
- RP X7.17
- RP X7.18
- RP X7.19
- RP X7.20
- RP X7.21
- RP X7.22
- RP X7.23
- RP X7.24

SUPERVISORY CONTROLS 48V DC (HARDWIRED OPTIONAL)

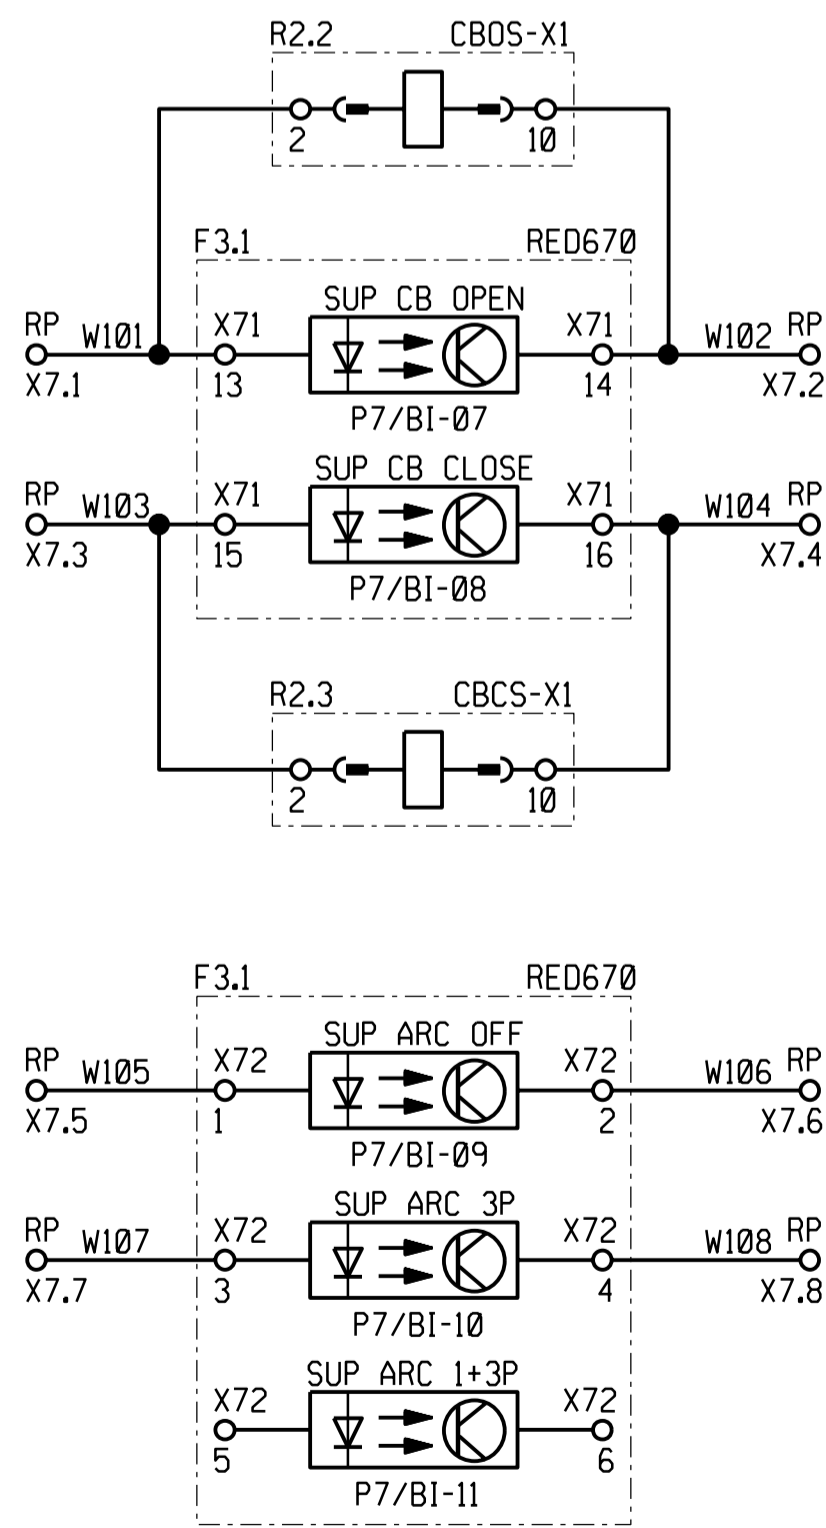

NOTE:

1. THESE INDICATIONS MUST ALWAYS BE WIRED IN BY ESKOM. THE RED670 IED HMI GRAPHICAL DISPLAY EDITOR SINGLE LINE DIAGRAM (SLD) SHOULD BE ALTERED BY ESKOM COMMISSIONING STAFF TO REFLECT THE BUSBAR ARRANGEMENT ON SITE - IN PCM600, GO TO 'GRAPHIC DISPLAY EDITOR'. COMMISSIONING STAFF MUST ALSO DEFAULT THE HMI DISPLAY TO THE SLD BY SELECTING ON THE RED670 HMI MAIN MENU, SETTINGS, GENERAL SETTINGS, HMI, SCREEN, DEFAULT SCREEN = SINGLE LINE DIAGRAM. NOTE THAT THE BYPASS ISOLATOR STATUS MAY BE FOUND ON THE BACK-UP DC KEY DIAGRAM.

SHT 28	ISOLATOR JB
SHT 27	CABLE BLOCK
SHT 26	LINE VT DIAGRAM
SHT 25	CT JB CABLING
SHT 24	CABLING DIAGRAM
SHT 23	CABLING DIAGRAM
SHT 22	CABLING DIAGRAM
SHT 21	REFERENCE DIAG
SHT 20	REFERENCE DIAG
SHT 19	REFERENCE DIAG
SHT 18	DISTUR RECORDER
SHT 17	SUP ALARMS KEY
SHT 16	SUP STATUS, CONT
SHT 15	REA & MEAS KEY
SHT 14	SPR REW, AC KEY
SHT 13	INDICAT, DC KEY
SHT 12	CLOSE DC KEY
SHT 11	BACK-UP DC KEY
SHT 10	BACK-UP DC KEY
SHT 09	BACK-UP DC KEY
SHT 08	TELEPROT DC KEY
SHT 07	MAIN DC KEY
SHT 06	MAIN DC KEY
SHT 05	VT SUPPLY KEY
SHT 04	AC KEY DIAGRAM
SHT 03	SINGLE LINE
SHT 02	LOGIC DIAGRAM
SHT 01	PANEL LAYOUT
DRG No.	REFERENCE DRAWINGS:

1	66kV VT & CB ADDED, FEEDER RENAMED.	KS	BH	CP	25/06/2021	153272156-00003
REV	REVISION DESCRIPTION	BY	CHKD	AUTH	DATE	PROJECT NUMBER

Eskom

ISCOR SUBSTATION
66kV FEEDER 1
SUPERVIS. STATUS & CONTROL KEY


D-WC-7104

SET NUMBER	SHEET NUMBER	REVISION
61	16	1

PANEL TYPE DESIGNATION 4FZD-3920



REV	AUTH	DATE	REVISION TO MASTER	BY	CHKD	SCALE
-	-	-	-	-	-	-

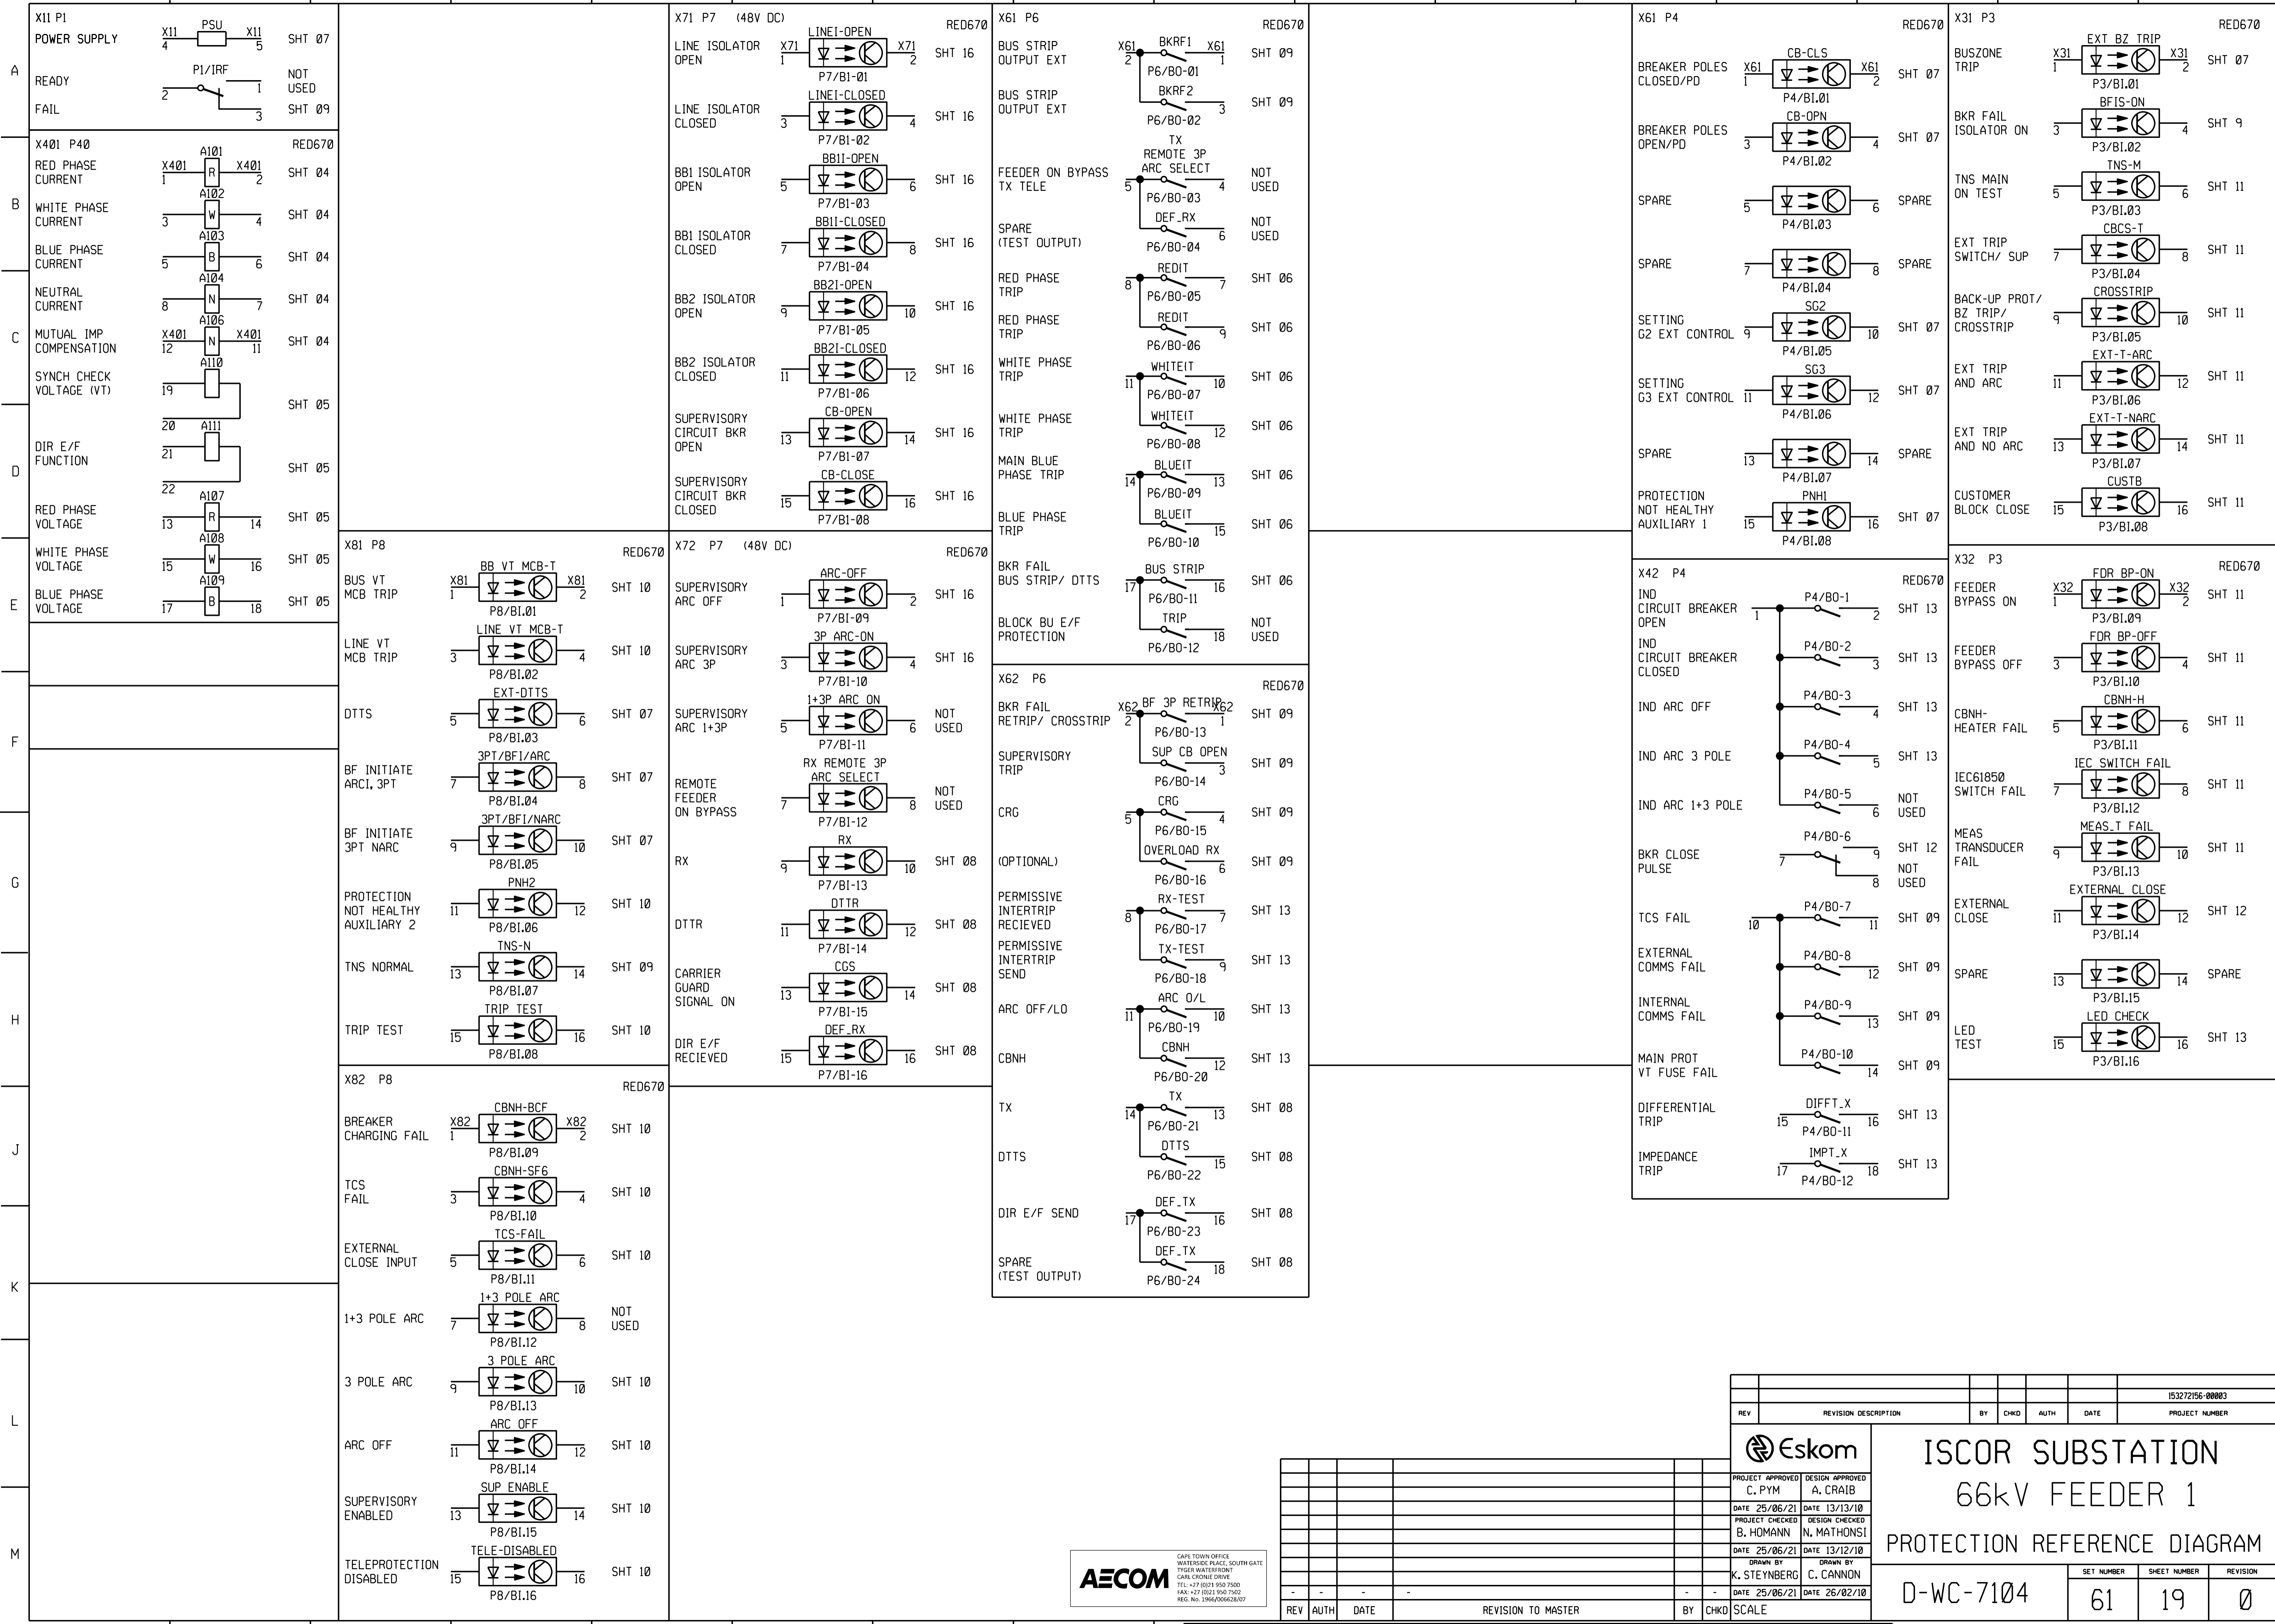

REV	REVISION DESCRIPTION	BY	CHKD	AUTH	DATE	PROJECT NUMBER










		ISCOR SUBSTATION 66kV FEEDER 1 PROTECTION REFERENCE DIAGRAM		
PROJECT APPROVED C. PYM	DESIGN APPROVED A. CRAIB	DATE 25/06/21	DATE 13/13/10	
PROJECT CHECKED B. HOMANN	DESIGN CHECKED N. MATHONSI	DATE 25/06/21	DATE 13/12/10	
DRAWN BY K. STEYNBERG		DRAWN BY C. CANNON		
DATE 25/06/21		DATE 26/02/10		
REV		AUTH	DATE	REVISION TO MASTER
BY		CHKD	SCALE	

SET NUMBER	SHEET NUMBER	REVISION
D-WC-7104	61	19


LEVELS	1	2	5	10	11	12	20	21	22	28
--------	---	---	---	----	----	----	----	----	----	----



MASTER TRACING FILED UNDER D-DT-15007 SHEET 19 OF 28 REVISION 2

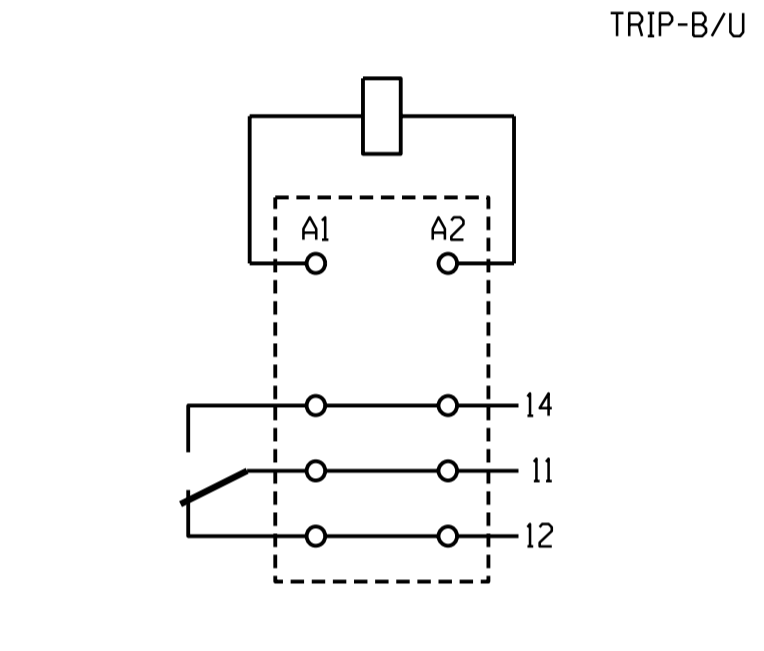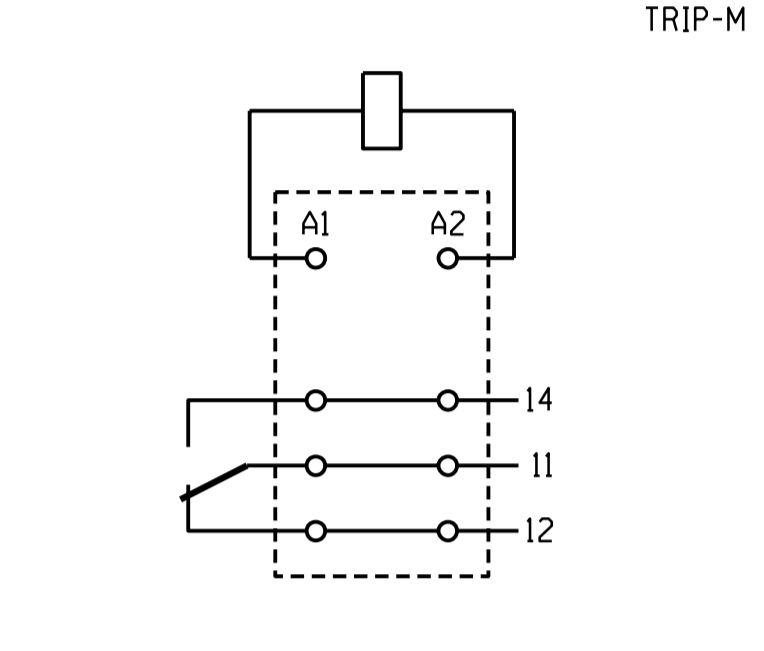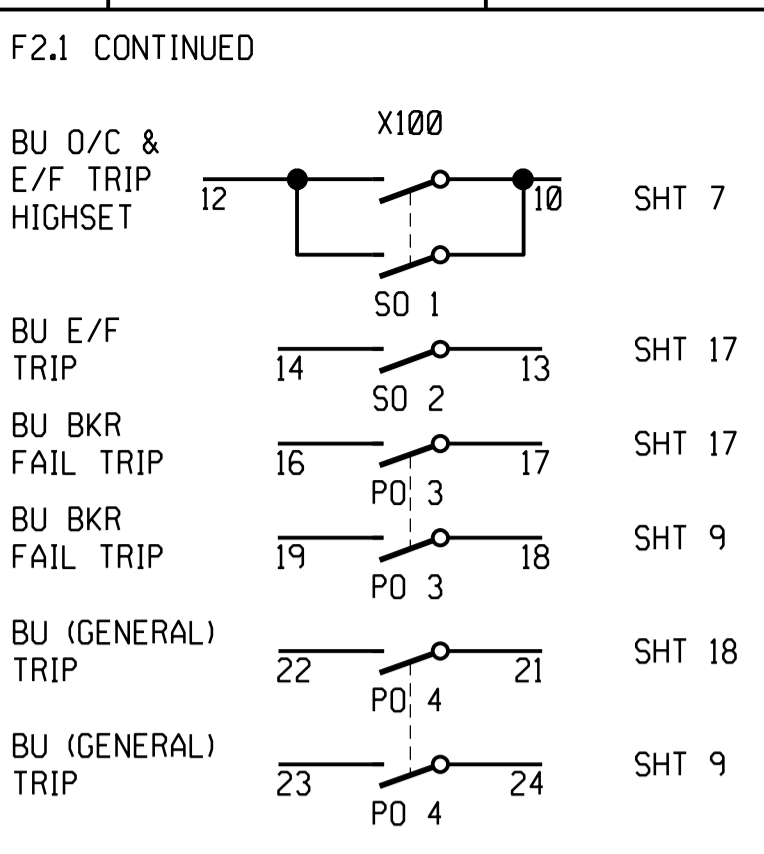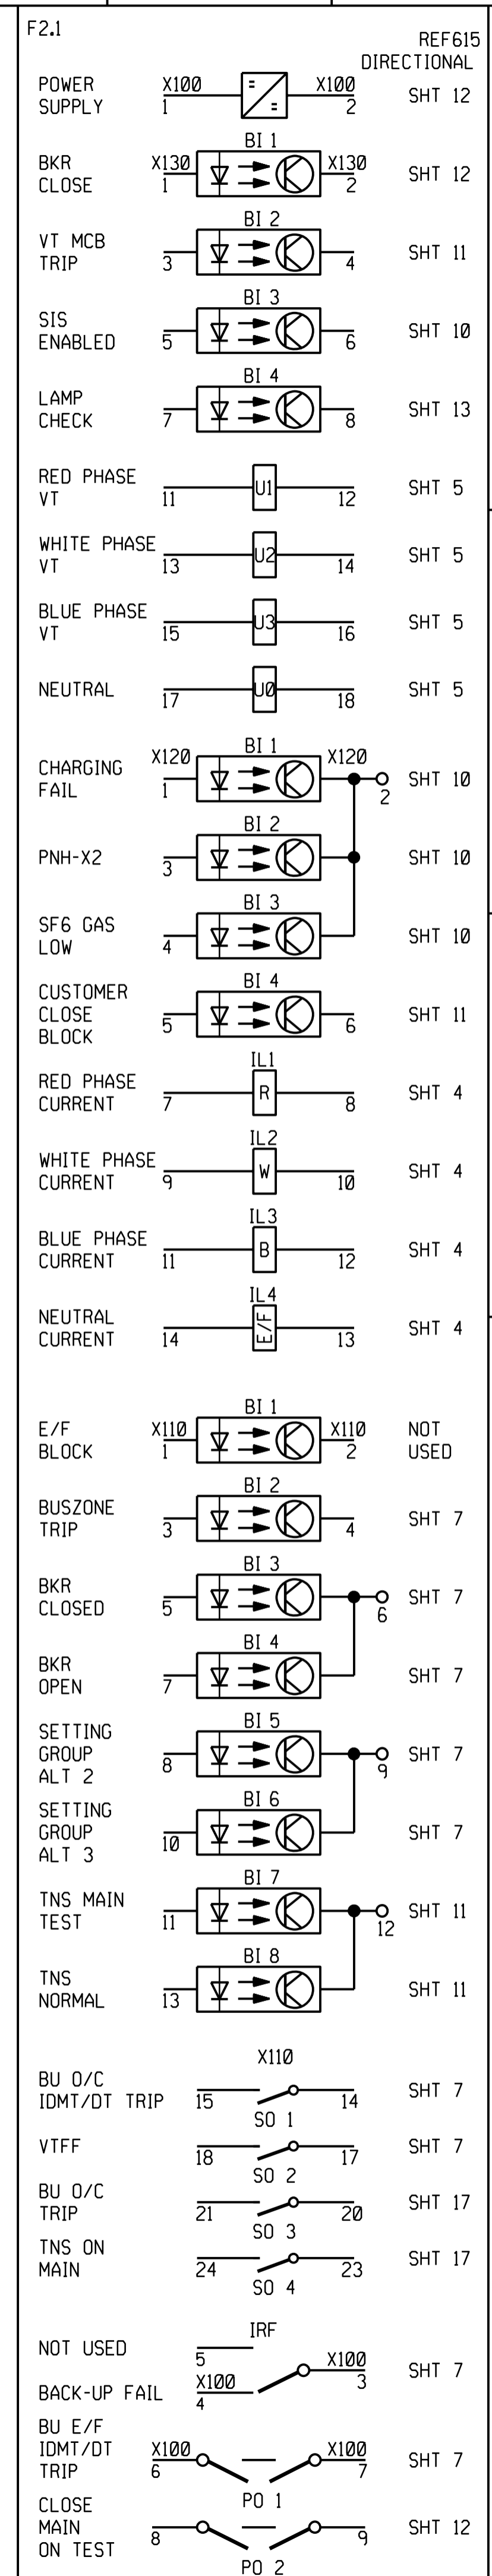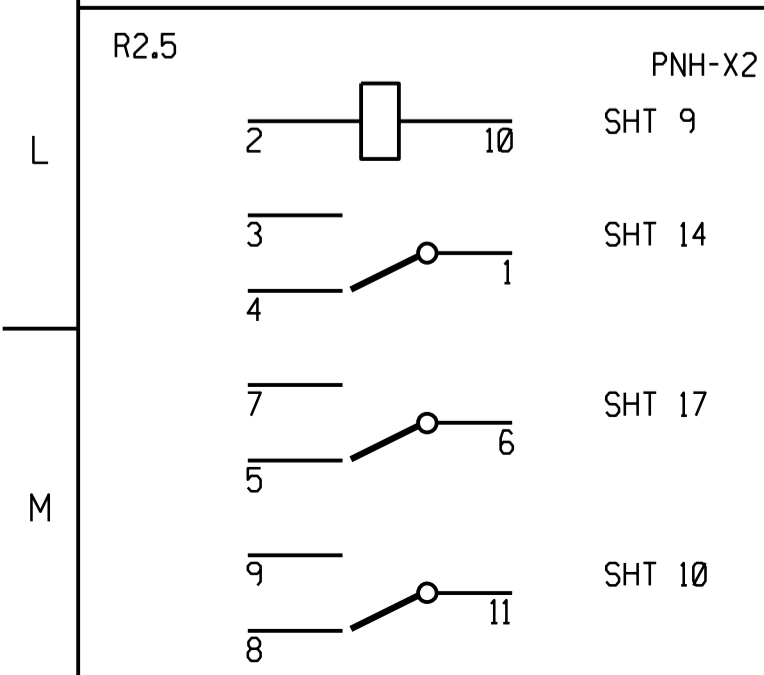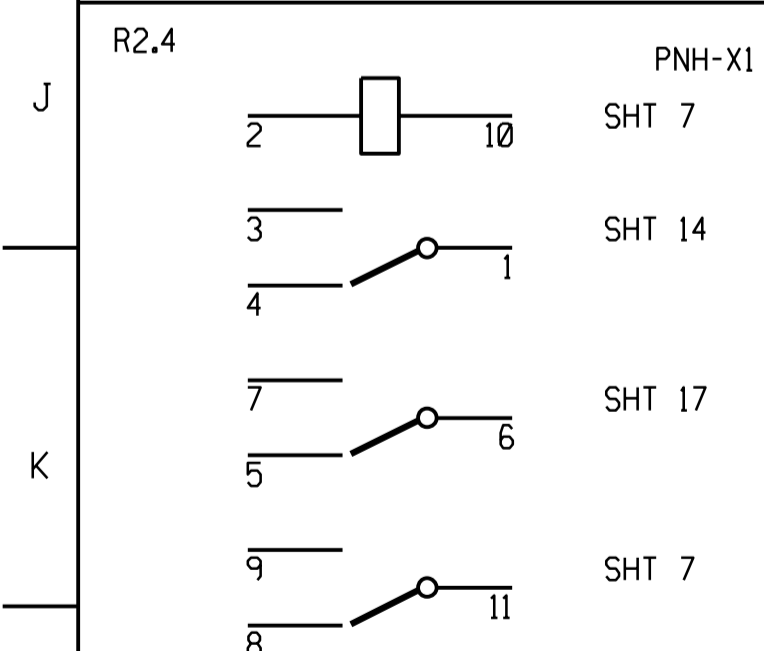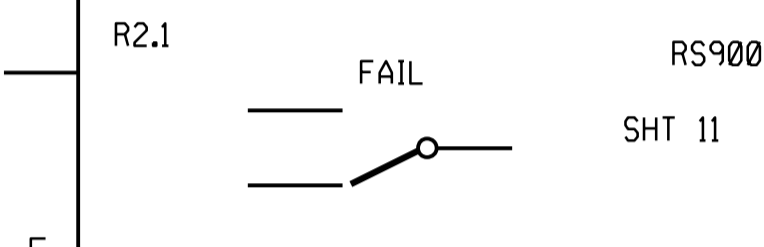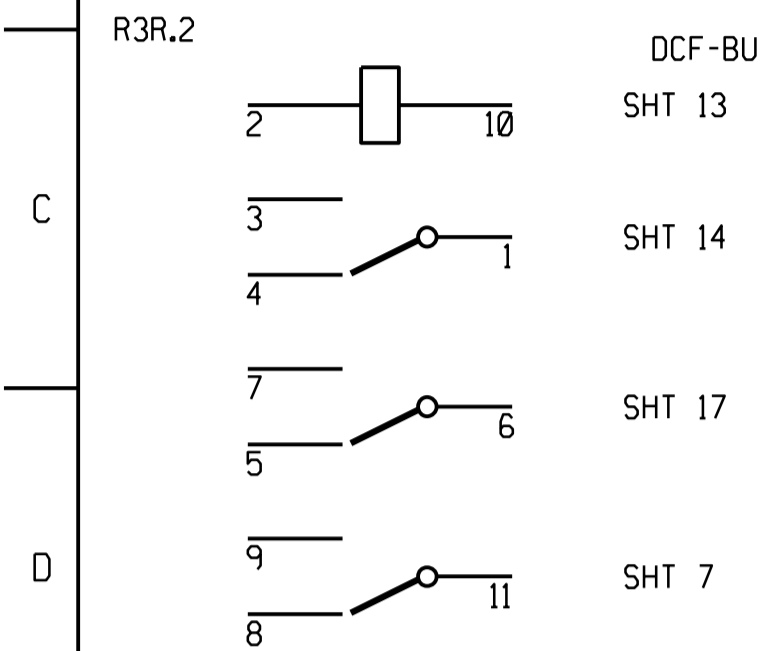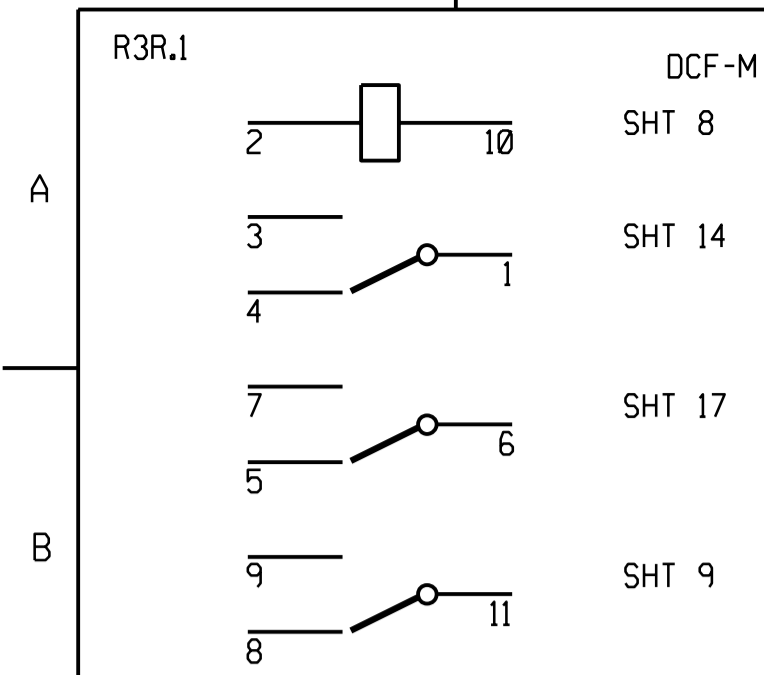

SHT 28	ISOLATOR JB
SHT 27	CABLE BLOCK
SHT 26	LINE VT DIAGRAM
SHT 25	CT JB CABLING
SHT 24	CABLING DIAGRAM
SHT 23	CABLING DIAGRAM
SHT 22	CABLING DIAGRAM
SHT 21	REFERENCE DIAG
SHT 20	REFERENCE DIAG
SHT 19	REFERENCE DIAG
SHT 18	DISTUR RECORDER
SHT 17	SUP ALARMS KEY
SHT 16	SUP STATUS, CONT
SHT 15	REA & MEAS KEY
SHT 14	SPR REW, AC KEY
SHT 13	INDICAT, DC KEY
SHT 12	CLOSE DC KEY
SHT 11	BACK-UP DC KEY
SHT 10	BACK-UP DC KEY
SHT 09	BACK-UP DC KEY
SHT 08	TELEPROT DC KEY
SHT 07	MAIN DC KEY
SHT 06	MAIN DC KEY
SHT 05	VT SUPPLY KEY
SHT 04	AC KEY DIAGRAM
SHT 03	SINGLE LINE
SHT 02	LOGIC DIAGRAM
SHT 01	PANEL LAYOUT
DRG No.	REFERENCE DRAWINGS:

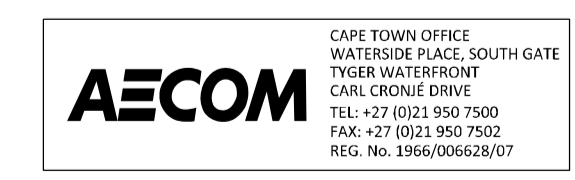

1	66kV VT & CB ADDED, FEEDER RENAMED.	KS	BH	CP	25/06/2021	153272156-00003
REV	REVISION DESCRIPTION	BY	CHKD	AUTH	DATE	PROJECT NUMBER

Eskom

ISCOR SUBSTATION 66kV FEEDER 1




PROTECTION REFERENCE DIAGRAM

PROJECT APPROVED C. PYM	DESIGN APPROVED A. CRAIB
DATE 25/06/21	DATE 13/13/10
PROJECT CHECKED B. HOMANN	DESIGN CHECKED N. MATHONSI
DATE 25/06/21	DATE 13/12/10
DRAWN BY K. STEYNBERG	DRAWN BY C. CANNON
DATE 25/06/21	DATE 26/02/10

D-WC-7104

SET NUMBER	SHEET NUMBER	REVISION
61	21	1

PANEL TYPE DESIGNATION 4FZD-3920

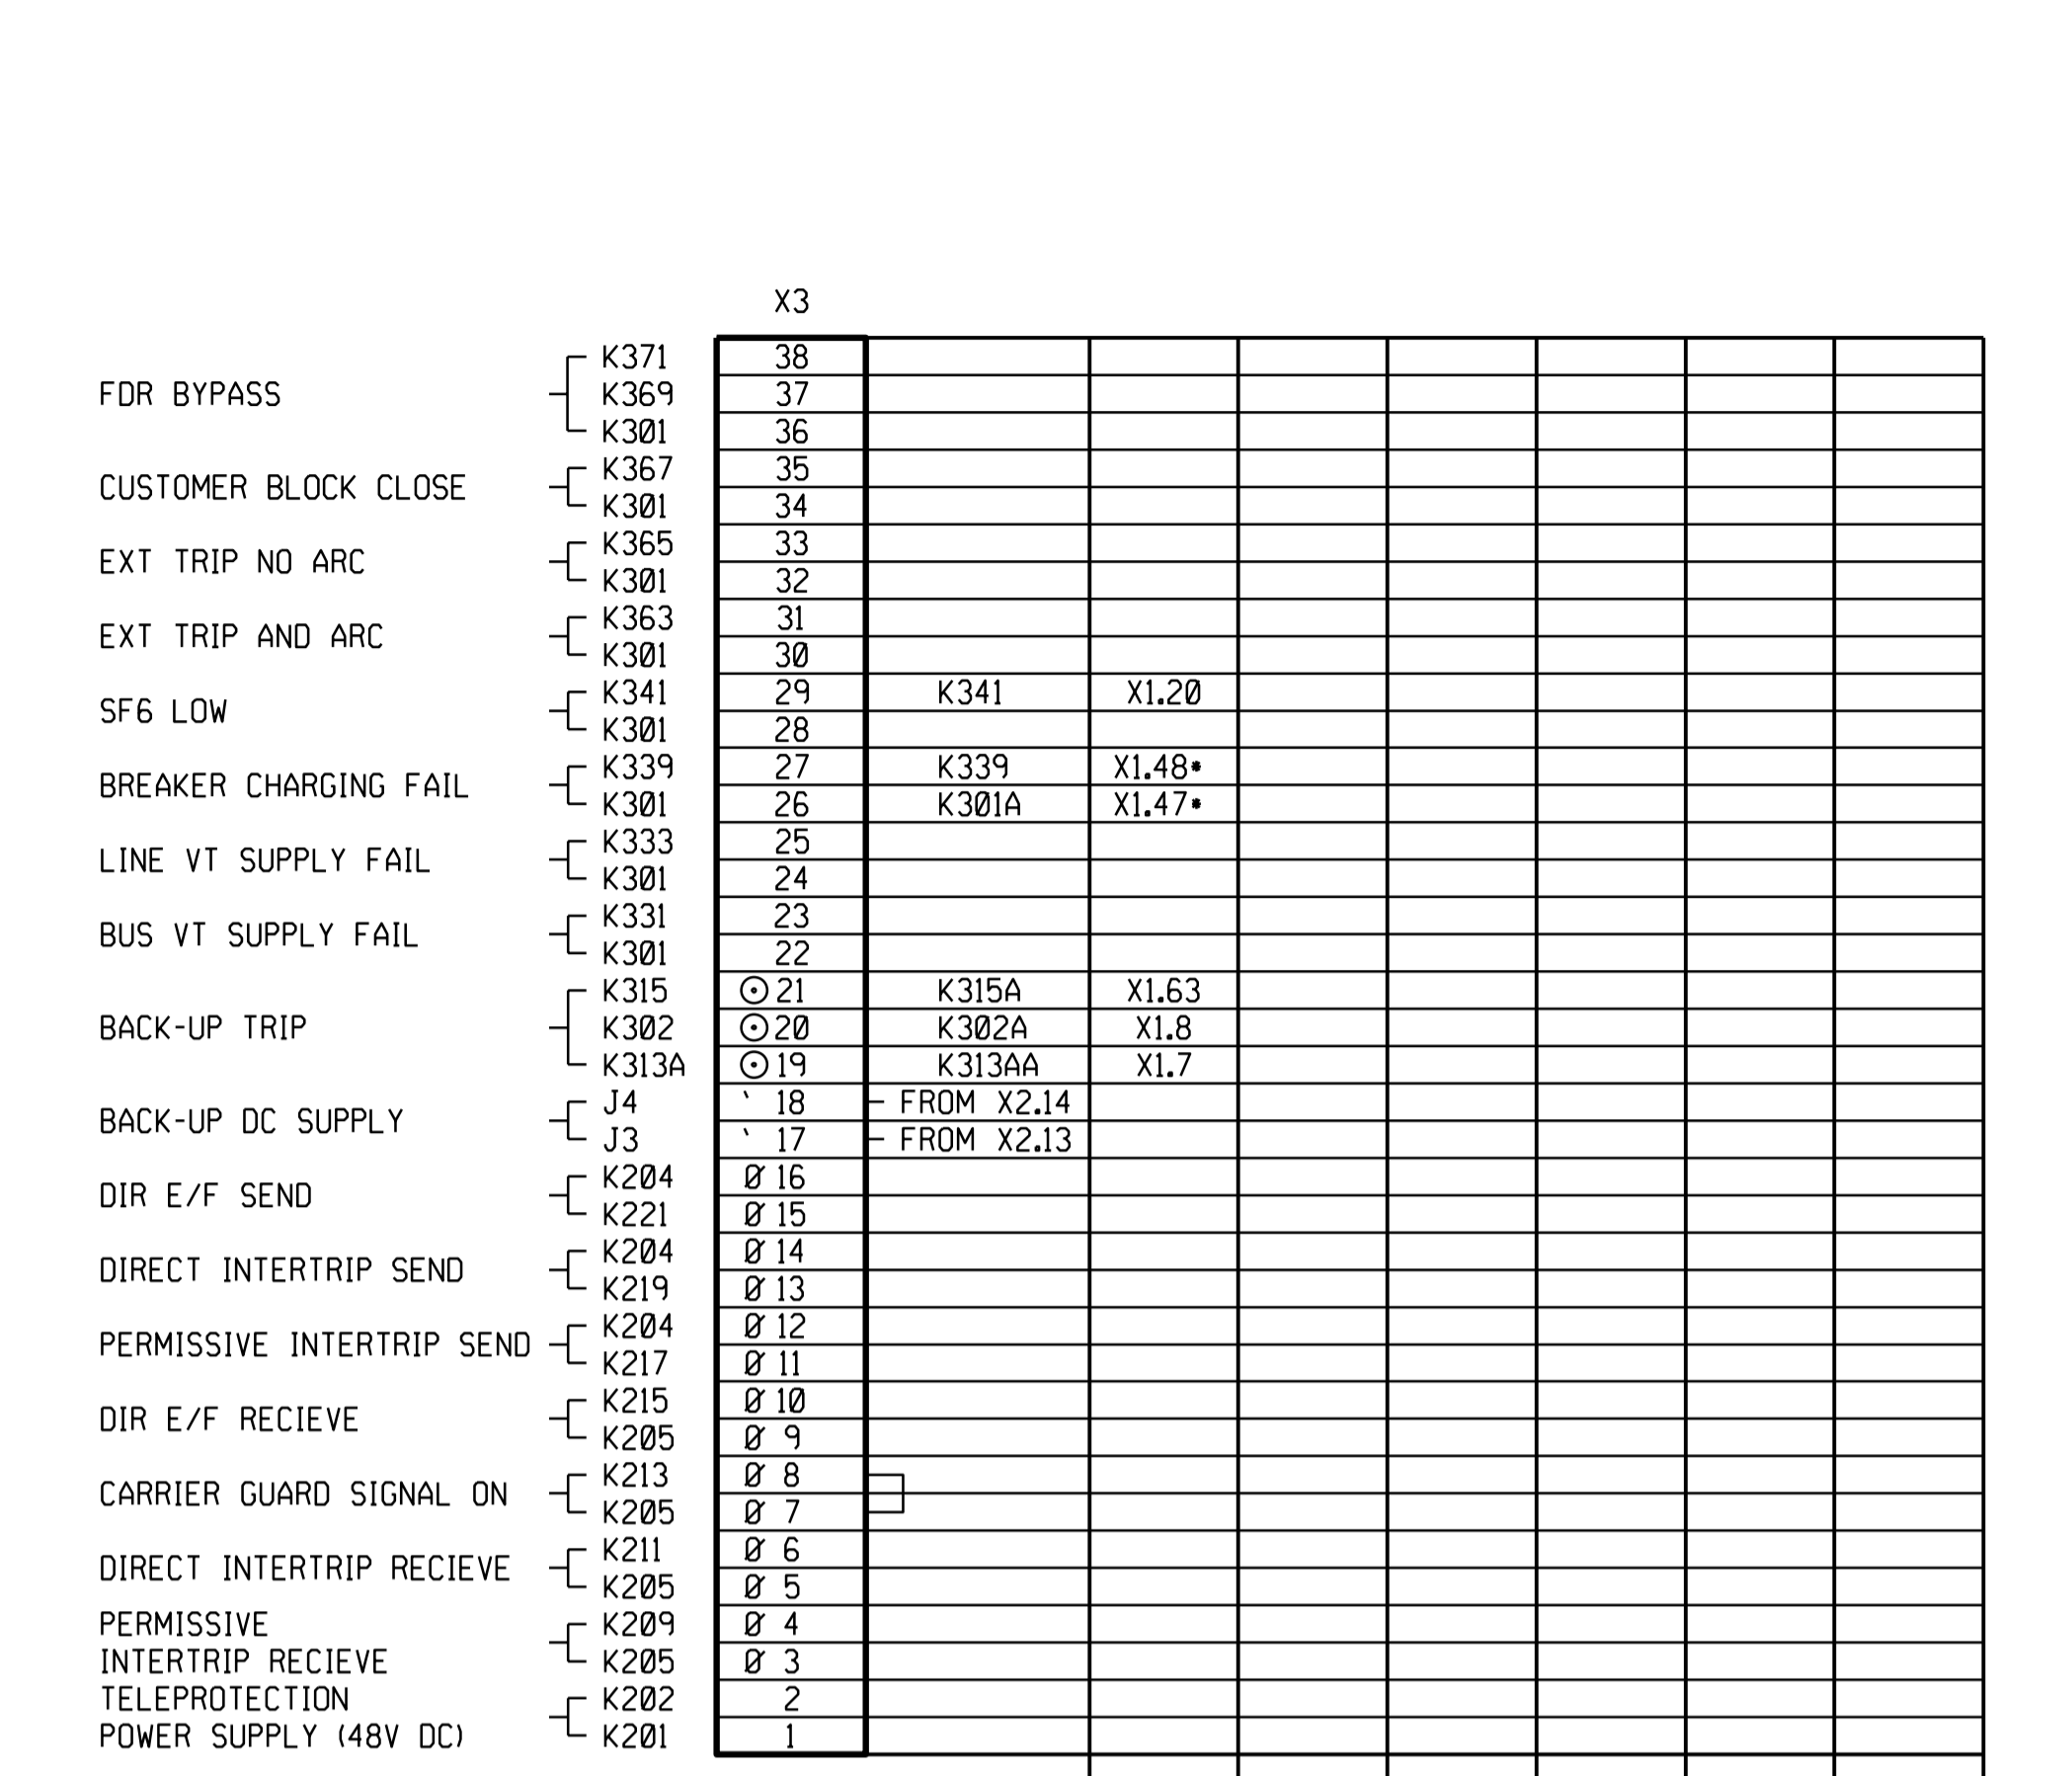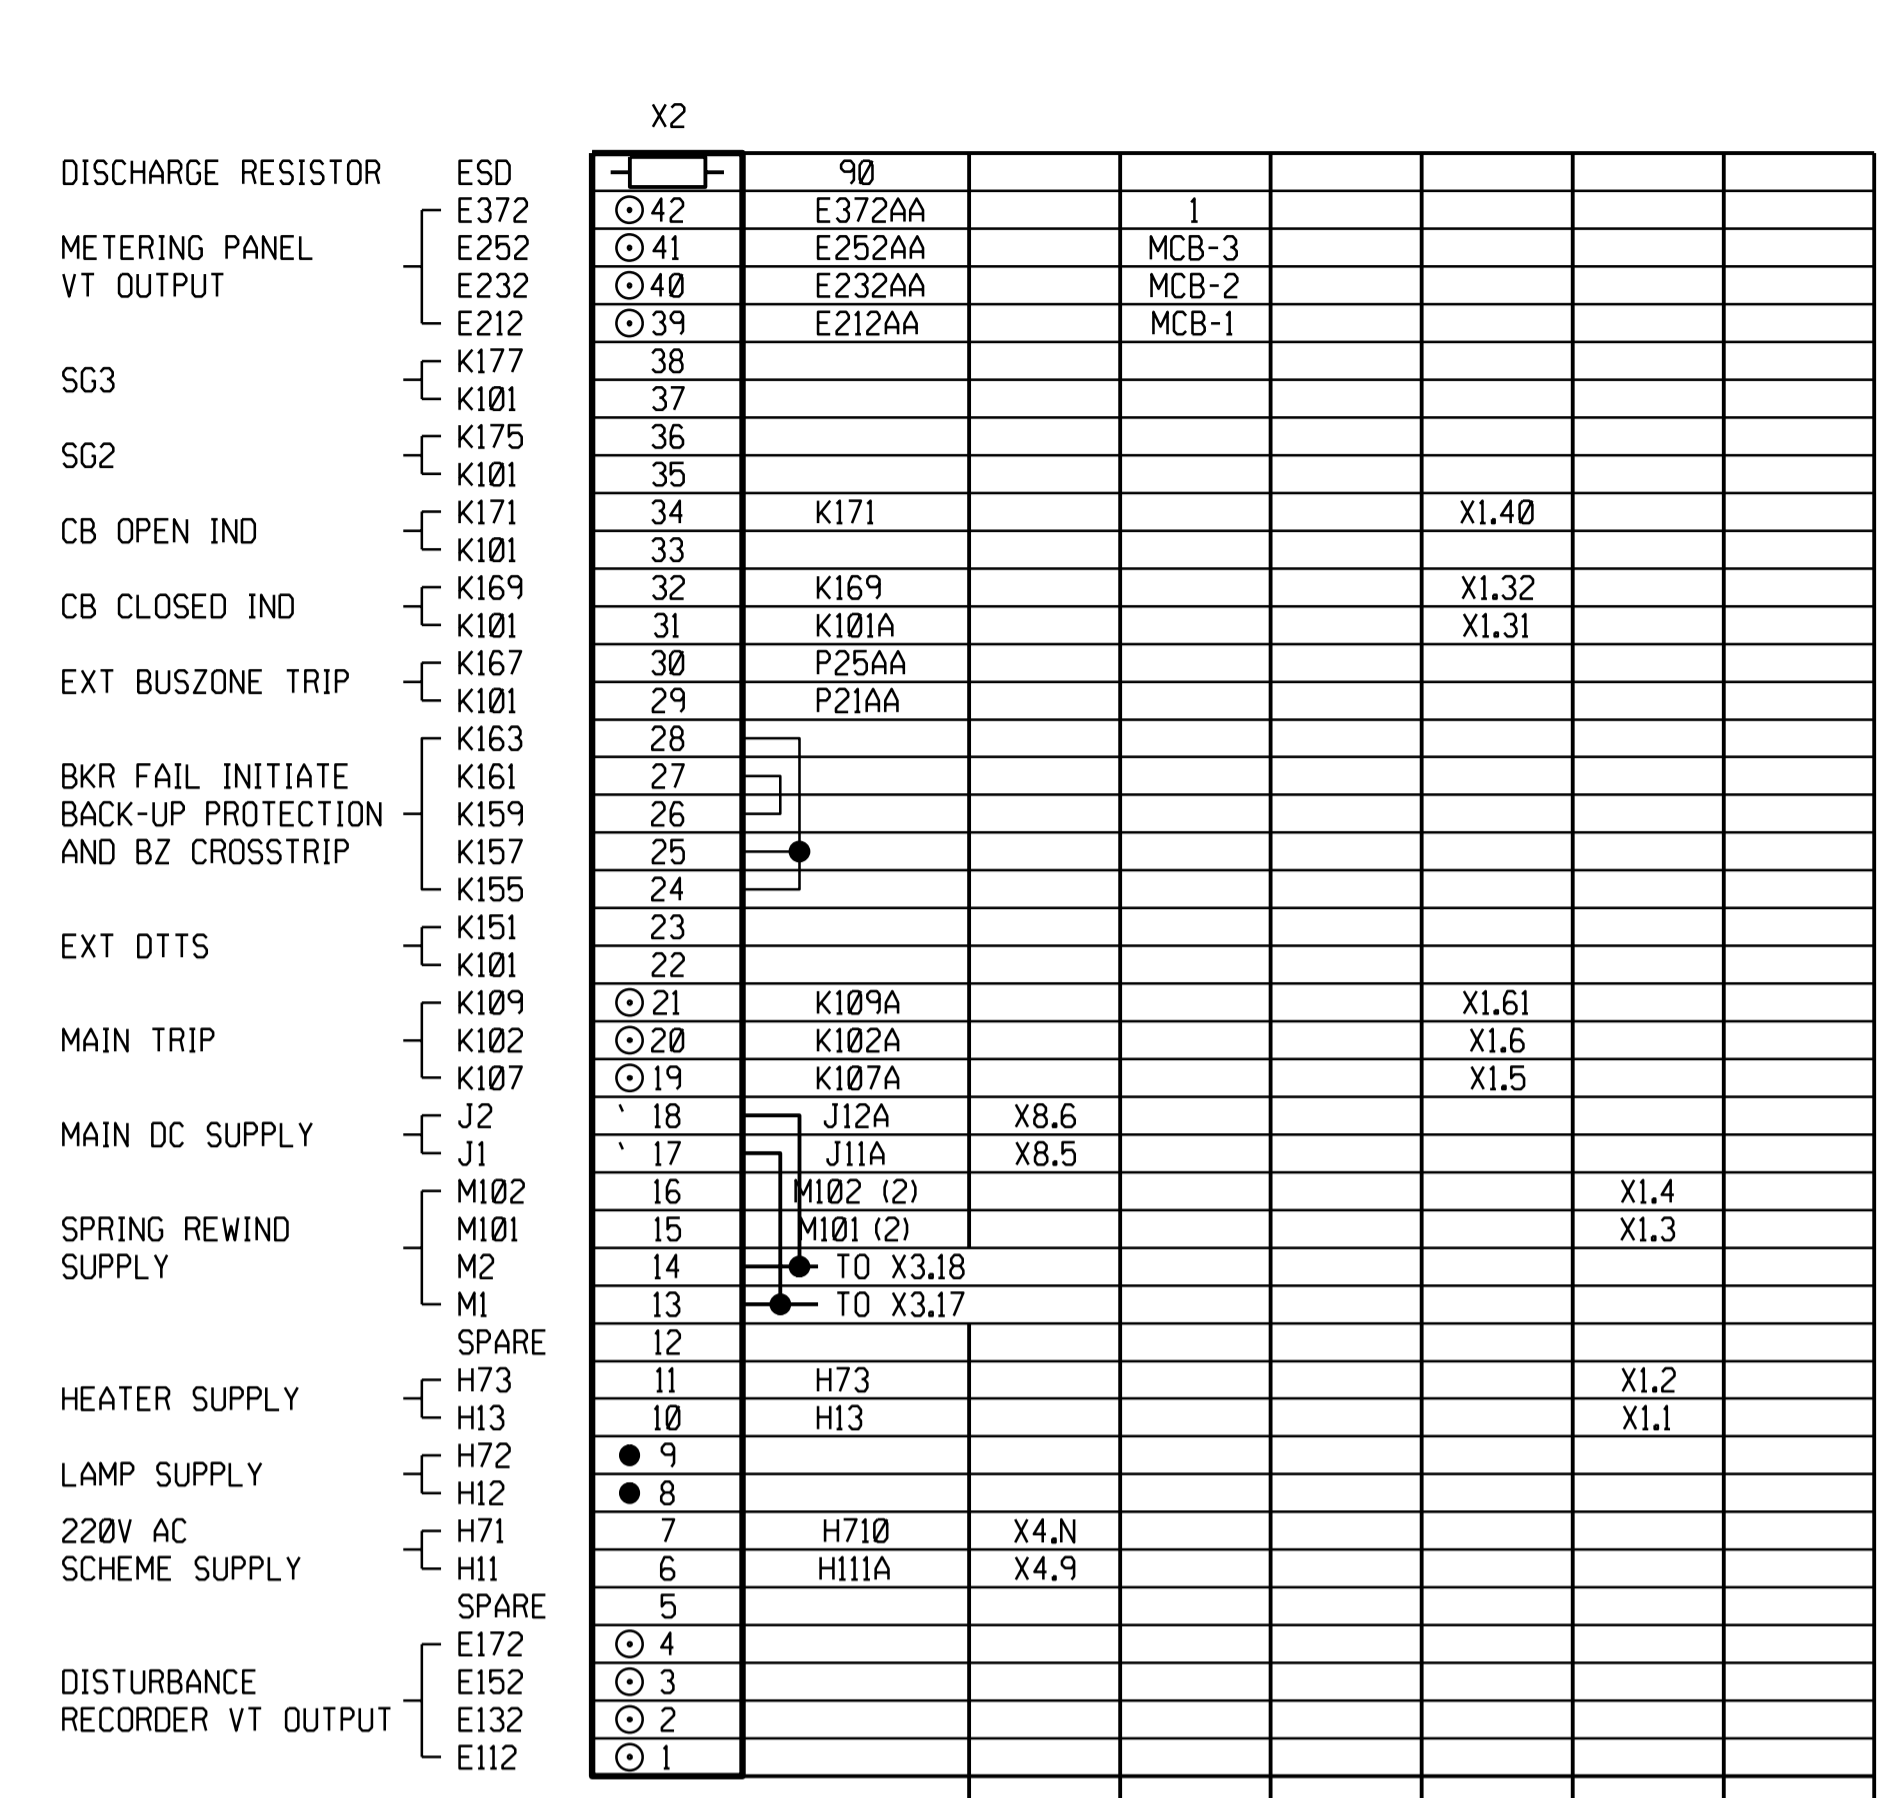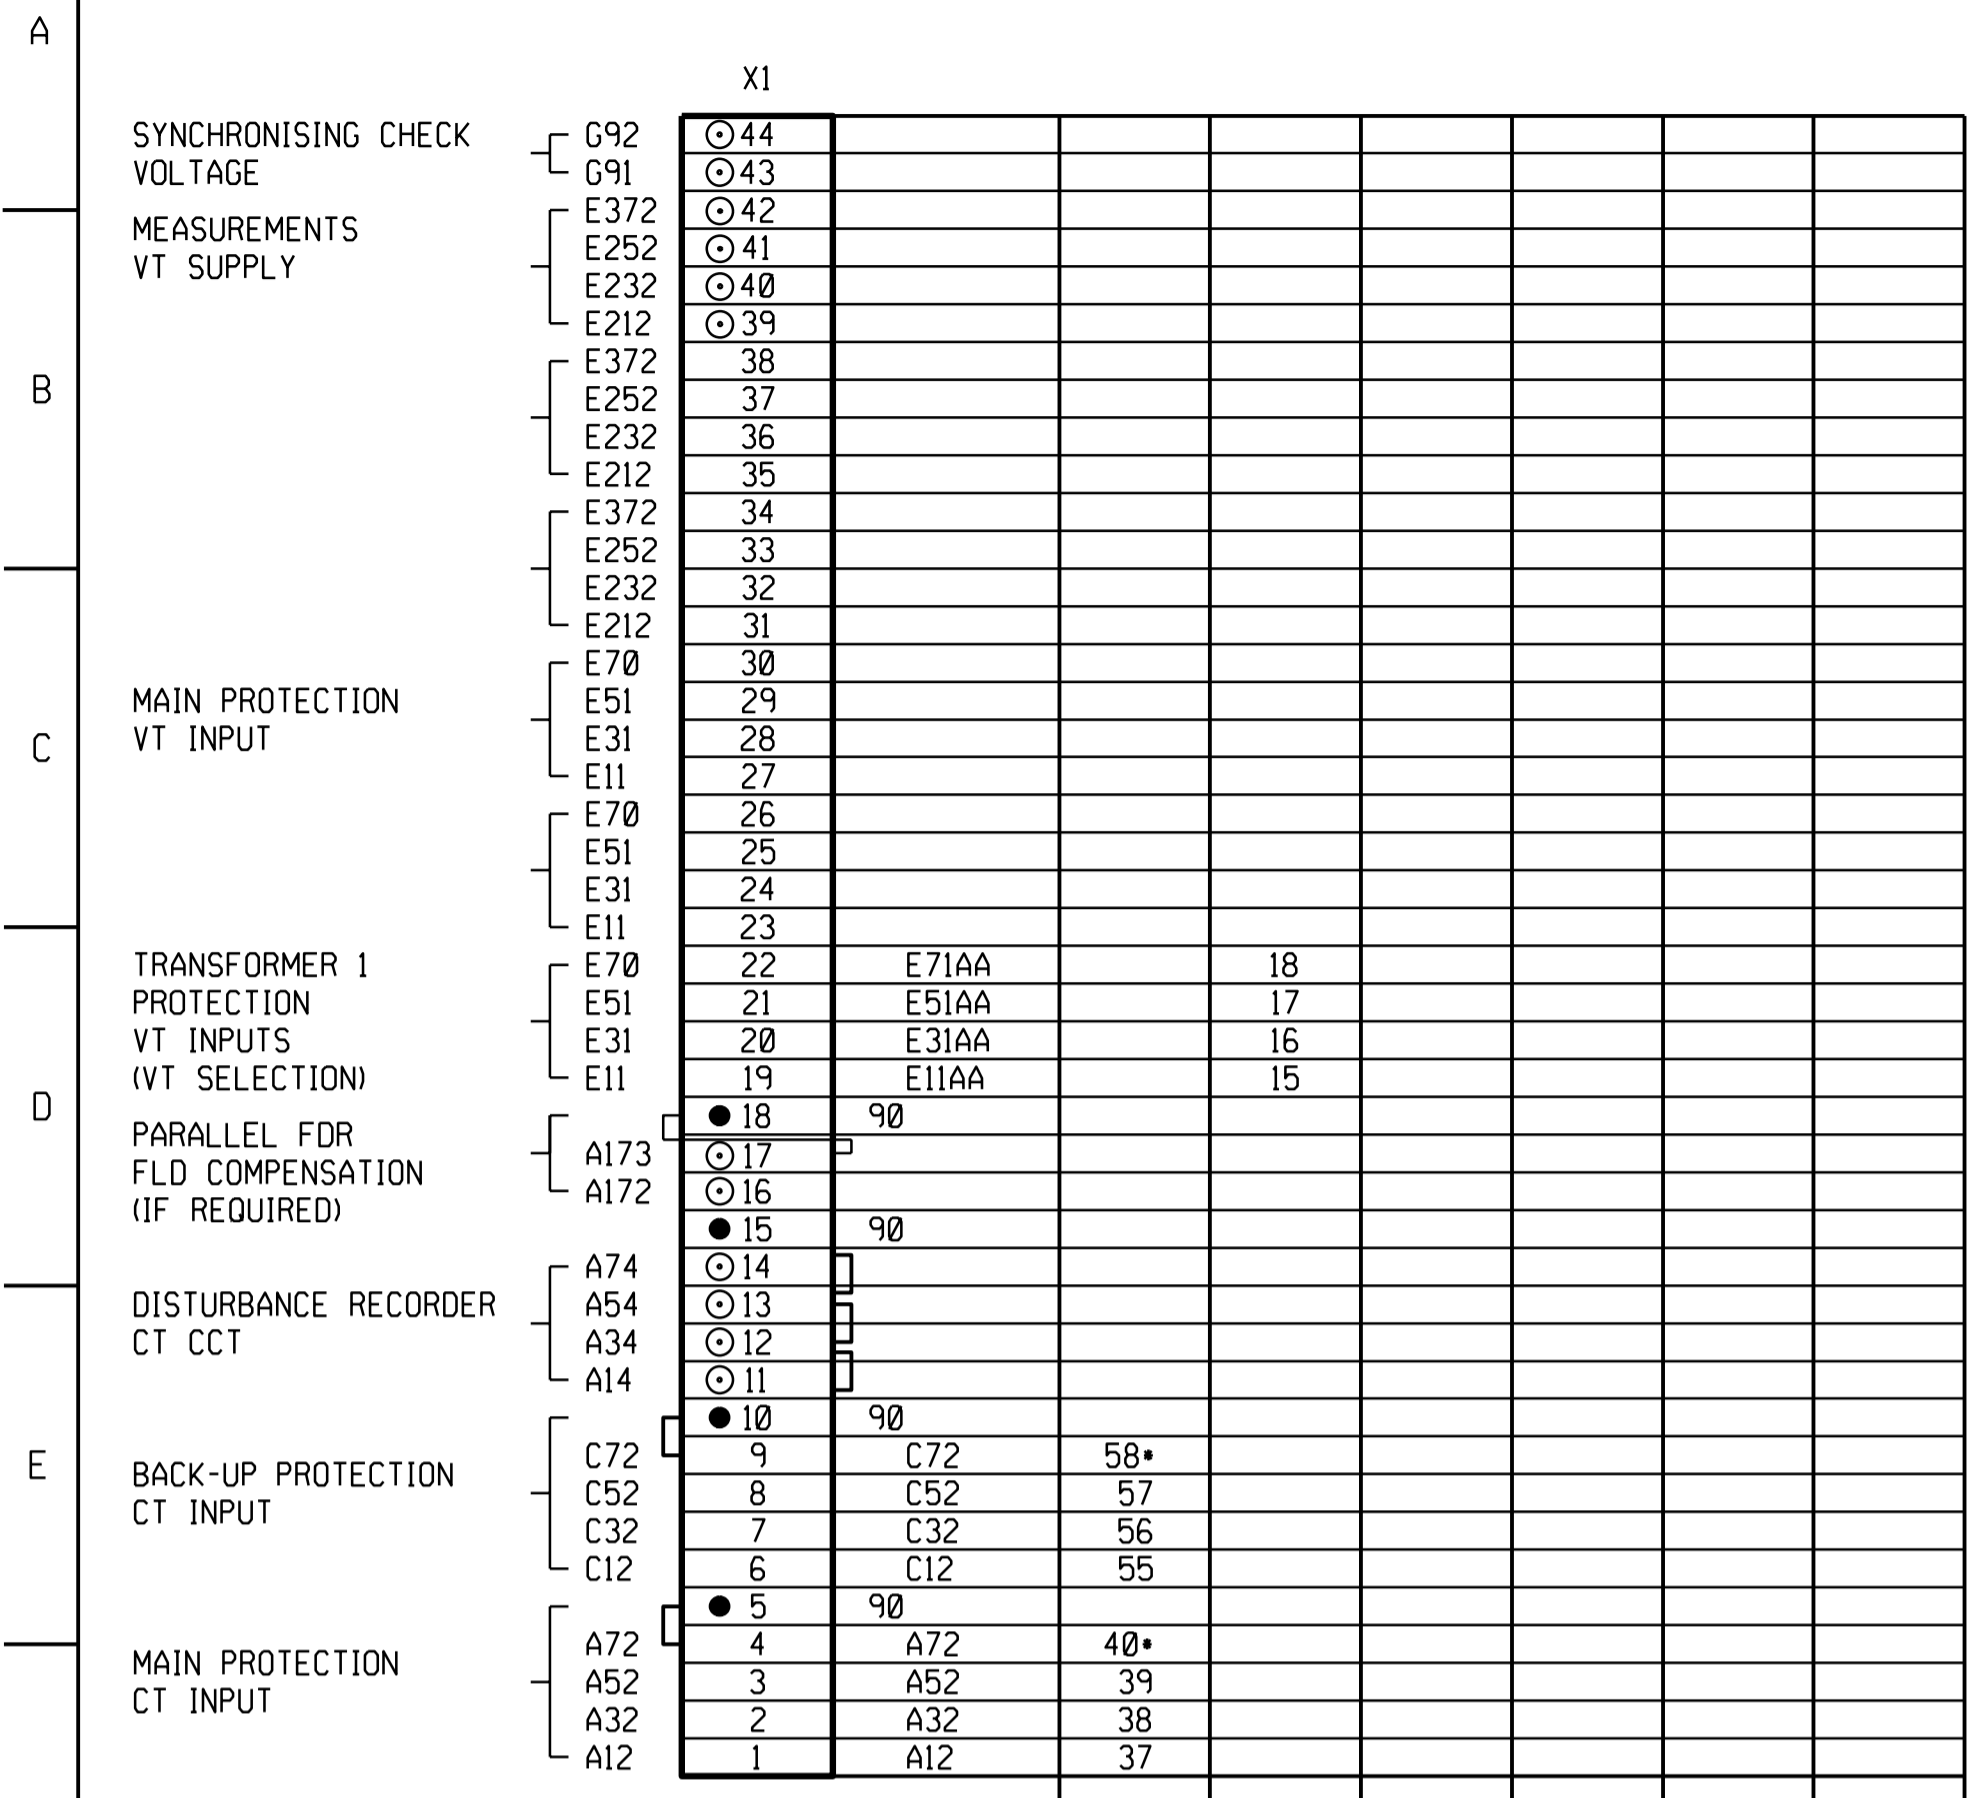

CABLE NUMBER	AA104	AA112
CABLE SIZE	12	12
NUMBER OF SPARES	8	8
DESTINATION	CT JUNCTION BOX	66KV TRANSFORMER 1 VTJB

CABLE NUMBER	AA122	AA107	AA105	AA106
CABLE SIZE	4	4	19	12
NUMBER OF SPARES	0	0	1	6
DESTINATION	AC/DC DISTRIBUTION BOARD	STATS METERING PANEL	HV CIRCUIT-BREAKER	HV CIRCUIT-BREAKER

CABLE NUMBER	AA105
CABLE SIZE	19
NUMBER OF SPARES	1
DESTINATION	HV CIRCUIT-BREAKER

RP	TERMINAL LOOPS
CB MB	X2.13 - X3.17; X2.14 - X3.18
	X1.18 - X1.48; X1.31 - X1.39;
	X1.17 - X1.19 - X1.47
CTJB	40 - 41 - 42; 46 - 47 - 48; 52 - 53 - 54;
	58 - 59 - 60; 61 - 62 - 63 - 64 - 65 - 66 - E; 70 - 71 - 72 - E

NOTE:

- (2) INDICATES TWO LEADS IN PARALLEL.
- SPARE CABLE LEADS TO BE LEFT LONG ENOUGH TO REACH THE FURTHEST TERMINAL.
- LEAD NUMBERS SHOWN THUS
 K101 K101 INDICATES NO CHANGE IN LEAD NUMBER.
 K301 K305 INDICATES CHANGE IN LEAD NUMBER.
- SEE CABLE BLOCK DIAGRAM FOR PREFIXING.

STANDARD TERMINALS USED ARE ENTRELEC M10/10.RS

- D6/8-ST-RS ENTRELEC SLIDING LINK TEST TERMINAL
- D6/8 ST1 RS TEST AND SHORTING LINKS WITH SAFETY CONNECTIONS (YELLOW INSULATED TEST POINTS)
- ⊘ M4/6 RS SPRING LOADED ENTRELEC
- : M4/6SNTS ENTRELEC SHORTING STRIP (ORANGE) SPRING LOADED TERMINALS
- X D2.5/5 SN ADD ENTRELEC TERMINALS
- M4/8 SF ENTRELEC FUSE TERMINALS
- ' ENTRELEC ISNA168237R0500 TEST SOCKET - AL4 - DIA 4mm (INSTALLED IN CENTRE SPACING OF TERMINAL)
- ▣ M4/6 RS SPRING LOADED ENTRELEC WITH RESISTOR INSERTED

- NOTE THAT D6/8 ST1 RS TERMINALS MAY BE USED IN PLACE OF D6/8-ST-RS TERMINALS. THE YELLOW INSULATED TEST POINTS MAY BE REMOVED FROM THE EARTH LINKS, AT THE COMMISSIONING TECHNICIANS DISCRETION.
- FINE TOOTHED HORIZONTAL TRUNKING SHALL BE USED.

SHT No.	REFERENCE DRAWINGS:	DRG No.	REFERENCE DRAWINGS:
SHT 15	REA & MEAS KEY	SHT 14	SPR REW, AC KEY
SHT 14	INDICAT, DC KEY	SHT 12	CLOSE DC KEY
SHT 13	INDICAT, DC KEY	SHT 11	BACK-UP DC KEY
SHT 12	CLOSE DC KEY	SHT 10	BACK-UP DC KEY
SHT 11	BACK-UP DC KEY	SHT 09	BACK-UP DC KEY
SHT 10	BACK-UP DC KEY	SHT 08	TELEPROT DC KEY
SHT 09	BACK-UP DC KEY	SHT 07	MAIN DC KEY
SHT 08	TELEPROT DC KEY	SHT 06	MAIN DC KEY
SHT 07	MAIN DC KEY	SHT 05	VT SUPPLY KEY
SHT 06	MAIN DC KEY	SHT 04	AC KEY DIAGRAM
SHT 05	VT SUPPLY KEY	SHT 03	SINGLE LINE
SHT 04	AC KEY DIAGRAM	SHT 02	LOGIC DIAGRAM
SHT 03	SINGLE LINE	SHT 01	PANEL LAYOUT
SHT 02	LOGIC DIAGRAM		
SHT 01	PANEL LAYOUT		

66kV VT & CB ADDED, FEEDER RENAMED.		KS	BH	CP	25/06/2021	153272156-00003
REV	REVISION DESCRIPTION	BY	CHKD	AUTH	DATE	PROJECT NUMBER

PROJECT APPROVED
C. PYM

DATE 25/06/21

PROJECT CHECKED
B. HOMANN

DATE 25/06/21

DESIGN APPROVED
A. CRAIB

DATE 13/13/10

DESIGN CHECKED
N. MATHONSI

DATE 13/12/10

DRAWN BY
K. STEYNBERG

DATE 25/06/21

ISCOR SUBSTATION

66kV FEEDER 1

PANEL CABLING DIAGRAM

D-WC-7104	61	22	1
SET NUMBER		SHEET NUMBER	
REVISION		REVISION	

PANEL TYPE DESIGNATION 4FZD-3920



REV	AUTH	DATE	REVISION TO MASTER	BY	CHKD	SCALE


Terminal	Symbol	Terminal	Symbol	Terminal	Symbol	Terminal	Symbol
X4							
W4	: 49						
W3	: 48						
W2	: 47						
W1	: 46						
BSYNCH	: 45						
ASYNCH	: 44						
L141	: 43						
L139	: 42						
L137	: 41						
L135	: 40						
L133	: 39						
L131	: 38						
L102	● 37						
K502	● 36						
L101	● 35						
K501	● 34						
K502	● 33	K502A		X1.12A			
K523	● 32	K523A		X1.11			
K521	● 31						
K501	● 30						
K501	● A29						
P17	28	P17AA					
P7	27	P7AA					
T7	26						
T3	25						
K302	⊙ 24	X102					
K301	⊙ 23	X101					
K302	22						
K301	21						
K302	20						
K301	19						
K302	18	K302B		X1.16			
K301	17	K301C		X1.15			
K391	16						
K389	15						
K301	14						
K387	13	K387		X2.6			
K385	12	K385		X2.5			
K301	11	K301E		X2.4			
K383	10	K383		X2.3			
K381	9	K381		X2.2			
K301	8	K301D		X2.1			
K302	● 7						
K377	● 6						
K301	● 5						
K375	● 4	K375A					
K301	● 3	K301A					
K373	2	K373		X1.28			
K301	1	K301B		X1.27			

CABLE NUMBER	AA115	AA105
CABLE SIZE	19	19
NUMBER OF SPARES	7	1
DESTINATION	66kV FEEDER 1 ISOLATOR JB	HV CIRCUIT BREAKER

NOTE:

- SEE CABLE BLOCK DIAGRAM FOR PREFIXING.
STANDARD TERMINALS USED ARE ENTRELEC M10/10.RS
● D6/8-ST-RS ENTRELEC SLIDING LINK TEST TERMINAL
⊙ D6/8 ST1 RS TEST AND SHORTING LINKS WITH SAFETY CONNECTIONS (YELLOW INSULATED TEST POINTS)
⊗ M4/6 RS SPRING LOADED ENTRELEC
: M4/6SNTS ENTRELEC SHORTING STRIP (ORANGE) SPRING LOADED TERMINALS
x D2.5/5 SN ADD ENTRELEC TERMINALS
□ M4/8 SF ENTRELEC FUSE TERMINALS
ENTRELEC ISNA168237R0500 TEST SOCKET - AL4 - DIA 4mm (INSTALLED IN CENTRE SPACING OF TERMINAL)
⊞ M4/6 RS SPRING LOADED ENTRELEC WITH RESISTOR INSERTED
- NOTE THAT D6/8 ST1 RS TERMINALS MAY BE USED IN PLACE OF D6/8-ST-RS TERMINALS. THE YELLOW INSULATED TEST POINTS MAY BE REMOVED FROM THE EARTH LINKS, AT THE COMMISSIONING TECHNICIANS DISCRETION.
- THE DROPPING RESISTORS HAVE BEEN REMOVED FROM THE X5 RACK AT THE REQUEST OF ABB.

Terminal	Terminal	Terminal	Terminal	Terminal	Terminal	Terminal	Terminal
X5							
X117	0 34	1b					
X115	0 33	1a					
X113	0 32	X113		X2.18			
X111	0 31	X111		X2.17			
X101	0 30	X101C		X2.16			
X109	0 29	X109		X2.15			
X107	0 28	X107		X2.14			
X101	0 27	X101B		X2.13			
X105	0 26	X105		X2.12			
X103	0 25	X103		X2.11			
X101	0 24	X101A		X2.10			
	: 23						
	: 22						
	: 21						
	: 20						
	: 19						
	: 18						
	: 17						
	: 16						
	: 15						
	: 14						
	: 13			X5.10			
	: 12			X5.9			
	: 11						
	: 10						
	: 9						
	⊙ 8						
	⊙ 7						
	⊙ 6						
	● 5	90					
	⊙ 4						
	⊙ 3						
	⊙ 2						
	⊙ 1						

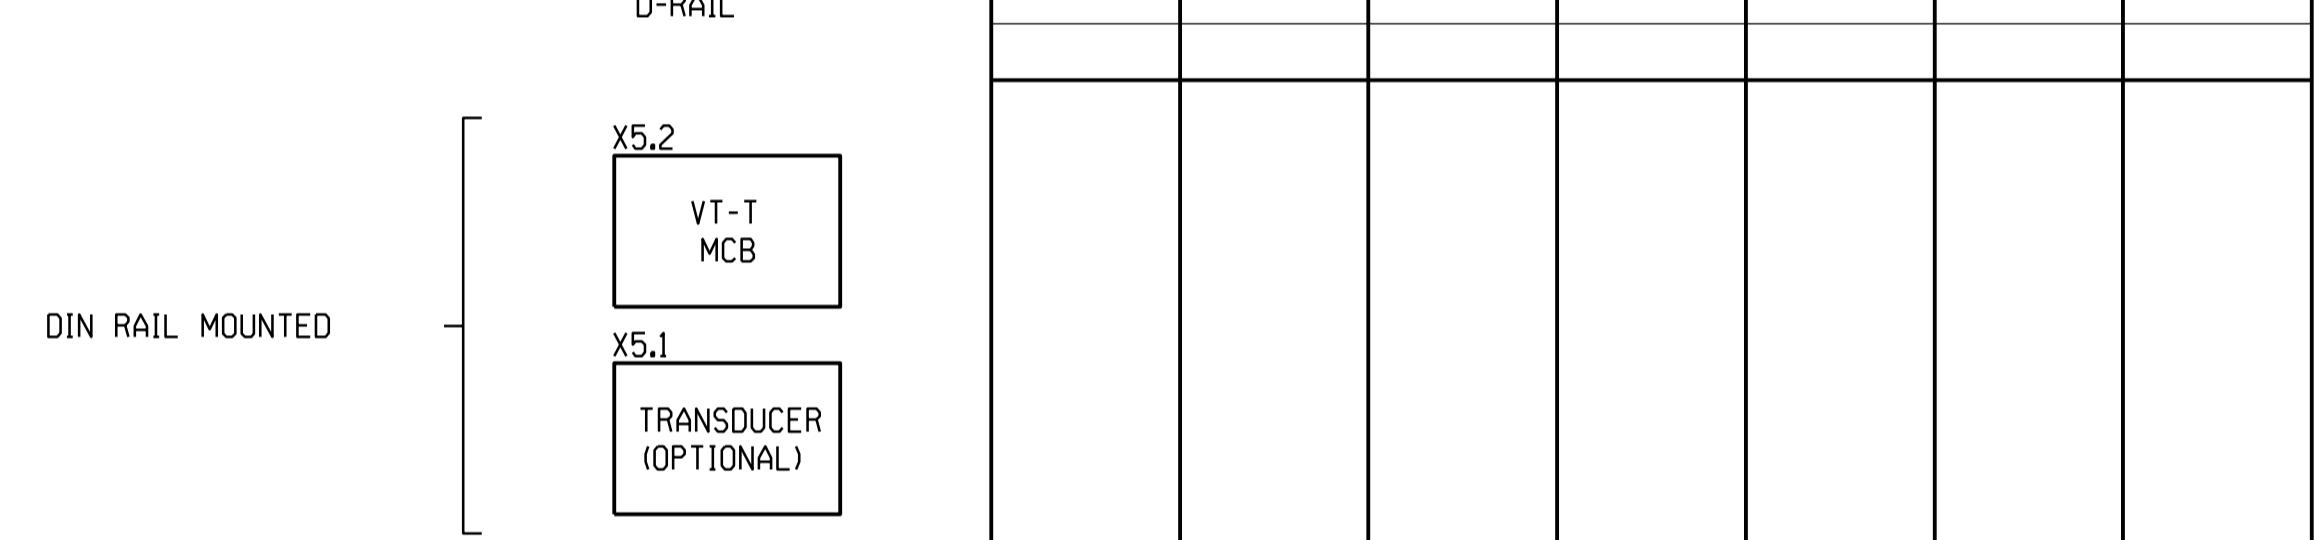


CABLE NUMBER	AA115	AA124	AA127	AA123
CABLE SIZE	4	4Pr	4Pr	10Pr
NUMBER OF SPARES	1	3Pr	3Pr	9Pr
DESTINATION	66kV FEEDER 1 ISOLATOR JB	RTU	66kV FEEDER 2 RP	IDF

TERMINAL LOOPS (*)	
LINE IS MB	X1.24 - X1.48
BB1 IS MB	X1.24 - X1.48
BB2 IS MB	X1.24 - X1.48

SHT 28	ISOLATOR JB
SHT 27	CABLE BLOCK
SHT 26	LINE VT DIAGRAM
SHT 25	CT JB CABLING
SHT 24	CABLING DIAGRAM
SHT 23	CABLING DIAGRAM
SHT 22	CABLING DIAGRAM
SHT 21	REFERENCE DIAG
SHT 20	REFERENCE DIAG
SHT 19	REFERENCE DIAG
SHT 18	DISTUR RECORDER
SHT 17	SUP ALARMS KEY
SHT 16	SUP STATUS, CONT
SHT 15	REA & MEAS KEY
SHT 14	SPR REW, AC KEY
SHT 13	INDICAT, DC KEY
SHT 12	CLOSE DC KEY
SHT 11	BACK-UP DC KEY
SHT 10	BACK-UP DC KEY
SHT 09	BACK-UP DC KEY
SHT 08	TELEPROT DC KEY
SHT 07	MAIN DC KEY
SHT 06	MAIN DC KEY
SHT 05	VT SUPPLY KEY
SHT 04	AC KEY DIAGRAM
SHT 03	SINGLE LINE
SHT 02	LOGIC DIAGRAM
SHT 01	PANEL LAYOUT
DRG No.	REFERENCE DRAWINGS:

1	66kV VT & CB ADDED, FEEDER RENAMED.	KS	BH	CP	25/06/2021	153272156-00003
REV	REVISION DESCRIPTION	BY	CHKD	AUTH	DATE	PROJECT NUMBER
ISCOR SUBSTATION 66kV FEEDER 1 PANEL CABLING DIAGRAM						
D-WC-7104		SET NUMBER	SHEET NUMBER	REVISION		
		61	23	1		

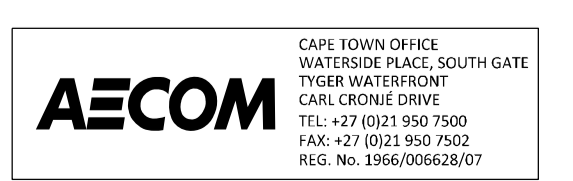


REV	AUTH	DATE	REVISION TO MASTER	BY	CHKD	SCALE
-	-	-	-	-	-	-

MASTER TRACING FILED UNDER D-DT-15007 SHEET 23 OF 28 REVISION 2

TOP OF TERMINAL STRIP

To CURRENT TRANSFORMERS				X1
		6S5	D171B	36
		6S1	D151	35
		5S5	D71B	34
		5S1	D51	33
		4S2	C71B	32
		4S1	C51	31
		3S5	B71B	30
		3S1	B51	29
		2S5	B171B	28
		2S1	B150	27
		1S2	A71B	26
		1S1	A51	25
	6S5		D171W	24
	6S1		D131	23
	5S5		D71W	22
	5S1		D31	21
	4S2		C71W	20
	4S1		C31	19
	3S5		B71W	18
	3S1		B31	17
	2S5		B171W	16
	2S1		B130	15
	1S2		A71W	14
	1S1		A31	13
	6S5		D171R	12
	6S1		D111	11
	5S5		D71R	10
	5S1		D11	9
	4S2		C71R	8
	4S1		C11	7
	3S5		B71R	6
	3S1		B11	5
	2S5		B171R	4
	2S1		B110	3
	1S2		A71R	2
	1S1		A11	1

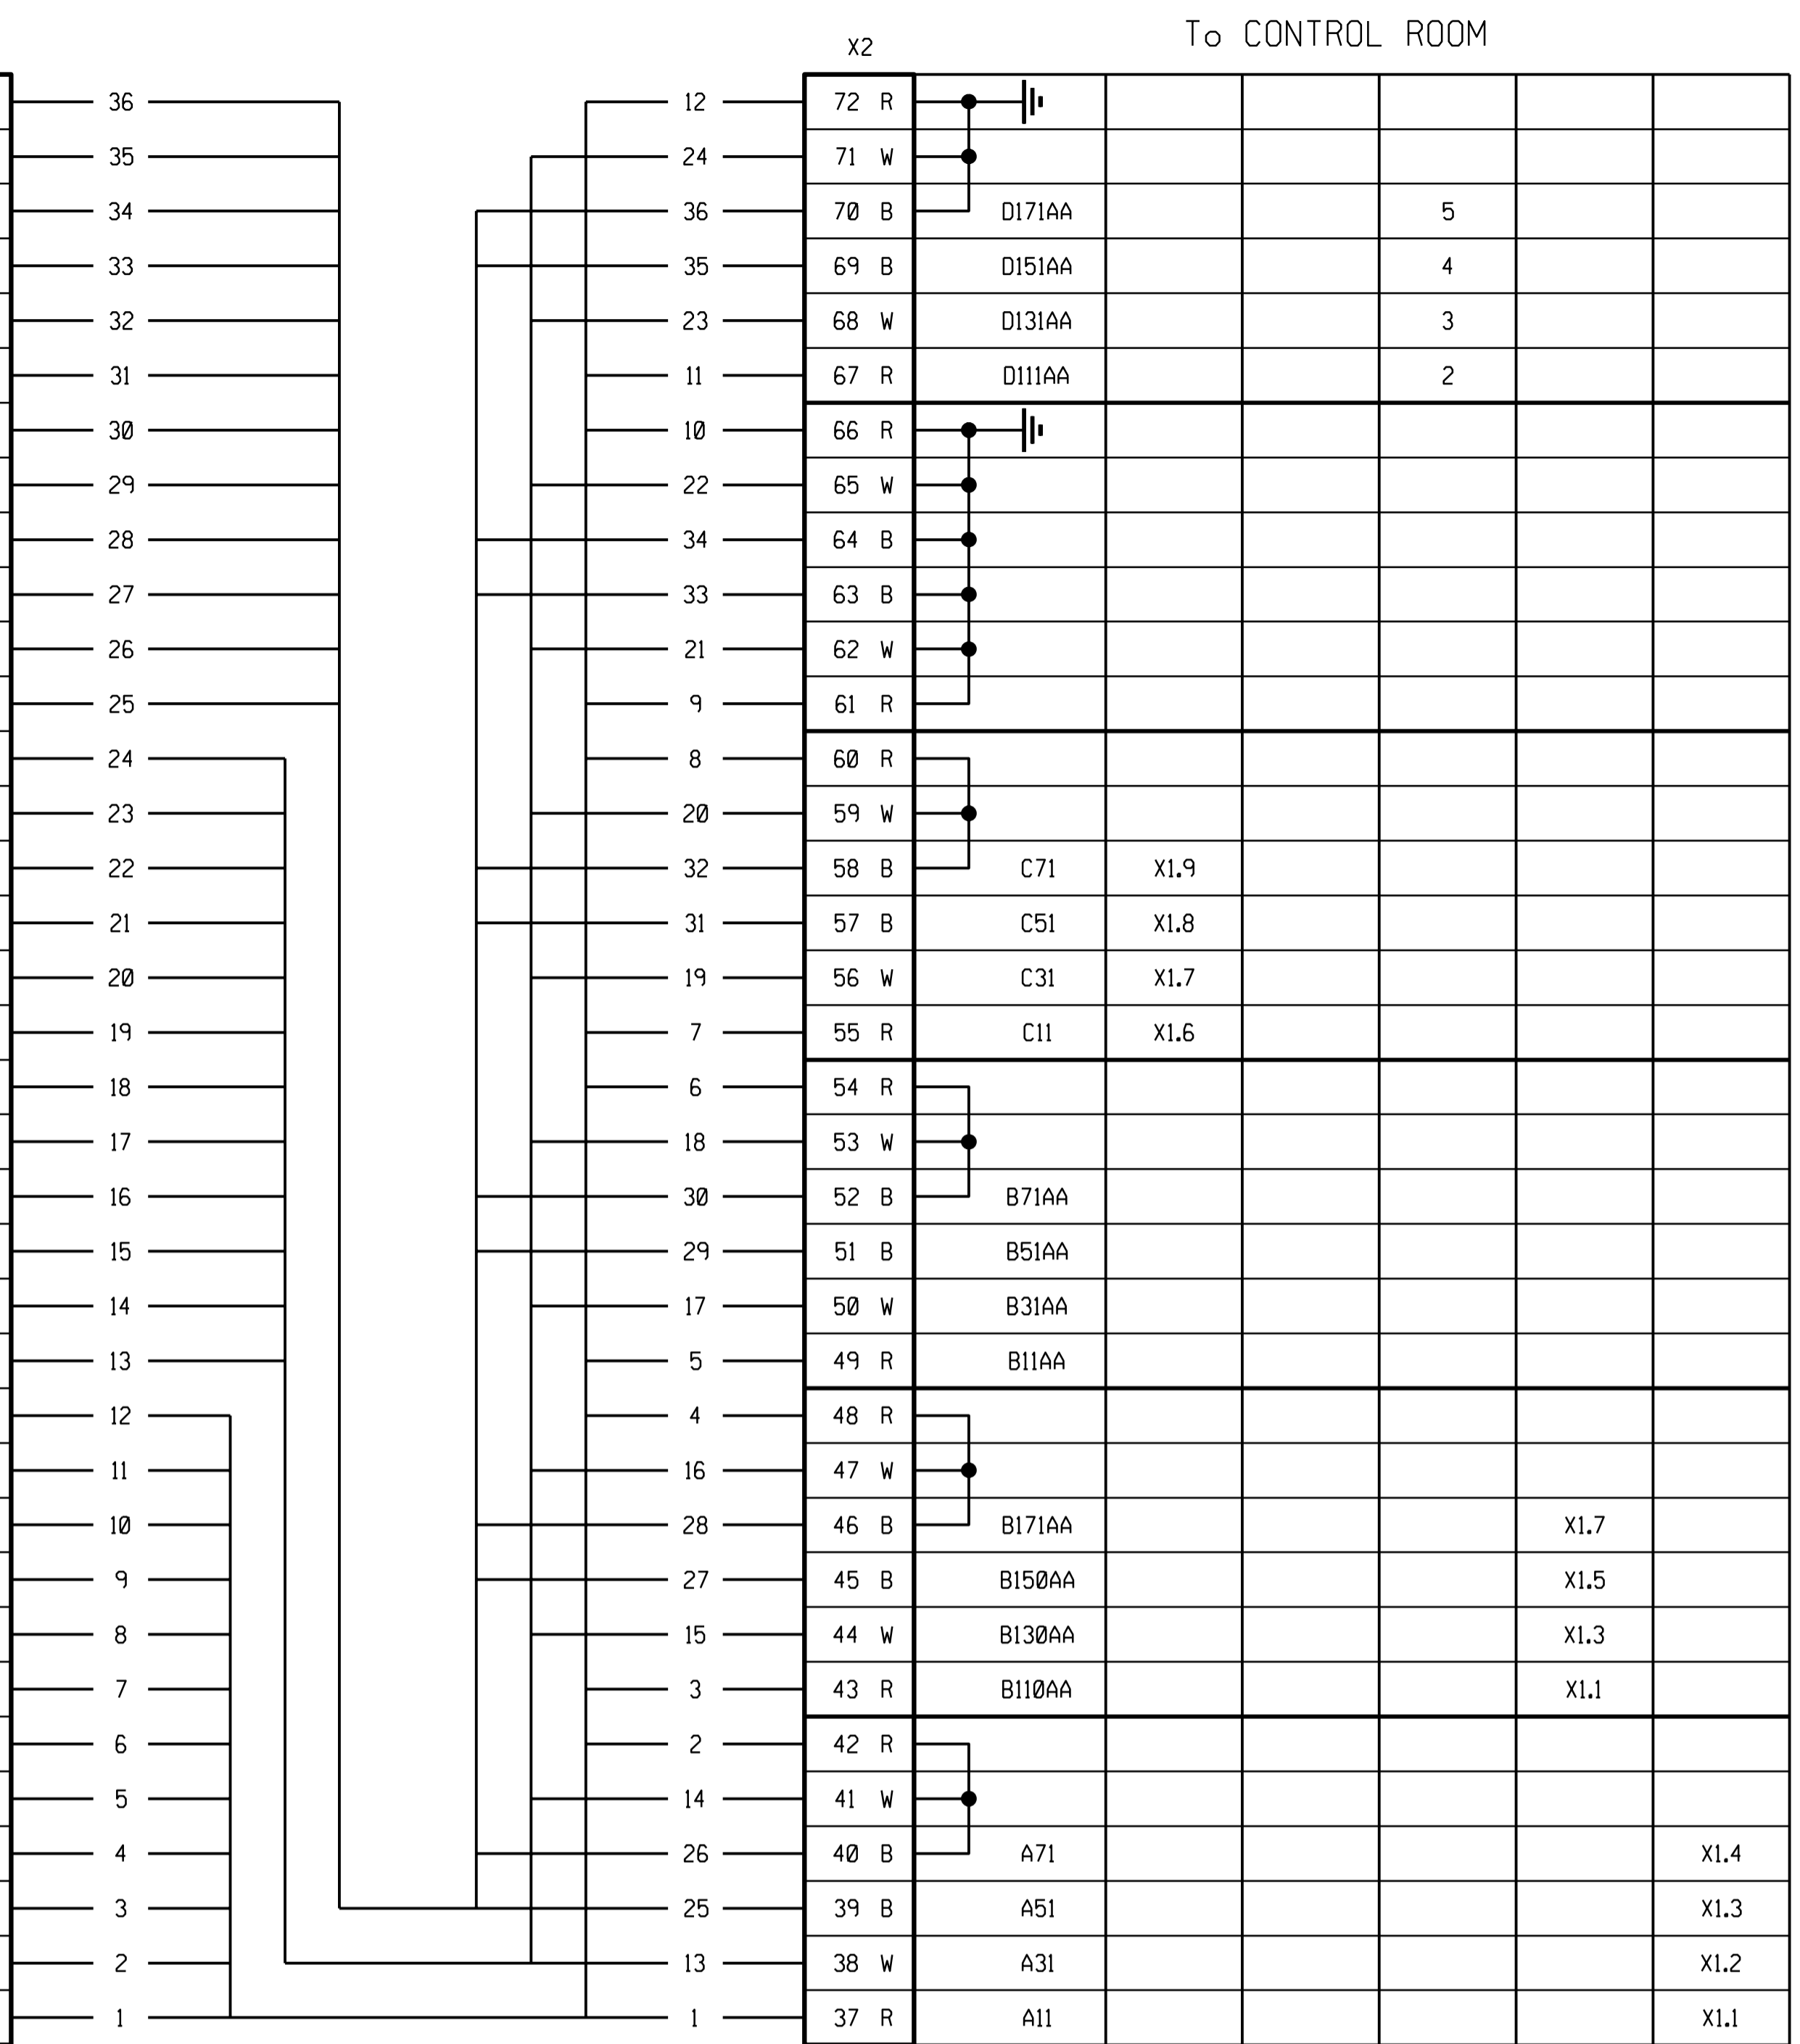

CABLE NUMBER	AA104	AA118	AA126	EA504
CABLE SIZE	12	4	4	12
NUMBER OF SPARES	8	0	0	8
DESTINATION	66kV FEEDER 1 RELAY PANEL	STATISTICAL METERING PANEL	66kV FEEDER 1 ISOLATOR JB	66/11kV TRANSFORMER 1 RELAY PANEL

AA101	AA102	AA103	CABLE NUMBER
12	12	12	CABLE SIZE
0	0	0	NUMBER OF SPARES
66kV FEEDER 1 66kV RED PHASE CT	66kV FEEDER 1 66kV WHITE PHASE CT	66kV FEEDER 1 66kV BLUE PHASE CT	DESTINATION

TERMINAL LOOPS (*)	
CT JB	40-41-42, 46-47-48, 52-53-54, 58-59-60, 61-62-63-64-65-66-E; 70-71-72-E.

SHT 28	ISOLATOR JB
SHT 27	CABLE BLOCK
SHT 26	LINE VT DIAGRAM
SHT 25	CT JB CABLING
SHT 24	CABLING DIAGRAM
SHT 23	CABLING DIAGRAM
SHT 22	CABLING DIAGRAM
SHT 21	REFERENCE DIAG
SHT 20	REFERENCE DIAG
SHT 19	REFERENCE DIAG
SHT 18	DISTUR RECORDER
SHT 17	SUP ALARMS KEY
SHT 16	SUP STATUS, CONT
SHT 15	REA & MEAS KEY
SHT 14	SPR REW, AC KEY
SHT 13	INDICAT, DC KEY
SHT 12	CLOSE DC KEY
SHT 11	BACK-UP DC KEY
SHT 10	BACK-UP DC KEY
SHT 09	BACK-UP DC KEY
SHT 08	TELEPROT DC KEY
SHT 07	MAIN DC KEY
SHT 06	MAIN DC KEY
SHT 05	VT SUPPLY KEY
SHT 04	AC KEY DIAGRAM
SHT 03	SINGLE LINE
SHT 02	LOGIC DIAGRAM
SHT 01	PANEL LAYOUT
DRG No.	REFERENCE DRAWINGS:

1	66kV VT & CB ADDED, FEEDER RENAMED.	KS	BH	CP	25/06/2021	153272156-00003
REV	REVISION DESCRIPTION	BY	CHKD	AUTH	DATE	PROJECT NUMBER

PROJECT APPROVED	A. CRAIB
C. PYM	
DATE 25/06/21	DATE 13/13/10
PROJECT CHECKED	DESIGN CHECKED
B. HOMANN	N. MATHONSI
DATE 25/06/21	DATE 13/12/10
DRAWN BY	DRAWN BY
K. STEYBERG	C. CANNON
DATE 25/06/21	DATE 26/02/10

Eskom

ISCOR SUBSTATION


66kV FEEDER 1

CTJB CABLING DIAGRAM

D-WC-7104

SET NUMBER	SHEET NUMBER	REVISION
61	25	1

PANEL TYPE DESIGNATION 4FZD-3920

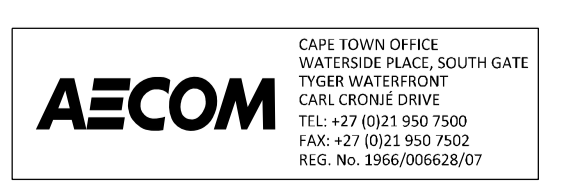

REV	AUTH	DATE	REVISION TO MASTER	BY	CHKD	SCALE
-	-	-	-	-	-	-


(NOT USED)
SEE D-WC-7104 SET 159

SHT 28	ISOLATOR JB
SHT 27	CABLE BLOCK
SHT 26	LINE VT DIAGRAM
SHT 25	CT JB CABLING
SHT 24	CABLING DIAGRAM
SHT 23	CABLING DIAGRAM
SHT 22	CABLING DIAGRAM
SHT 21	REFERENCE DIAG
SHT 20	REFERENCE DIAG
SHT 19	REFERENCE DIAG
SHT 18	DISTUR RECORDER
SHT 17	SUP ALARMS KEY
SHT 16	SUP STATUS, CONT
SHT 15	REA & MEAS KEY
SHT 14	SPR REW, AC KEY
SHT 13	INDICAT, DC KEY
SHT 12	CLOSE DC KEY
SHT 11	BACK-UP DC KEY
SHT 10	BACK-UP DC KEY
SHT 09	BACK-UP DC KEY
SHT 08	TELEPROT DC KEY
SHT 07	MAIN DC KEY
SHT 06	MAIN DC KEY
SHT 05	VT SUPPLY KEY
SHT 04	AC KEY DIAGRAM
SHT 03	SINGLE LINE
SHT 02	LOGIC DIAGRAM
SHT 01	PANEL LAYOUT
DRG No.	REFERENCE DRAWINGS:

				153272156-00003			
REV	REVISION DESCRIPTION	BY	CHKD	AUTH	DATE	PROJECT NUMBER	
PROJECT APPROVED		DESIGN APPROVED					
C. PYM		A. CRAIB					
DATE 25/06/21		DATE 13/13/10					
PROJECT CHECKED		DESIGN CHECKED					
B. HOMANN		N. MATHONSI					
DATE 25/06/21		DATE 13/12/10					
DRAWN BY		DRAWN BY					
K. STEYNBERG		C. CANNON					
DATE 25/06/21		DATE 26/02/10					
REV		AUTH		DATE		REVISION TO MASTER	
-	-	-	-	-	-	-	-
BY		CHKD		SCALE			

Eskom
ISCOR SUBSTATION
66kV FEEDER 1
CABLE BLOCK DIAGRAM

D-WC-7104 61 27 0

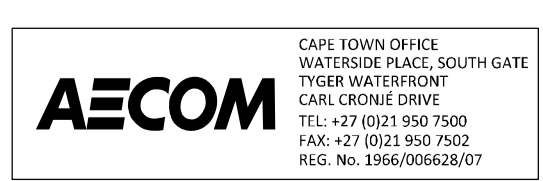

LEVELS	1	5	10	14	20	21	22	28
--------	---	---	----	----	----	----	----	----

		X2			
		K301D	1	K301D	X4.8
		K381	2	K381	X4.9
		K383	3	K383	X4.10
	X1.22	K301E	4	K301E	X4.11
	X1.23	K385	5	K385	X4.12
	X1.21	K387	6	K387	X4.13
			7		
			8		
			9		
	X1.48	K101A	10	K101A	X5.24
	X1.49	X103	11	X103	X5.25
	X1.25	X105	12	X105	X5.26
		X101B	13	X101B	X5.27
		X107	14	X107	X5.28
		X109	15	X109	X5.29
		X101C	16	X101C	X5.30
		X111	17	X111	X5.31
		X113	18	X113	X5.32
			19		
			20		
			21		
			22		
			23		
			24		
			25		
			26		
			27		
			28		
			29		
			30		
			31		
			32		
			33		
	AA110	CABLE NUMBER		AA115	
	12	CABLE SIZE		19	
	6	NUMBER OF SPARES		4	
	66kV LINE ISMB	DESTINATION		66kV FEEDER 1 RP	

		X1			
		B110AA	1	B110AA	43
		B111AA	2	B111AA	
		B130AA	3	B130AA	44
		B131AA	4	B131AA	
		B150AA	5	B150AA	45
		B151AA	6	B151AA	
		B171AA	7	B171AA	
		B210AA	8	B210AA	
		B211AA	9	B211AA	
			10	B230AA	
		B231AA	11	B231AA	
			12	B250AA	
		B251AA	13	B251AA	
			14	B271AA	
		P3AA	15	P3AA	
		P117AA	16	P117AA	
		P5AA	17	P5AA	
		P217AA	18	P217AA	
			19		
			20		
			21		
			22		
			23		
			24		
			25		
			26		
			27		
			28		
			29		
			30		
	AA126	CABLE NUMBER		AA126	
	4	CABLE SIZE		4	
	-	NUMBER OF SPARES		-	
	66kV FEEDER 1 CTJB	DESTINATION		66kV FEEDER 1 CTJB	

LOOPED TERMINALS	
BP ISMB	
BB1 ISMB	X1.20-X1.22; X1.24-X1.48; X1.32-X1.34; X1.33-X1.35; X1.37-X1.39; X1.41-X1.43; X1.44-X1.46; X1.45-X1.47
BB2 ISMB	X1.20-X1.22; X1.24-X1.48; X1.32-X1.34; X1.33-X1.35; X1.37-X1.39; X1.41-X1.43; X1.44-X1.46; X1.45-X1.47
LINE ISMB	X1.20-X1.22; X1.24-X1.48
ISJB	X1.1-X1.8; X1.3-X1.10; X1.5-X1.12; X1.7-X1.14



1	66kV VT & CB ADDED, FEEDER RENAMED.	KS	BH	CP	25/06/2021	153272156-00003
REV	REVISION DESCRIPTION	BY	CHKD	AUTH	DATE	PROJECT NUMBER

Eskom

ISCOR SUBSTATION
66kV FEEDER 1

ISJB CABLING DIAGRAM

D-WC-7104



SET NUMBER	SHEET NUMBER	REVISION
61	28	1

PANEL TYPE DESIGNATION 4FZD-3920

SHT 28	ISOLATOR JB
SHT 27	CABLE BLOCK
SHT 26	LINE VT DIAGRAM
SHT 25	CT JB CABLING
SHT 24	CABLING DIAGRAM
SHT 23	CABLING DIAGRAM
SHT 22	CABLING DIAGRAM
SHT 21	REFERENCE DIAG
SHT 20	REFERENCE DIAG
SHT 19	REFERENCE DIAG
SHT 18	DISTUR RECORDER
SHT 17	SUP ALARMS KEY
SHT 16	SUP STATUS, CONT
SHT 15	REA & MEAS KEY
SHT 14	SPR REV, AC KEY
SHT 13	INDICAT, DC KEY
SHT 12	CLOSE DC KEY
SHT 11	BACK-UP DC KEY
SHT 10	BACK-UP DC KEY
SHT 09	BACK-UP DC KEY
SHT 08	TELEPROT DC KEY
SHT 07	MAIN DC KEY
SHT 06	MAIN DC KEY
SHT 05	VT SUPPLY KEY
SHT 04	AC KEY DIAGRAM
SHT 03	SINGLE LINE
SHT 02	LOGIC DIAGRAM
SHT 01	PANEL LAYOUT
DRG No.	REFERENCE DRAWINGS:

FRONT OF MODULE


TERMINAL PLATE OF MODULE (TOP)

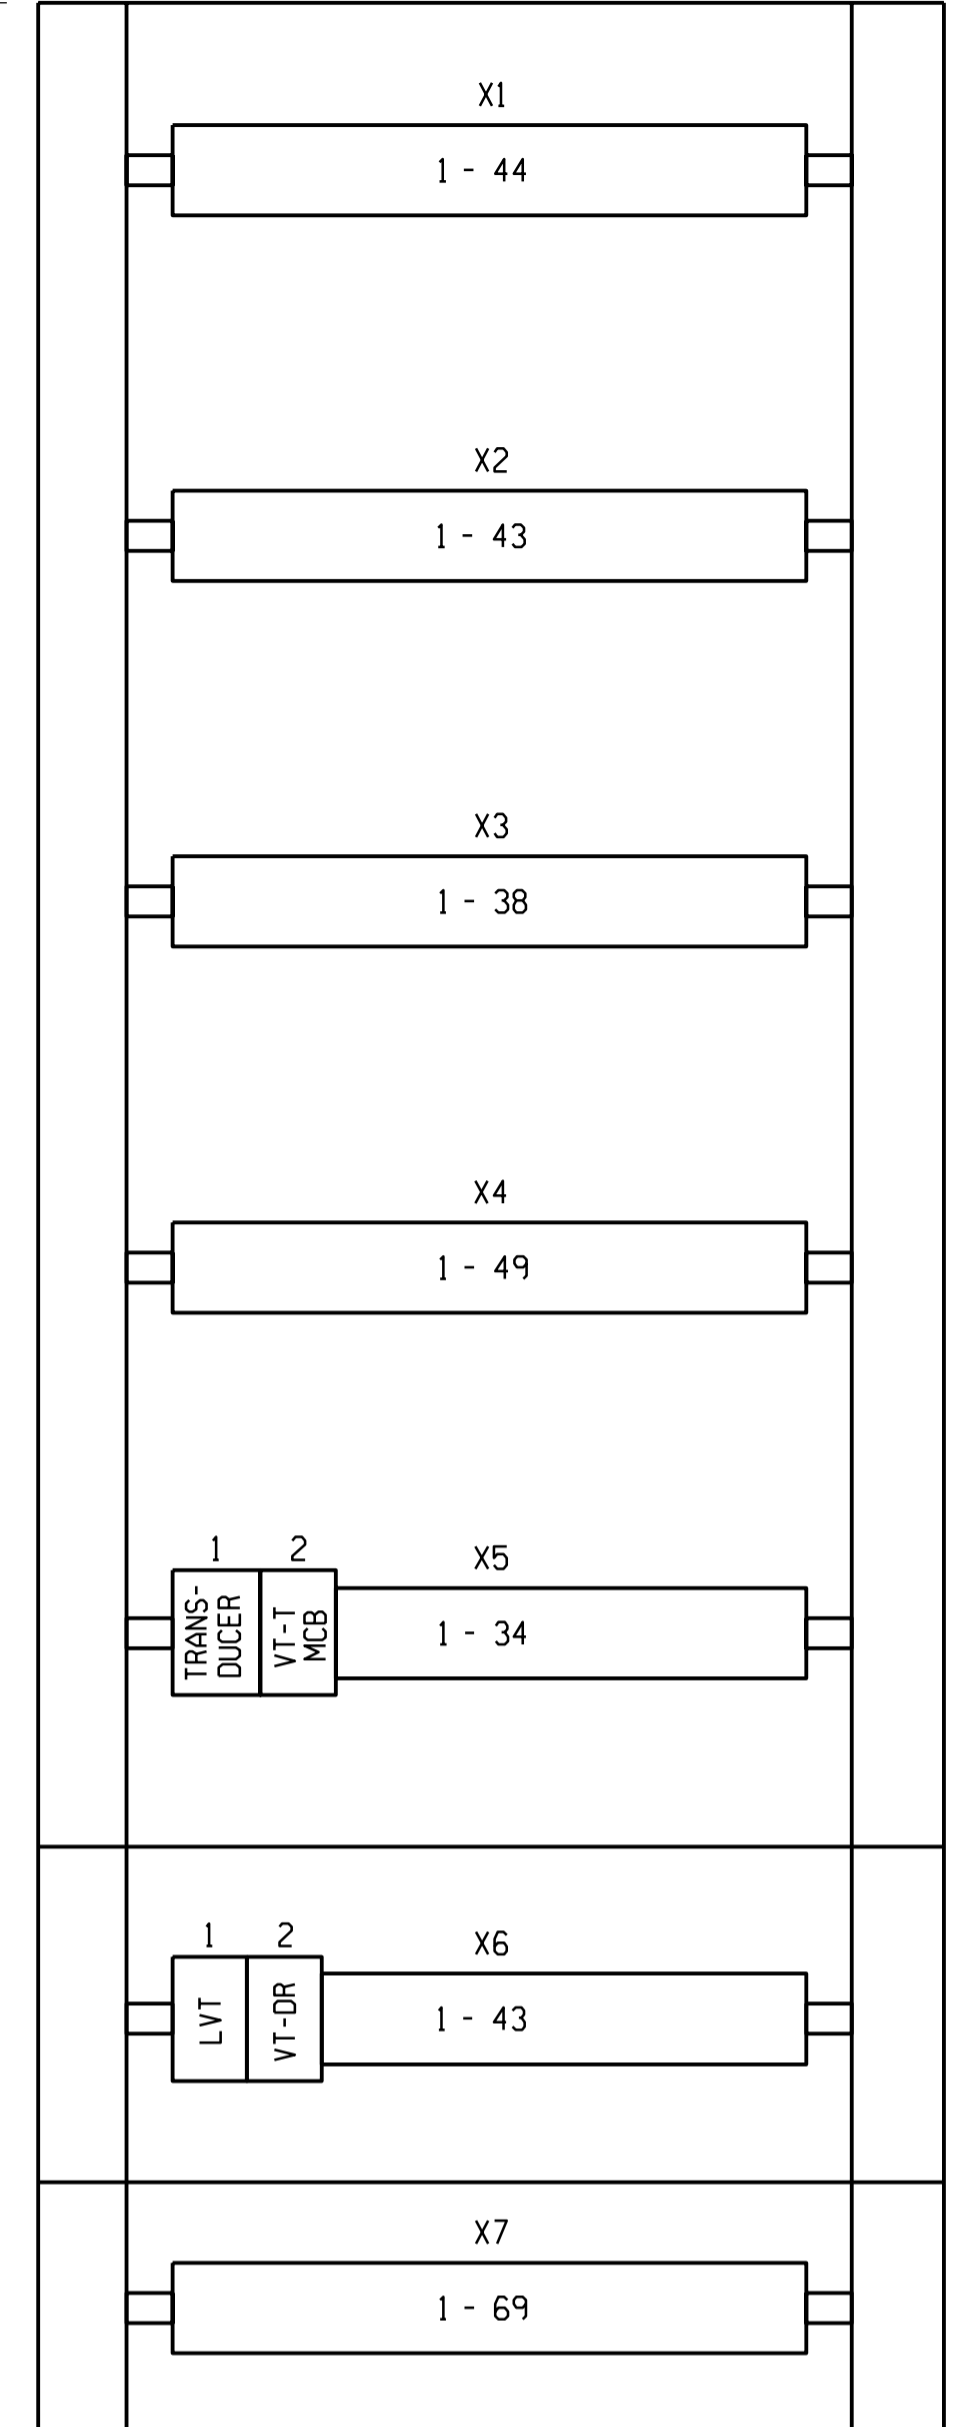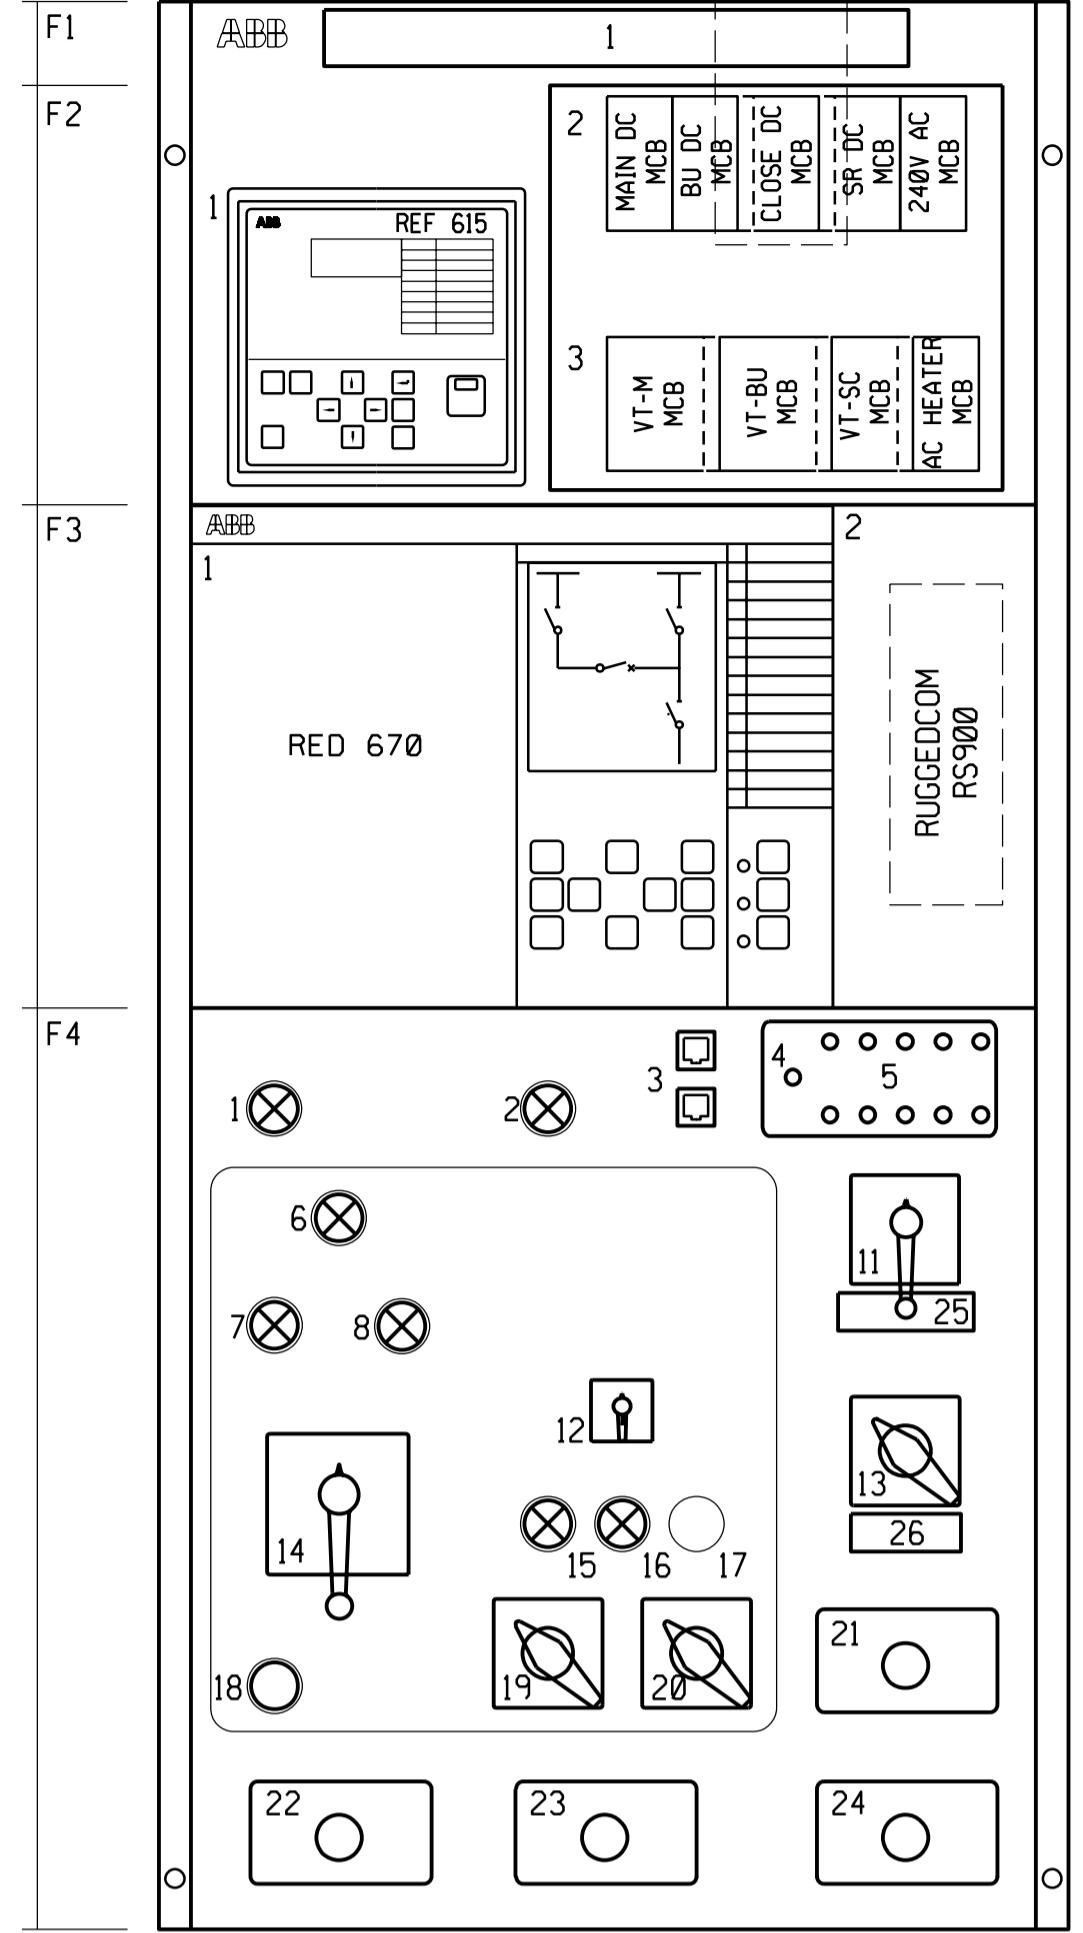


DISTURBANCE RECORDER TERMINALS (OPTIONAL)

SUPERVISORY HARDWIRED TERMINALS (OPTIONAL)

REAR OF MODULE

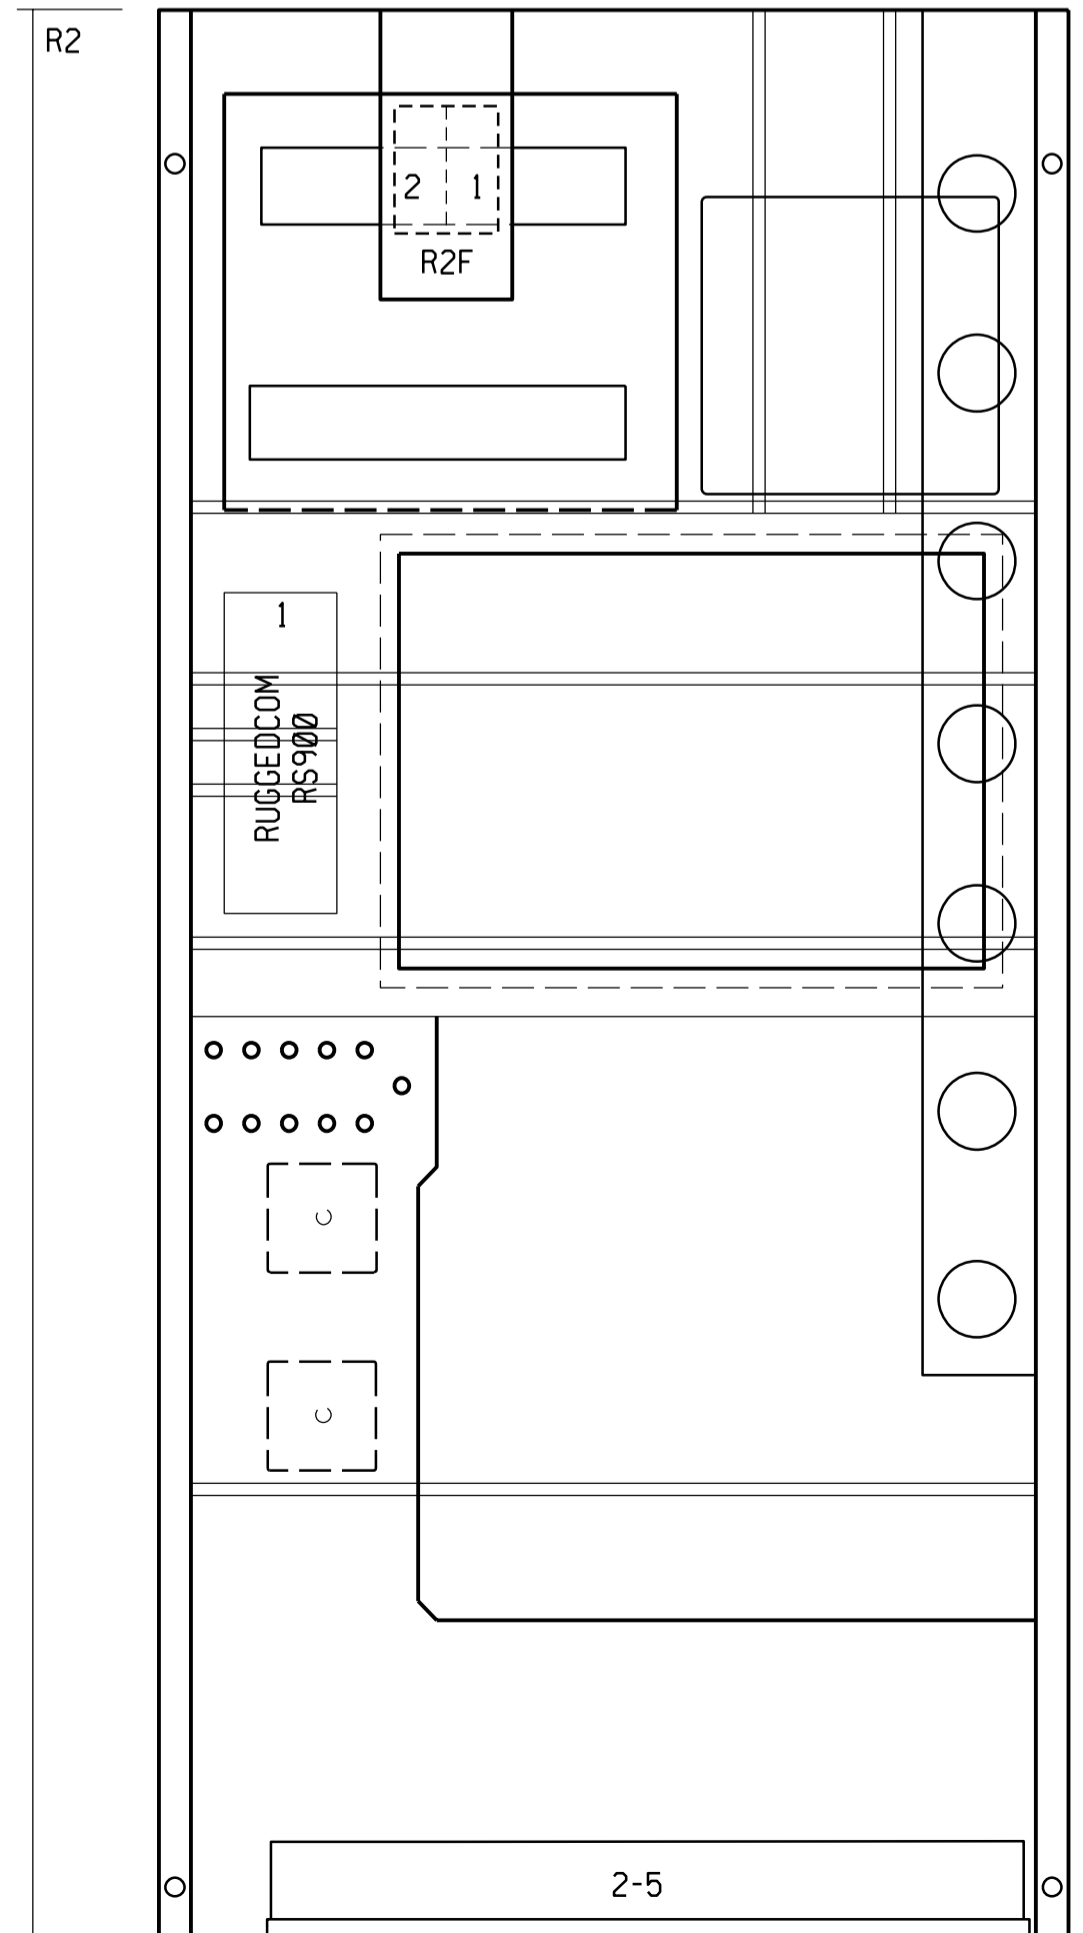


INTERNAL TO MODULE

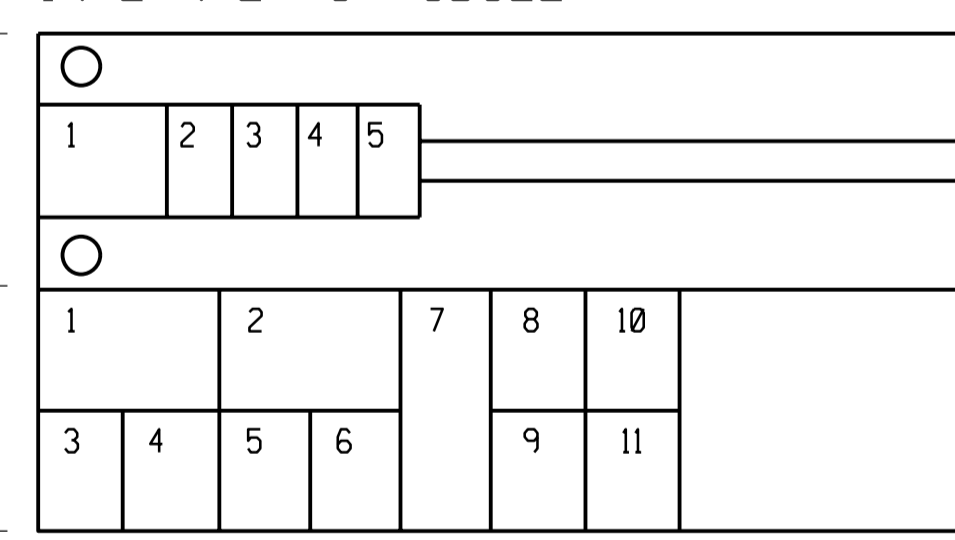


LAYOUT FOR 110V AND 220V DC SCHEME (FRONT VIEW)

INTERNAL TO MODULE

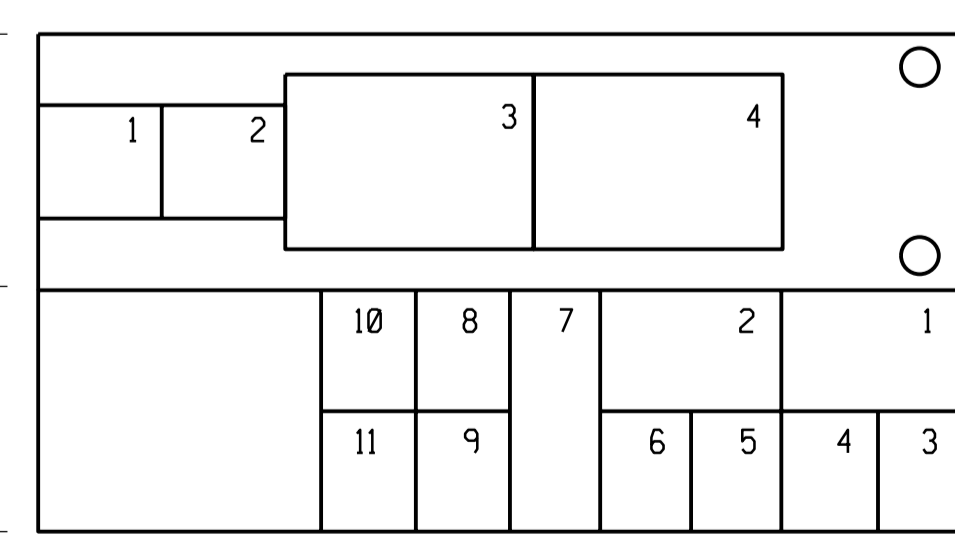


LAYOUT FOR 110V AND 220V DC SCHEME (REAR VIEW)

INTERNAL TO MODULE

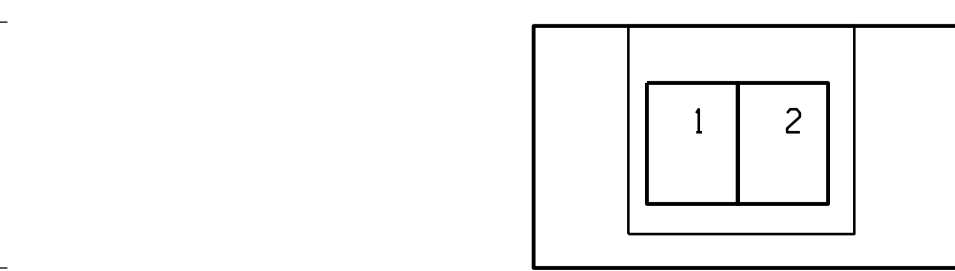

LAYOUT FOR 110V AND 220V DC SCHEME (FRONT ACCESS VIA MCB (F2) DOOR)

LOCATION	DESIGNATION	DESCRIPTION	TYPE	MANUFACTURER
FRONT OF MODULE				
F1	1	LABEL		
F2	1	BACK-UP IED	DIRECTIONAL BACK-UP PROTECTION	REF615
	2	1 MCB(M)	MAIN DC SUPPLY MCB (110V, 220V SCHEME) (16 AMP)	S282-UC B16
	3	1 MCB(BU)	BACK-UP DC SUPPLY MCB (110V, 220V SCHEME) (16 AMP)	S282-UC B16
	4	1 MCB(CL)	CLOSE DC SUPPLY MCB AUXILIARY CONTACT	S2-H11 I
	5	1 MCB(SR)	CLOSE DC SUPPLY MCB (110V, 220V SCHEME) (10 AMP)	S282-UC B10
	6	1 MCB(SR)	SPRING REWIND DC SUPPLY MCB AUXILIARY CONTACT	S2-H11 I
	7	1 MCB(SR)	SPRING REWIND DC SUPPLY MCB (110V, 220V SCHEME) (20 AMP)	S282-UC B20
	8	1 MCB(SR)	SPRING REWIND DC SUPPLY MCB (110V, 220V SCHEME) (10 AMP)	S282-UC B10
	9	1 MCB(SR)	MAIN AC SUPPLY MCB (3 POLE)	S203-C 2
	10	1 MCB(SR)	VT SUPPLY MAIN PROTECTION MCB AUXILIARY CONTACT	S2C-H6R
	11	1 MCB(SR)	VT SUPPLY MAIN PROTECTION MCB (3 POLE)	S203-C 2
	12	1 MCB(SR)	VT SUPPLY BACK-UP PROTECTION MCB AUXILIARY CONTACT	S2C-H6R
	13	1 MCB(SR)	VT SUPPLY BACK-UP PROTECTION MCB (3 POLE)	S203-C 2
	14	1 MCB(SR)	VT SUPPLY BACK-UP PROTECTION MCB AUXILIARY CONTACT	S2C-H6R
	15	1 MCB(SR)	VT SUPPLY SYNCH CHECK MCB	S202-C 2
	16	1 MCB(SR)	VT SUPPLY SYNCH CHECK MCB AUXILIARY CONTACT	S2C-H6R
	17	1 MCB(SR)	HEATER SUPPLY MCB (6 AMP)	S282-UC B6
F3	1	MAIN IED	INTERGRATED DISTANCE/DIFFERENTIAL FEEDER PROTECTION RELAY	RED670
F4	1	PNH	PROTECTION NOT HEALTHY INDICATION (AMBER)	CL523Y
	2	ARC-OFF/LOCKED-OUT	AUTO RECLOSE OFF & CLOSE LOCK-OUT INDICATION (AMBER) (CL520 = 240V DC)	CL515Y
	3	IEC61850 RELAY COM PORTS	IEC61850 RELAY TEST ETHERNET COMMUNICATION PORTS	
	4	ESD	ELECTROSTATIC DISCHARGE POINT	SOCKET (BLUE)
	5	1 TP-1	TEST POINT 1 - MAIN PROTECTION TRIP (RED PHASE)	SOCKET (RED)
	6	1 TP-2	TEST POINT 2 - MAIN PROTECTION TRIP (WHITE PHASE)	SOCKET (RED)
	7	1 TP-3	TEST POINT 3 - MAIN PROTECTION TRIP (BLUE PHASE)	SOCKET (RED)
	8	1 TP-4	TEST POINT 4 - BREAKER FAIL BUS STRIP	SOCKET (RED)
	9	1 TP-5	TEST POINT 5 - MAIN DC NEGATIVE SUPPLY	SOCKET (BLACK)
	10	1 TP-6	TEST POINT 6 - BREAKER FAIL RETRIP CROSS TRIP	SOCKET (RED)
	11	1 TP-7	TEST POINT 7 - SUPERVISORY TRIP	SOCKET (RED)
	12	1 TP-8	TEST POINT 8 - BACK-UP PROTECTION TRIP	SOCKET (RED)
	13	1 TP-9	TEST POINT 9 - ARC OR EXTERNAL CLOSE	SOCKET (RED)
	14	1 TP-10	TEST POINT 10 - BACK-UP DC NEGATIVE SUPPLY	SOCKET (BLACK)
	15	1 CBNH	CIRCUIT BREAKER NOT HEALTHY INDICATION (AMBER)	CL515Y
	16	1 CBO	CIRCUIT BREAKER OPEN INDICATION (GREEN)	CL515C
	17	1 CBC	CIRCUIT BREAKER CLOSE INDICATION (RED)	CL515R
	18	1 TNS	TEST NORMAL SWITCH	CR0867
	19	1 LCS	LAMP CHECK SWITCH	CA4 A321-621
	20	1 TPIS	TELEPROTECTION ISOLATOR SWITCH	CR-0866
	21	1 CBCS	CIRCUIT BREAKER CONTROL SWITCH	CR-0604
	22	1 ARC OFF	AUTO RECLOSE SELECTION STATE PUSH BUTTON (AMBER) (110V DC)	MP3-11Y, MBH-101
	23	1 ARC 3 POLE	AUTO RECLOSE SELECTION STATE PUSH BUTTON (AMBER) (110V DC)	MP3-11Y, MBH-101
	24	1 TTPB	TRIP TEST PUSH BUTTON/ PROTECTIVE COVER	CP10-10R-10/ YSF
	25	1 BFIS	BREAKER FAIL ISOLATOR SWITCH	CR-0866A
	26	1 SIS	SUPERVISORY ISOLATOR SWITCH	CR-0316
	27	1 CTTB-BU	CT TEST BLOCK (BACK-UP)	PK2 (4 WAY)
	28	1 CTTB-M	CT TEST BLOCK (MAIN)	PK2 (4 WAY)
	29	1 VTTB-M	VT TEST BLOCK (MAIN)	PK2 (4 WAY)
	30	1 VTTB-BU	VT TEST BLOCK (BACK-UP)	PK2 (4 WAY)
	31	1 M.O.T.	LABEL INDICATING EMERGENCY CLOSE CONTROL WITHOUT SYNCH CHECK WHEN LINK A IS CLOSED, AND TNS SELECTED TO MAIN ON TEST	
	32	1 REMOTE DIFF ISOLATION	LABEL INDICATING TPIS BLOCKS REMOTE DIFF UNIT (OPTIONAL)	
INTERNAL TO MODULE				
RI	1	VSR-1	ISOLATOR 1 REPEAT RELAY (• AN=110V DC, AS=220V DC) (NOT INSTALLED)	RXMBV 2 RK 251205-•
	2	VSR-2	ISOLATOR 2 REPEAT RELAY (• AN=110V DC, AS=220V DC) (NOT INSTALLED)	RXMBV 2 RK 251205-•
	3		(BLANK)	
	4		(BLANK)	
	5	RCPM,C/T	SNUBBER CIRCUIT	RCPM1 PR56512029-AA
	6	CT-X	BACK-UP TO MAIN CROSS TRIP AUXILIARY RELAY	RXMA 1 RK 211072-AN
	7	PSU	48 VOLT DC POWER SUPPLY UNIT (NOT INSTALLED)	RXTUG
	8	TCS-M	TRIP CIRCUIT SUPERVISION MAIN (MAIN)	BTCS110
	9		(BLANK)	
	10		(BLANK)	
	11	TCS-BU	TRIP CIRCUIT SUPERVISION BACK-UP (BACK-UP)	BTCS110
R3F	1	D1	LAMP CHECK DIODES	PR56592018
	2	D2	CROSS TRIP DIODES	PR56512033,BA
	3	D3	CROSS TRIP DIODES	PR56512033,BA
	4	D4	BLOCKING DIODE (MEASURING POINTS)	PR56592018/4,PNH
	5	D5	BLOCKING DIODE (TRIP CIRCUIT SUPERVISION 3 POLE)	PR56512033,BA
R3R	1	DCF-M	DC FAIL RELAY (MAIN) (• 110=110V DC, 220=220V DC)	CR-U110DC3L
	2	DCF-BU	DC FAIL RELAY (BACKUP) (• 110=110V DC, 220=220V DC)	CR-U110DC3L
	3	MCTS	MAIN CT SHORTING RELAY (• 110=110V DC, 220=220V DC) (NOT INSTALLED)	BJ8-110V DC
	4	BCTS	BACK-UP CT SHORTING RELAY (• 110=110V DC, 220=220V DC) (NOT INSTALLED)	BJ8-110V DC
R2F	1	CBC-CR	CIRCUIT BREAKER CLOSE AUXILIARY RELAY (• AN = 110V DC, AS = 220V DC)	RXMB1 1MRK 000 803-•
	2		(BLANK)	
REAR OF MODULE				
R2	1	ROUTER	IEC61850 ROUTER (OPTIONAL)	RS900-HI-D-MTMTMT
	2	CBOS-X1	CIRCUIT BREAKER OPEN SUPERVISORY AUXILIARY 1 RELAY (48V DC) (OPTIONAL)	CR-U048DC3
	3	CBOS-X2	CIRCUIT BREAKER CLOSE SUPERVISORY AUXILIARY 1 RELAY (48V DC) (OPTIONAL)	CR-U048DC3
	4	PNH-X1	PROTECTION NOT HEALTHY AUXILIARY 1 RELAY (• 110=110V DC, 220=220V DC)	CR-U110DC3L
	5	PNH-X2	PROTECTION NOT HEALTHY AUXILIARY 2 RELAY (• 110=110V DC, 220=220V DC)	CR-U110DC3L
R4	X5.1	TRANSDUCER	MEASUREMENTS TRANSDUCER & INTERFACE (NOT INSTALLED)	SINEAX CAM/STAT15MT
	X5.2	MCB (VT-T)	TRANSDUCER VT SUPPLY MCB (3 POLE) (2 AMP)	S203-C 2
	X6.1	MCB (LVT)	DISTURBANCE RECORDER LVT SUPPLY MCB (NOT INSTALLED) (1 AMP)	S202-C 1
	X6.2	MCB (VT-DR)	DISTURBANCE RECORDER VT SUPPLY MCB (3 POLE) (NOT INSTALLED) (1 AMP)	S203-C 1

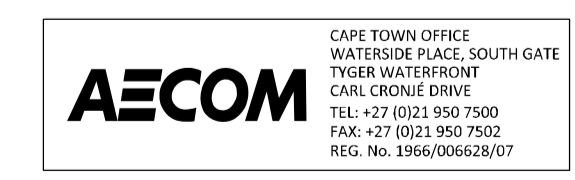

1	66kV VT & CB ADDED, FEEDER RENAMED.	KS	BH	CP	25/06/2021	153272156-00003
REV	REVISION DESCRIPTION	BY	CHKD	AUTH	DATE	PROJECT NUMBER

Eskom

ISCOR SUBSTATION
66kV FEEDER 2
PANEL EQUIPMENT LAYOUT

D-WC-7104

SET NUMBER: 62
SHEET NUMBER: 01
REVISION: 1

PANEL TYPE DESIGNATION: 4FZD-3920

REV	AUTH	DATE	REVISION TO MASTER	BY	CHKD	SCALE
-	-	-	-	-	-	-

MASTER TRACING FILED UNDER D-DT-15007 SHEET 01 OF 28 REVISION 2

RED670 AND REF615 RELAYS USE PCMG00 AS THEIR SOFTWARE TOOL. THE REQUIRED CONNECTIVITY PACKAGES FOR THESE RELAYS IS THE RELION SERIES SOFTWARE.

RED670: MAIN DISTANCE/DIFFERENTIAL RELAY

NOTE THAT THE INTERNAL TELEPROTECTION/DIFFERENTIAL COMMUNICATION LINK OF THIS RELAY IS ONLY COMPATIBLE WITH A MIRRORED RELAY ON THE DISTRIBUTION CONTRACT OR SCHEMES 6FZD3500 AND 6FZD3600 ON THE TRANSMISSION CONTRACT.

EXPLANATION OF THE CONTROLLED SWITCHES USED IN THE RED670 MAIN RELAY

GT SWITCHES, WHICH ARE SETTABLE IN THE PCMG00 ENGINEERING PARAMETER SETTING (PS) SOFTWARE, AND MAY BE FOUND WITHIN THE PARAMETER SETTINGS UNDER THE APPLICATION CONFIGURATION SECTIONS THEY ARE CONFIGURED WITHIN, ARE MASKED AS FOLLOWS:

GT-01) INTERNAL COMMUNICATION CARD LINK FAIL FUNCTION SELECTION

SET GT01 TO 'ON' (THE DEFAULT) IF THE SCHEME HAS A COMMUNICATION CARD IN SLOT X34 OR X35 AND IT IS USED.
SET GT01 TO 'OFF' IF THE CARD IS NOT USED OR IF THE SCHEME DOES NOT HAVE A COMMUNICATION CARD IN SLOT X34 OR X35.

TO TAKE ADVANTAGE OF THE TEF CARRIER GUARD FAIL MASKING: SET UNBLOCK = RESTART IN THE PST SOFTWARE AND SET SECURITY = 35ms.

GT-02) TEST OUTPUTS

SET GT02 TO 'ON' TO ENABLE PHASE AND EARTH FAULT IMPEDANCE STARTER TEST OUTPUTS.
SET GT02 TO 'OFF' (THE DEFAULT) TO ENABLE CARRIER RECEIVE AND CARRIER SEND TEST OUTPUTS.

GT-03) INSTANTANEOUS TRIP PARALLEL/SERIES LOGIC FUNCTION SELECTION

SET GT03 TO 'OFF' (THE DEFAULT) FOR PARALLEL OPTION WHICH ALLOWS EITHER FUNCTION, DIFFERENTIAL OR DISTANCE (Z1 OR Z2 AIDED), TO INITIATE THE TRIP (INCREASED DEPENDABILITY).
WITH GT03 SET 'ON', THE SERIES OPTION IS CHOSEN WHICH REQUIRES BOTH FUNCTIONS TO OPERATE TO INITIATE AN INSTANTANEOUS TRIP (INCREASED SECURITY).

GT-04) CARRIER GUARD ZONE ACCELERATION BLOCK

SET GT04 TO 'OFF' (THE DEFAULT) IN 'Application Configuration/Monitoring/Logic/LogicGate' WHEN THE CARRIER GUARD IS NOT USED.
SET GT04 TO 'ON' WHEN USING THE CARRIER GUARD AND USING THE ZONE ACCELERATION FUNCTIONALITY. NOTE THAT ZONE ACCELERATION CAN BE SET ON OR OFF (THE DEFAULT) WITHIN THE SETTINGS AND SHOULD ONLY BE USED FOR SINGLE RADIAL LINES.

GT-05) CARRIER GUARD SELECTION

SET GT05 TO 'ON' FOR CARRIER GUARD USAGE. SET TO 'OFF' (THE DEFAULT) IF THERE IS NO 50V DC SUPPLY TO THE EXTERNAL TELEPROTECTION (PLC) SCHEME CIRCUIT.

GT-06) PARALLEL FEEDER DISTANCE-TO-FAULT COMPENSATION SELECTION

SET GT06 TO 'OFF' (THE DEFAULT) FOR NO PARALLEL FEEDER DISTANCE TO FAULT COMPENSATION (FAULT LOCATOR ACCURACY).
SET GT06 TO 'ON' FOR DTF FAULT LOCATOR COMPENSATION FOR PARALLEL FEEDERS (DOUBLE CIRCUIT FEEDERS).

GT-07) UNDERVOLTAGE OVERLOAD TRIP OR OVERVOLTAGE TRIP FUNCTION SELECTION

THE U/V OVERLOAD TRIP FUNCTION (THE DEFAULT) MAY BE REPLACED WITH THE 'OVLD' TRIP FUNCTION (SET GT07 TO 'ON' FOR OVLD TRIP) IF THE SOLE CRITERIA IS CURRENT.

A SETTABLE TIMER FUNCTION, TS14, IS USED FOR THE TIMING OF THE OVERLOAD (OVLD) TRIP FUNCTION. TS14 WILL DELAY THE OVERLOAD TRIP OUTPUT AND IS SETTABLE IN THE PST SOFTWARE. TS14 IS IN SERIES WITH THE OVLD FUNCTION TIMER T OUTPUT (I.E. THE TIMERS ARE ADAPTIVE). IF TS14 IS SET TO 'OFF', THE OVLD TRIP AND THE U/V OVLD ARE BLOCKED BUT THE OVLD ALARM WOULD REMAIN FUNCTIONAL (I.E. THE OVLD ALARM OUTPUT IS TAKEN OFF BEFORE TS14 AND THE OVLD ALARM WOULD OPERATE AFTER OVLD FUNCTION TIME TIMEOUT).

NOTE THAT THE U/V FUNCTION TIMER RUNS CONCURRENTLY WITH THE OVLD TRIP OUTPUT FOR THE U/V TRIP OUTPUT.

GT-08) BROKEN CONDUCTOR TRIP OR ALARM FUNCTION SELECTION

THE BROKEN CONDUCTOR ALARM FUNCTION (THE DEFAULT) MAY BE REPLACED WITH THE BROKEN CONDUCTOR TRIP FUNCTION (SET GT08 TO 'ON' FOR BC TRIP) IF THE CONNECTED POWER PARAMETERS ALLOW IT.

GT-09) FUSE FAIL BREAKER STATUS DUDI FUNCTION SELECTION

SET GT09 TO 'OFF' (THE DEFAULT) FOR EXCLUSION OF THE BREAKER STATUS WITHIN THE DUDI FUNCTION DECISION LOGIC (THEN RELIES SOLELY ON THE CONDITION 'phase Imag > Iph setting' TO BE FULFILLED FOR INITIATION OF DUDI). SET GT09 'ON' FOR INCLUSION OF THE BREAKER STATUS LOGIC (THEN RELIES ON EITHER OF THE CONDITIONS 'phase Imag > Iph setting' OR 'CIRCUIT BREAKER CLOSED' TO BE FULFILLED FOR INITIATION OF THE DUDI FUNCTION).

GT-11) POLE DISAGREEMENT FUNCTION SELECTION

THE POLE DISAGREEMENT FUNCTION (PD) INCLUDES BOTH BREAKER AUXILIARY CONTACT ANALYSIS (TRADITIONAL METHOD) AND A CURRENT BASED FUNCTIONALITY. THEY ARE INDEPENDANT OF EACH OTHER.

THE CURRENT BASED OPTION CAN BE SET FOR CONTINUOUS MONITORING OR FOR A PERIOD OF 200ms AFTER THE BREAKER CHANGES STATE ('CurrSel'='CB OPEN MONITOR' IS THE SETTING FOR THE 200ms OPTION - INITIATED VIA CLOSE OR 3 POLE TRIP COMMANDS).

IF THE CURRENT BASED OPTION IS USED, THEN IT IS RECOMMENDED TO CHOOSE THE 200ms OPTION, AS OPPOSED TO THE CONTINUOUS OPTION, AS IT IS MORE SECURE.

IF THE CURRENT BASED OPTION IS NOT REQUIRED (RECOMMENDED), SET THE 'Curr Sel' TO 'OFF' (THE DEFAULT).

FUNCTIONALITY HAS BEEN ADDED TO THE TRADITIONAL METHOD OF PD AND THUS THERE IS AN OPTION TO HAVE IT SUPERVISED BY USING THE BROKEN CONDUCTOR 'START' FUNCTIONALITY AND BROKEN CONDUCTOR FUNCTION CURRENT SETTINGS. THIS IS STILL INDEPENDANT OF THE SOLELY CURRENT BASED OPTION IN THE PREVIOUS PARAGRAPH.

SET GT11 TO 'ON' (THE DEFAULT) FOR TRADITIONAL POLE DISAGREEMENT FUNCTIONALITY (I.E. BREAKER AUXILIARY CONTACT ANALYSIS).

SET GT11 TO 'OFF' TO ENABLE A COMBINATION THAT USES BREAKER AUXILIARY CONTACTS AND THE BROKEN CONDUCTOR START FUNCTIONALITY.

THIS EXTRA FUNCTIONALITY HAS BEEN ADDED TO ENHANCE SECURITY OF THE SCHEME (I.E. PD WITH BCondStart WOULD NOT OPERATE FOR A FAULTY BREAKER AUXILIARY CONTACT ONLY) BUT WITH DECREASED DEPENDABILITY (I.E. THE LINE MUST BE ENERGISED, CONNECTED AND POSSIBLY LOADED BEFORE A PD COULD OPERATE).

GT-12) ZONE 2 AUTORECLOSE INITIATE FUNCTION SELECTION

FOR SELECTION OF IMPEDANCE ZONE 2 AUTORECLOSE INITIATION (Z2 ARC INITIATE), SET GT12 TO 'ON'. SET GT12 TO 'OFF' (THE DEFAULT) FOR NO ZONE 2 ARC INITIATE.

GT-13) FAULT AND TRIP COUNTER RESET

GT13 DEFAULT = 'OFF'. SET GATE 'ON' THEN 'OFF' WHEN REPLACING THE HV BREAKER.

GT-14) TEF (EARTH-FAULT RED670) AUTORECLOSE INITIATE FUNCTION SELECTION

FOR SELECTION OF TEF AUTORECLOSE INITIATION, SET GT14 TO 'ON' (THE DEFAULT) IN 'Application Configuration/Closing ARCCend Sync/Logic/LogicGate'.
SET GT14 TO 'OFF' FOR NO TEF ARC INITIATE.

GT-15) O/C (RED670) AUTORECLOSE INITIATE FUNCTION SELECTION

FOR SELECTION OF O/C AUTORECLOSE INITIATION, SET GT15 TO 'ON' IN 'Application Configuration/Closing ARCCend Sync/Logic/LogicGate'.
SET GT15 TO 'OFF' FOR NO O/C ARC INITIATE (THE DEFAULT).

GT-16) SYNCH CHECK FUNCTION

SET GT16 TO 'OFF' (THE DEFAULT) FOR USAGE OF THE SYNCH CHECK AUTO FUNCTION. SET GT16 TO 'ON' IF THERE IS NO SYNCH CHECK LINE VT.

GT-18) TRIP CIRCUIT SUPERVISION CLOSE BLOCKING

SET GT18 TO 'ON' IN 'PARAMETER SETTING/MONITORING' FOR ANY TCS FAIL (FROM MAIN OR BACK-UP TRIP COIL CIRCUITS) TO BLOCK A CLOSE.
TCS FAIL WILL NOT BLOCK A CLOSE IF GT18 IS SET 'OFF' UNLESS BOTH MAIN AND BACK-UP TRIP CIRCUITS HAVE FAILED. THE DEFAULT SETTING IS GT18='OFF'.
A PNH AND A CBNH ALARM WILL BE ISSUED FOR A TCS FAIL, IRRESPECTIVE OF THE GT18 STATE.

REF615: BACK-UP RELAY SETTINGS AND LOGIC

CB CLOSE CONTROL LOGIC

THE BACK-UP RELAY HAS BEEN MASKED AND THE SCHEME WIRED TO ENABLE BREAKER CONTROL WHEN THE TNS SWITCH IS SET TO 'MAIN ON TEST' (AND BACK-UP ON TEST). THE CLOSE PULSE CAN BE ISOLATED IF REQUIRED BY LINK A ON THE TERMINAL STRIP AS THE BACK-UP RELAY DOES NOT OFFER SYNCH-CHECK. THE DEFAULT LINK A POSITION IS 'OPEN'.

SUPERVISORY BREAKER CONTROL:

THE BACK-UP RELAY IS ALSO MASKED FOR SUPERVISORY DNP3 AND HARDWIRED REMOTE BREAKER CONTROL (VIA MAIN ON TEST AND SIS SELECTION).

BREAKER FAIL LOGIC (51BF)

THE FUNCTION IS ONLY ENABLED WHEN THE TNS SWITCH IS SET TO 'MAIN ON TEST' (AND BACK-UP ON TEST). THERE IS NO TELEPROTECTION LINKED TO THIS OUTPUT AND THE BREAKER FAIL OUTPUT IS ALSO ISOLATED VIA THE BFIS SWITCH. THE BF TRIP PULSE OUTPUT IS SET TO 200ms.

AUTORECLOSE (ARREC1Z9)

THE RELAY INCLUDES ARC FUNCTIONALITY. THE FUNCTION IS MASKED SUCH THAT IT IS ENABLED WHEN THE TNS SWITCH IS SET TO 'MAIN ON TEST' (AND BACK-UP ON TEST). HOWEVER, DUE TO LIMITATIONS, BACK-UP RELAY INTERNAL ARC ON/OFF IS NOT SELECTABLE VIA SUPERVISORY OR FROM THE OPERATOR PANEL. THE FUNCTION CAN BE SET ON/OFF VIA EITHER ALTERNATIVE SETTING SELECTION OR MANUALLY AND SHOULD ONLY BE USED IN LONG TERM EMERGENCIES.
NOTE THAT THE FUNCTION IS AUTOMATICALLY INHIBITED FOR A MANUAL CLOSE.

2ND HARMONIC INRUSH DETECTION FUNCTIONALITY

THE INRUSH DETECTION FUNCTION, INRPARI, IS MASKED TO BLOCK THE FOLLOWING FUNCTIONS WHEN OPERATED:
DIR_OC1 (67-1(1)), DIR_HighSetOC (67-2), NonDir_InstOC (50P/51), AND IS MASKED TO ENABLE THE DIR_OC2 (67-1(2)) FUNCTION'S MULTIPLIER.

CB CLOSED MULTIPLIER (TPGAPC1) GENERIC TIMER, DEFAULT TIME = 500ms


TP GAPC1 IS MASKED TO THE FOLLOWING FUNCTIONS TO ENABLE THE MULTIPLIER WHEN THE BREAKER CLOSES IF REQUIRED:
DIR_HighSetOC (67-2), NonDIR_InstOC (50P/51), SEF DIR EF2 (67N-1), DEF_HighSet (67N-2), NonDir_InstEF (51N-2), NegSeq_OC1/2 (46(1/2)).

THERMAL OVERLOAD (Ther_mOVLD (49F))

THE FUNCTION HAS BEEN MASKED FOR INDICATION AND NOT TRIP PURPOSES. HOWEVER, THE BLOCK BREAKER CLOSE FOR TEMPERATURE EXCEED HAS BEEN MASKED. TO CIRCUMVENT THE BLOCK CLOSE FUNCTIONALITY, SET THE RECLOSE TEMPERATURE TO MAXIMUM OR SET THE FUNCTION OFF.

BROKEN CONDUCTOR (46PD) OVERVOLTAGE 3PH O/V (59), UNDERVOLTAGE 3PH U/V (27), PosSeq-U/V (47U), NegSeq-O/V (47O)

THESE FUNCTIONS HAVE BEEN MASKED FOR ALARMING PURPOSES ONLY. HOWEVER, THE OPERATION OF THE FUNCTIONS WOULD INHIBIT THE INTERNAL ARC FUNCTION (ENABLED VIA TNS OFF NORMAL).

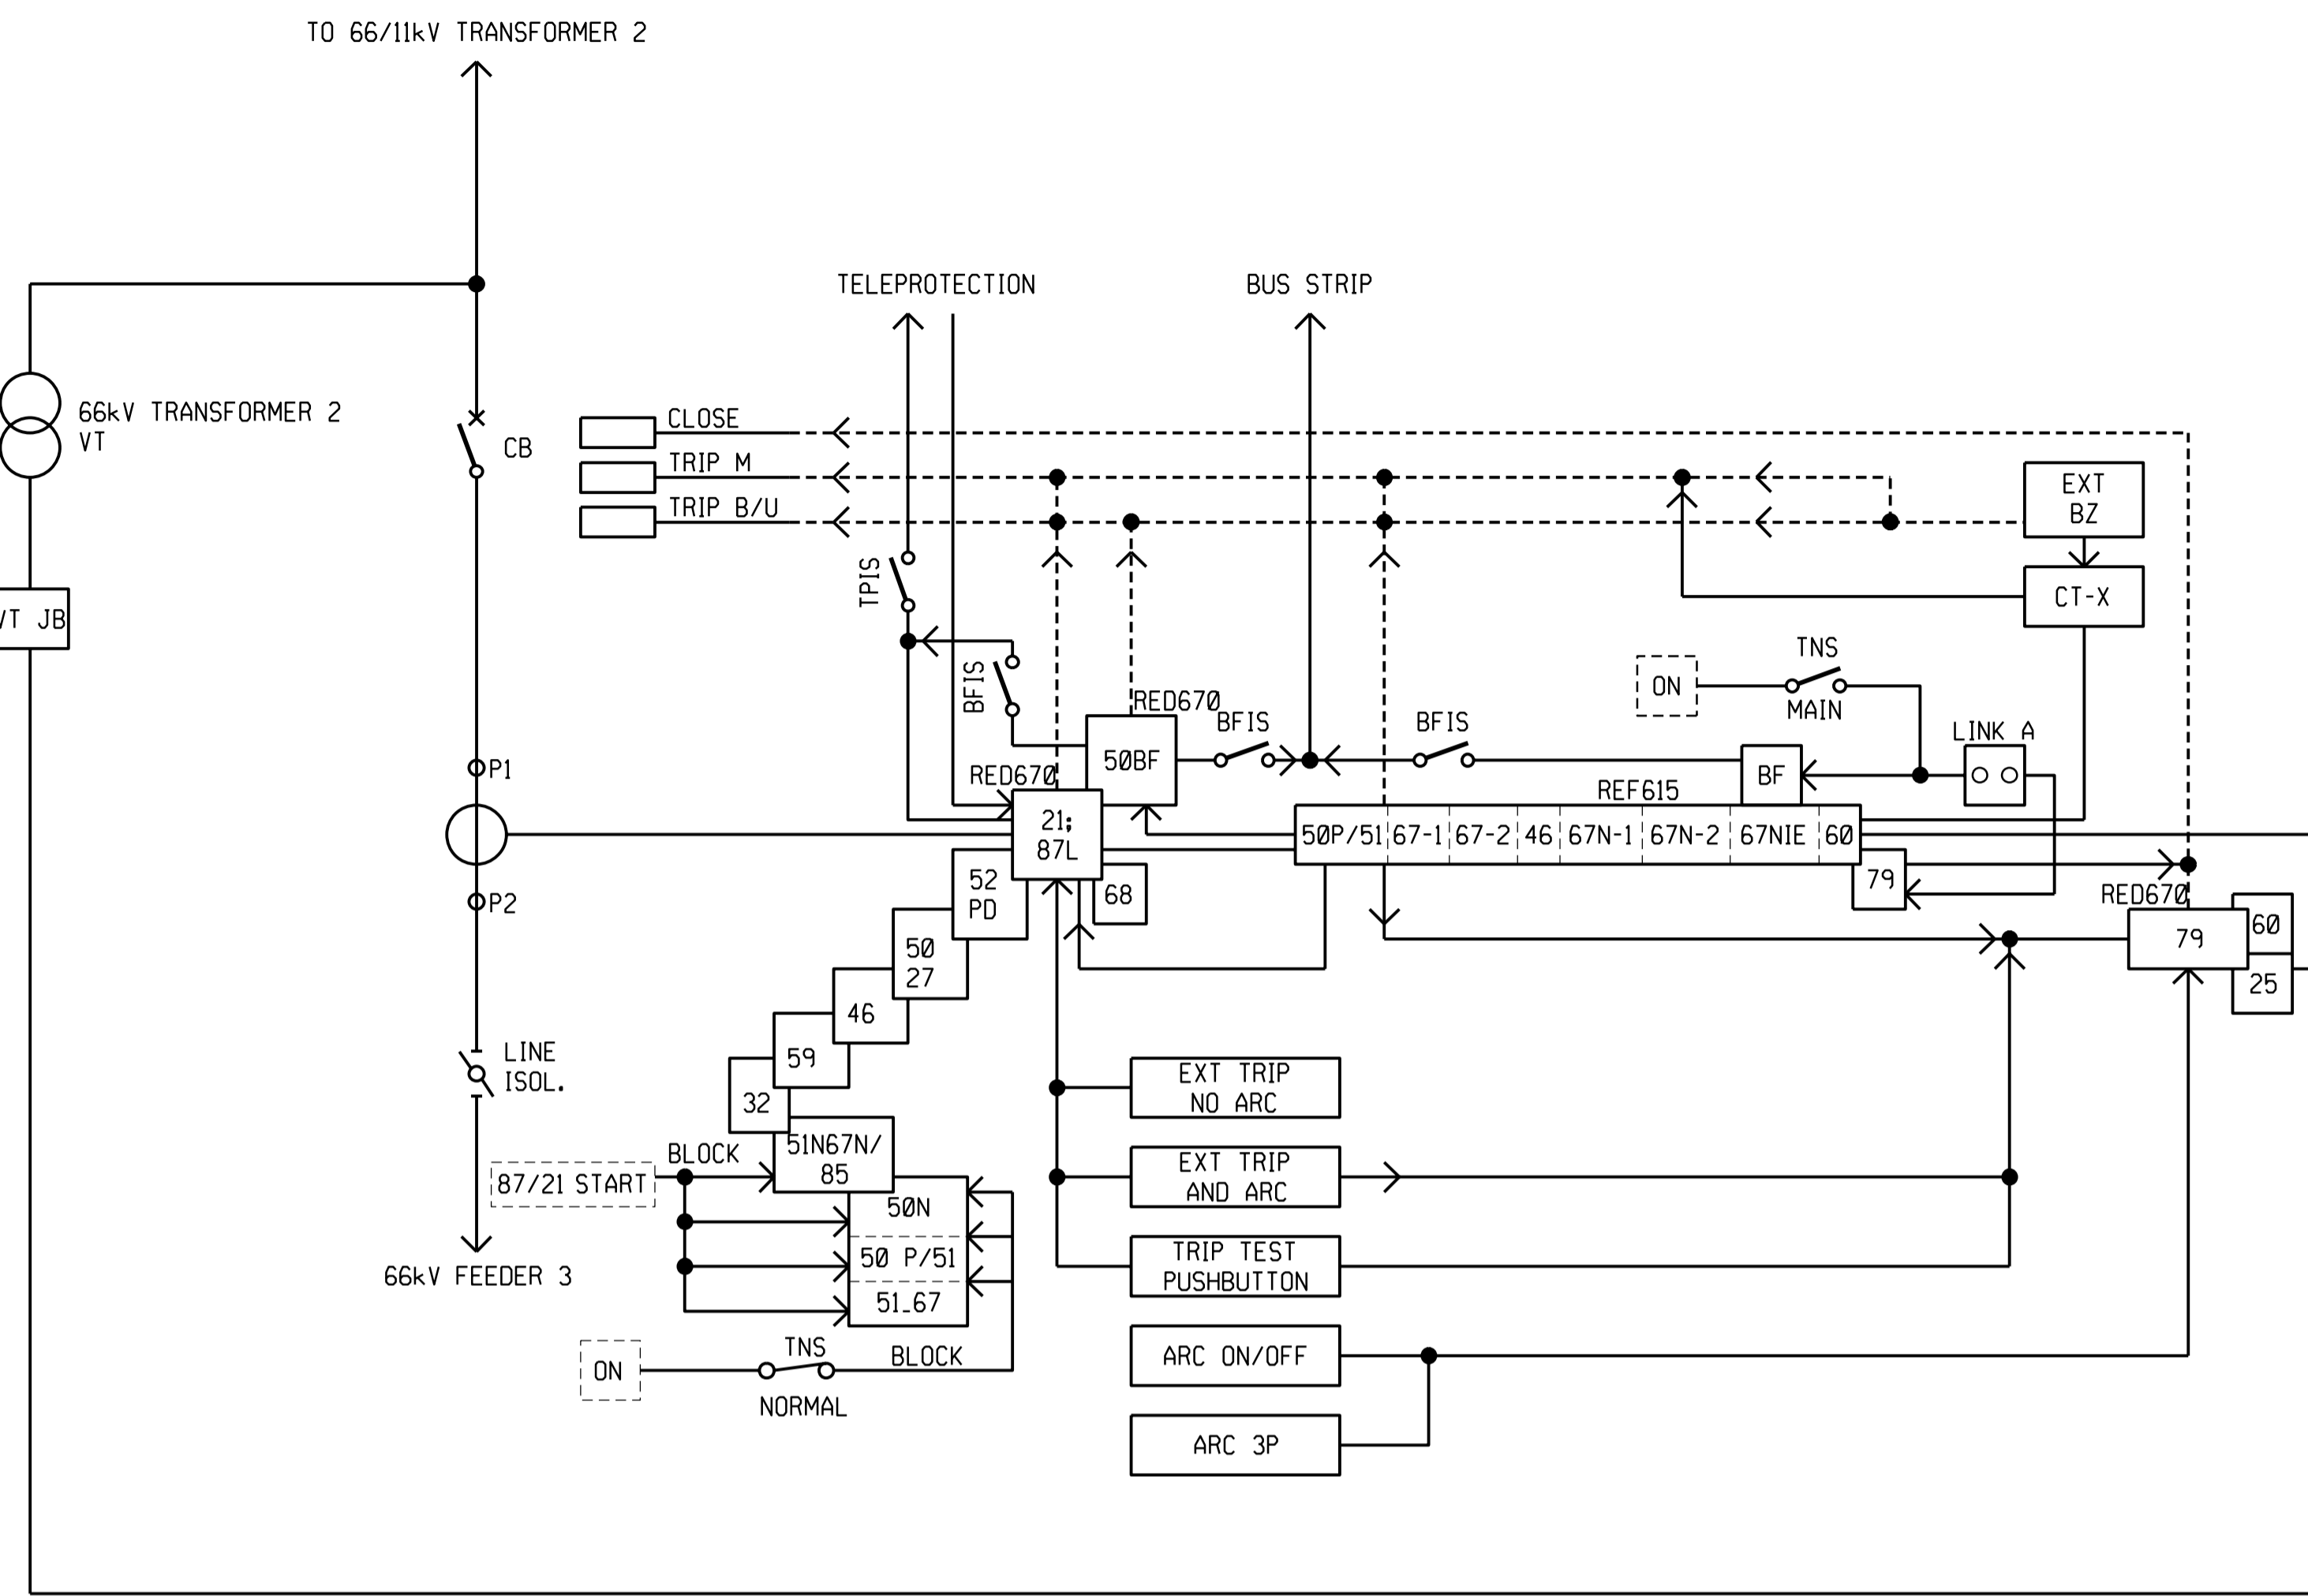

1 2 3 4 5 6 7 8 9 10 11 12 13 14 15 16 17 18 19 20 21 22 23 24 25 26 27 28 29 30 31

LEGEND	
21	DISTANCE PROTECTION FUNCTION
25	SYNCHRONISM-CHECK FUNCTION
27	UNDERVOLTAGE FUNCTION
32	DIRECTIONAL OVERPOWER FUNCTION
46	NEGATIVE SEQUENCE OVERCURRENT/ BROKEN COND FUNCTIONS
50BF	BREAKER FAIL FUNCTION
50N	NON-DIR INSTANTANEOUS EARTHFAULT FUNCTION
50/51	INSTANTANEOUS OR TIME DELAY OVERCURRENT FUNCTION
50P/51	NON-DIR INSTANTANEOUS OVERCURRENT FUNCTION
51	AC INVERSE TIME O/C FUNCTION
52PD	POLE DISAGREEMENT PROTECTION FUNCTION
59	OVERVOLTAGE FUNCTION FUNCTION
60	FUSE FAILURE FUNCTION
67-1	DIR OVERCURRENT IDMT OR DT FUNCTION
67-2	DIR HIGHSET OVERCURRENT FUNCTION
67N-1	DIRECT EARTHFAULT IDMT OR DT FUNCTION
67N-2	DIR HIGHSET EARTHFAULT FUNCTION
67NIE	INTERMITANT EARTHFAULT FUNCTION
68	POWERSWING FUNCTION
79	AUTO RECLOSE FUNCTION
85	EARTH FAULT FUNCTION AIDED
87L	LINE DIFFERENTIAL PROTECTION FUNCTION
AUX	AUXILIARY
BCD	BINARY CODED DECIMAL
BZ	BUSZONE

LEGEND	
CT-X	CROSS TRIP AUXILIARY
DIR	DIRECTIONAL
DT	DEFINITE TIME
DTTR	DIRECT TRANSFER TRIP RECIEVE
DTTS	DIRECT TRANSFER TRIP SEND
GPS	GLOBAL POSITIONING SYSTEM
GSM	GPS TIME SYNCHRONISATION MODULE
LDCM	LINE DATA COMMUNICATION MODULE (TELEPROTECTION AND DIFFERENTIAL COMMUNICATION)
LSB/MSB	LEAST SIGNIFICANT BIT /MOST SIGNIFICANT BIT
LSB	LEAST SIGNIFICANT BIT
MSB	MOST SIGNIFICANT BIT
OEM	OPTICAL ETHERNET MODULE
PCMG00	CONFIGURATION, PARAMETER SETTING & DISTURBANCE HANDLING ENGINEERING TOOL PACKAGE FOR ABB RELION SERIES
PS	PARAMETER SETTING TOOL WITHIN PCMG00
REA	REMOTE ENGINEERING ACCESS
SLM	SERIAL COMMUNICATION MODULE LON AND SPA BUS
SYNCH	CHECK SYNCHRONISM OR SYNCHRONISM-CHECK
TCS	TRIP CIRCUIT SUPERVISION (MONITOR)
TP	TEST POINT
TRIP B/U	TRIP BACKUP CIRCUIT BREAKER COIL
TRIP M	TRIP MAIN CIRCUIT BREAKER COIL
VSR	VOLTAGE SELECTION RELAY



REV	AUTH	DATE	REVISION TO MASTER	BY	CHKD	SCALE
-	-	-	-	-	-	-

I	66kV VT & CB ADDED, FEEDER RENAMED.	KS	BH	CP	25/06/2021	153272156-00003
REV	REVISION DESCRIPTION	BY	CHKD	AUTH	DATE	PROJECT NUMBER


		ISCOR SUBSTATION	
		66kV FEEDER 2	
		LOGIC DIAGRAM	
D-WC-7104	62	02	1
SET NUMBER	SHEET NUMBER	REVISION	

MASTER TRACING FILED UNDER D-DT-15007 SHEET 02 OF 28 REVISION 2

LEVELS 1 2 3 4 5 6 7 8 9 10 11 12 13 14 15 16 17 18 19 20 21 22 23 24 25 26 27 28 29 30 31 PANEL TYPE DESIGNATION 4FZD-3920

A
B
C
D
E
F
G
H
J
K
L
M

A
B
C
D
E
F
G
H
J
K
L
M

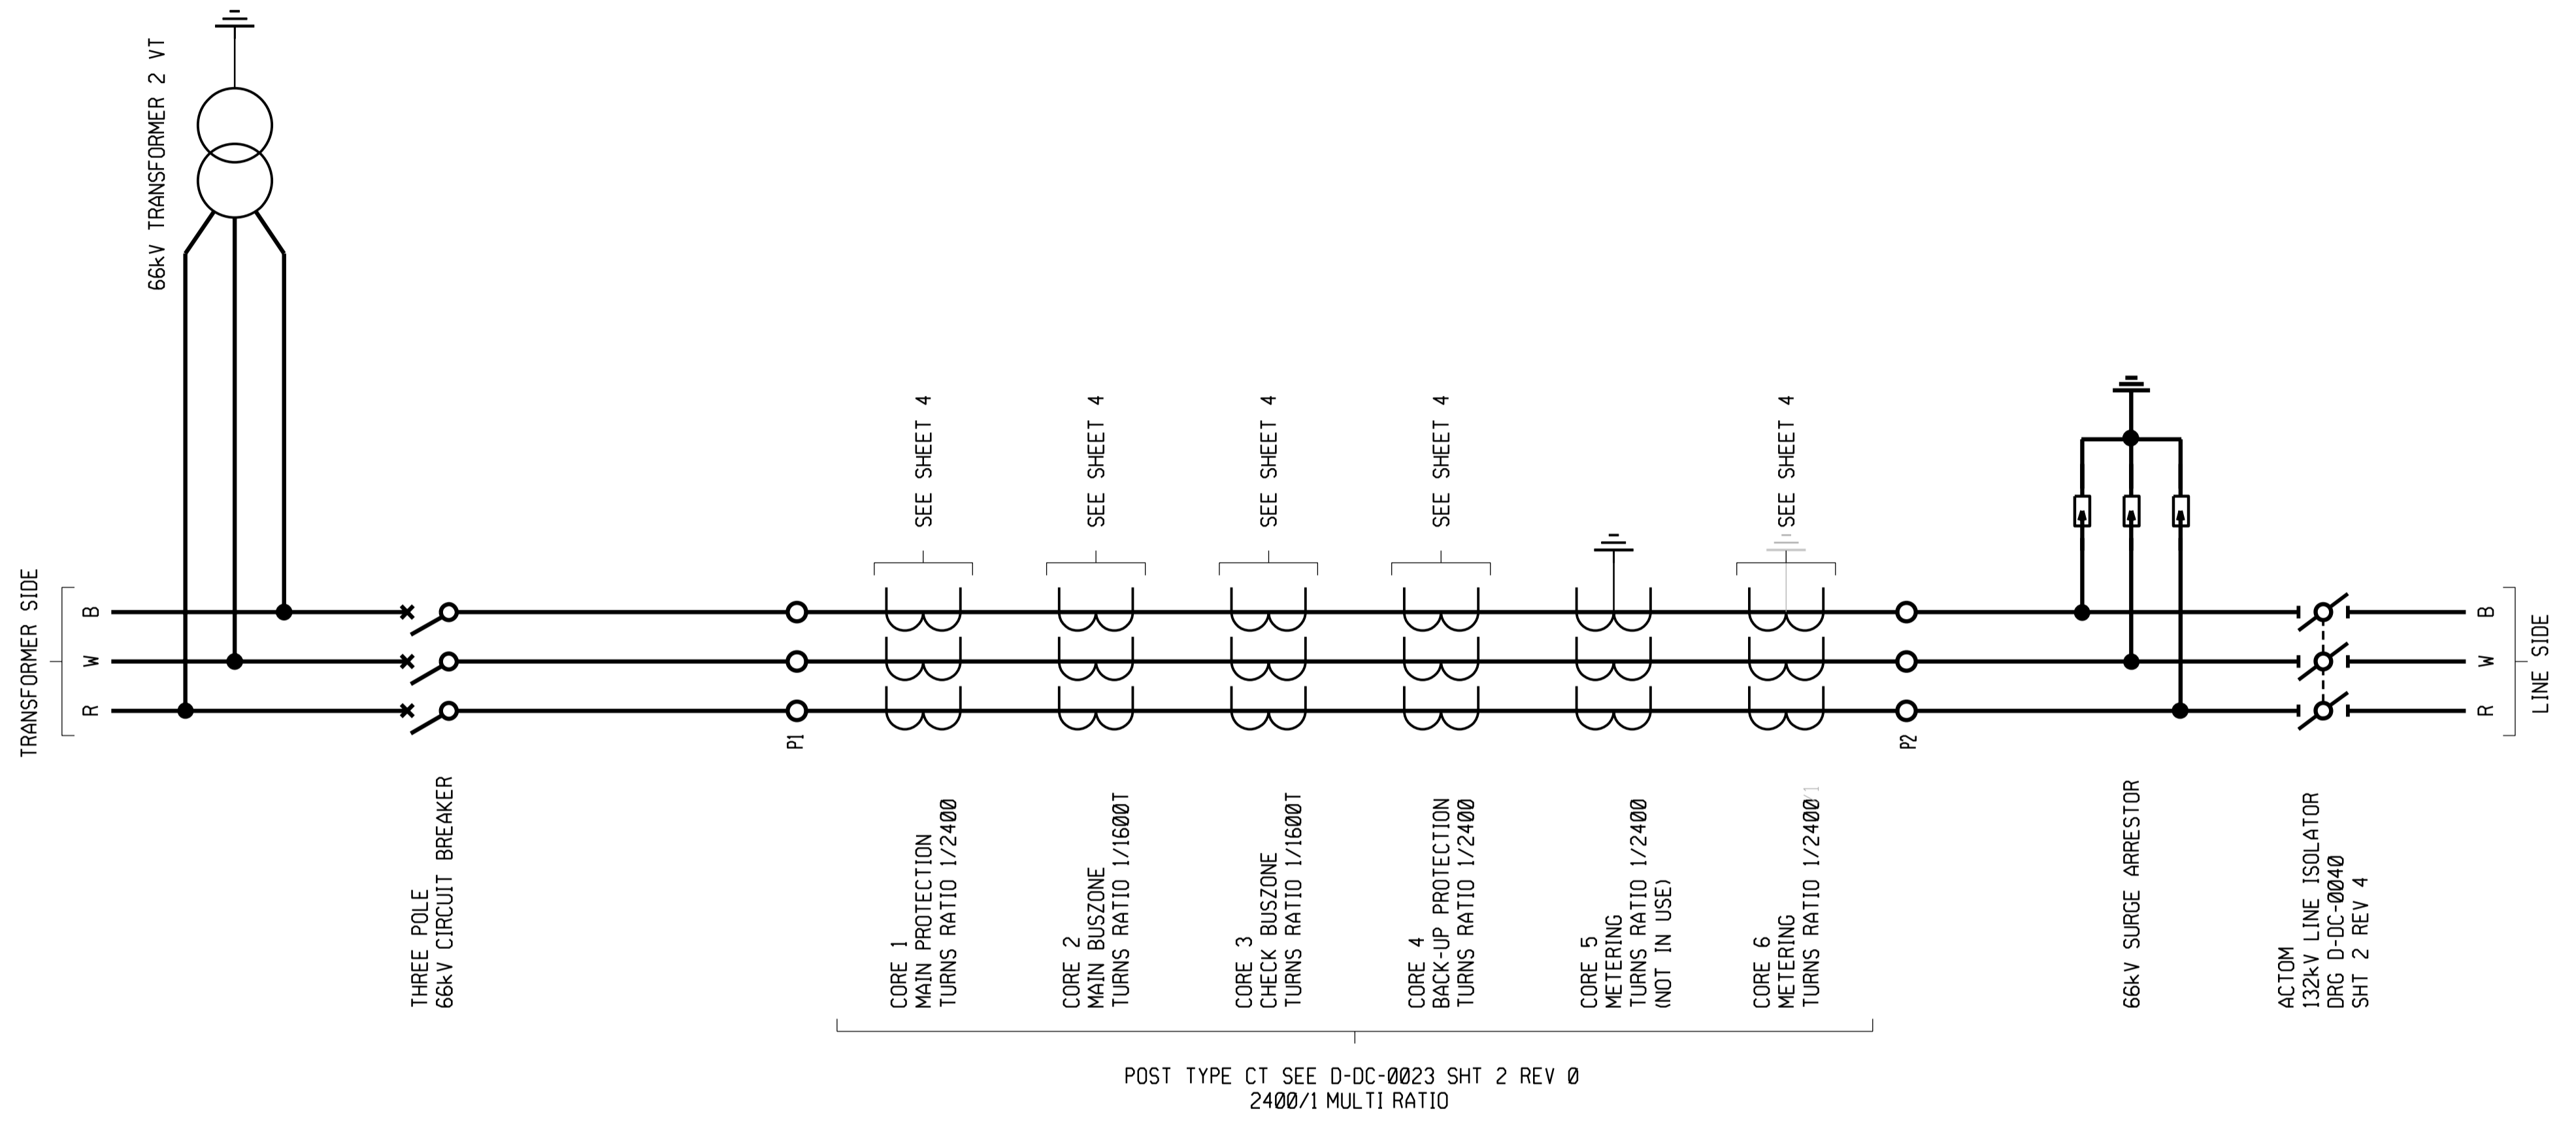

SHT 28	ISOLATOR JB
SHT 27	CABLE BLOCK
SHT 26	LINE VT DIAGRAM
SHT 25	CT JB CABLING
SHT 24	CABLING DIAGRAM
SHT 23	CABLING DIAGRAM
SHT 22	CABLING DIAGRAM
SHT 21	REFERENCE DIAG
SHT 20	REFERENCE DIAG
SHT 19	REFERENCE DIAG
SHT 18	DISTUR RECORDER
SHT 17	SUP ALARMS KEY
SHT 16	SUP STATUS, CONT
SHT 15	REA & MEAS KEY
SHT 14	SPR REW, AC KEY
SHT 13	INDICAT, DC KEY
SHT 12	CLOSE DC KEY
SHT 11	BACK-UP DC KEY
SHT 10	BACK-UP DC KEY
SHT 09	BACK-UP DC KEY
SHT 08	TELEPROT DC KEY
SHT 07	MAIN DC KEY
SHT 06	MAIN DC KEY
SHT 05	VT SUPPLY KEY
SHT 04	AC KEY DIAGRAM
SHT 03	SINGLE LINE
SHT 02	LOGIC DIAGRAM
SHT 01	PANEL LAYOUT
DRG No.	REFERENCE DRAWINGS:

1	66kV VT & CB ADDED, FEEDER RENAMED.	KS	BH	CP	25/06/2021	153272156-00003
REV	REVISION DESCRIPTION	BY	CHKD	AUTH	DATE	PROJECT NUMBER

Eskom						
PROJECT APPROVED C. PYM	DESIGN APPROVED A. CRAIB					
DATE 25/06/21	DATE 13/13/10					
PROJECT CHECKED B. HOMANN	DESIGN CHECKED N. MATHONSI					
DATE 25/06/21	DATE 13/12/10					
DRAWN BY K. STEYBERG	DRAWN BY C. CANNON					
DATE 25/06/21	DATE 26/02/10					
REV	AUTH	DATE	REVISION TO MASTER	BY	CHKD	SCALE

ISCOR SUBSTATION
66kV FEEDER 2
SINGLE LINE DIAGRAM

D-WC-7104

SET NUMBER	SHEET NUMBER	REVISION
62	03	1

PANEL TYPE DESIGNATION 4FZD-3920




LEVELS	1	2	3	4	5	6	7	8	9	10	11	12	13	14	15	16	17	18	19	20	21	22	23	24	25	26	27	28	29	30	31
--------	---	---	---	---	---	---	---	---	---	----	----	----	----	----	----	----	----	----	----	----	----	----	----	----	----	----	----	----	----	----	----

MASTER TRACING FILED UNDER D-DT-15007 SHEET 03 OF 28 REVISION 2

66/11kV TRANSFORMER 2 SIDE

66kV CIRCUIT BREAKER

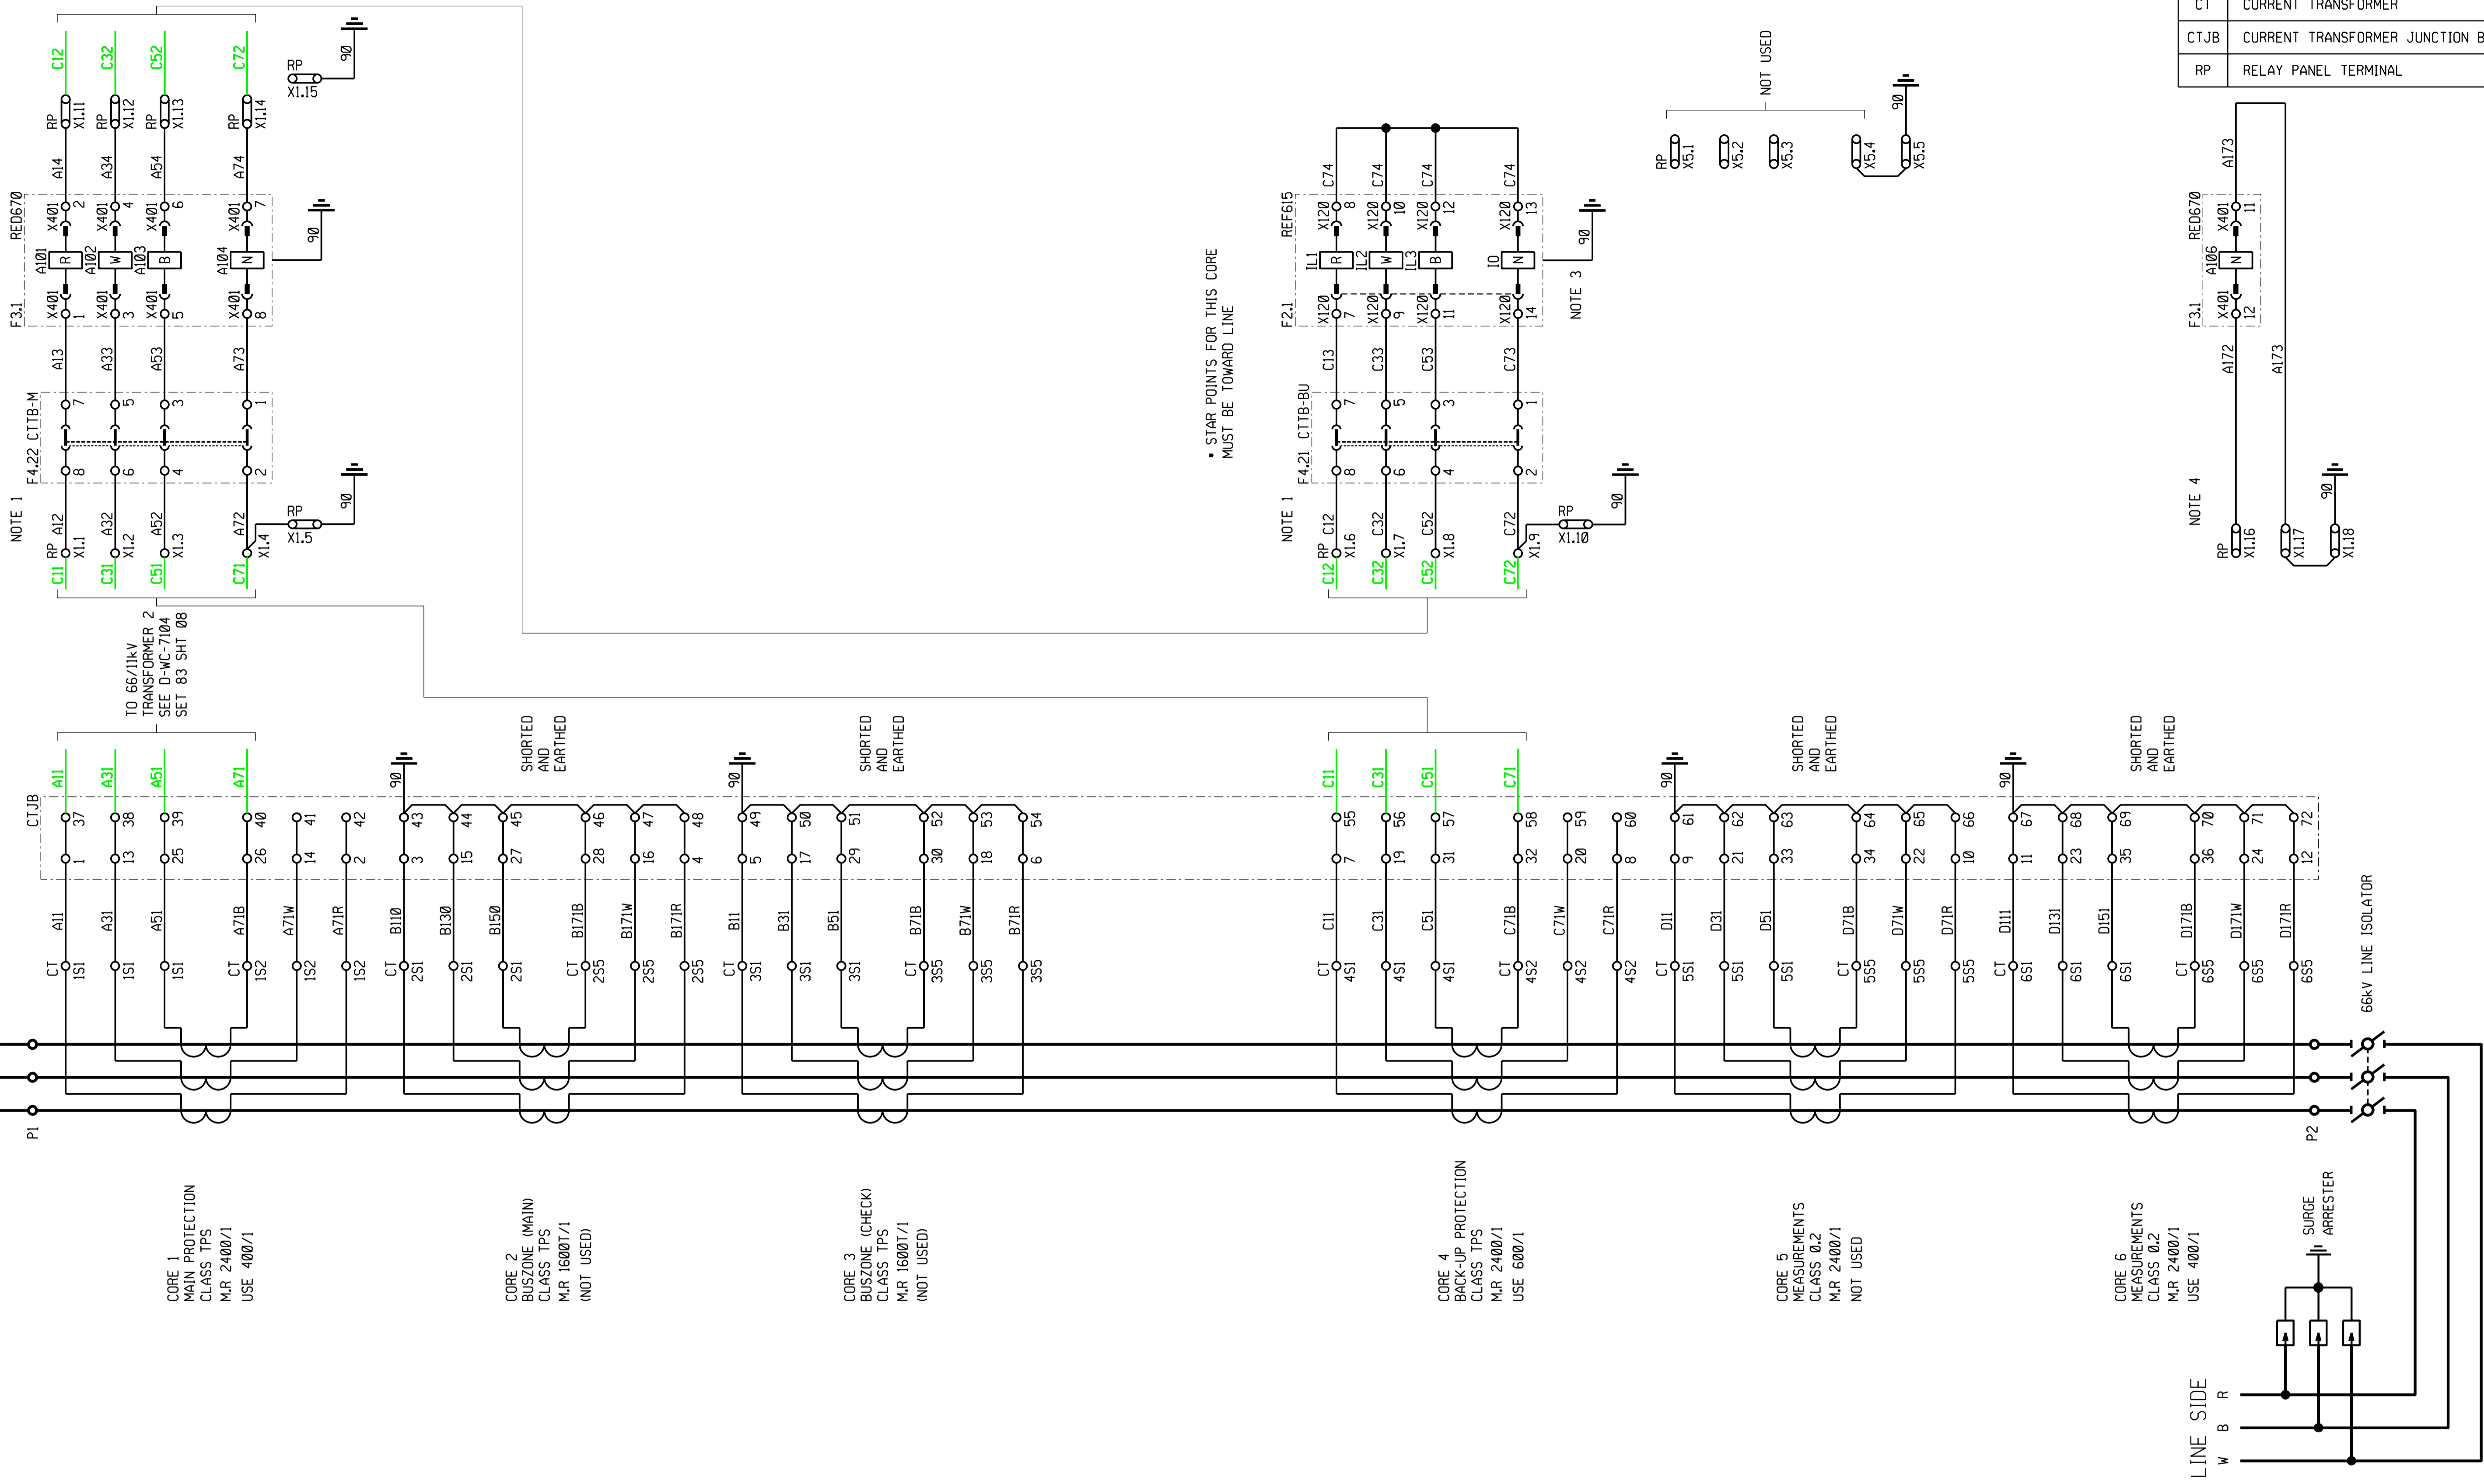

TERMINAL DESCRIPTION	
CT	CURRENT TRANSFORMER
CTJB	CURRENT TRANSFORMER JUNCTION BOX
RP	RELAY PANEL TERMINAL

- NOTES:**
- IF THE FEEDER HAS OUTBOARD PRIMARY PLANT BYPASS CAPABILITY THEN SWITCH ON DRAWING LEVEL 18 (I.E. THE CT SHORTING OPTION IS TO THEN BE ORDERED AND USED).
 - AN EXTERNAL DISTURBANCE RECORDER MAY BE CONNECTED HERE IF NO DISTURBANCE RECORDER CT CORE IS AVAILABLE.
 - THE BACK-UP IED FEATURES AN AUTOMATIC CT SHORT-CIRCUIT CONNECTOR WHEN THE PLUG-IN UNIT IS WITHDRAWN.
 - FOR THE CASE OF DOUBLE CIRCUIT LINES WITH REGARD TO THE FAULT LOCATOR ACCURACY, THE INFLUENCE OF THE ZERO-SEQUENCE MUTUAL IMPEDANCE IS COMPENSATED FOR BY CONSIDERING THE RESIDUAL CURRENT ON THE PARALLEL LINE. FOR THIS CASE, USE THESE RELAY CT INPUTS.
 - PULLING CTTB-M WILL ALSO REMOVE THE REF 615 FROM SERVICE. IN THE EVENT THAT THE MAIN IED NEEDS TO BE REMOVED FROM SERVICE, RETURN CTTB-M TO SERVICE AND INSTALL JUMPERS.

* STAR POINTS FOR THIS CORE MUST BE TOWARD LINE




REV	AUTH	DATE	REVISION TO MASTER	BY	CHKD	SCALE



1	66kV VT & CB ADDED, FEEDER RENAMED.	KS	BH	CP	25/06/2021	153272156-00003
REV	REVISION DESCRIPTION	BY	CHKD	AUTH	DATE	PROJECT NUMBER
		<p align="center">ISCOR SUBSTATION 66kV FEEDER 2 AC KEY DIAGRAM</p>				SET NUMBER 62
PROJECT APPROVED C. PYM DATE 25/06/21		DESIGN APPROVED A. CRAIB DATE 13/13/10				SHEET NUMBER 04
PROJECT CHECKED B. HOMANN DATE 25/06/21		DESIGN CHECKED N. MATHONSI DATE 26/02/10				REVISION 1
DRAWN BY K. STEYBERG		DRAWN BY C. CANNON				PANEL TYPE DESIGNATION 4FZD-3920

MASTER TRACING FILED UNDER D-DT-15007 SHEET 04 OF 28 REVISION 2

LINE VOLTS
(LINE VT JB)
(NOT USED)

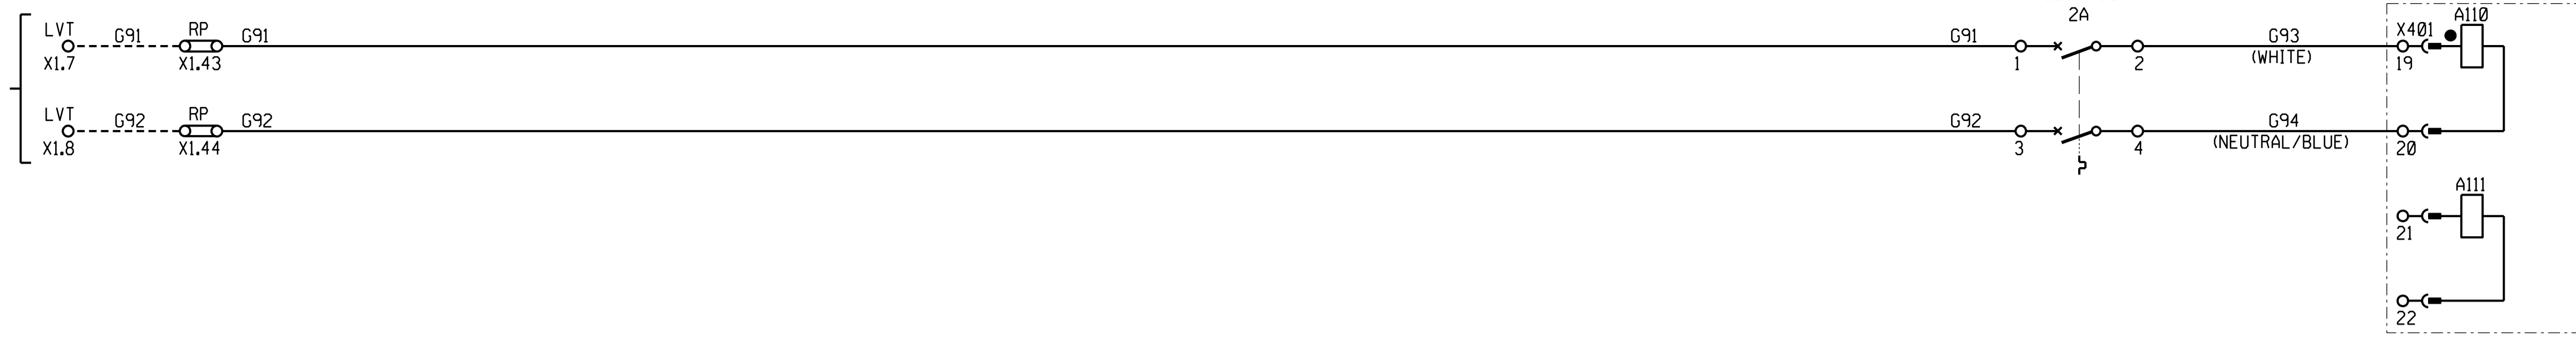

- NOTE:**
- ALL OPTIONS ARE WIRED IN, ONLY THE OPTIONAL RELAYS NEED TO BE INSERTED TO SELECT THE SPECIFIC OPTION.
 - RELAY VSR WITH ASSOCIATED WIRING IS ONLY REQUIRED WHEN THE MULTIPLE BUSBAR OPTION IS TAKEN.
IF THE MULTIPLE BUSBAR OPTION IS NOT TAKEN, THE VT'S ARE TO BE CONNECTED AS FOLLOWS :-
MEASUREMENTS - X1.31, X1.32, X1.33 AND X1.34
PROTECTION - X1.19, X1.20, X1.21 AND X1.22
ADD LOOPS FROM X1.19 TO X1.27
X1.20 TO X1.28
X1.21 TO X1.29 } PROTECTION VT CIRCUIT
AND X1.31 TO X1.39
X1.32 TO X1.40
X1.33 TO X1.41 } MEASUREMENTS VT CIRCUIT
 - SELECT THE PREFERRED VOLTAGE FOR THE SYNCHRONISING CHECK OPTION, THE RELAY CAN USE THE FOLLOWING VOLTAGES: R-N, W-N, B-N, R-W, W-B, B-R.
 - THE IMPEDANCE VOLTS ARE DESIGNATED THE 'BUS' VOLTS AND THE SYNCH CHECK VOLTS ARE DESIGNATED THE 'LINE' VOLTS WITHIN THE ABB RED670 RELAY. THIS IS IDENTICAL TO THE DISTRIBUTION STANDARD OF 'BUS' VOLTS AND 'LINE' VOLTS, AS DEPICTED ON SHEETS 3 AND 5.

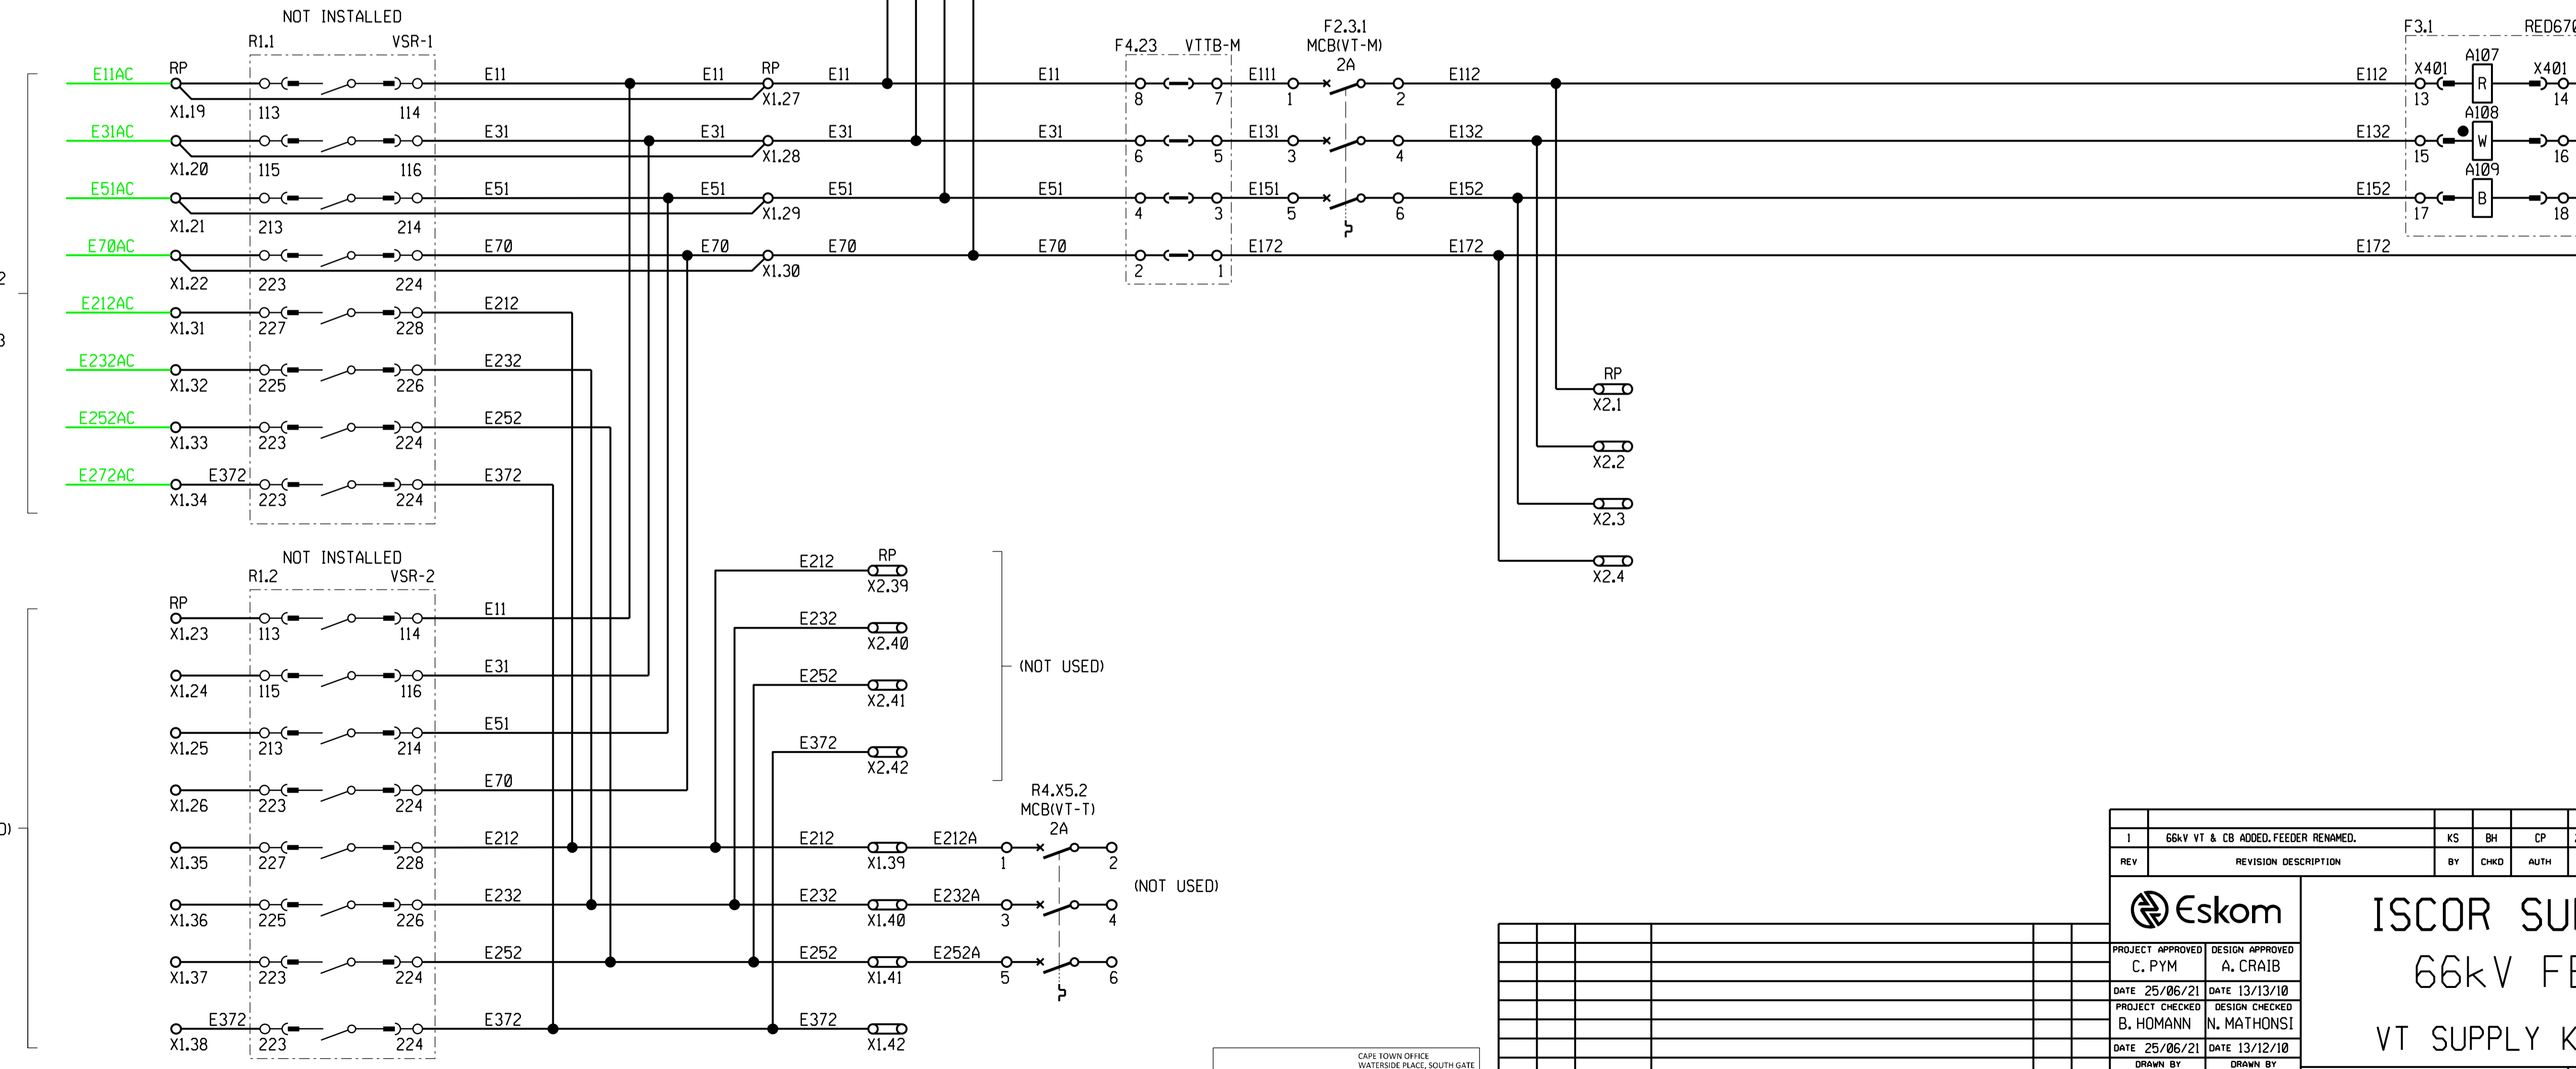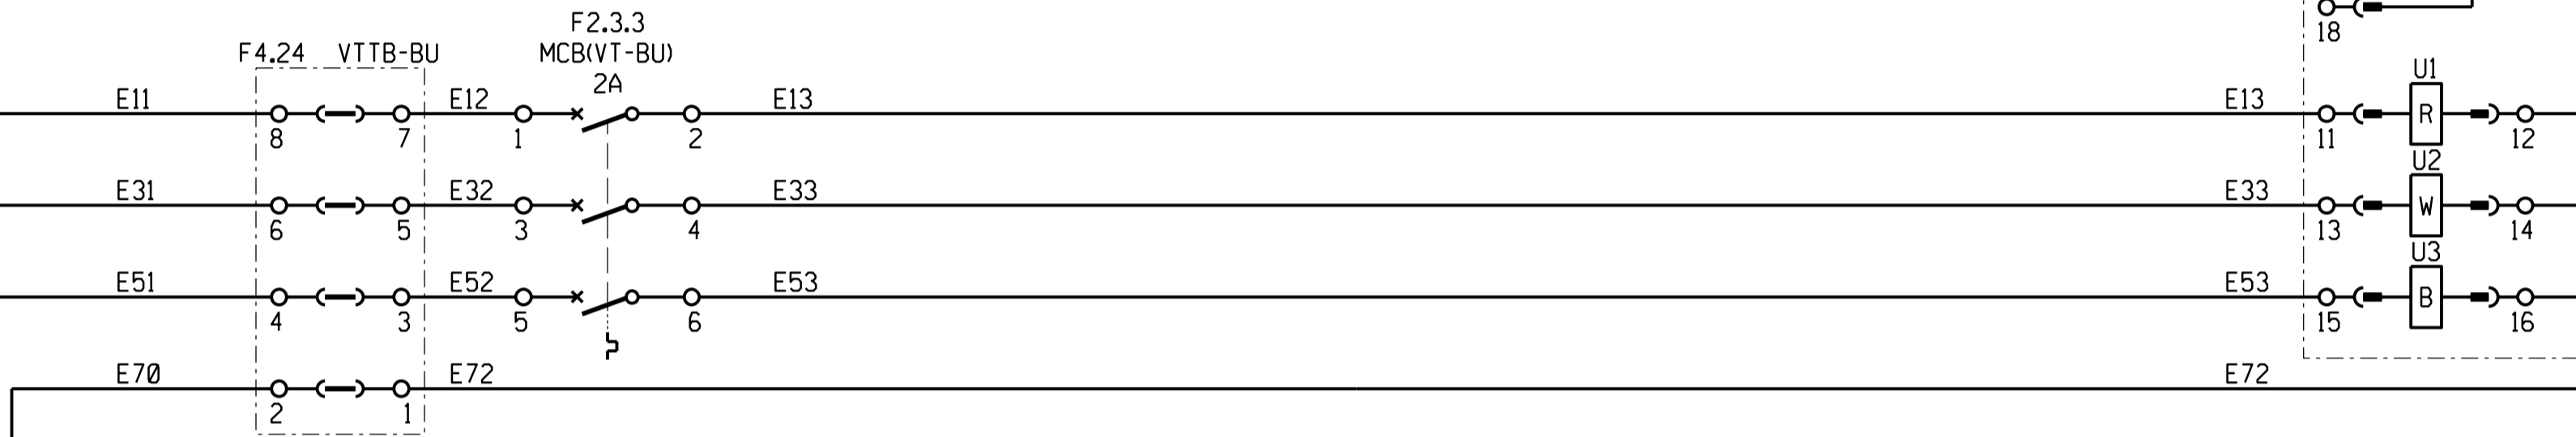

SHT 28	ISOLATOR JB
SHT 27	CABLE BLOCK
SHT 26	LINE VT DIAGRAM
SHT 25	CT JB CABLING
SHT 24	CABLING DIAGRAM
SHT 23	CABLING DIAGRAM
SHT 22	CABLING DIAGRAM
SHT 21	REFERENCE DIAG
SHT 20	REFERENCE DIAG
SHT 19	REFERENCE DIAG
SHT 18	DISTUR RECORDER
SHT 17	SUP ALARMS KEY
SHT 16	SUP STATUS, CONT
SHT 15	REA & MEAS KEY
SHT 14	SPR REW, AC KEY
SHT 13	INDICAT, DC KEY
SHT 12	CLOSE DC KEY
SHT 11	BACK-UP DC KEY
SHT 10	BACK-UP DC KEY
SHT 09	BACK-UP DC KEY
SHT 08	TELEPROT DC KEY
SHT 07	MAIN DC KEY
SHT 06	MAIN DC KEY
SHT 05	VT SUPPLY KEY
SHT 04	AC KEY DIAGRAM
SHT 03	SINGLE LINE
SHT 02	LOGIC DIAGRAM
SHT 01	PANEL LAYOUT
DRG No.	REFERENCE DRAWINGS:

1	66kV VT & CB ADDED, FEEDER RENAMED.	KS	BH	CP	25/06/2021	153272156-00003			
REV	REVISION DESCRIPTION	BY	CHKD	AUTH	DATE	PROJECT NUMBER			
PROJECT APPROVED C. PYM		DESIGN APPROVED A. CRAIB							
DATE 25/06/21		DATE 13/13/10							
PROJECT CHECKED B. HOMANN		DESIGN CHECKED N. MATHONSI							
DATE 25/06/21		DATE 13/12/10							
DRAWN BY K. STEYNBERG		DRAWN BY C. CANNON							
DATE 25/06/21		DATE 26/02/10							
REV	AUTH	DATE	REVISION TO MASTER			BY	CHKD	SCALE	
<h2>ISCOR SUBSTATION</h2> <h3>66kV FEEDER 2</h3> <h4>VT SUPPLY KEY DIAGRAM</h4>							SET NUMBER	SHEET NUMBER	REVISION
D-WC-7104							62	05	1
PANEL TYPE DESIGNATION 4FZD-3920									



LEVELS	1	2	5	10	11	12	21	25	28
--------	---	---	---	----	----	----	----	----	----

MASTER TRACING FILED UNDER D-DT-15007 SHEET 05 OF 28 REVISION 2

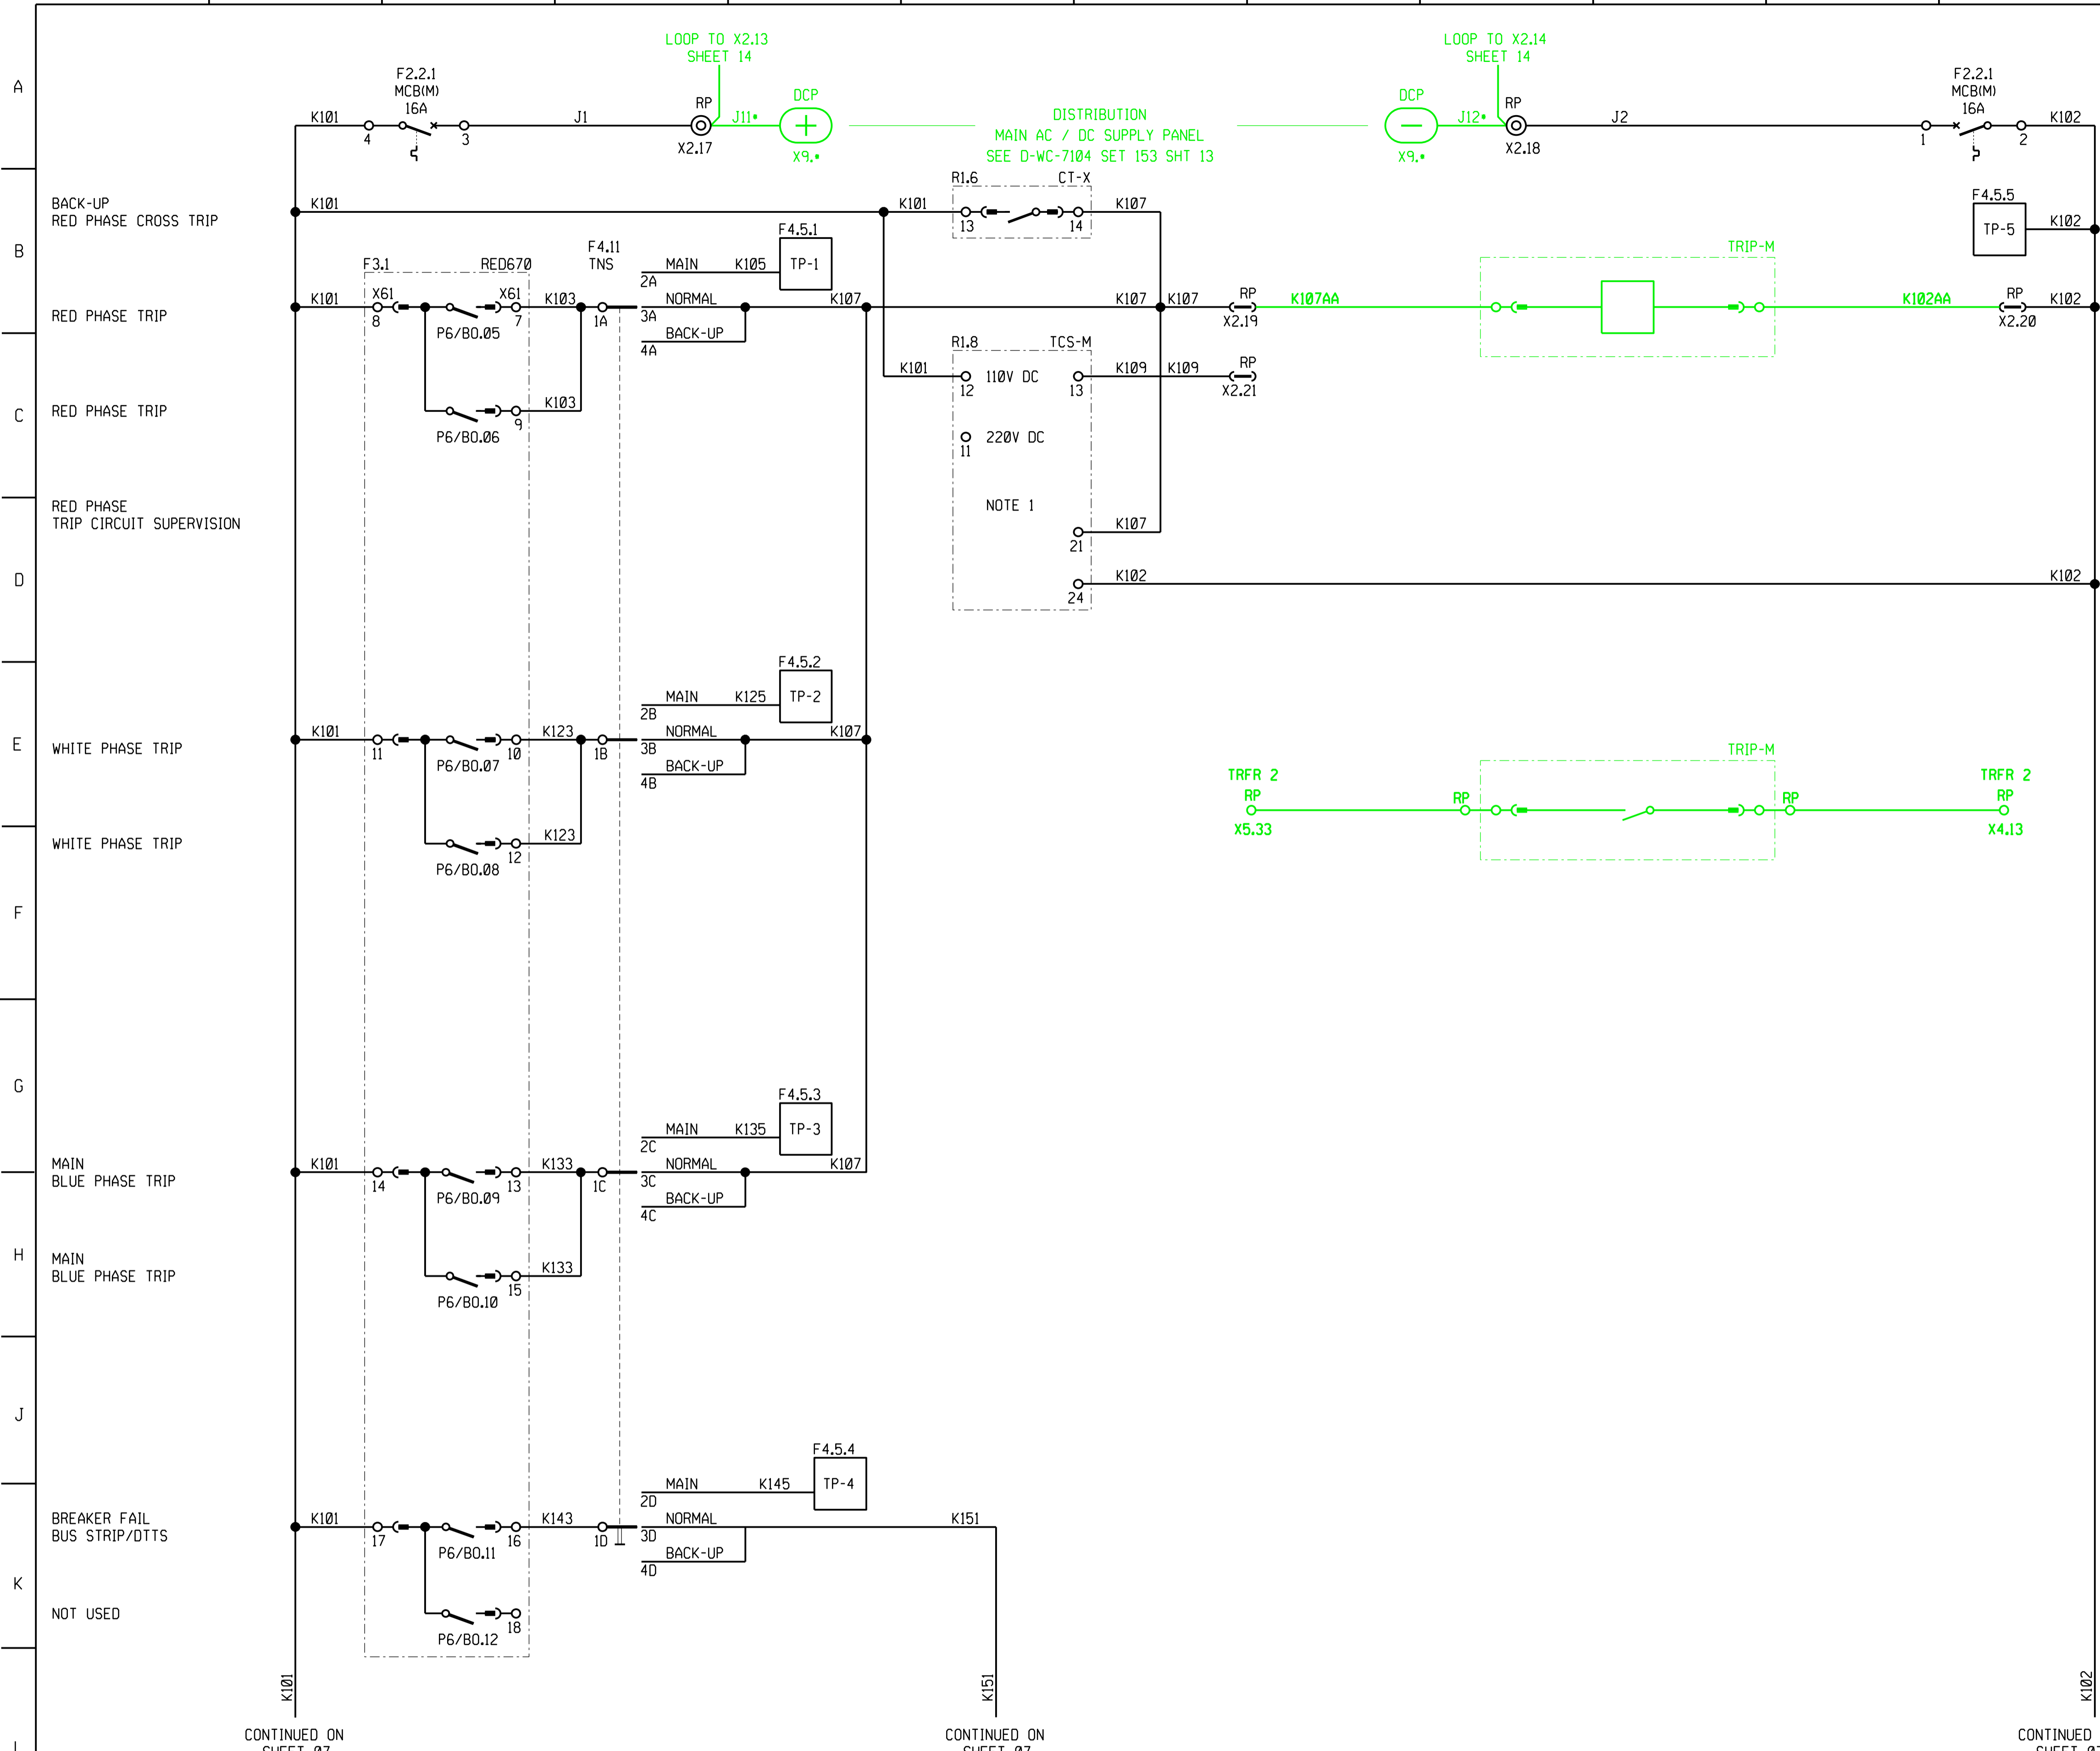


ABB 132kV THREE POLE BREAKER LEGEND	
ITEM	DESCRIPTION
BD1	DENSITY SWITCH
BG1	BREAKER AUXILIARY CONTACTS
BT1	HEATER THERMOSTAT
BW1	SPRING LIMIT SWITCH
E1	HEATER (PERMANENTLY CONNECTED)
E2	HEATER (THERMOSTAT CONTROLLED)
F1	DIRECT ON LINE MOTOR STARTER MCB
F2	MINATURE CIRCUIT BREAKER (HEATER)
K1	AUXILIARY RELAY (SPRING LIMIT SWITCH)
K3	ANTI-PUMPING RELAY
K9	SF6 INTERLOCKING RELAY (CLOSE)
K10	SF6 INTERLOCKING RELAY (MAIN TRIP)
K19	AUXILIARY RELAY (THERMOSTAT)
K19.1 & K19.2	CURRENT RELAY (HEATER)
K25	SF6 AUXILIARY RELAY (SF6 LOW GAS ALARM)
KT1	TIME DELAYED RELAY (SPRING CHARGE FAILURE)
M1	SPRING REWIND MOTOR
S4	BREAKER ISOLATOR SWITCH (LOR)
SX11 - SX22	CONNECTION TERMINALS
SXY1 - SXY3	CONNECTION TERMINALS
X1	TERMINAL BLOCK FOR CONNECTIONS
X11 - X22	CONNECTION TERMINALS
XC1 - XC7	CONNECTION POINT
Y1	MAIN TRIP COIL
Y2	BACK-UP TRIP COIL
Y3	CLOSE COIL

NOTE:
 1. REMOVE TCS-M TRIP CIRCUIT SUPERVISION RELAY IN ORDER TO PREVENT TCS FAIL ALARM. CIRCUIT BREAKER HEALTH IS MONITORED BY THE TRANSFORMER PROTECTION.

SHT 28	ISOLATOR JB
SHT 27	CABLE BLOCK
SHT 26	LINE VT DIAGRAM
SHT 25	CT JB CABLING
SHT 24	CABLING DIAGRAM
SHT 23	CABLING DIAGRAM
SHT 22	CABLING DIAGRAM
SHT 21	REFERENCE DIAG
SHT 20	REFERENCE DIAG
SHT 19	REFERENCE DIAG
SHT 18	DISTUR RECORDER
SHT 17	SUP ALARMS KEY
SHT 16	SUP STATUS, CONT
SHT 15	REA & MEAS KEY
SHT 14	SPR REW, AC KEY
SHT 13	INDICAT, DC KEY
SHT 12	CLOSE DC KEY
SHT 11	BACK-UP DC KEY
SHT 10	BACK-UP DC KEY
SHT 09	BACK-UP DC KEY
SHT 08	TELEPROT DC KEY
SHT 07	MAIN DC KEY
SHT 06	MAIN DC KEY
SHT 05	VT SUPPLY KEY
SHT 04	AC KEY DIAGRAM
SHT 03	SINGLE LINE
SHT 02	LOGIC DIAGRAM
SHT 01	PANEL LAYOUT
DRG No.	REFERENCE DRAWINGS:

1	66kV VT & CB ADDED, FEEDER RENAMED.	KS	BH	CP	25/06/2021	153272156-00003
REV	REVISION DESCRIPTION	BY	CHKD	AUTH	DATE	PROJECT NUMBER

Eskom

PROJECT APPROVED
C. PYM

DESIGN APPROVED
A. CRAIB

DATE 25/06/21 DATE 13/13/10

PROJECT CHECKED
B. HOMANN

DESIGN CHECKED
N. MATHONSI

DATE 25/06/21 DATE 13/12/10

DRAWN BY
K. STEYBERG

DATE 25/06/21 DATE 26/02/10

ISCOR SUBSTATION

66kV FEEDER 2

MAIN DC KEY DIAGRAM

D-WC-7104


SET NUMBER	SHEET NUMBER	REVISION
62	06	1

PANEL TYPE DESIGNATION 4FZD-3920



REV	AUTH	DATE	REVISION TO MASTER	BY	CHKD	SCALE

MASTER TRACING FILED UNDER D-DT-15007 SHEET 06 OF 28 REVISION 2

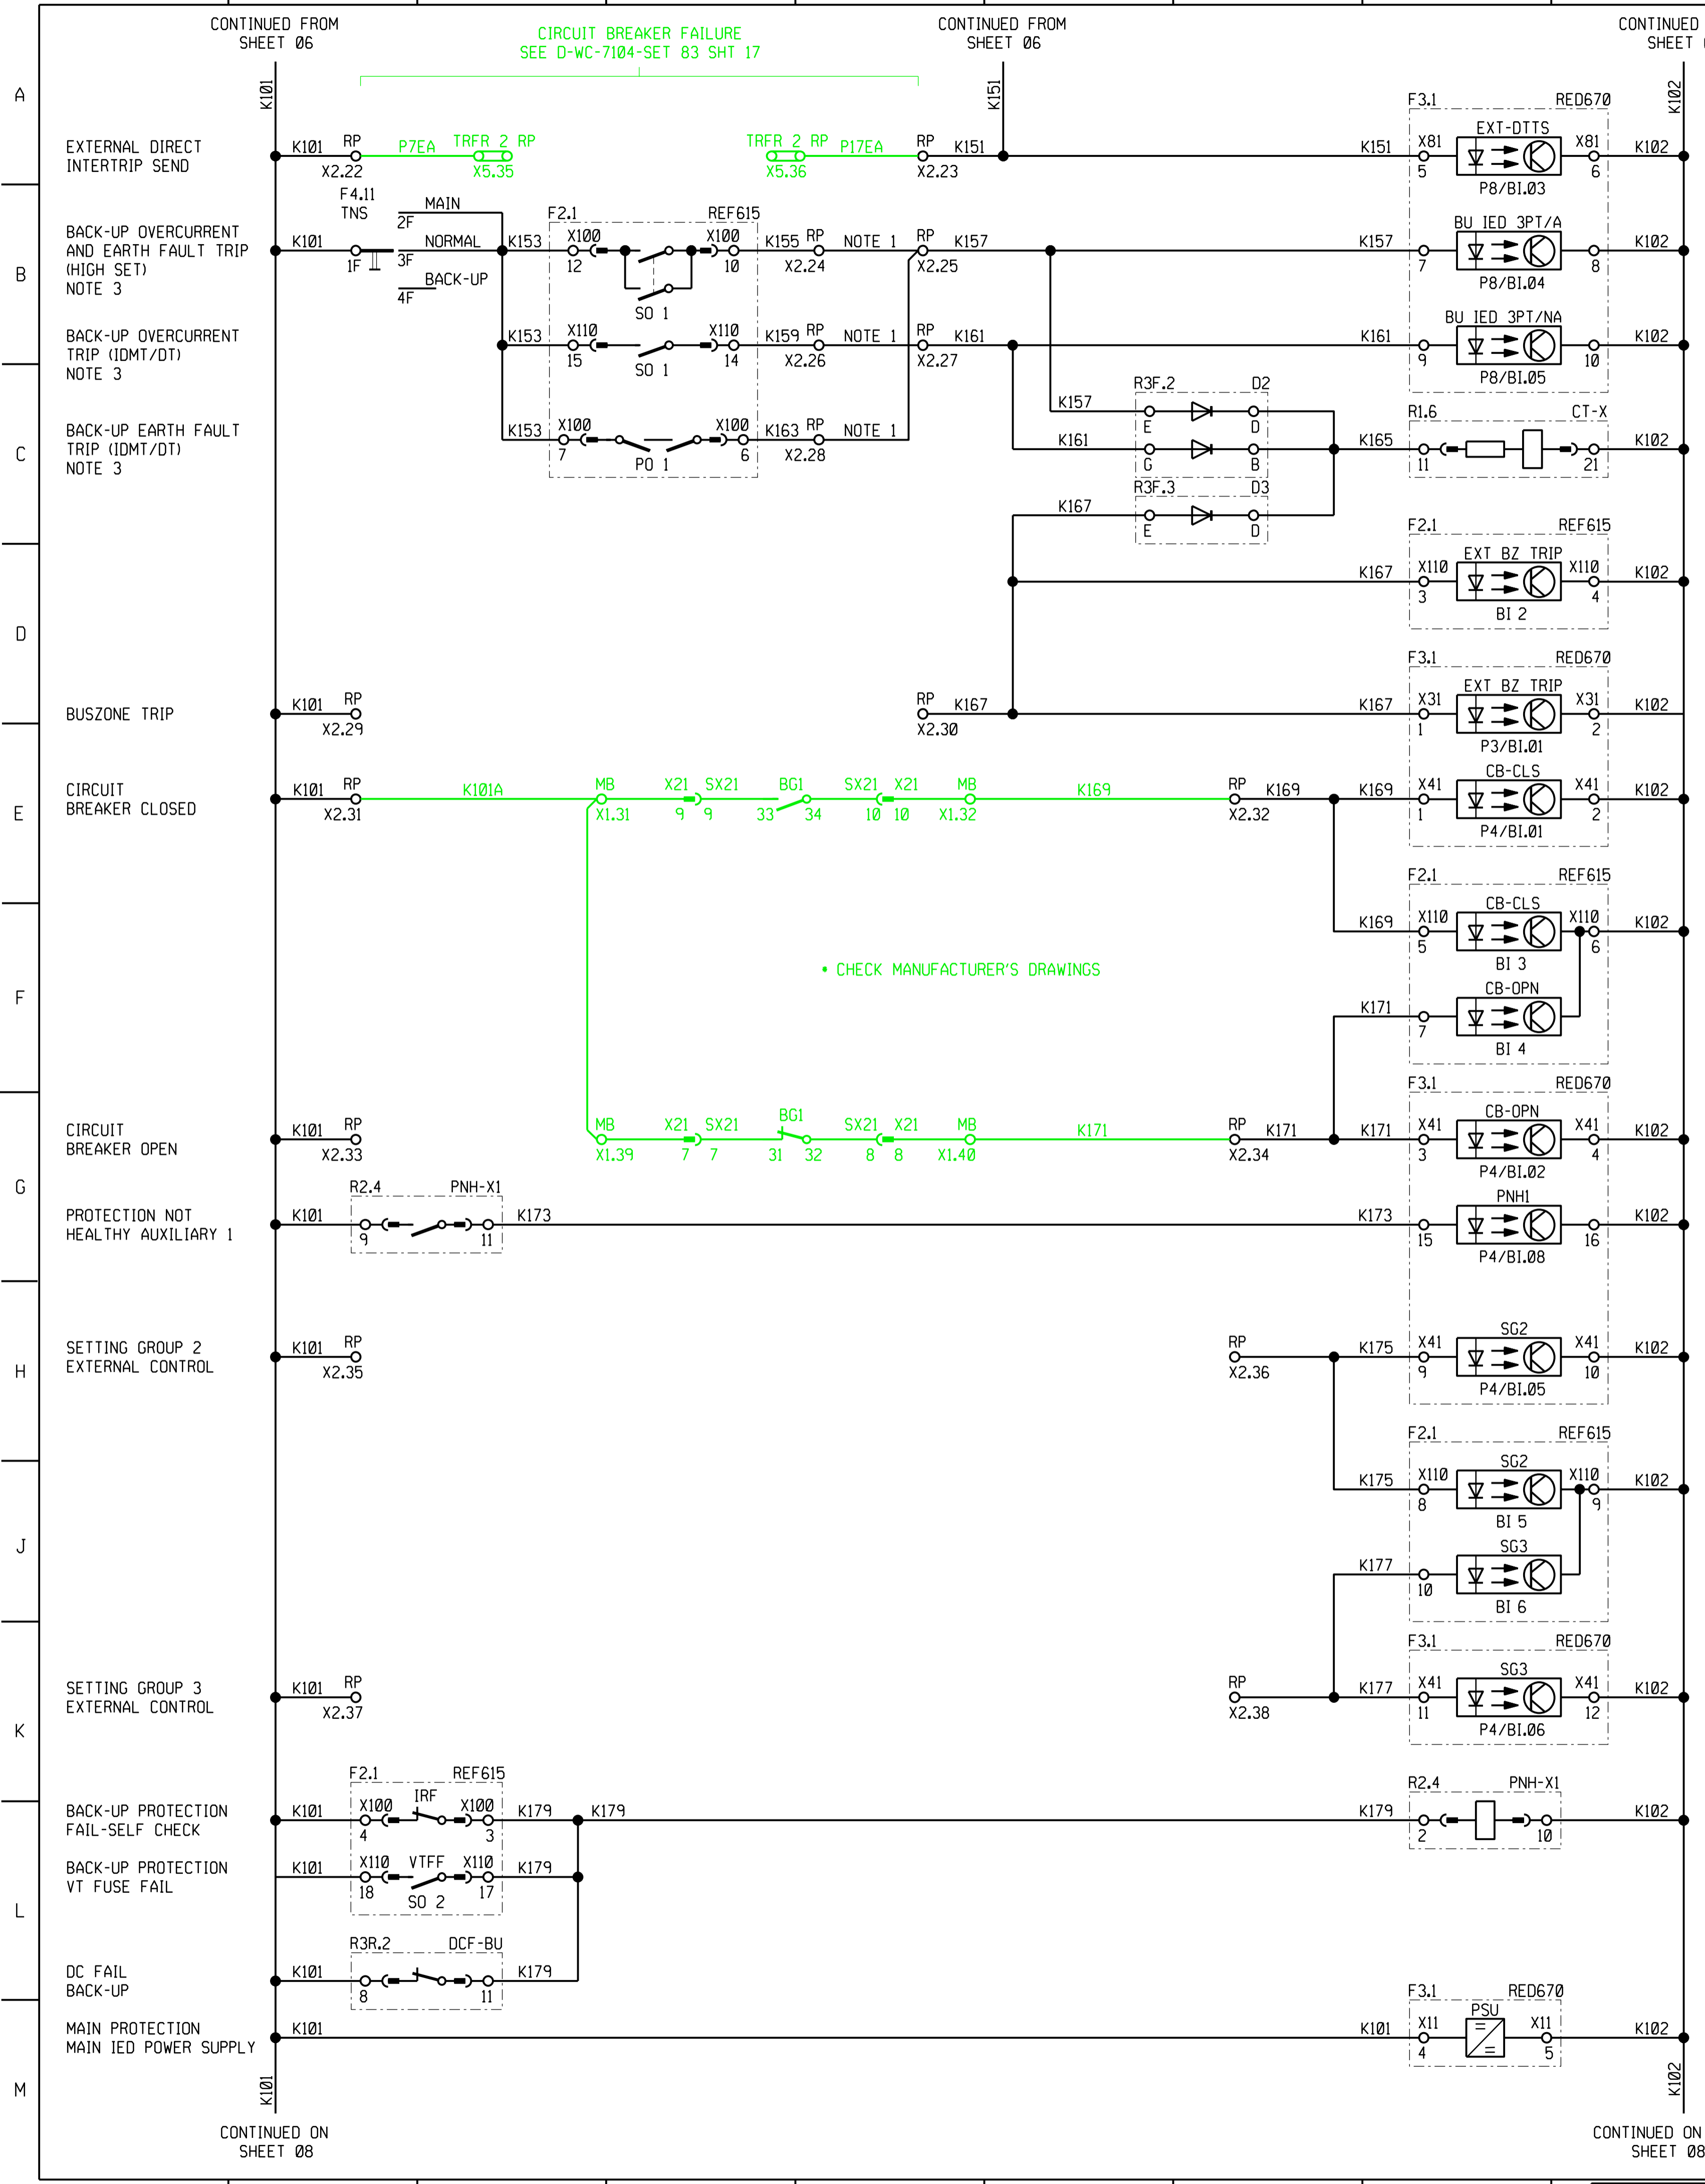

NOTE:

- CONNECT RELAY PANEL TERMINALS AS REQUIRED FOR INITIATION OF AUTO RECLOSE.
- FOR RED670 IMPEDANCE FUNCTION, ZONE 2 INITIATED AUTO-RECLOSE SET GATE 12 TO 'ON' (DEFAULT = 'OFF').
- THESE OUTPUTS OF THE BACK-UP IED (REF615) ARE MASKED/ SET TO 'NON-LATCHED'.

ABB 132kV THREE POLE BREAKER LEGEND	
ITEM	DESCRIPTION
BD1	DENSITY SWITCH
BG1	BREAKER AUXILIARY CONTACTS
BT1	HEATER THERMOSTAT
BW1	SPRING LIMIT SWITCH
E1	HEATER (PERMANENTLY CONNECTED)
E2	HEATER (THERMOSTAT CONTROLLED)
F1	DIRECT ON LINE MOTOR STARTER MCB
F2	MINATURE CIRCUIT BREAKER (HEATER)
K1	AUXILIARY RELAY (SPRING LIMIT SWITCH)
K3	ANTIPUMPING RELAY
K9	SF6 INTERLOCKING RELAY (CLOSE)
K10	SF6 INTERLOCKING RELAY (MAIN TRIP)
K19	AUXILIARY RELAY (THERMOSTAT)
K19.1 & K19.2	CURRENT RELAY (HEATER)
K25	SF6 AUXILIARY RELAY (SF6 LOW GAS ALARM)
KT1	TIME DELAYED RELAY (SPRING CHARGE FAILURE)
MI	SPRING REWIND MOTOR
S4	BREAKER ISOLATOR SWITCH (LOR)
SX11 - SX22	CONNECTION TERMINALS
SXY1 - SXY3	CONNECTION TERMINALS
X1	TERMINAL BLOCK FOR CONNECTIONS
X11 - X22	CONNECTION TERMINALS
XC1 - XC7	CONNECTION POINT
Y1	MAIN TRIP COIL
Y2	BACK-UP TRIP COIL
Y3	CLOSE COIL

SHT 28	ISOLATOR JB
SHT 27	CABLE BLOCK
SHT 26	LINE VT DIAGRAM
SHT 25	CT JB CABLING
SHT 24	CABLING DIAGRAM
SHT 23	CABLING DIAGRAM
SHT 22	CABLING DIAGRAM
SHT 21	REFERENCE DIAG
SHT 20	REFERENCE DIAG
SHT 19	REFERENCE DIAG
SHT 18	DISTUR RECORDER
SHT 17	SUP ALARMS KEY
SHT 16	SUP STATUS, CONT
SHT 15	REA & MEAS KEY
SHT 14	SPR REW, AC KEY
SHT 13	INDICAT, DC KEY
SHT 12	CLOSE DC KEY
SHT 11	BACK-UP DC KEY
SHT 10	BACK-UP DC KEY
SHT 09	BACK-UP DC KEY
SHT 08	TELEPROT DC KEY
SHT 07	MAIN DC KEY
SHT 06	MAIN DC KEY
SHT 05	VT SUPPLY KEY
SHT 04	AC KEY DIAGRAM
SHT 03	SINGLE LINE
SHT 02	LOGIC DIAGRAM
SHT 01	PANEL LAYOUT
DRG No.	REFERENCE DRAWINGS:

AECOM
CAPE TOWN OFFICE
TYGER WATERFRONT
CARL CRONJE DRIVE
TEL: +27 (0)21 950 7500
FAX: +27 (0)21 950 7502
REG. No. 1966/00628/07

1	66kV VT & CB ADDED, FEEDER RENAMED.	KS	BH	CP	25/06/2021	153272156-00003
REV	REVISION DESCRIPTION	BY	CHKD	AUTH	DATE	PROJECT NUMBER

PROJECT APPROVED	DESIGN APPROVED
C. PYM	A. CRAIB
DATE 25/06/21	DATE 13/13/10
PROJECT CHECKED	DESIGN CHECKED
B. HOMANN	N. MATHONSI
DATE 25/06/21	DATE 13/12/10
DRAWN BY	DRAWN BY
K. STEYNBERG	C. CANNON
DATE 25/06/21	DATE 26/02/10

Eskom

ISCOR SUBSTATION 66kV FEEDER 2 MAIN DC KEY DIAGRAM

D-WC-7104 62 07 1

PANEL TYPE DESIGNATION 4FZD-3920

LEVELS 1 2 5 10 11 12 20 21 22 25 28

MASTER TRACING FILED UNDER D-DT-15007 SHEET 07 OF 28 REVISION 2

CONTINUED FROM SHEET 10



CONTINUED FROM SHEET 10

NOTE:

1. A PERMANENT INPUT IS REQUIRED TO BLOCK AN EXTERNAL CLOSE.
2. THIS BYPASS LOGIC IS USED FOR THE SUPERVISORY DNP3 STATUS, THE HMI DISPLAY AND THE AUTOMATED REMOTE ARC BYPASS AND DIFF OUT OF SERVICE SELECTION LOGIC. NOTE THAT A 'G' ISOLATOR CONTACT MUST BE USED FOR THE 'ON' SELECTION AND A 'N' ISOLATOR CONTACT MUST BE USED FOR THE 'OFF' SELECTION.

ABB 132kV THREE POLE BREAKER LEGEND	
ITEM	DESCRIPTION
BD1	DENSITY SWITCH
BG1	BREAKER AUXILIARY CONTACTS
BT1	HEATER THERMOSTAT
BW1	SPRING LIMIT SWITCH
E1	HEATER (PERMANENTLY CONNECTED)
E2	HEATER (THERMOSTAT CONTROLLED)
F1	DIRECT ON LINE MOTOR STARTER MCB
F2	MINATURE CIRCUIT BREAKER (HEATER)
K1	AUXILIARY RELAY (SPRING LIMIT SWITCH)
K3	ANTI-PUMPING RELAY
K9	SF6 INTERLOCKING RELAY (CLOSE)
K10	SF6 INTERLOCKING RELAY (MAIN TRIP)
K19	AUXILIARY RELAY (THERMOSTAT)
K19.1 & K19.2	CURRENT RELAY (HEATER)
K25	SF6 AUXILIARY RELAY (SF6 LOW GAS ALARM)
KT1	TIME DELAYED RELAY (SPRING CHARGE FAILURE)
M1	SPRING REWIND MOTOR
S4	BREAKER ISOLATOR SWITCH (LOR)
SX11 - SX22	CONNECTION TERMINALS
SXY1 - SXY3	CONNECTION TERMINALS
X1	TERMINAL BLOCK FOR CONNECTIONS
X11 - X22	CONNECTION TERMINALS
XC1 - XC7	CONNECTION POINT
Y1	MAIN TRIP COIL
Y2	BACK-UP TRIP COIL
Y3	CLOSE COIL

SHT 28	ISOLATOR JB
SHT 27	CABLE BLOCK
SHT 26	LINE VT DIAGRAM
SHT 25	CT JB CABLING
SHT 24	CABLING DIAGRAM
SHT 23	CABLING DIAGRAM
SHT 22	CABLING DIAGRAM
SHT 21	REFERENCE DIAG
SHT 20	REFERENCE DIAG
SHT 19	REFERENCE DIAG
SHT 18	DISTUR RECORDER
SHT 17	SUP ALARMS KEY
SHT 16	SUP STATUS, CONT
SHT 15	REA & MEAS KEY
SHT 14	SPR REW, AC KEY
SHT 13	INDICAT, DC KEY
SHT 12	CLOSE DC KEY
SHT 11	BACK-UP DC KEY
SHT 10	BACK-UP DC KEY
SHT 09	BACK-UP DC KEY
SHT 08	TELEPROT DC KEY
SHT 07	MAIN DC KEY
SHT 06	MAIN DC KEY
SHT 05	VT SUPPLY KEY
SHT 04	AC KEY DIAGRAM
SHT 03	SINGLE LINE
SHT 02	LOGIC DIAGRAM
SHT 01	PANEL LAYOUT
DRG No.	REFERENCE DRAWINGS:

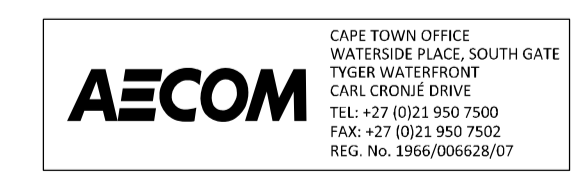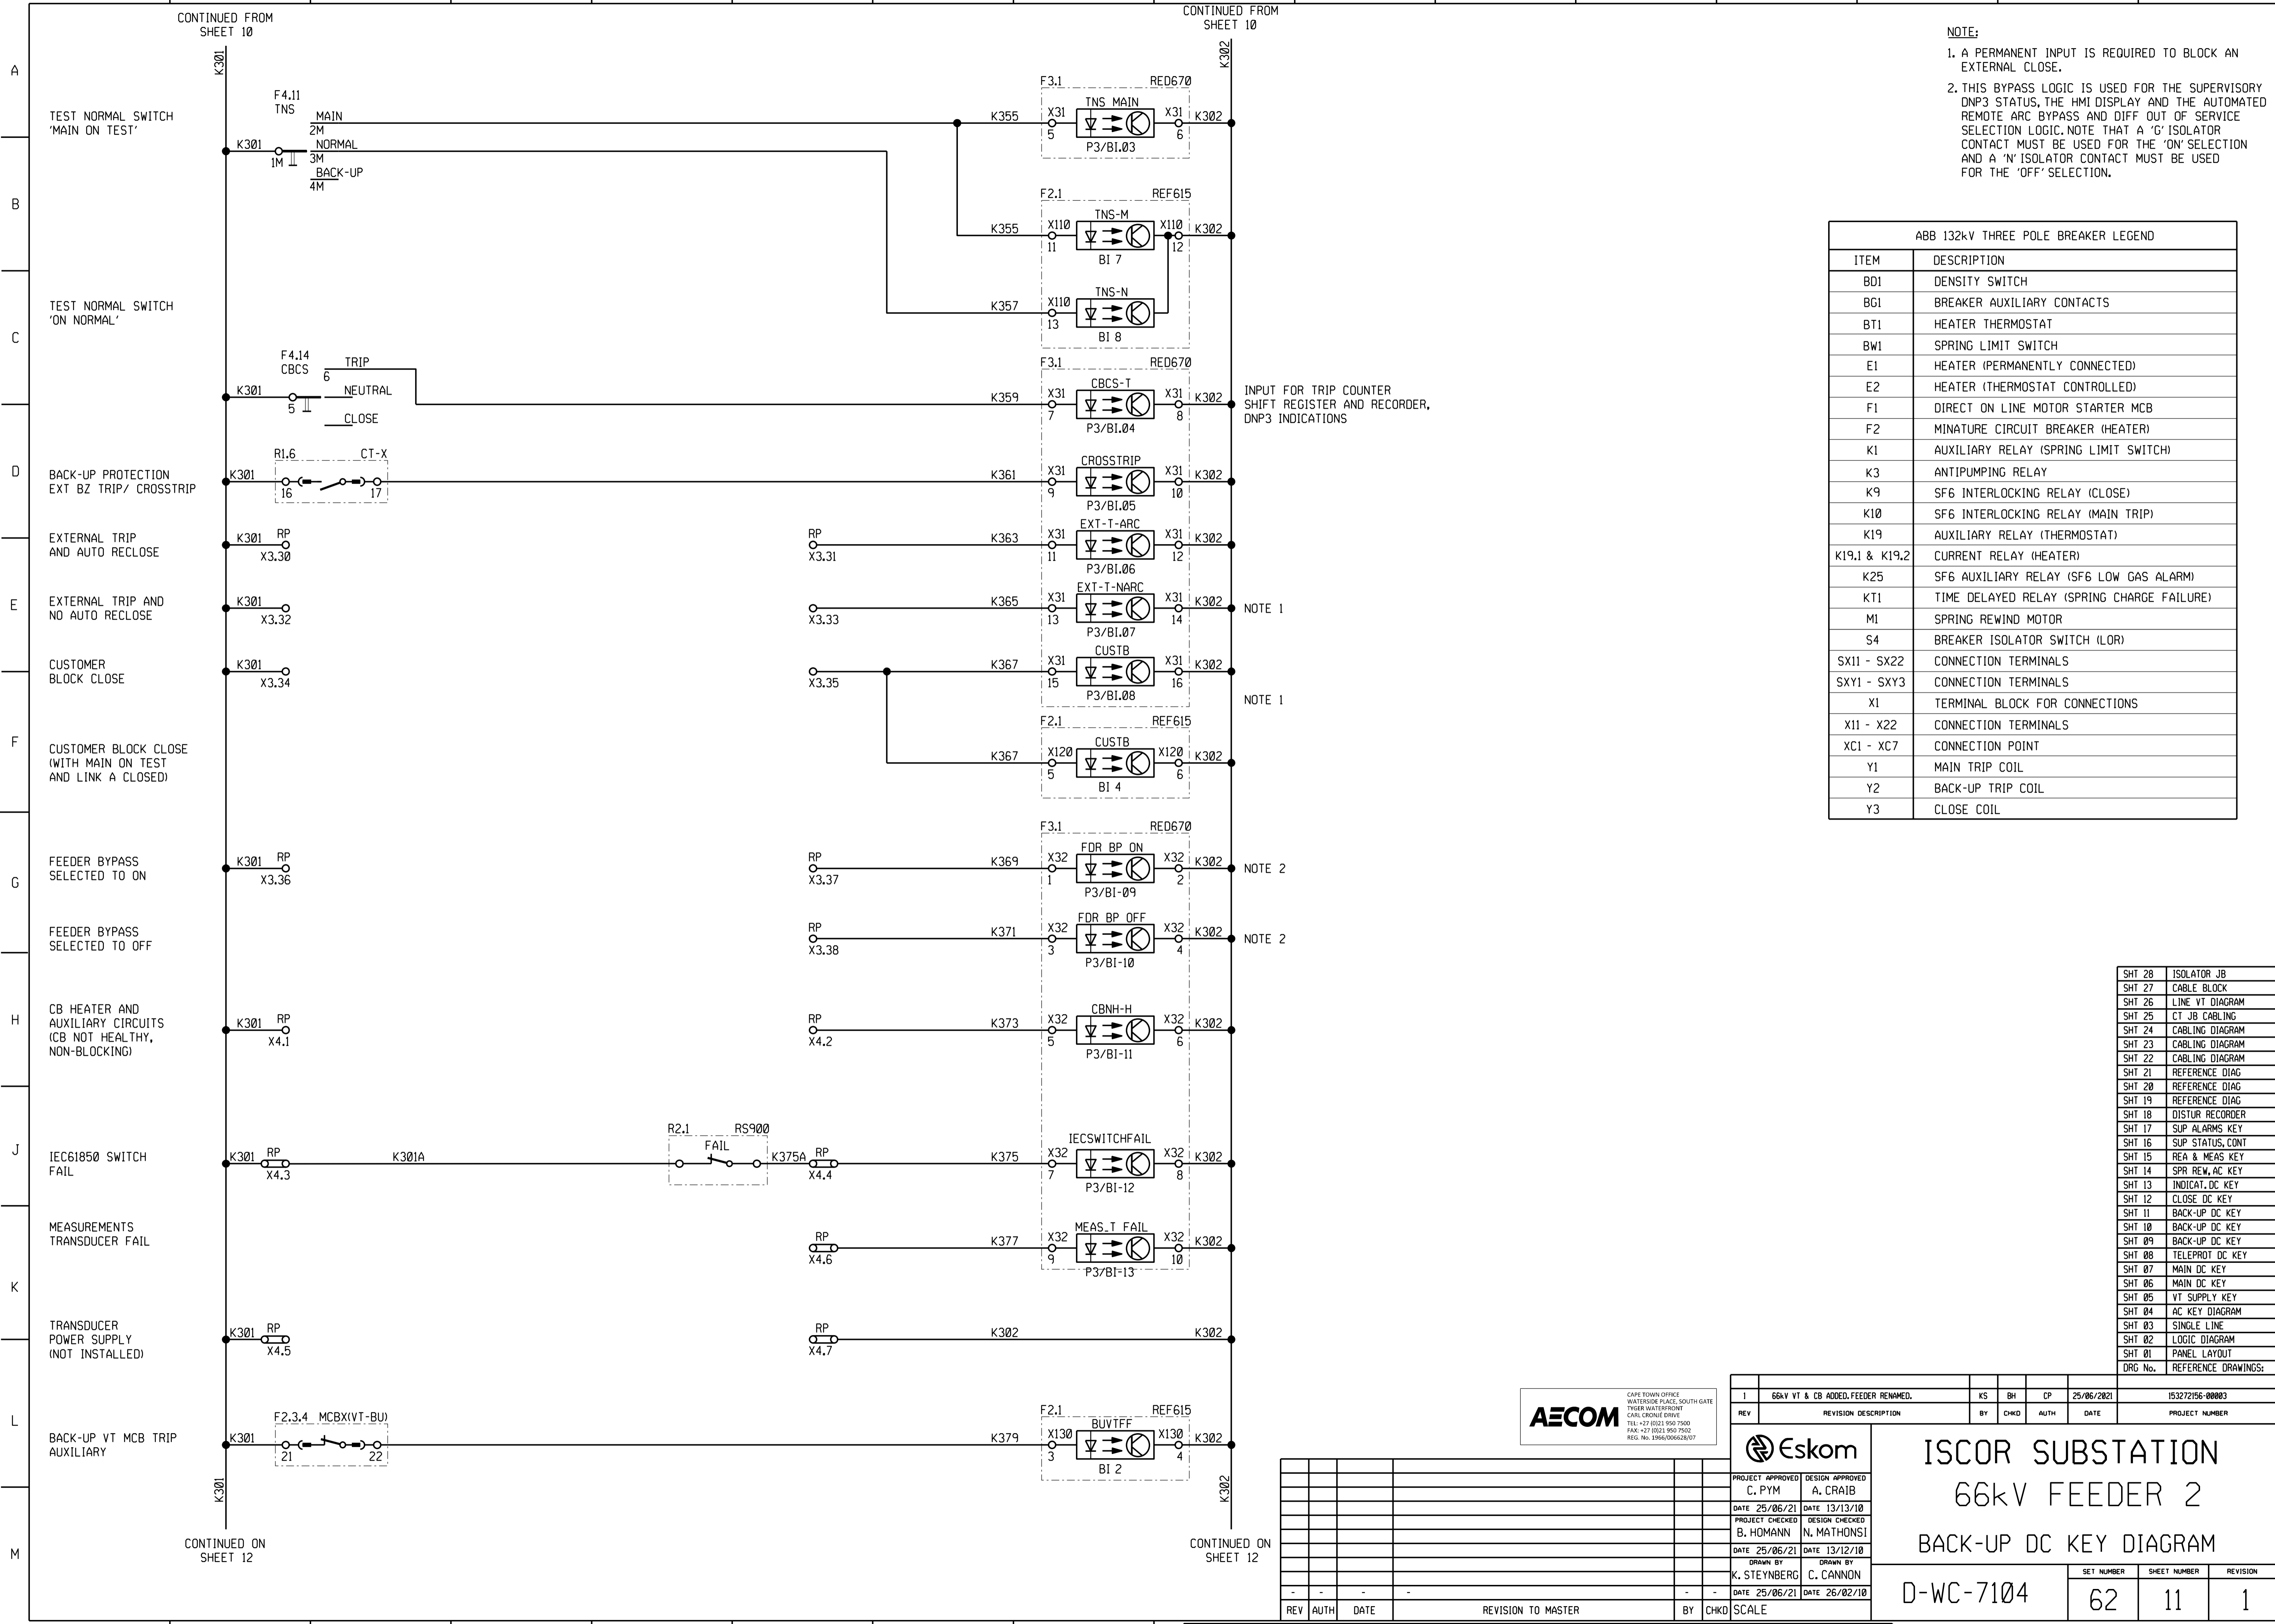


1	66kV VT & CB ADDED, FEEDER RENAMED.	KS	BH	CP	25/06/2021	153272156-00003
REV	REVISION DESCRIPTION	BY	CHKD	AUTH	DATE	PROJECT NUMBER

**ISCOR SUBSTATION
66kV FEEDER 2
BACK-UP DC KEY DIAGRAM**

DATE 25/06/21	DATE 13/13/10
PROJECT CHECKED	B. HOMANN
DESIGN CHECKED	N. MATHONSI
DATE 25/06/21	DATE 13/12/10
DRAWN BY	K. STEYNBERG
CHECKED BY	C. CANNON
DATE 25/06/21	DATE 26/02/10

REV	AUTH	DATE	REVISION TO MASTER	BY	CHKD	SCALE


MASTER TRACING FILED UNDER D-DT-15007 SHEET 11 OF 28 REVISION 2

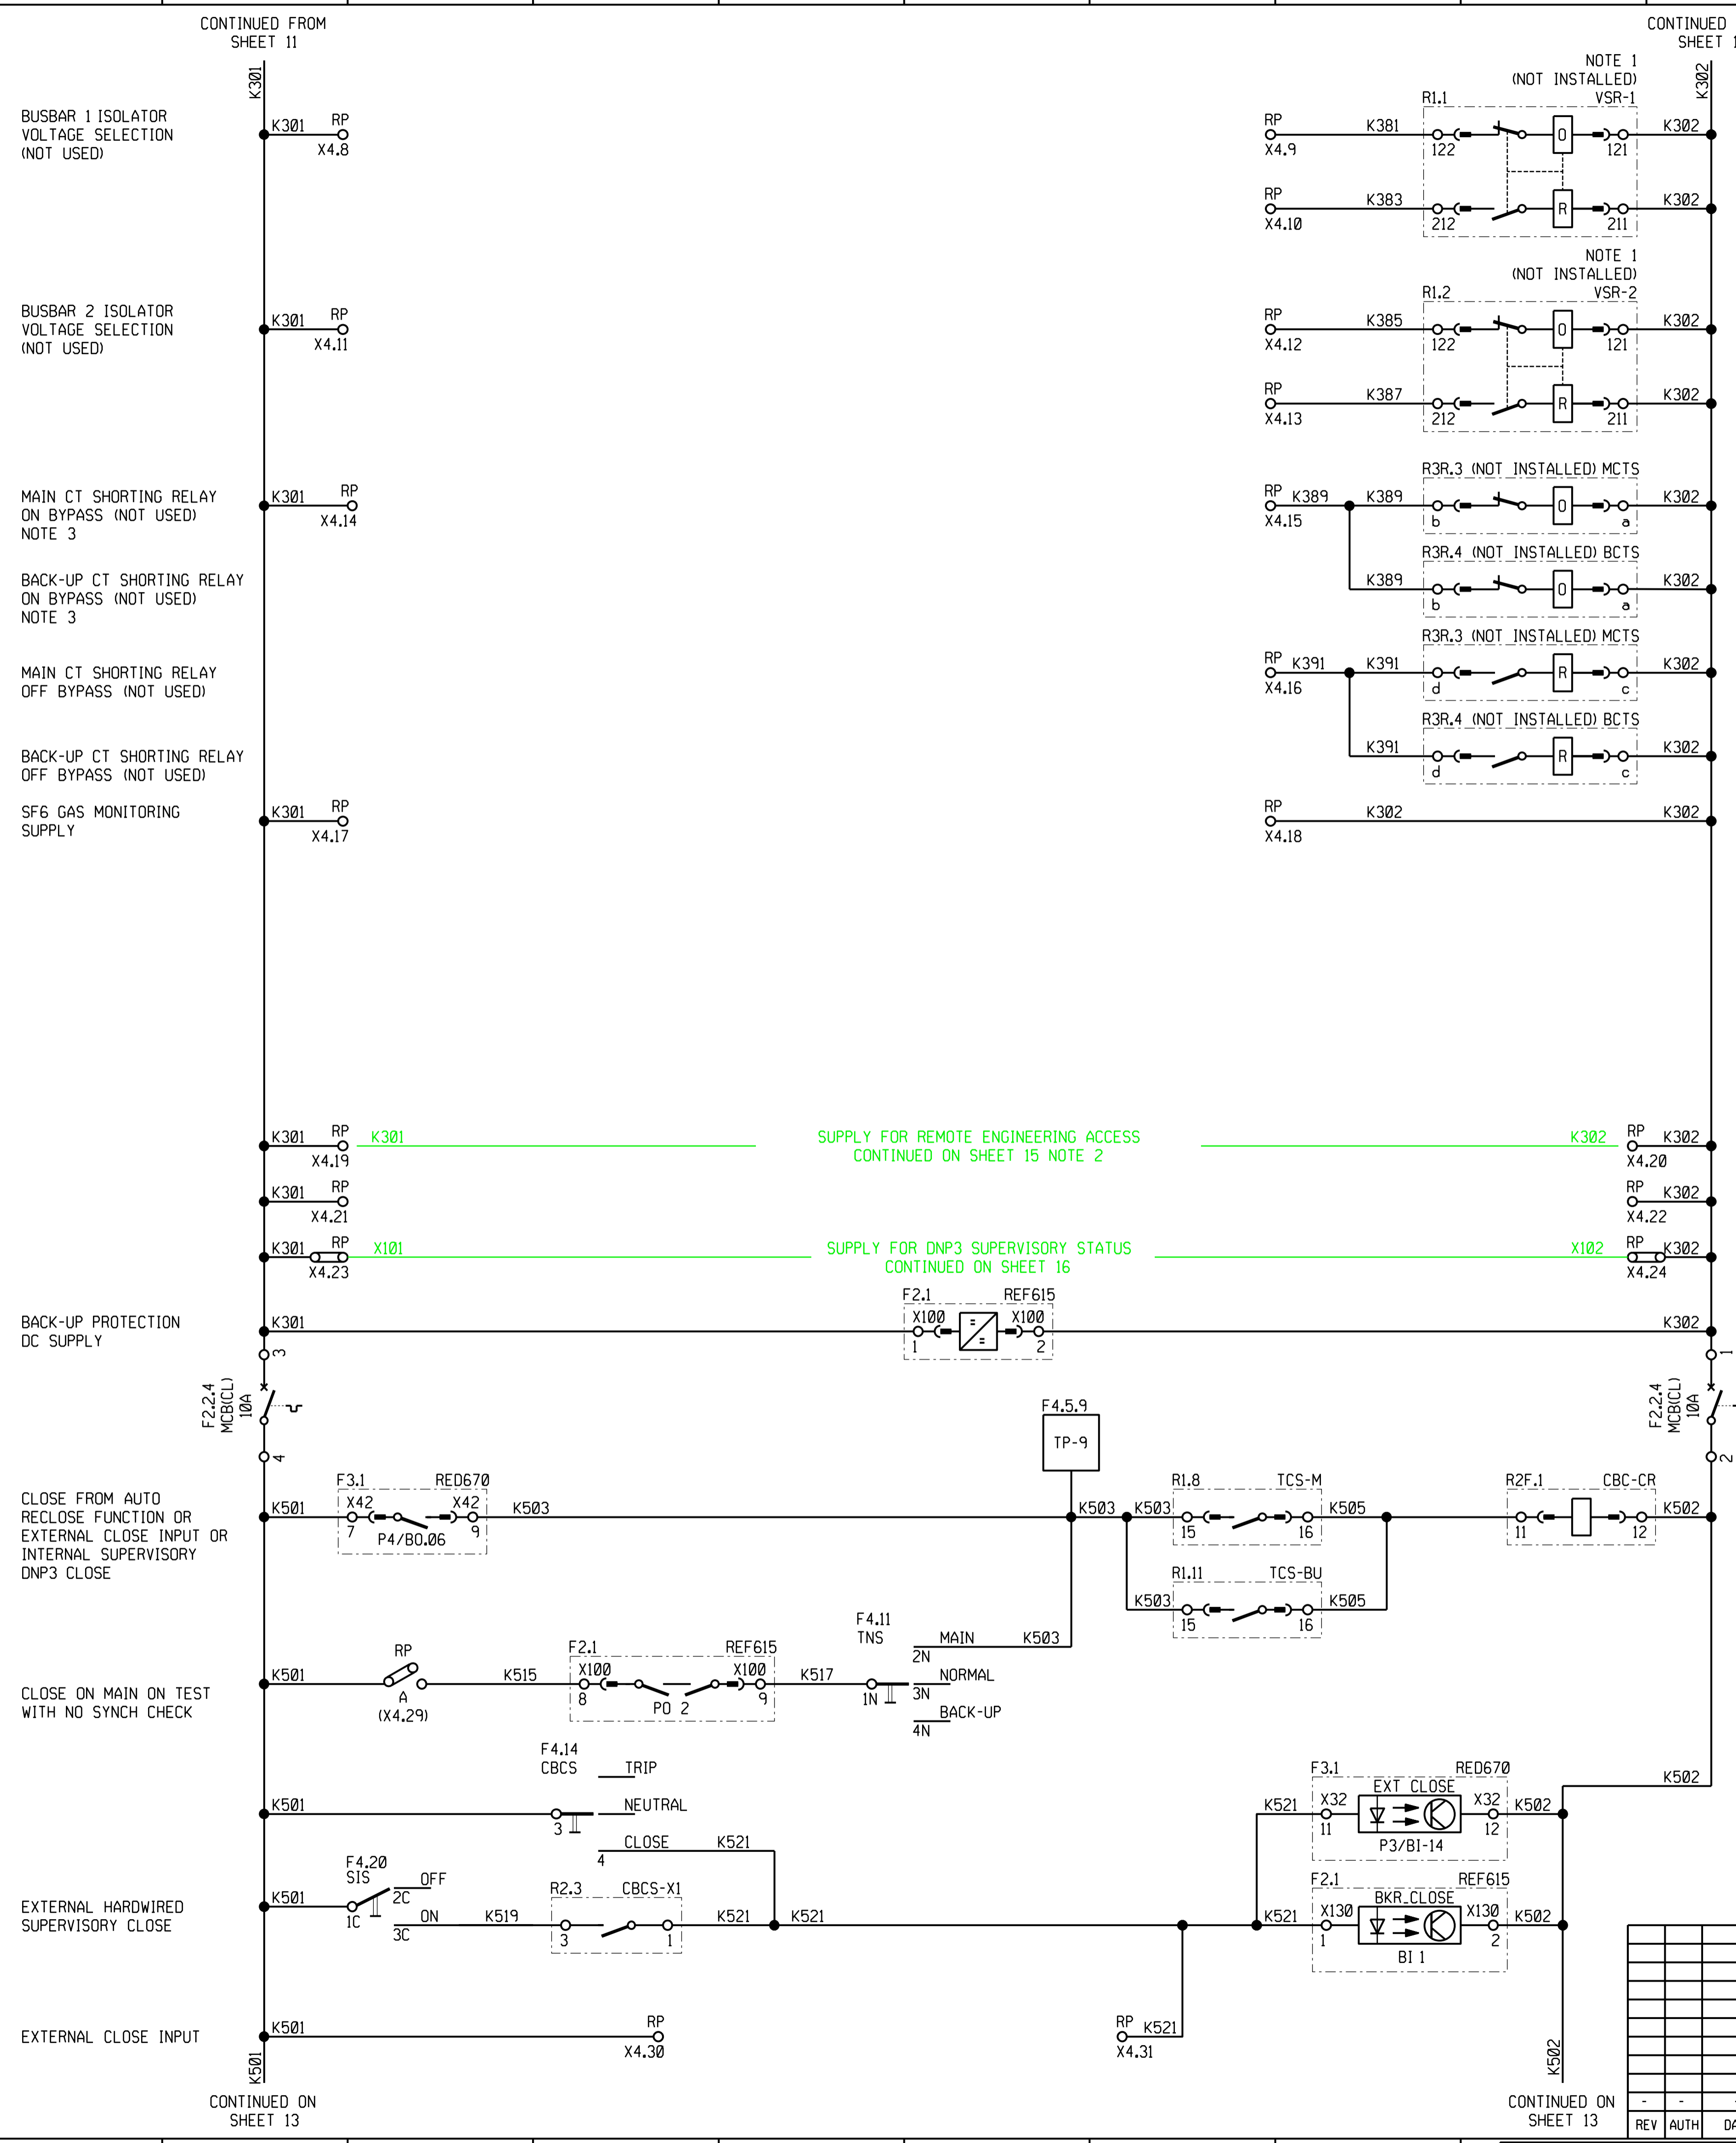

- NOTE:**
1. ALL OPTIONS ARE WIRED IN, ONLY THE OPTIONAL RELAYS NEED TO BE INSERTED TO SELECT THE SPECIFIC OPTION.
 2. ESKOM TO INSTALL JUMPERS TO BACKPLATE MODULES ON SITE IF THE OPTION IS ORDERED.
 3. FOR CT SHORTING ON BYPASS, 'GS' CONTACTS AND 'N' CONTACTS OF THE ISOLATOR MUST BE USED.

ABB 132kV THREE POLE BREAKER LEGEND	
ITEM	DESCRIPTION
BD1	DENSITY SWITCH
BG1	BREAKER AUXILIARY CONTACTS
BT1	HEATER THERMOSTAT
BW1	SPRING LIMIT SWITCH
E1	HEATER (PERMANENTLY CONNECTED)
E2	HEATER (THERMOSTAT CONTROLLED)
F1	DIRECT ON LINE MOTOR STARTER MCB
F2	MINIATURE CIRCUIT BREAKER (HEATER)
K1	AUXILIARY RELAY (SPRING LIMIT SWITCH)
K3	ANTI-PUMPING RELAY
K9	SF6 INTERLOCKING RELAY (CLOSE)
K10	SF6 INTERLOCKING RELAY (MAIN TRIP)
K19	AUXILIARY RELAY (THERMOSTAT)
K19.1 & K19.2	CURRENT RELAY (HEATER)
K25	SF6 AUXILIARY RELAY (SF6 LOW GAS ALARM)
KT1	TIME DELAYED RELAY (SPRING CHARGE FAILURE)
M1	SPRING REWIND MOTOR
S4	BREAKER ISOLATOR SWITCH (LOR)
SX11 - SX22	CONNECTION TERMINALS
SXY1 - SXY3	CONNECTION TERMINALS
X1	TERMINAL BLOCK FOR CONNECTIONS
X11 - X22	CONNECTION TERMINALS
XC1 - XC7	CONNECTION POINT
Y1	MAIN TRIP COIL
Y2	BACK-UP TRIP COIL
Y3	CLOSE COIL

SHT 28	ISOLATOR JB
SHT 27	CABLE BLOCK
SHT 26	LINE VT DIAGRAM
SHT 25	CT JB CABLING
SHT 24	CABLING DIAGRAM
SHT 23	CABLING DIAGRAM
SHT 22	CABLING DIAGRAM
SHT 21	REFERENCE DIAG
SHT 20	REFERENCE DIAG
SHT 19	REFERENCE DIAG
SHT 18	DISTUR RECORDER
SHT 17	SUP ALARMS KEY
SHT 16	SUP STATUS, CONT
SHT 15	REA & MEAS KEY
SHT 14	SPR REW, AC KEY
SHT 13	INDICAT, DC KEY
SHT 12	CLOSE DC KEY
SHT 11	BACK-UP DC KEY
SHT 10	BACK-UP DC KEY
SHT 09	BACK-UP DC KEY
SHT 08	TELEPROT DC KEY
SHT 07	MAIN DC KEY
SHT 06	MAIN DC KEY
SHT 05	VT SUPPLY KEY
SHT 04	AC KEY DIAGRAM
SHT 03	SINGLE LINE
SHT 02	LOGIC DIAGRAM
SHT 01	PANEL LAYOUT
DRG No.	REFERENCE DRAWINGS:

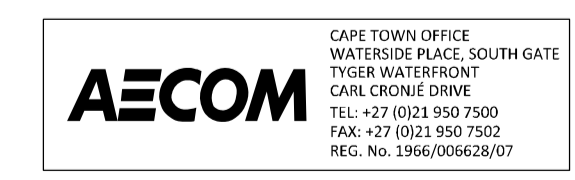

1	66kV VT & CB ADDED, FEEDER RENAMED.	KS	BH	CP	25/06/2021	153272156-00003
REV	REVISION DESCRIPTION	BY	CHKD	AUTH	DATE	PROJECT NUMBER

ISCOR SUBSTATION

66kV FEEDER 2

CLOSE DC KEY DIAGRAM

PROJECT APPROVED C. PYM	DESIGN APPROVED A. CRAIB
DATE 25/06/21	DATE 13/13/10
PROJECT CHECKED B. HOMANN	DESIGN CHECKED N. MATHONSI
DATE 25/06/21	DATE 13/12/10
DRAWN BY K. STEYNBERG	DRAWN BY C. CANNON
DATE 25/06/21	DATE 26/02/10

D-WC-7104

SET NUMBER	SHEET NUMBER	REVISION
62	12	1

PANEL TYPE DESIGNATION 4FZD-3920 SIZE GRID/TITLE A1L


REV	AUTH	DATE	REVISION TO MASTER	BY	CHKD	SCALE

MASTER TRACING FILED UNDER D-DT-15007 SHEET 12 OF 28 REVISION 2



REMOTE ENGINEERING ACCESS IEC61850

CONTINUED FROM SHEET 12, F3

CONTINUED FROM SHEET 12, F12

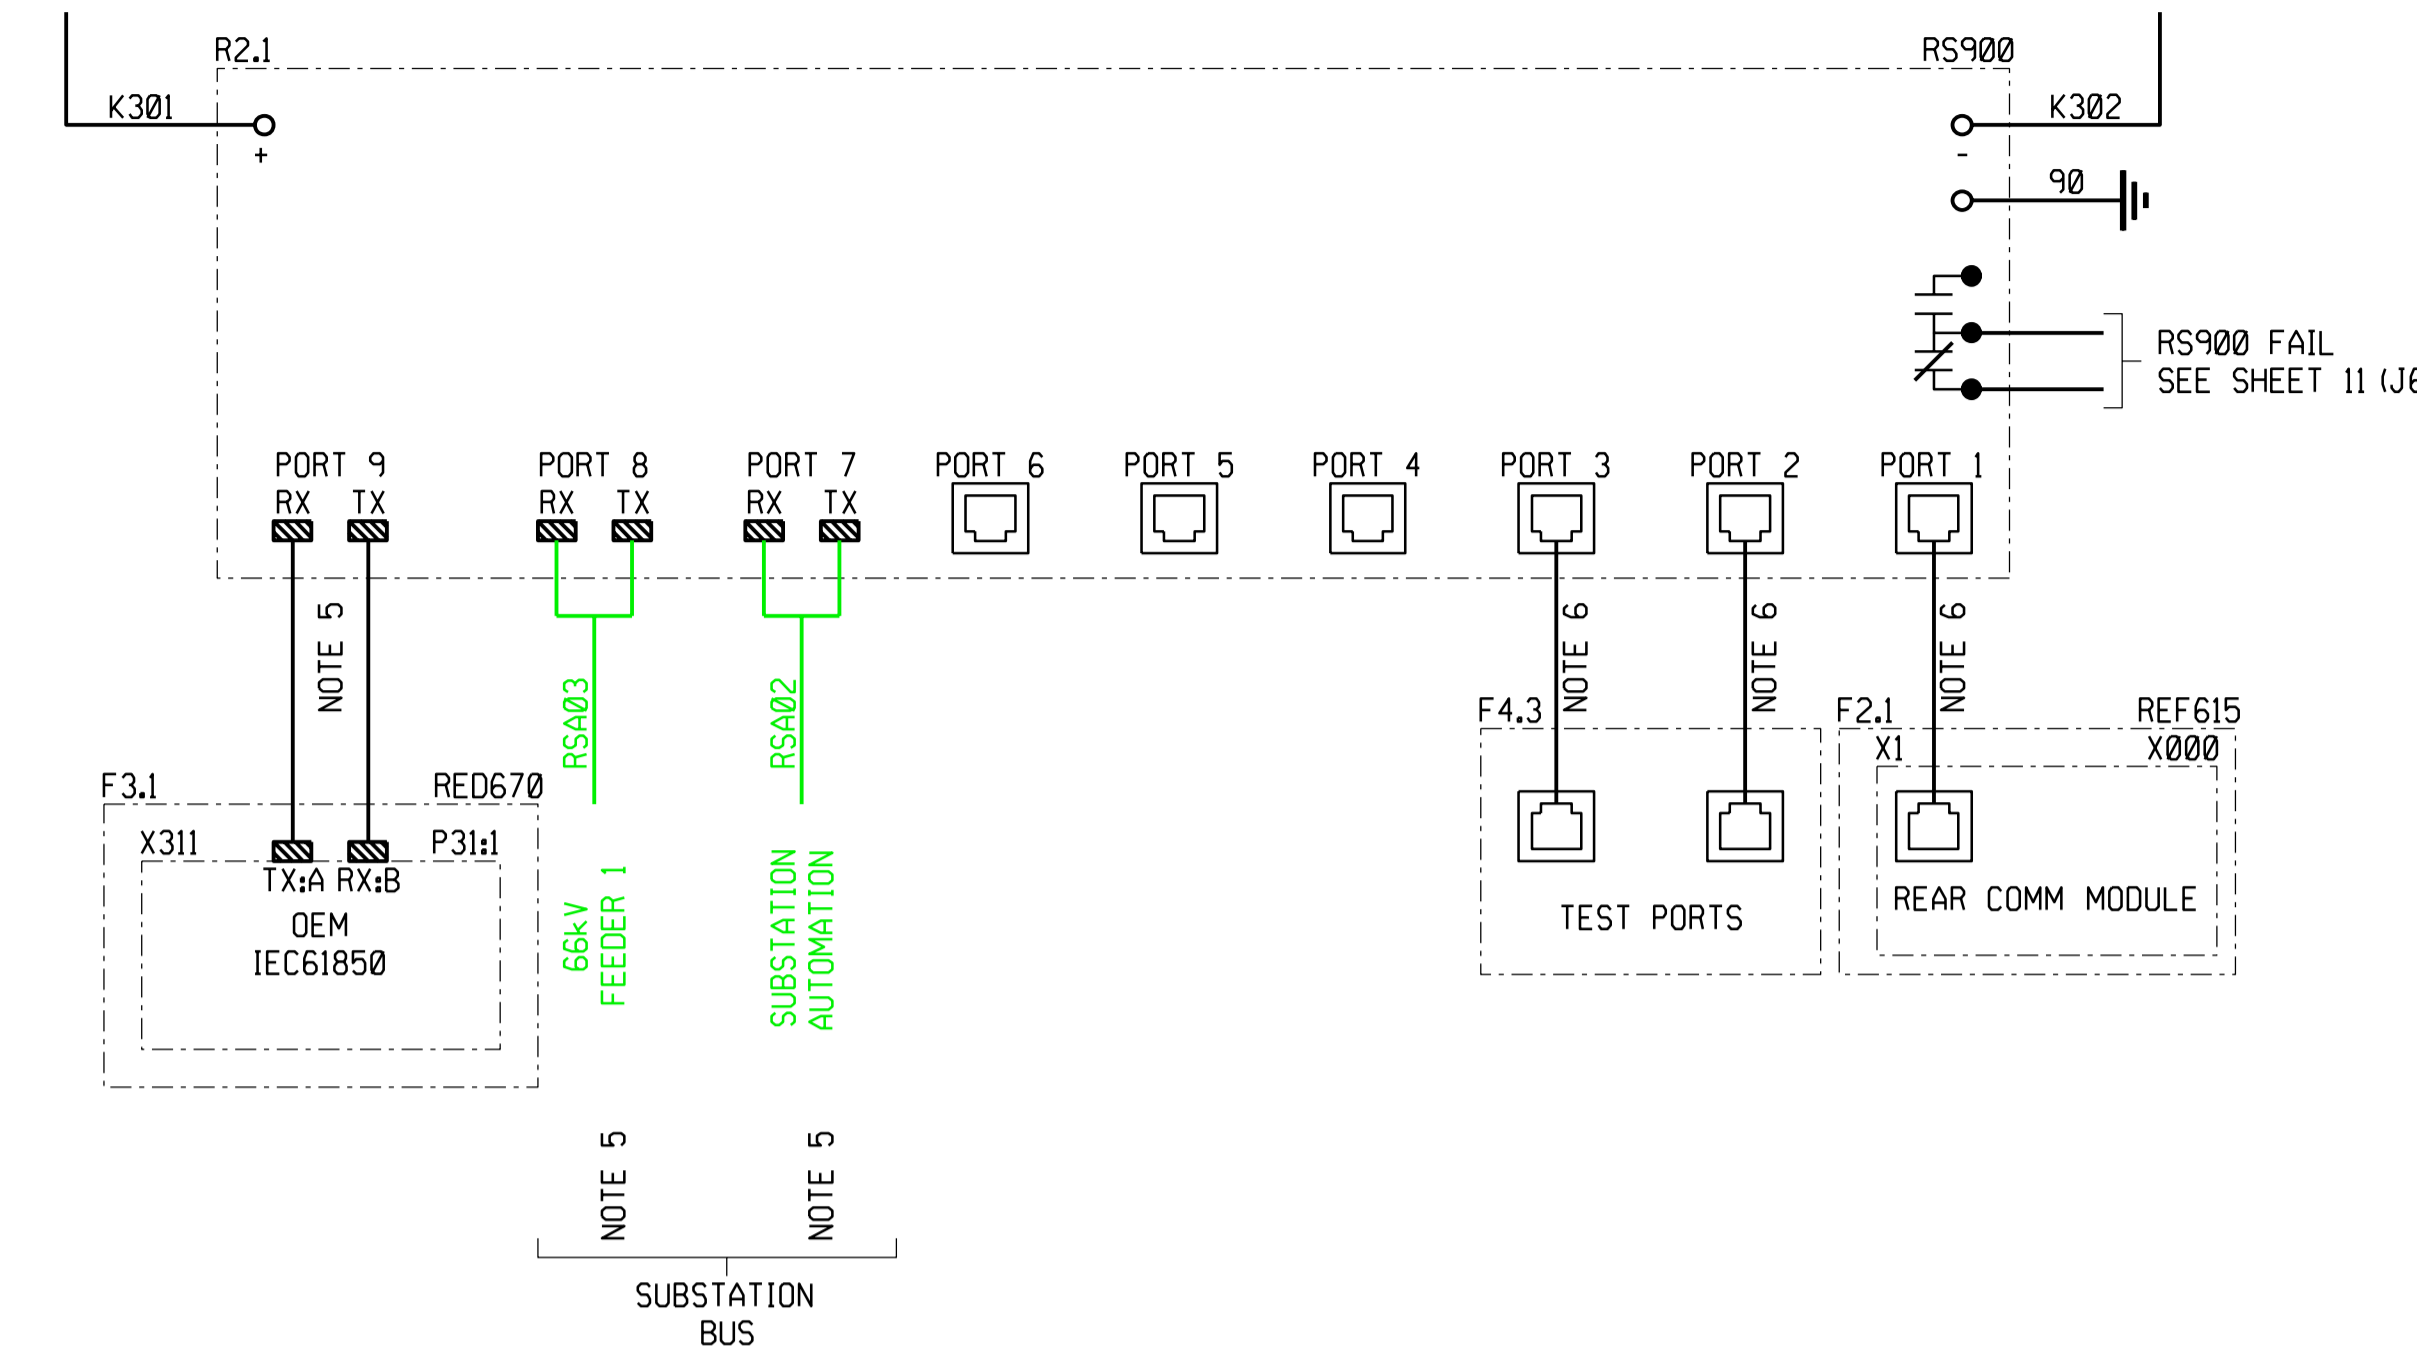

TIME SYNCHRONISATION NOTE 4

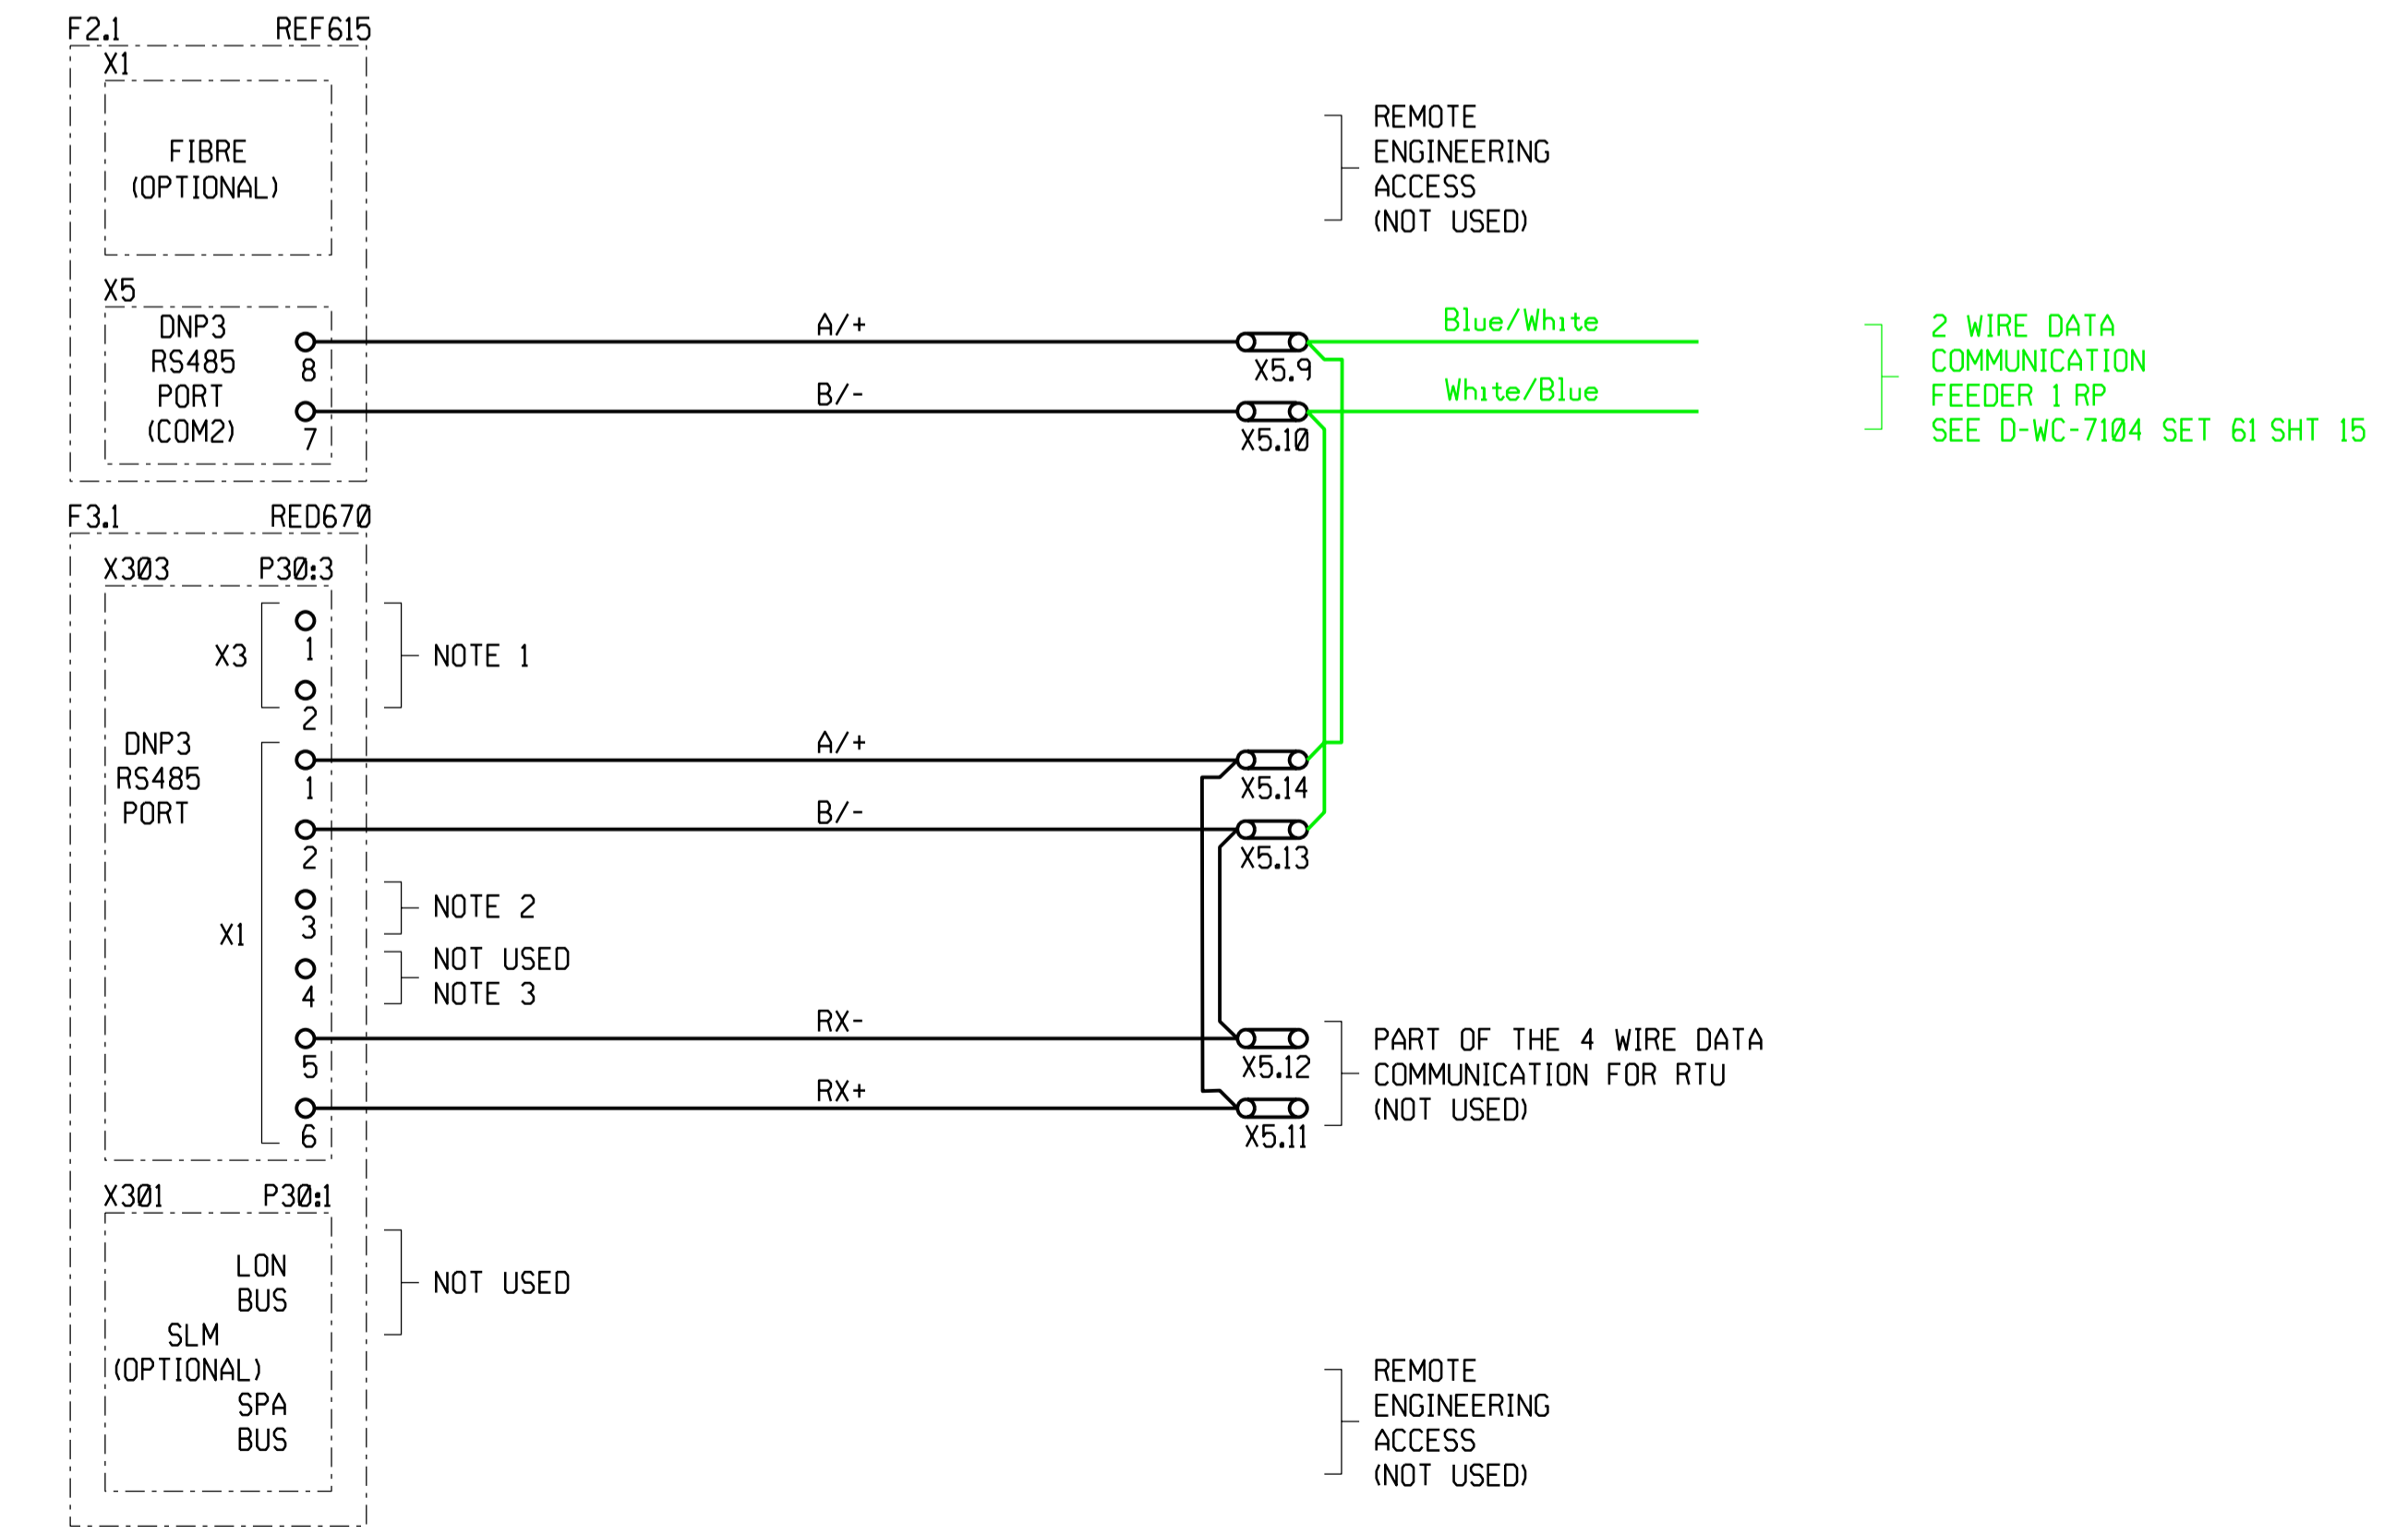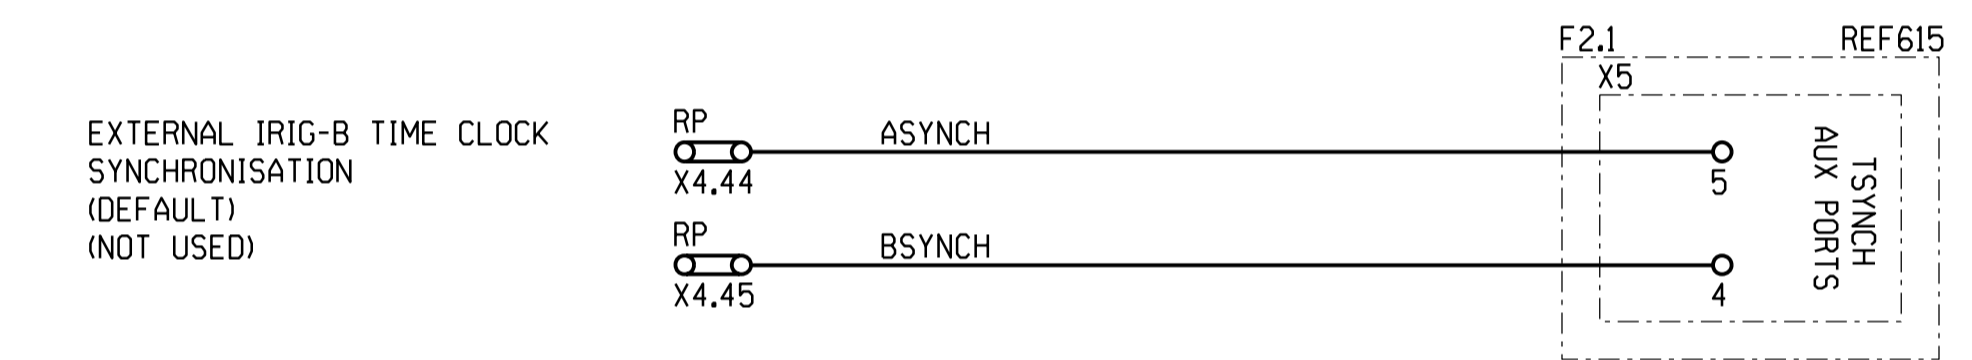

- NOTE:**
- X3 OF THE RED670 IS THE SOFT GROUND CONNECTOR. IT MAY BE UNCONNECTED OR IT CAN BE CONNECTED TO THE GND WITH AN RC NET PARALLEL WITH A MOV.
 - TERMINATION RESISTOR FOR TRANSMITTER AND RECEIVER. ESKOM PERSONNEL TO CONNECT TO A/+ IF USED.
 - TERMINATION RESISTOR FOR RECEIVER IN THE 4 WIRE CASE (CONNECT TO RX+).
 - IF ACCURATE TIMING IS STILL REQUIRED BUT NEITHER OF THE GPS TIMING OPTIONS ARE CHOSEN, THEN USE SNTP TIMING VIA THE IEC61850 OPTIONAL CONNECTION (NOT AS ACCURATE AS GPS TIMING).
 - 100 BASE FX MULTIMODE 1300nm (GLASS), ST CONNECTORS
 - STANDARD RJ45 PORT 100 BASE TX

SHT 28	ISOLATOR JB
SHT 27	CABLE BLOCK
SHT 26	LINE VT DIAGRAM
SHT 25	CT JB CABLING
SHT 24	CABLING DIAGRAM
SHT 23	CABLING DIAGRAM
SHT 22	CABLING DIAGRAM
SHT 21	REFERENCE DIAG
SHT 20	REFERENCE DIAG
SHT 19	REFERENCE DIAG
SHT 18	DISTUR RECORDER
SHT 17	SUP ALARMS KEY
SHT 16	SUP STATUS, CONT
SHT 15	REA & MEAS KEY
SHT 14	SPR REW, AC KEY
SHT 13	INDICAT, DC KEY
SHT 12	CLOSE DC KEY
SHT 11	BACK-UP DC KEY
SHT 10	BACK-UP DC KEY
SHT 09	BACK-UP DC KEY
SHT 08	TELEPROT DC KEY
SHT 07	MAIN DC KEY
SHT 06	MAIN DC KEY
SHT 05	VT SUPPLY KEY
SHT 04	AC KEY DIAGRAM
SHT 03	SINGLE LINE
SHT 02	LOGIC DIAGRAM
SHT 01	PANEL LAYOUT
DRG No.	REFERENCE DRAWINGS:

1	66kV VT & CB ADDED, FEEDER RENAMED.	KS	BH	CP	25/06/2021	153272156-00003
REV	REVISION DESCRIPTION	BY	CHKD	AUTH	DATE	PROJECT NUMBER


Eskom

ISCOR SUBSTATION
66kV FEEDER 2
REA AND MEASUREMENTS KEY DIAG

D-WC-7104 62 15 1


SET NUMBER SHEET NUMBER REVISION

PROJECT APPROVED	DESIGN APPROVED					
C. PYM	A. CRAIB					
DATE 25/06/21	DATE 13/13/10					
PROJECT CHECKED	DESIGN CHECKED					
B. HOMANN	N. MATHONSI					
DATE 25/06/21	DATE 13/12/10					
DRAWN BY	DRAWN BY					
K. STEYNBERG	C. CANNON					
DATE 25/06/21	DATE 26/02/10					
REV	AUTH	DATE	REVISION TO MASTER	BY	CHKD	SCALE

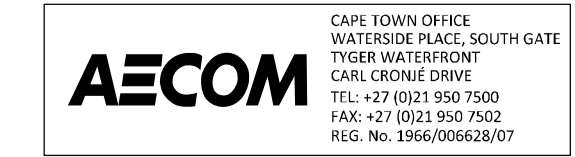


SUPERVISORY STATUS 48V DC (DNP3 OPTIONAL & HMI DISPLAY)

SUPERVISORY STATUS (HARDWIRED OPTIONAL)

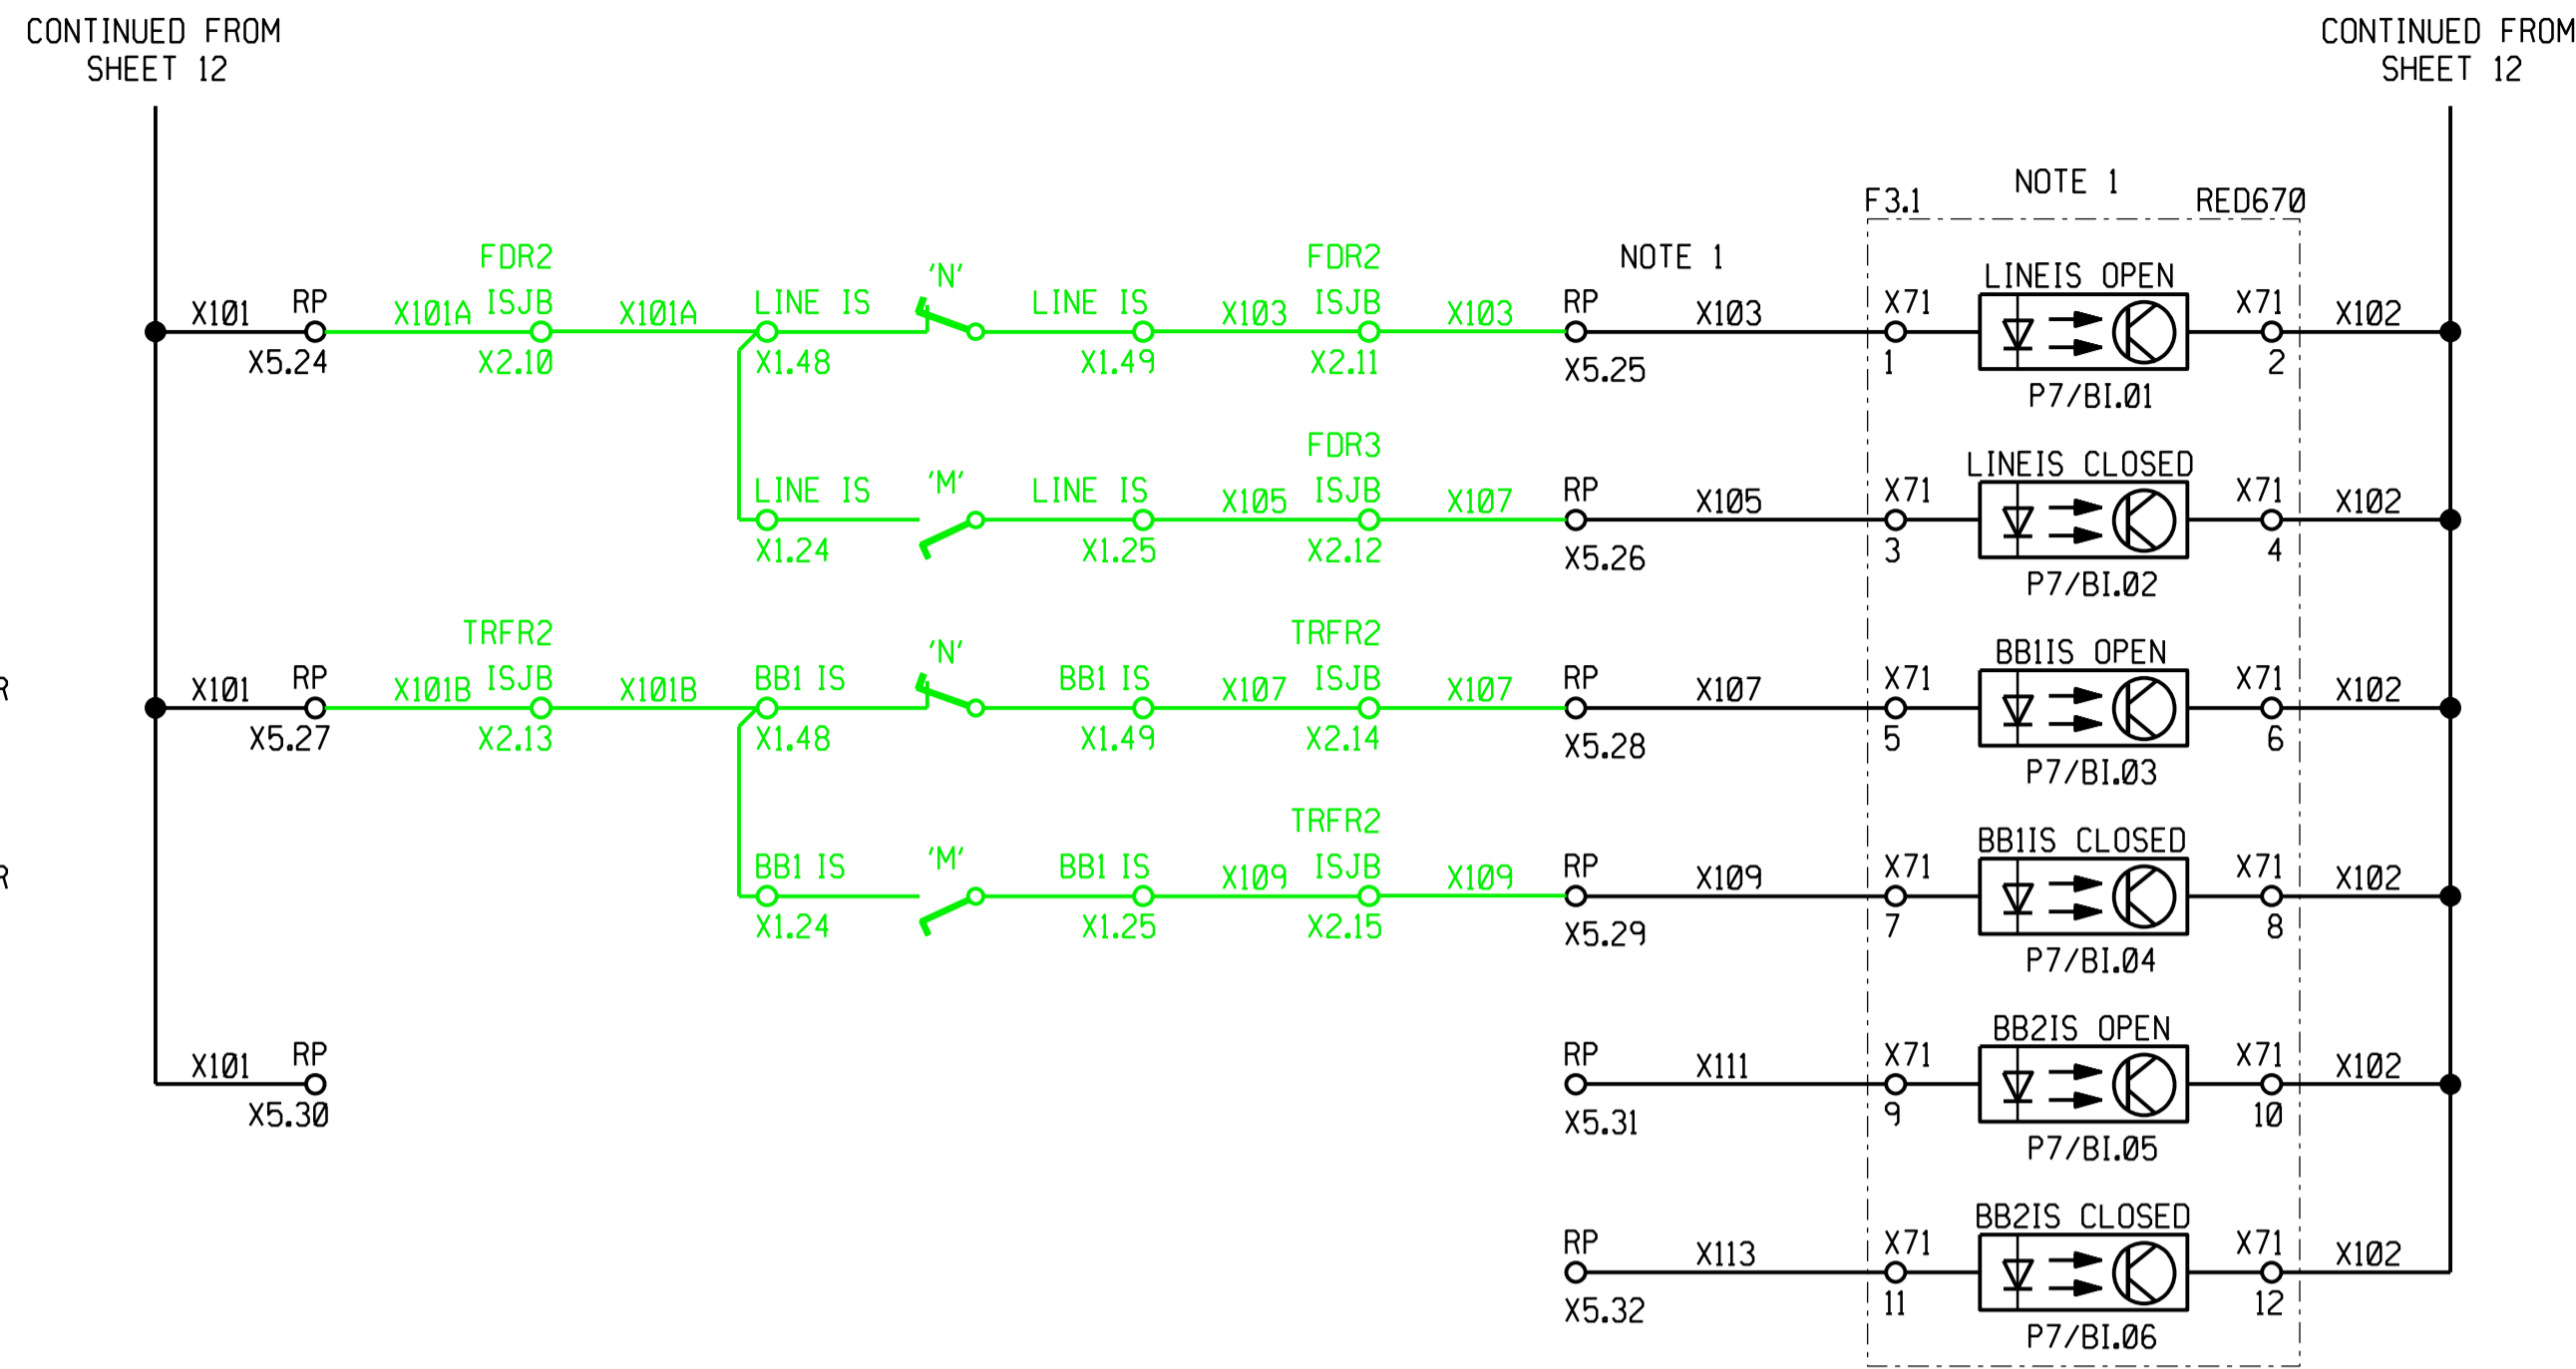

- RP X7.11
- RP X7.12
- RP X7.13
- RP X7.14
- RP X7.15
- RP X7.16
- RP X7.17
- RP X7.18
- RP X7.19
- RP X7.20
- RP X7.21
- RP X7.22
- RP X7.23
- RP X7.24

SUPERVISORY CONTROLS 48V DC (HARDWIRED OPTIONAL)

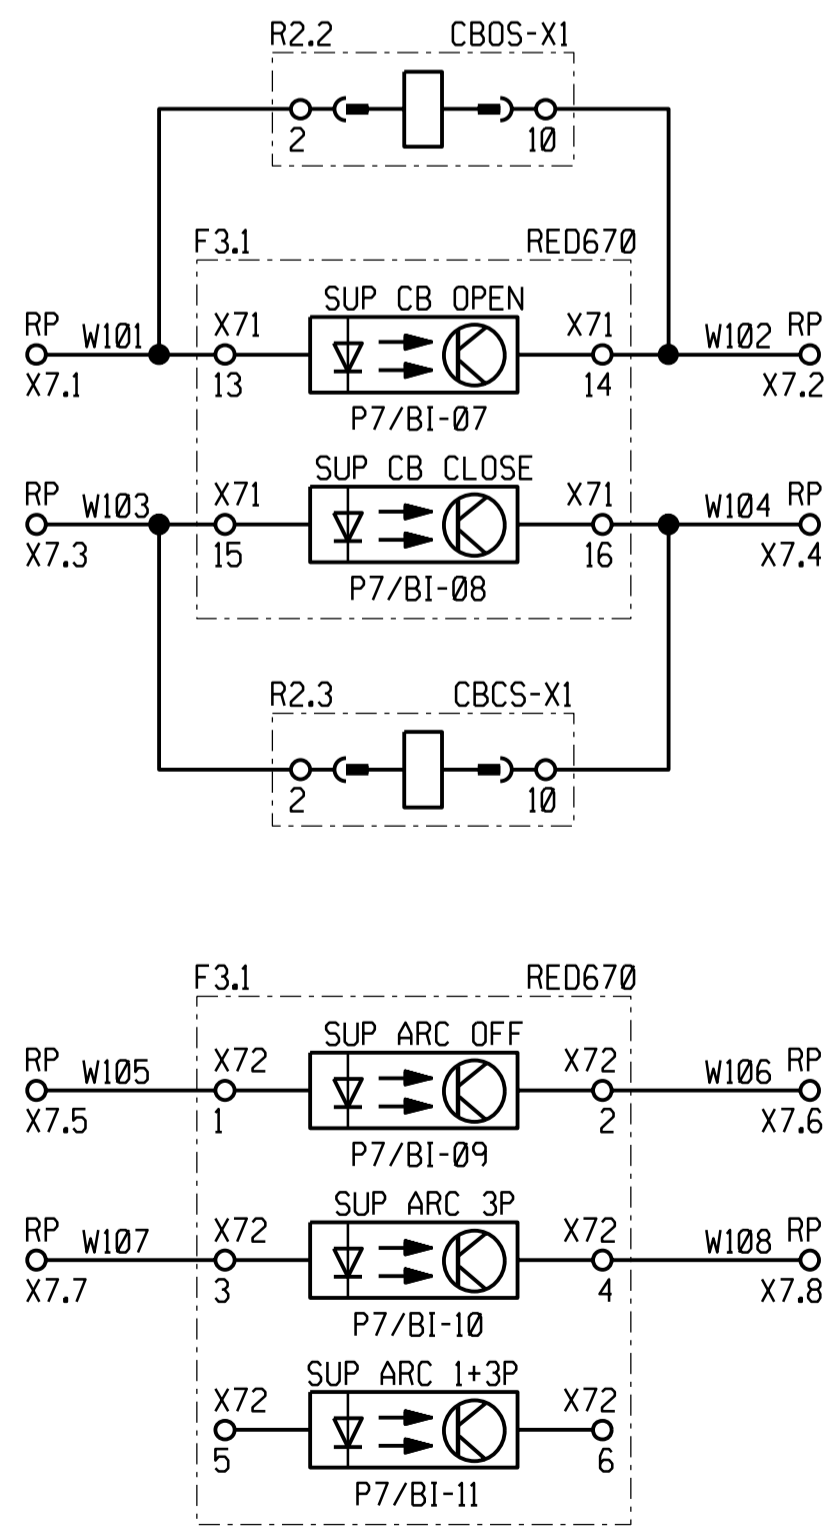

NOTE:
 1. THESE INDICATIONS MUST ALWAYS BE WIRED IN BY ESKOM.
 THE RED670 IED HMI GRAPHICAL DISPLAY EDITOR SINGLE LINE DIAGRAM (SLD) SHOULD BE ALTERED BY ESKOM COMMISSIONING STAFF TO REFLECT THE BUSBAR ARRANGEMENT ON SITE - IN PCM600, GO TO 'GRAPHIC DISPLAY EDITOR'.
 COMMISSIONING STAFF MUST ALSO DEFAULT THE HMI DISPLAY TO THE SLD BY SELECTING ON THE RED670 HMI MAIN MENU, SETTINGS, GENERAL SETTINGS, HMI, SCREEN, DEFAULT SCREEN = SINGLE LINE DIAGRAM.
 NOTE THAT THE BYPASS ISOLATOR STATUS MAY BE FOUND ON THE BACK-UP DC KEY DIAGRAM.

SHT 28	ISOLATOR JB
SHT 27	CABLE BLOCK
SHT 26	LINE VT DIAGRAM
SHT 25	CT JB CABLING
SHT 24	CABLING DIAGRAM
SHT 23	CABLING DIAGRAM
SHT 22	CABLING DIAGRAM
SHT 21	REFERENCE DIAG
SHT 20	REFERENCE DIAG
SHT 19	REFERENCE DIAG
SHT 18	DISTUR RECORDER
SHT 17	SUP ALARMS KEY
SHT 16	SUP STATUS, CONT
SHT 15	REA & MEAS KEY
SHT 14	SPR REW, AC KEY
SHT 13	INDICAT, DC KEY
SHT 12	CLOSE DC KEY
SHT 11	BACK-UP DC KEY
SHT 10	BACK-UP DC KEY
SHT 09	BACK-UP DC KEY
SHT 08	TELEPROT DC KEY
SHT 07	MAIN DC KEY
SHT 06	MAIN DC KEY
SHT 05	VT SUPPLY KEY
SHT 04	AC KEY DIAGRAM
SHT 03	SINGLE LINE
SHT 02	LOGIC DIAGRAM
SHT 01	PANEL LAYOUT
DRG No.	REFERENCE DRAWINGS:


1	66kV VT & CB ADDED, FEEDER RENAMED.	KS	BH	CP	25/06/2021	153272156-00003
REV	REVISION DESCRIPTION	BY	CHKD	AUTH	DATE	PROJECT NUMBER
<p align="center">ISCOR SUBSTATION 66kV FEEDER 2 SUPERVIS. STATUS & CONTROL KEY</p>						
D-WC-7104			SET NUMBER	SHEET NUMBER	REVISION	
			62	16	1	
PANEL TYPE DESIGNATION 4FZD-3920						




REV	AUTH	DATE	REVISION TO MASTER	BY	CHKD	SCALE

HARDWIRED SUPERVISORY ALARMS (OPTIONAL)


HARDWIRED SUPERVISORY ALARMS (OPTIONAL)

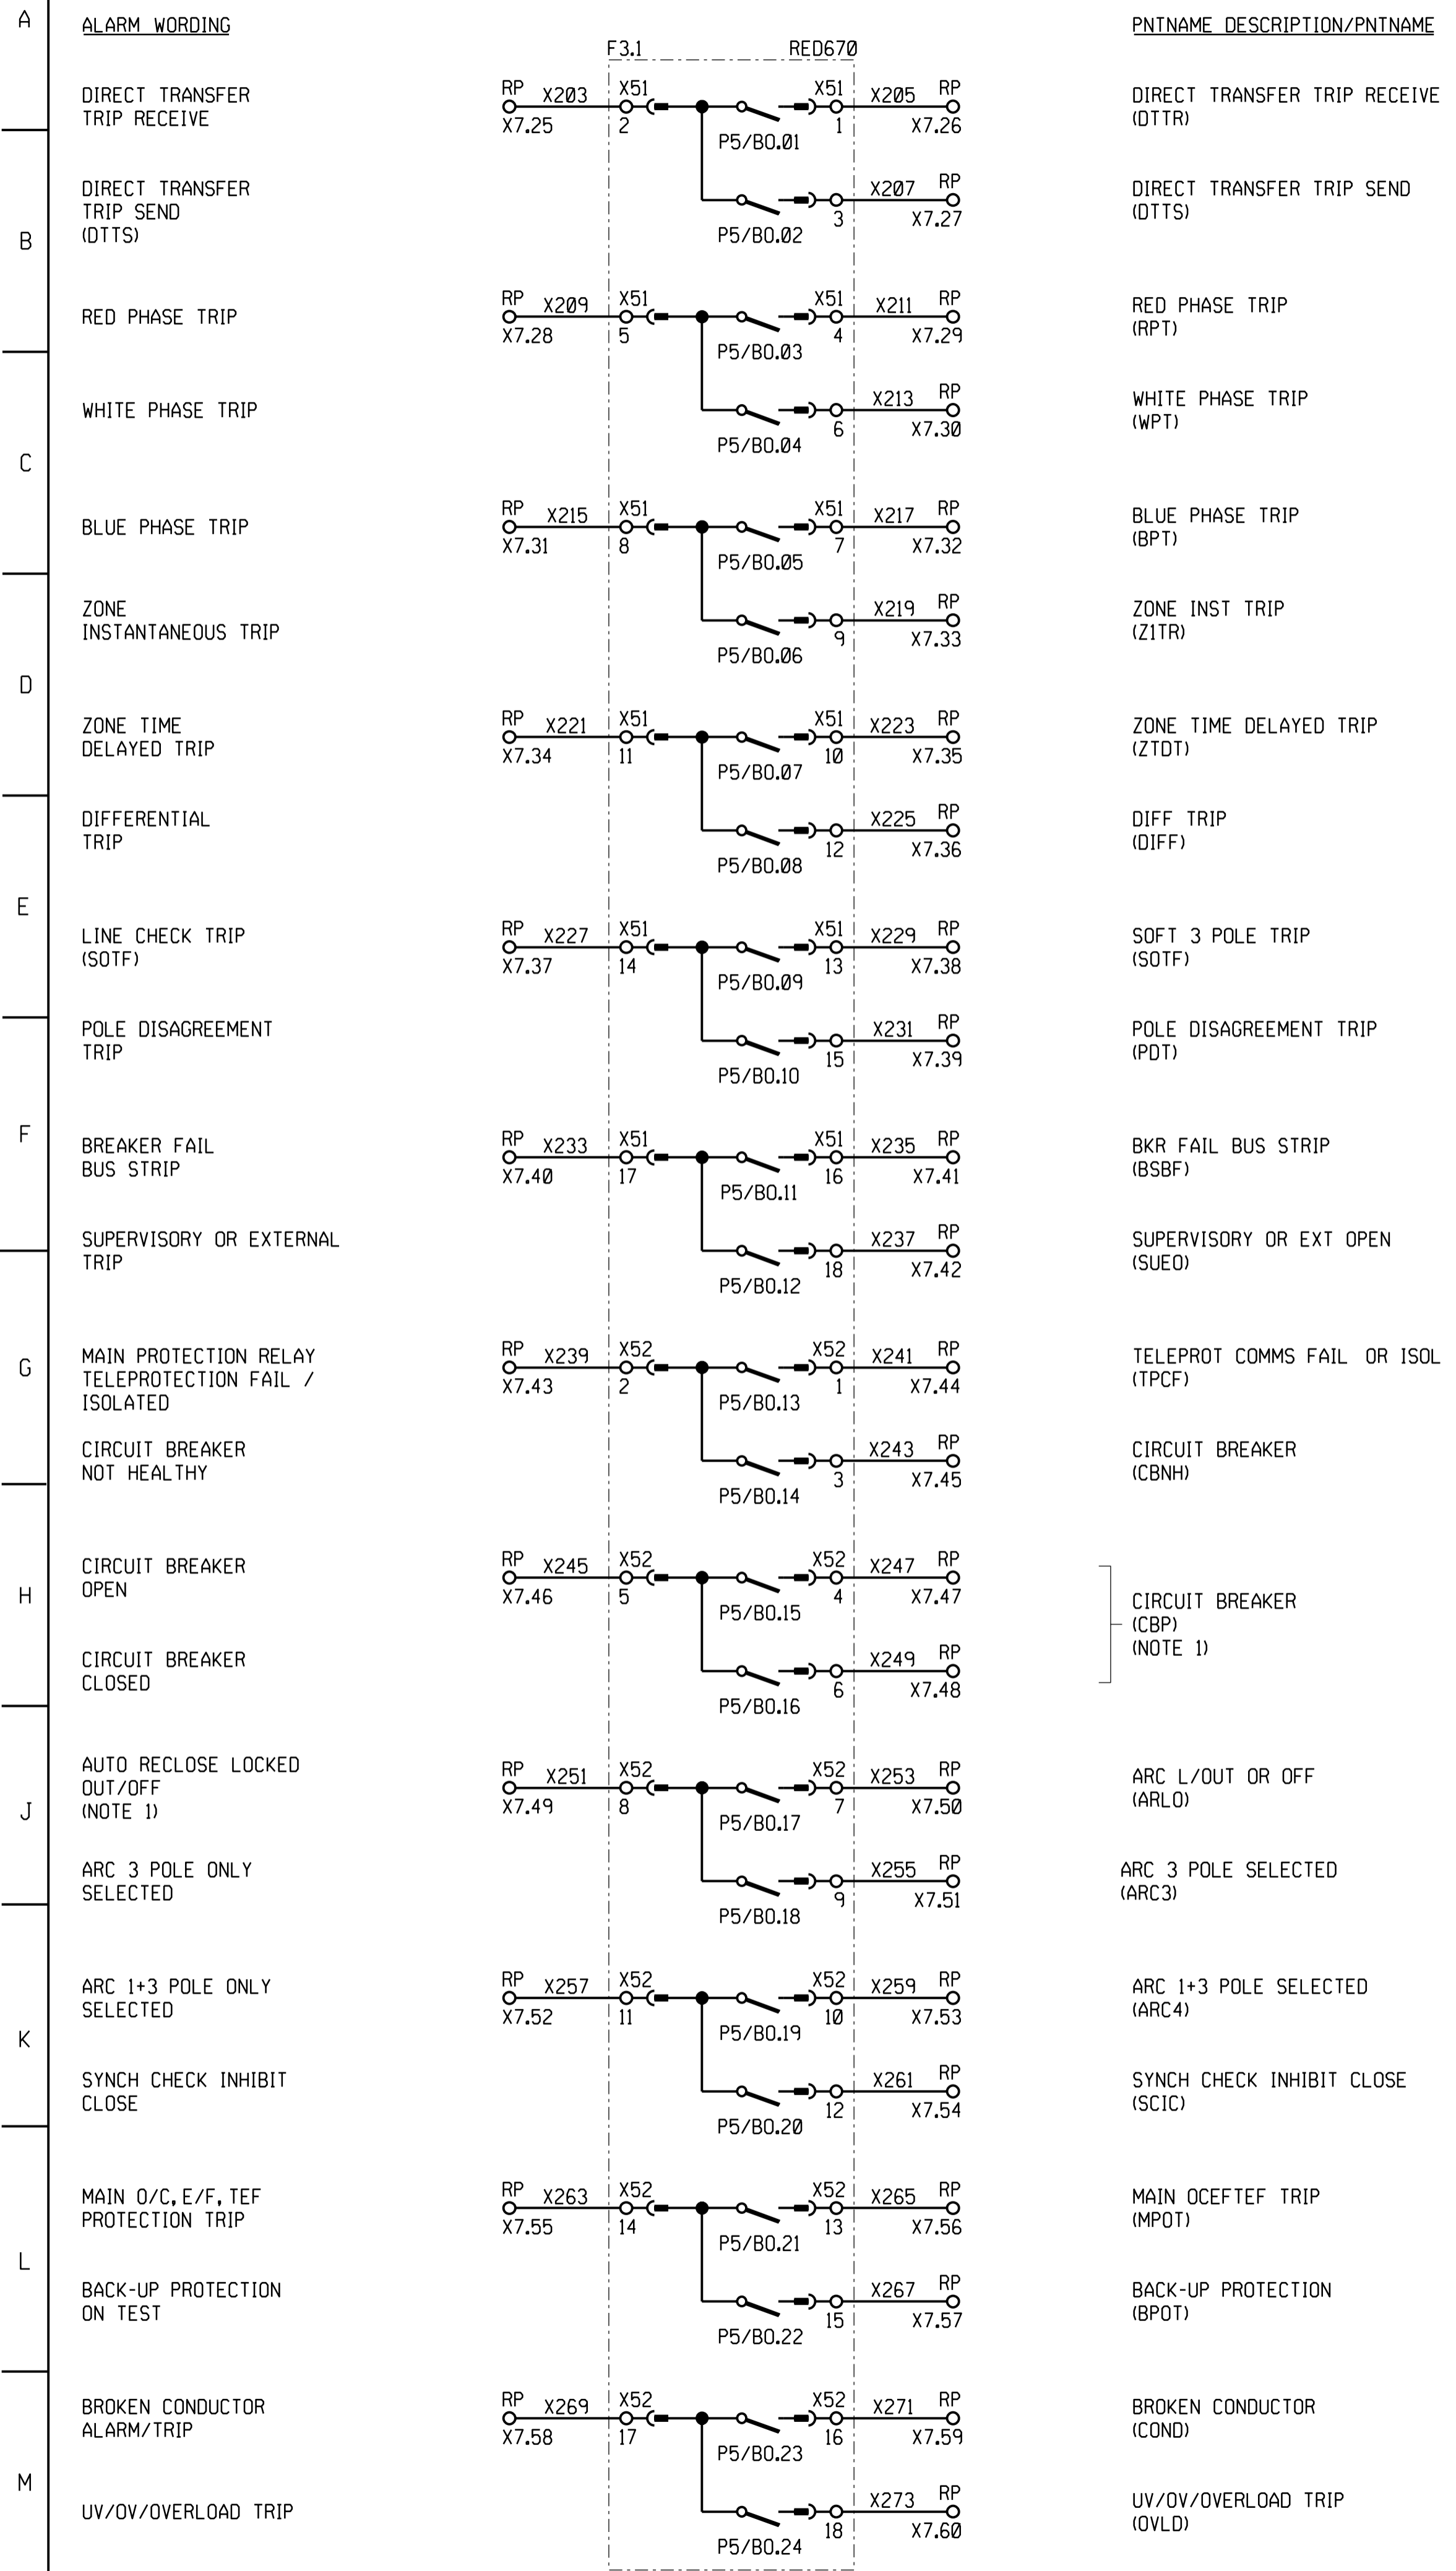

HARDWIRED SUPERVISORY ALARMS (PROGRAMMABLE, OPTIONAL)

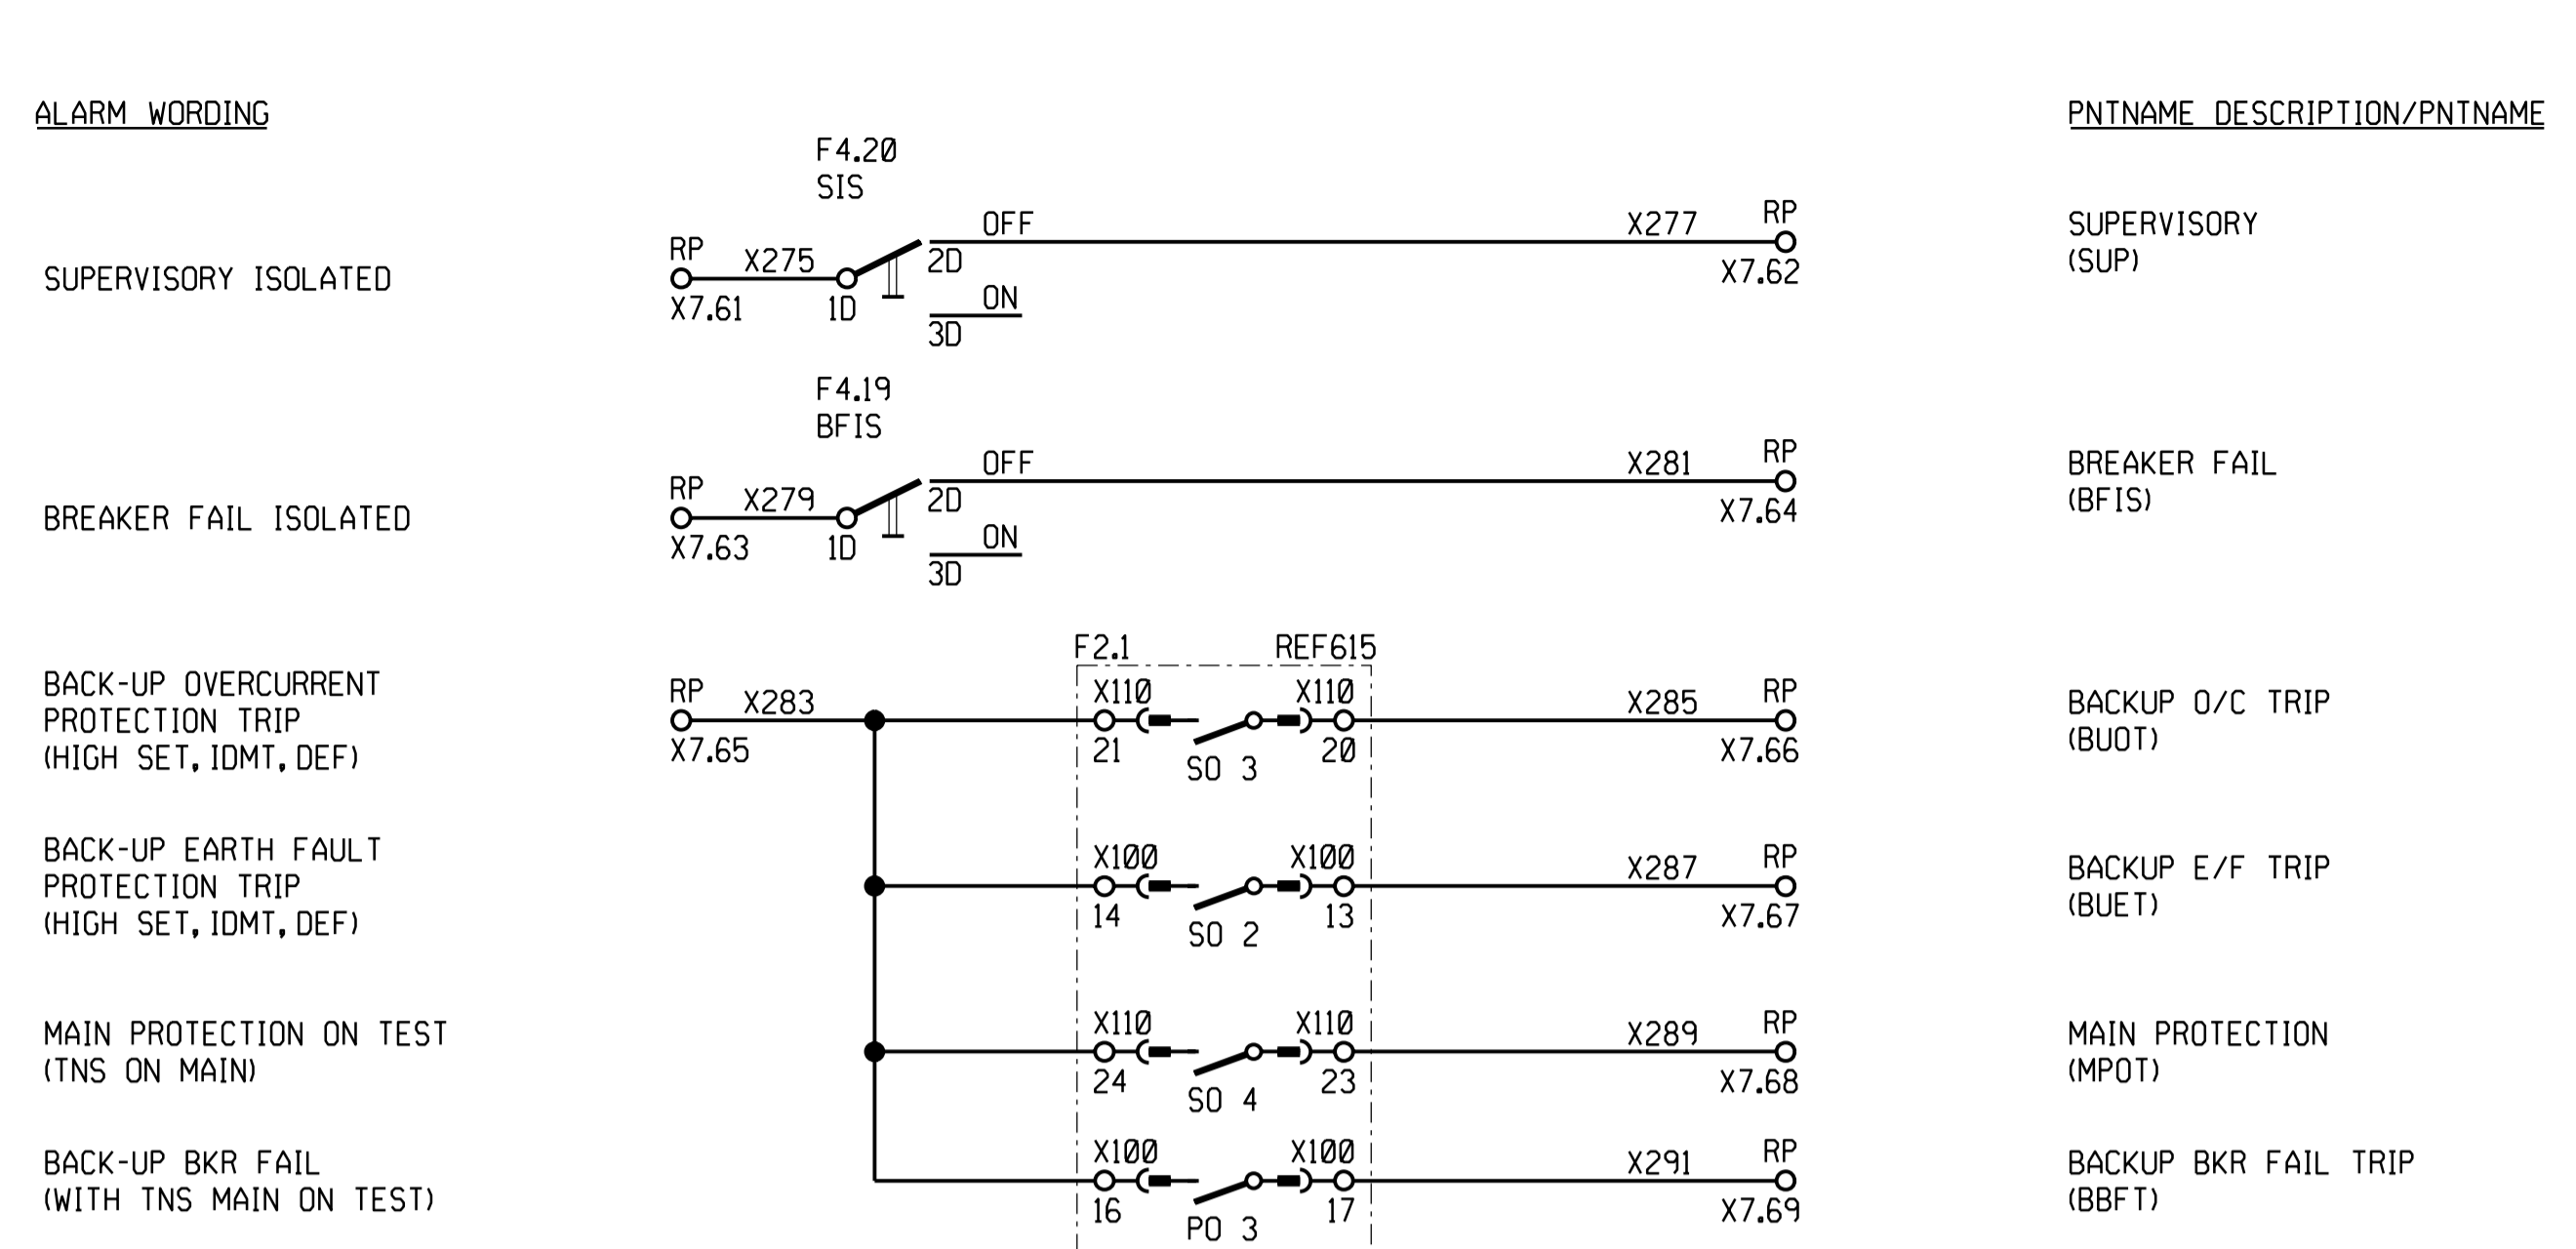

NOTE:
ITEMS INDICATED ABOVE ARE PROVIDED AS AN ORDERING OPTION.
ITEMS INDICATED BELOW ARE PROVIDED AS A DEFAULT.

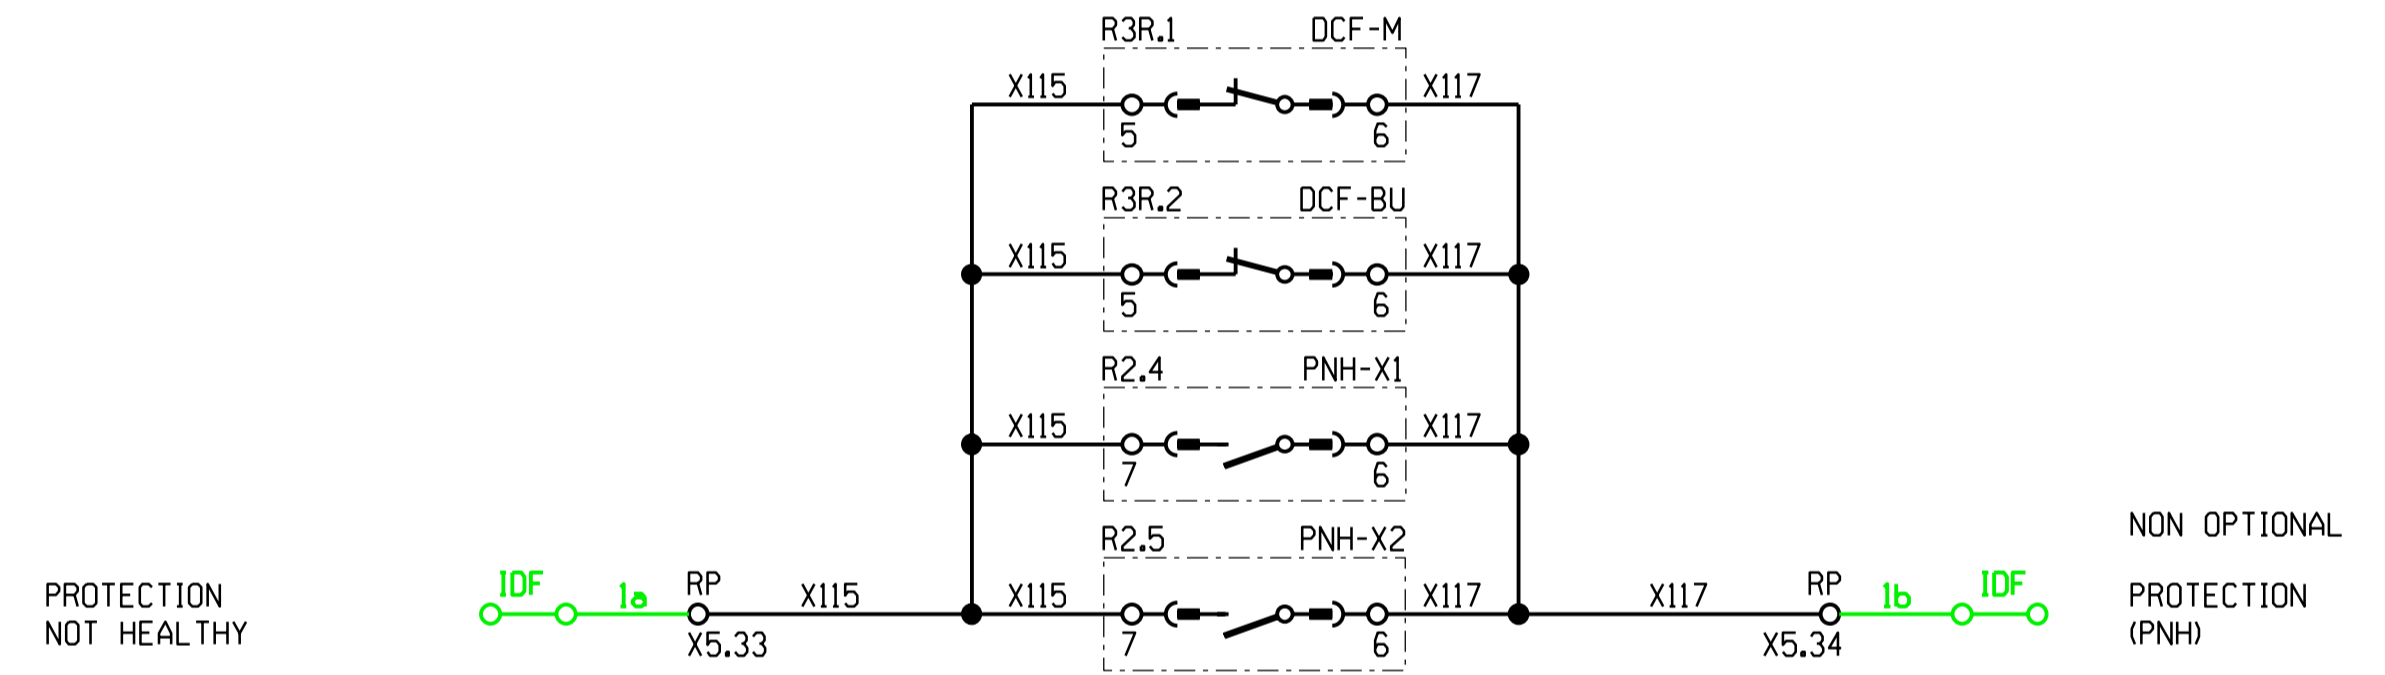








SHT	DESCRIPTION
SHT 28	ISOLATOR JB
SHT 27	CABLE BLOCK
SHT 26	LINE VT DIAGRAM
SHT 25	CT JB CABLING
SHT 24	CABLING DIAGRAM
SHT 23	CABLING DIAGRAM
SHT 22	CABLING DIAGRAM
SHT 21	REFERENCE DIAG
SHT 20	REFERENCE DIAG
SHT 19	REFERENCE DIAG
SHT 18	DISTUR RECORDER
SHT 17	SUP ALARMS KEY
SHT 16	SUP STATUS, CONT
SHT 15	REA & MEAS KEY
SHT 14	SPR REW, AC KEY
SHT 13	INDICAT, DC KEY
SHT 12	CLOSE DC KEY
SHT 11	BACK-UP DC KEY
SHT 10	BACK-UP DC KEY
SHT 09	BACK-UP DC KEY
SHT 08	TELEPROT DC KEY
SHT 07	MAIN DC KEY
SHT 06	MAIN DC KEY
SHT 05	VT SUPPLY KEY
SHT 04	AC KEY DIAGRAM
SHT 03	SINGLE LINE
SHT 02	LOGIC DIAGRAM
SHT 01	PANEL LAYOUT
DRG No.	REFERENCE DRAWINGS:

NOTE:
1. DOUBLE BIT INDICATION SHOULD BE USED.



REV	AUTH	DATE	REVISION TO MASTER	BY	CHKD	SCALE

153272156-00003						
REV	REVISION DESCRIPTION	BY	CHKD	AUTH	DATE	PROJECT NUMBER
		ISCOR SUBSTATION 66kV FEEDER 2 SUPERVISORY ALARMS KEY DIAGRAM				
PROJECT APPROVED C. PYM		DESIGN APPROVED A. CRAIB				
DATE 25/06/21		DATE 13/13/10				
PROJECT CHECKED B. HOMANN		DESIGN CHECKED N. MATHONSI				
DATE 25/06/21		DATE 13/12/10				
DRAWN BY K. STEYNBERG		DRAWN BY C. CANNON				
DATE 25/06/21		DATE 26/02/10				
		D-WC-7104		SET NUMBER	SHEET NUMBER	REVISION
				62	17	0
PANEL TYPE DESIGNATION 4FZD-3920						

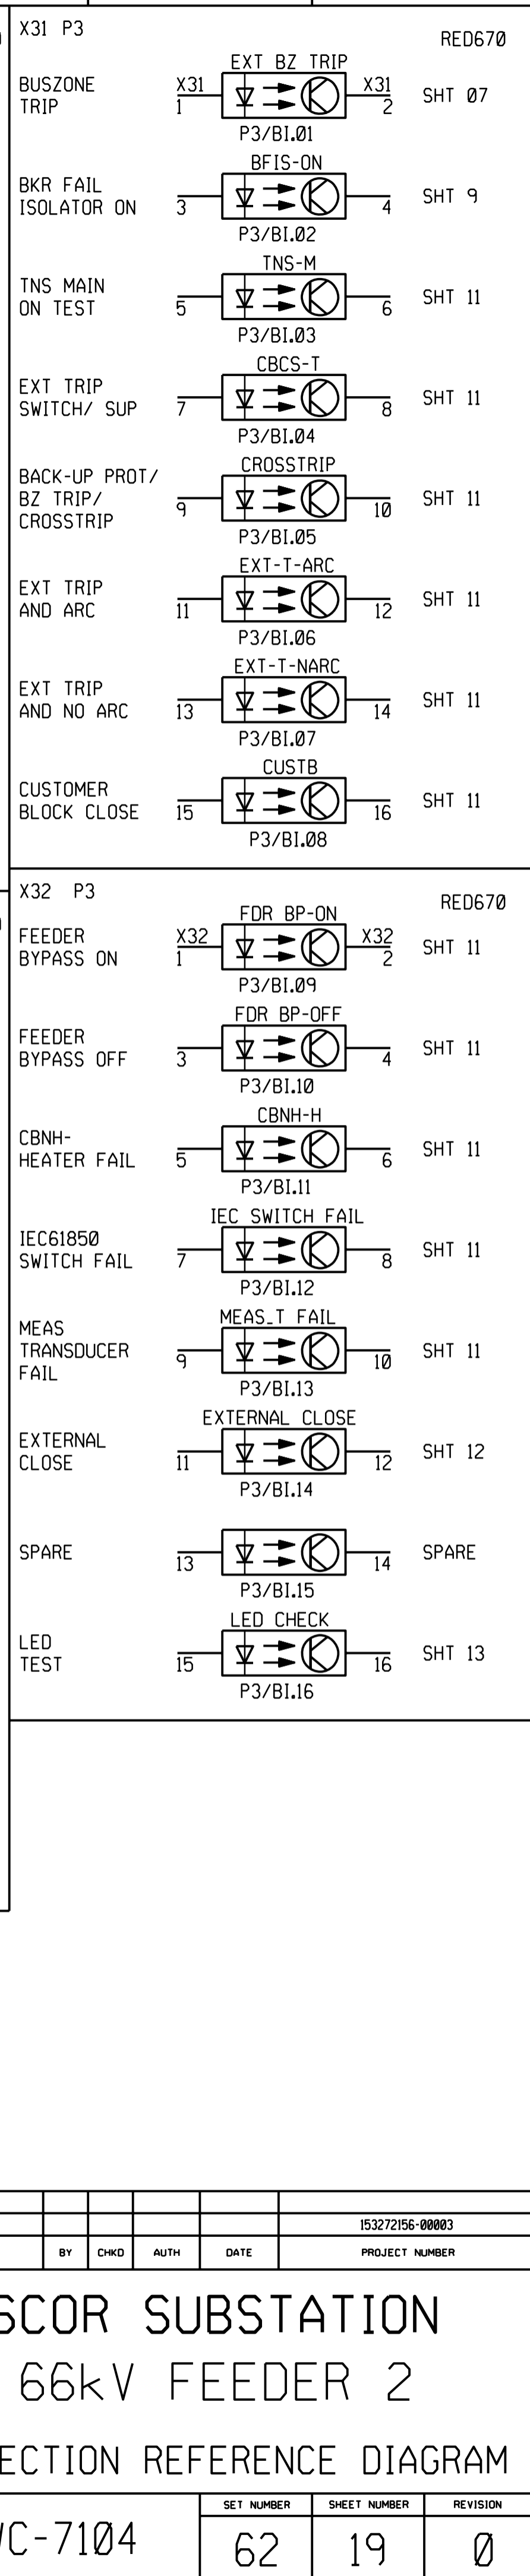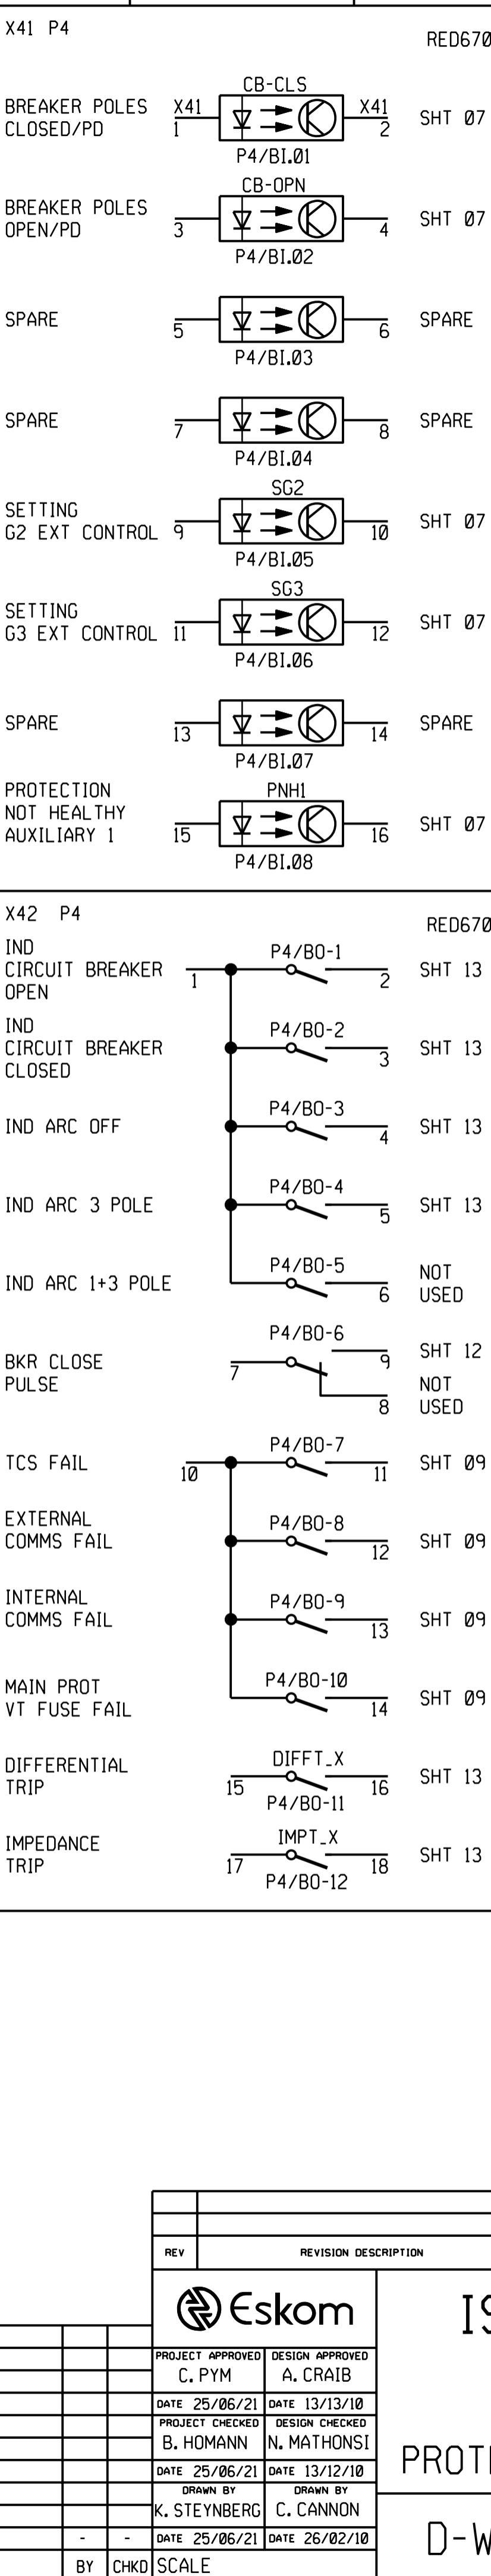 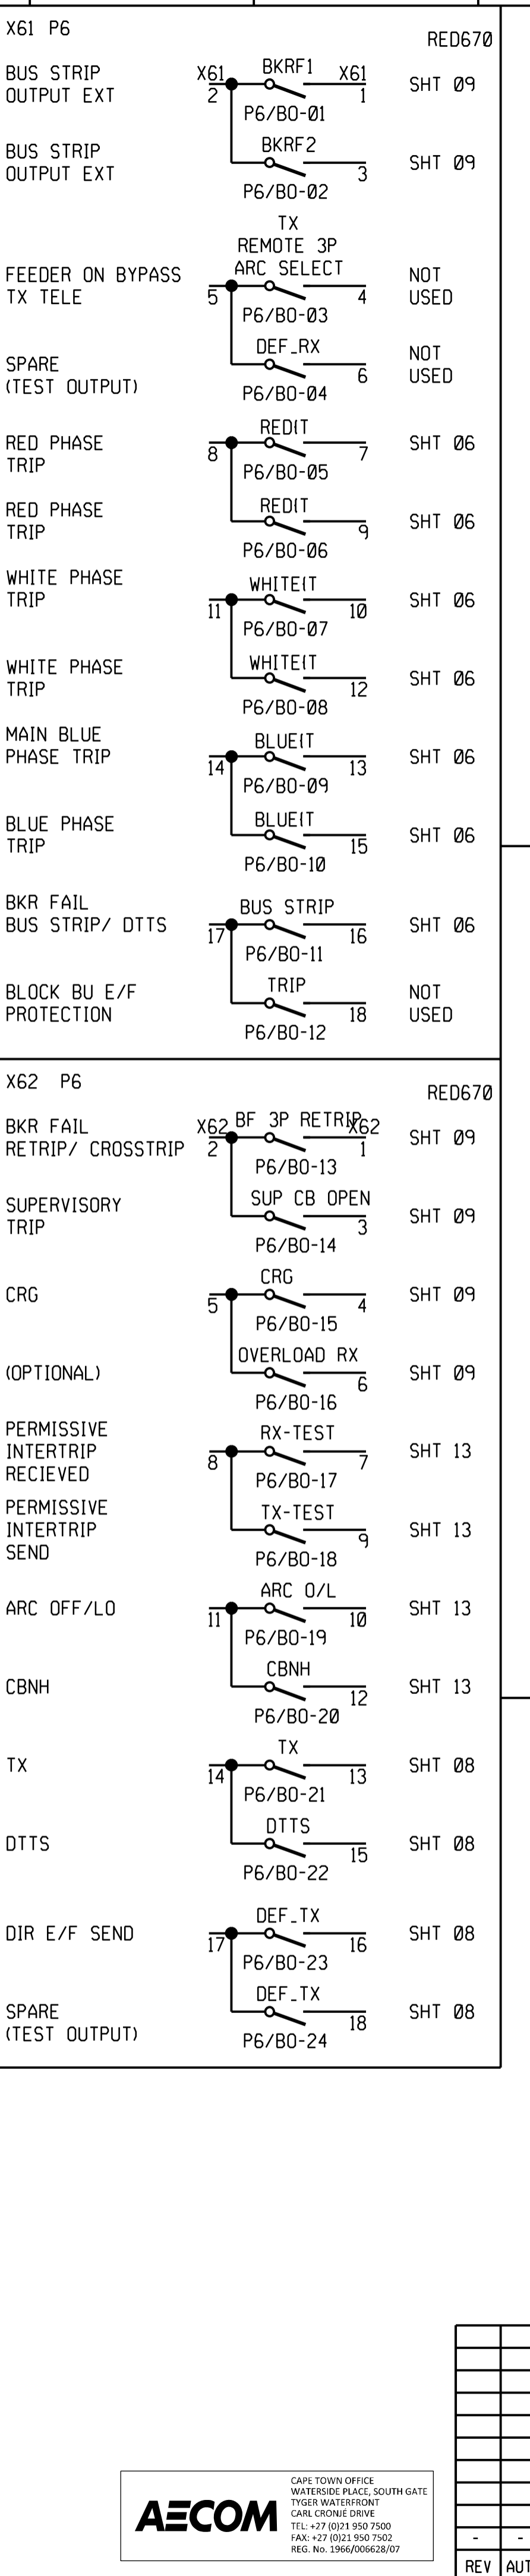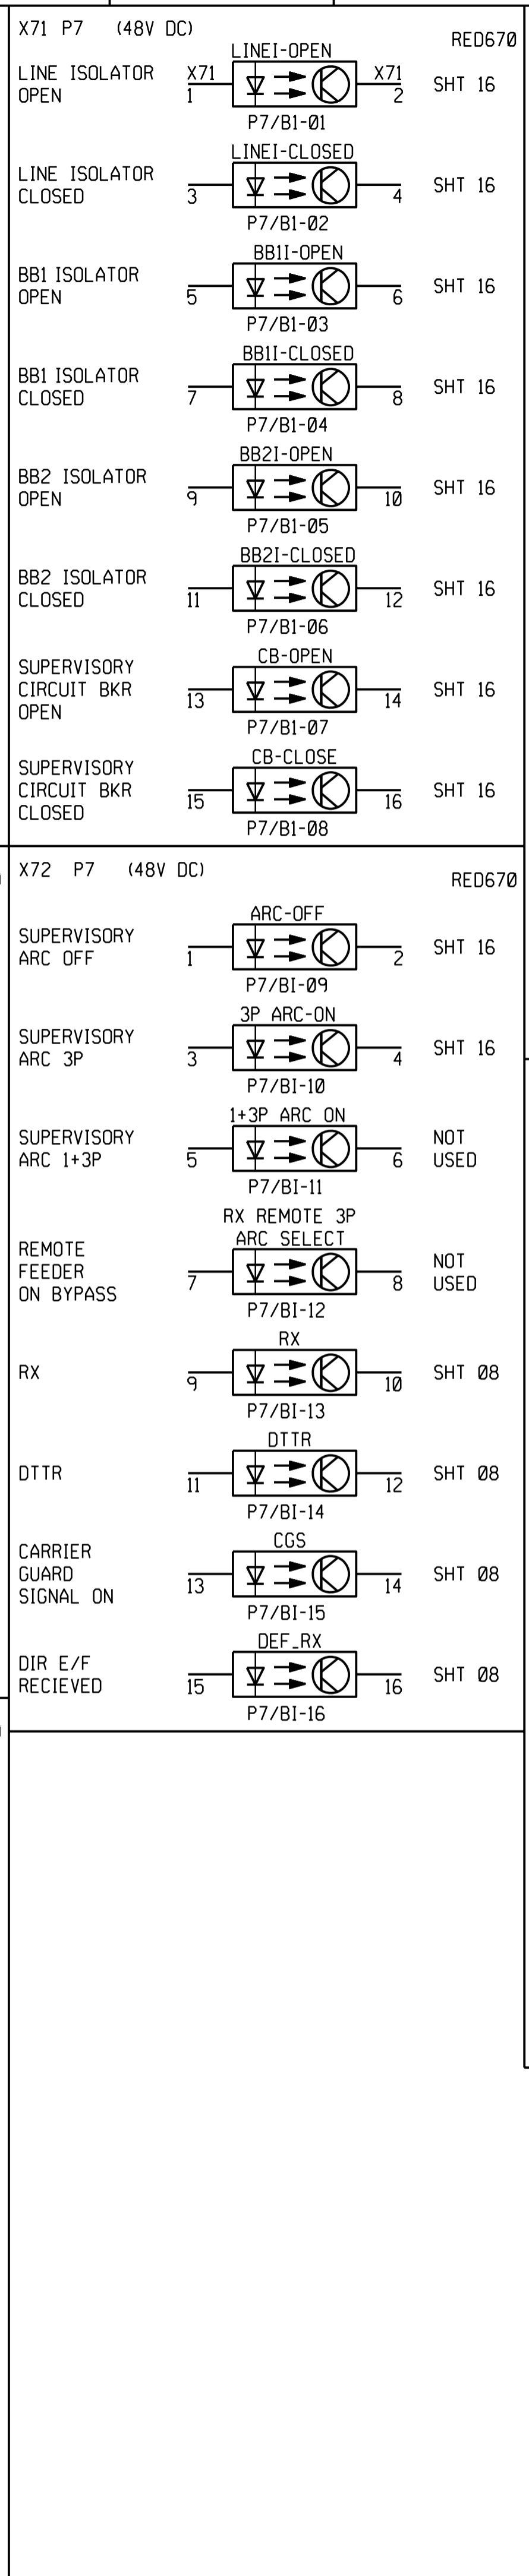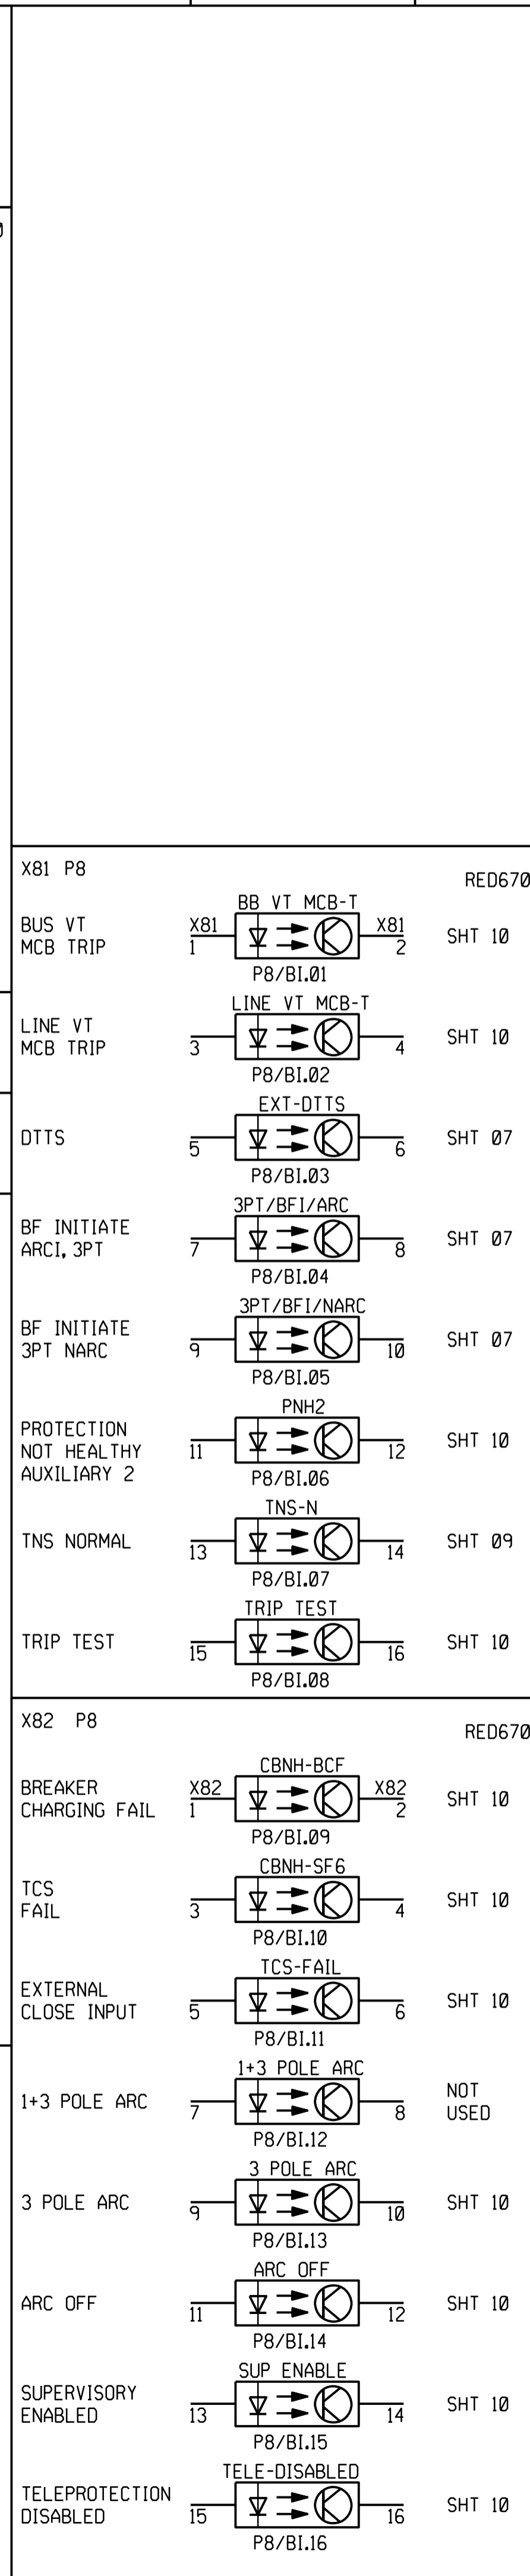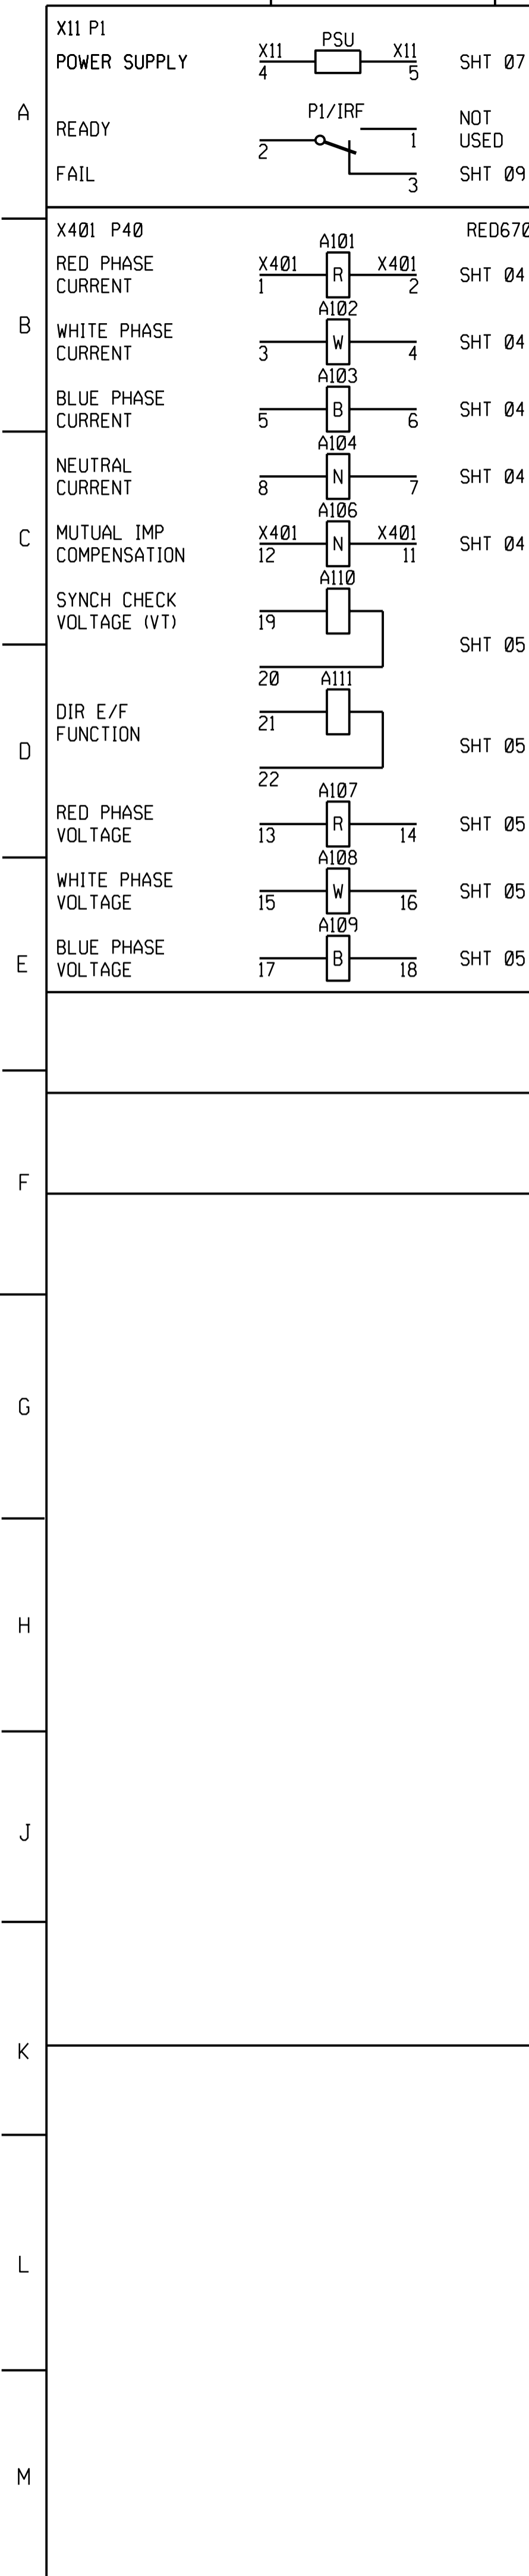

REV	REVISION DESCRIPTION	BY	CHKD	AUTH	DATE	PROJECT NUMBER
						15327256-00003

PROJECT APPROVED C. PYM		DESIGN APPROVED A. CRAIB	
DATE 25/06/21	DATE 13/13/10	DATE 25/06/21	DATE 13/12/10
PROJECT CHECKED B. HOMANN	DESIGN CHECKED N. MATHONSI	DRAWN BY K. STEYNERG	
DATE 25/06/21		DATE 26/02/10	
DRAWN BY K. STEYNERG		DRAWN BY C. CANNON	


REV	AUTH	DATE	REVISION TO MASTER	BY	CHKD	SCALE
-	-	-	-	-	-	-

SET NUMBER	SHEET NUMBER	REVISION
D-WC-7104	62	19

LEVELS	1	2	5	10	11	12	20	21	22	28
--------	---	---	---	----	----	----	----	----	----	----



MASTER TRACING FILED UNDER D-DT-15007 SHEET 19 OF 28 REVISION 2

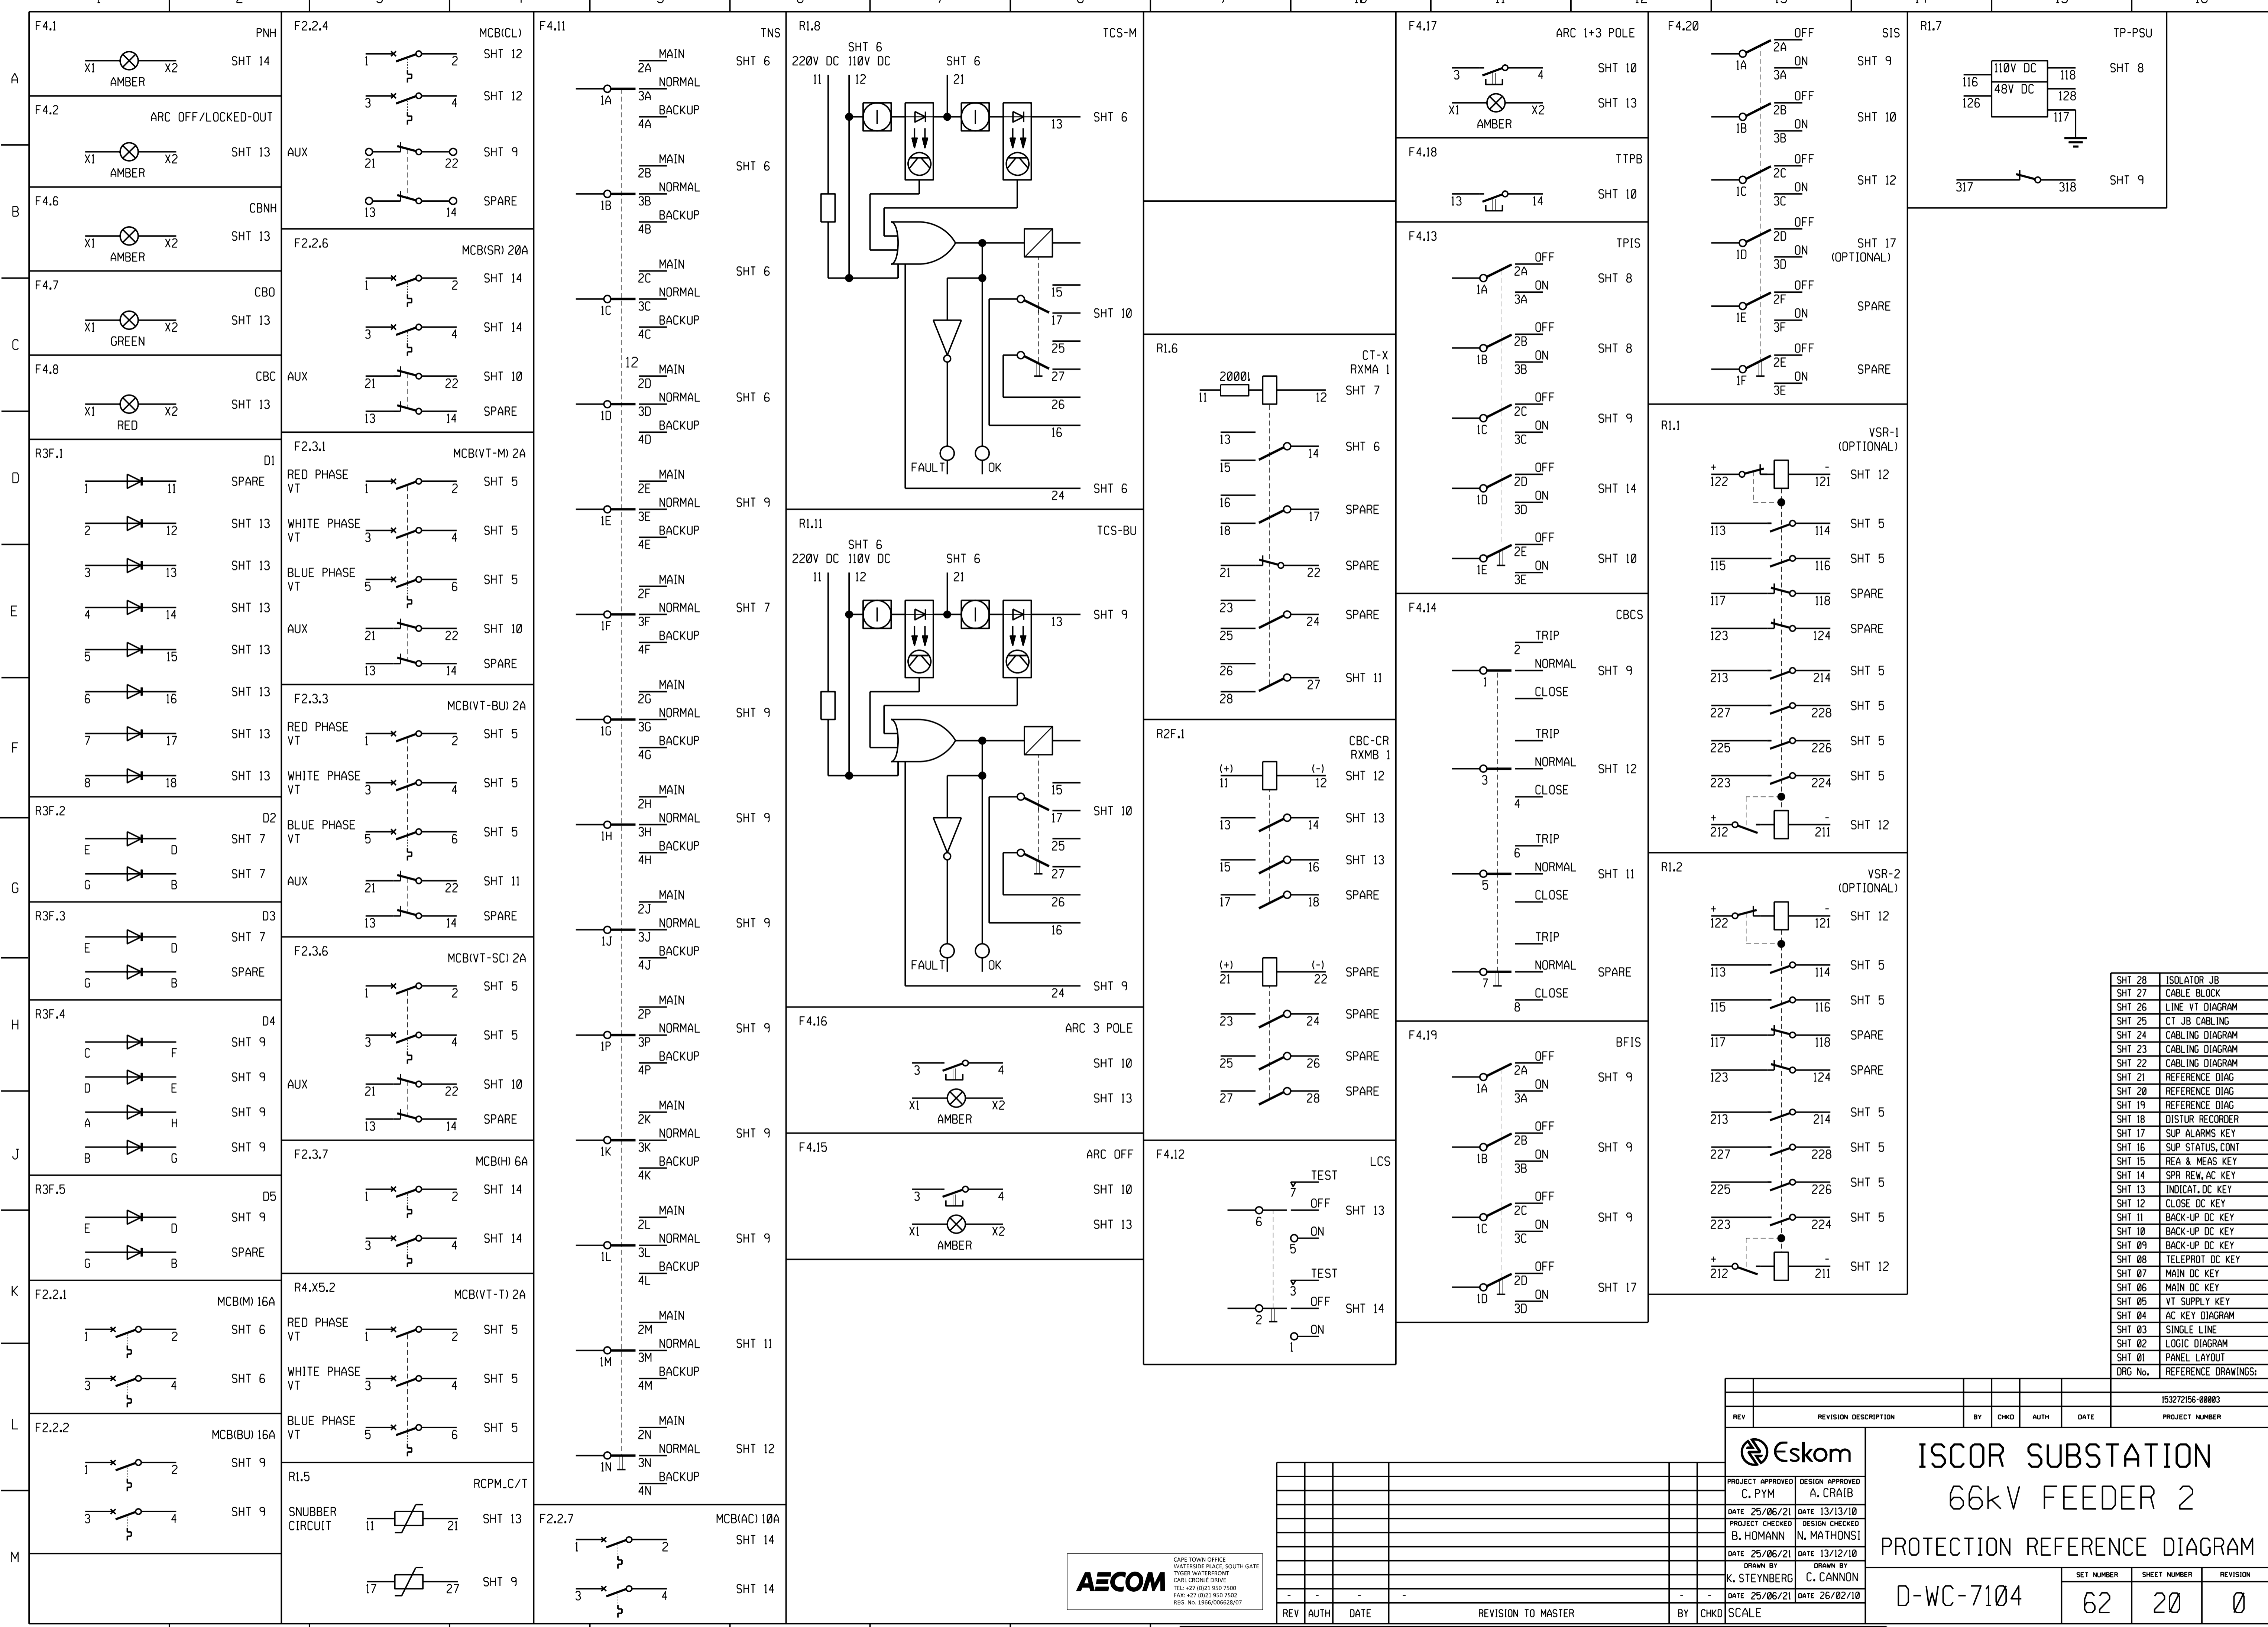










SHT 28	ISOLATOR JB
SHT 27	CABLE BLOCK
SHT 26	LINE VT DIAGRAM
SHT 25	CT JB CABLING
SHT 24	CABLING DIAGRAM
SHT 23	CABLING DIAGRAM
SHT 22	CABLING DIAGRAM
SHT 21	REFERENCE DIAG
SHT 20	REFERENCE DIAG
SHT 19	REFERENCE DIAG
SHT 18	DISTUR RECORDER
SHT 17	SUP ALARMS KEY
SHT 16	SUP STATUS, CONT
SHT 15	REA & MEAS KEY
SHT 14	SPR REW, AC KEY
SHT 13	INDICAT, DC KEY
SHT 12	CLOSE DC KEY
SHT 11	BACK-UP DC KEY
SHT 10	BACK-UP DC KEY
SHT 09	BACK-UP DC KEY
SHT 08	TELEPROT DC KEY
SHT 07	MAIN DC KEY
SHT 06	MAIN DC KEY
SHT 05	VT SUPPLY KEY
SHT 04	AC KEY DIAGRAM
SHT 03	SINGLE LINE
SHT 02	LOGIC DIAGRAM
SHT 01	PANEL LAYOUT
DRG No.	REFERENCE DRAWINGS:

15327156-00003					
REV	REVISION DESCRIPTION	BY	CHKD	DATE	PROJECT NUMBER
Eskom					
PROJECT APPROVED		DESIGN APPROVED			
C. PYM		A. CRAIB			
DATE 25/06/21		DATE 13/13/10			
PROJECT CHECKED		DESIGN CHECKED			
B. HOMANN		N. MATHONSI			
DATE 25/06/21		DATE 13/12/10			
DRAWN BY		DRAWN BY			
K. STEYNBERG		C. CANNON			
DATE 25/06/21		DATE 26/02/10			
D-WC-7104					
SET NUMBER		SHEET NUMBER		REVISION	
62		20		0	
PANEL TYPE DESIGNATION 4FZD-3920					




LEVELS	1	5	10
REV	AUTH	DATE	REVISION TO MASTER
BY	CHKD	SCALE	

MASTER TRACING FILED UNDER D-DT-15007 SHEET 20 OF 28 REVISION 2

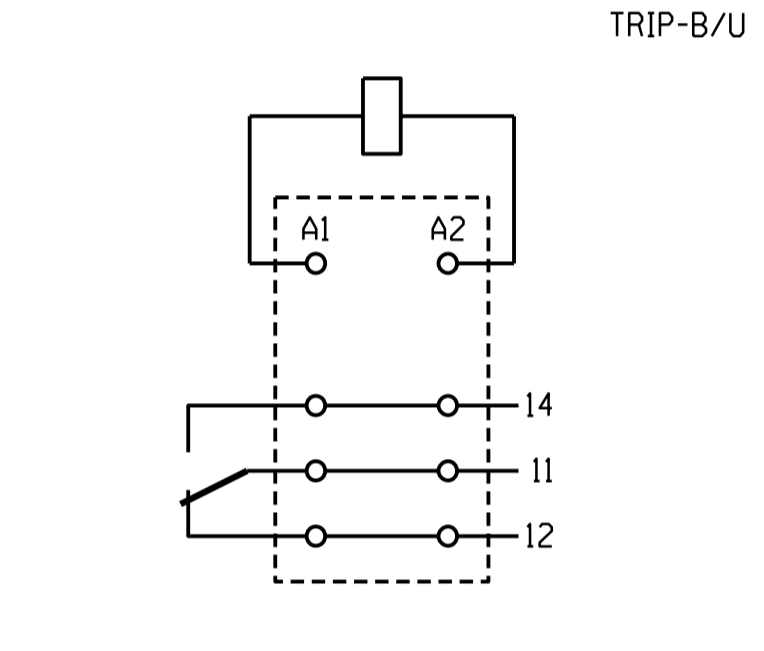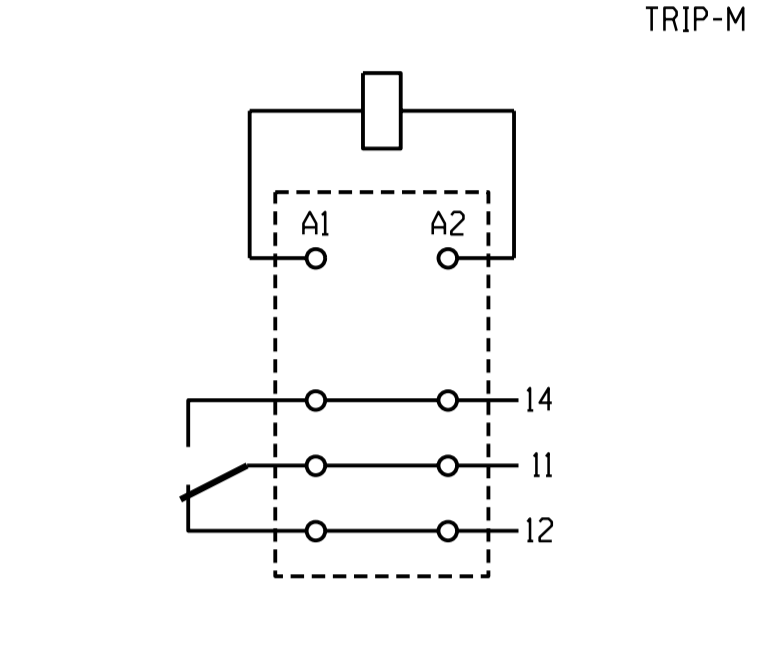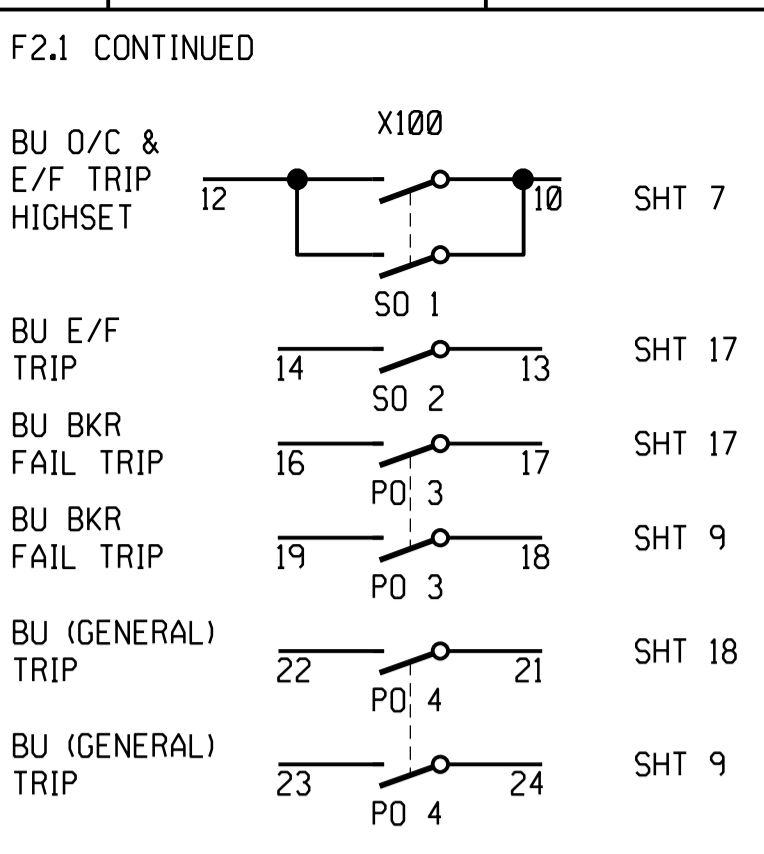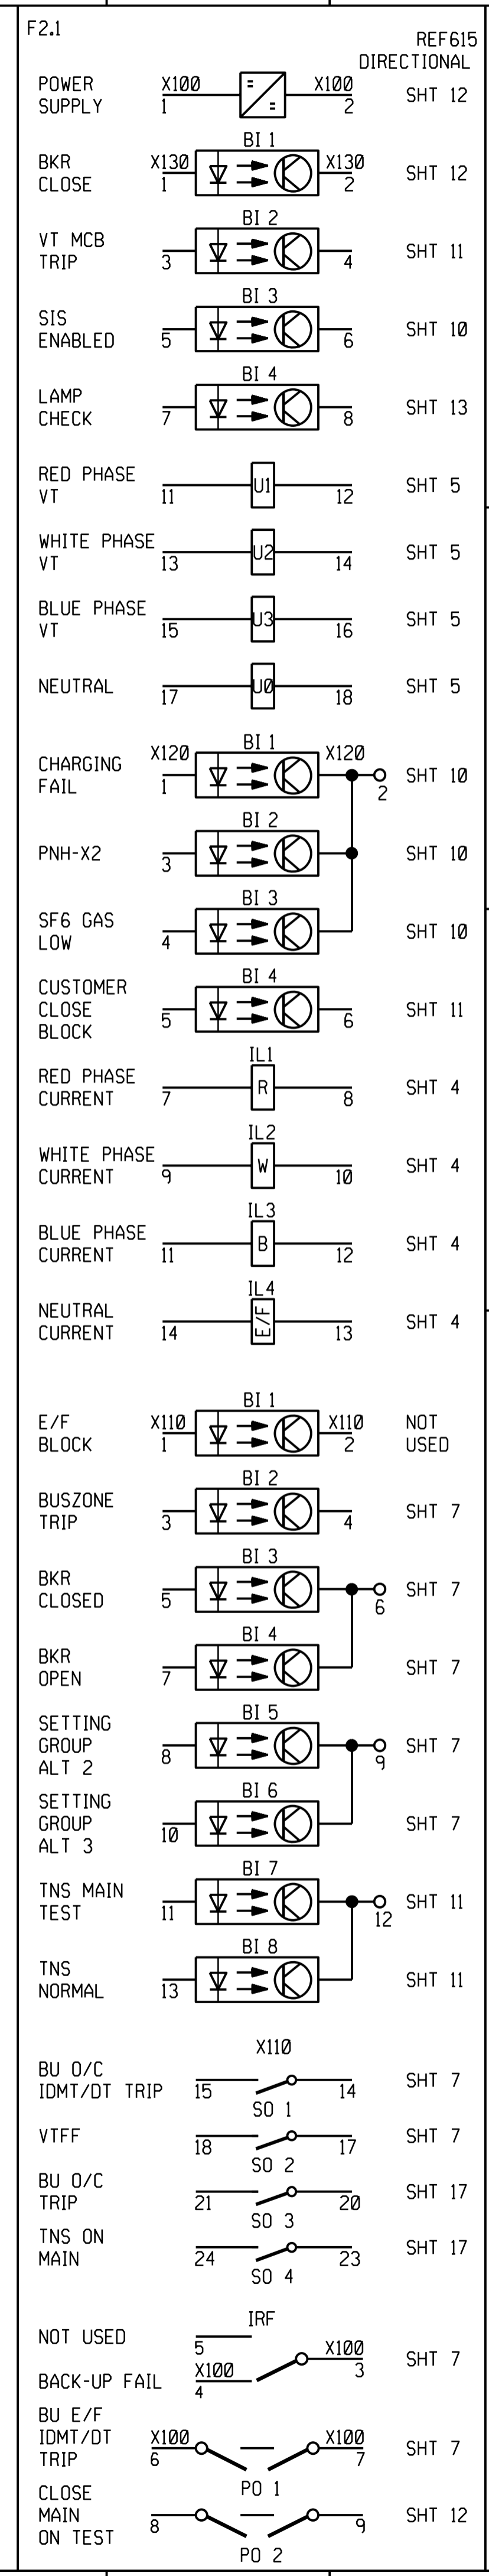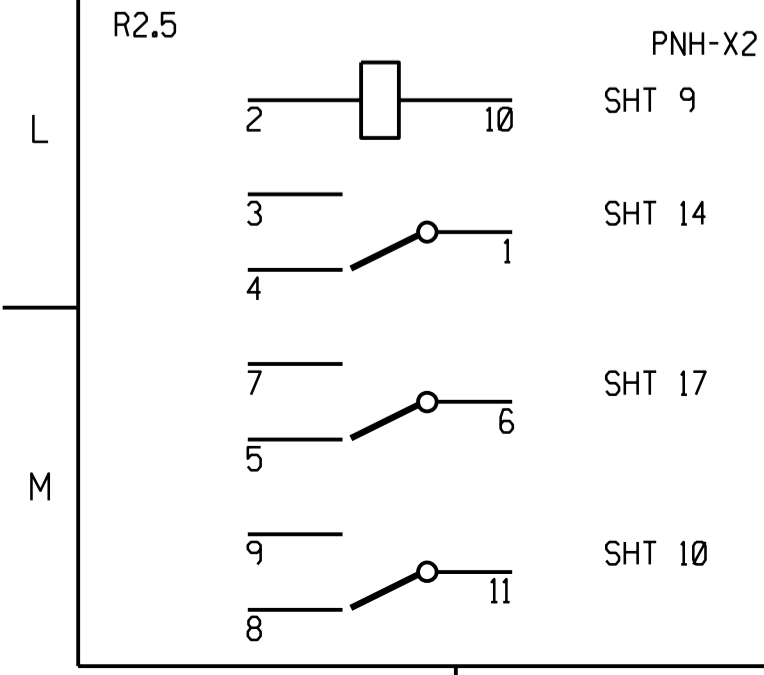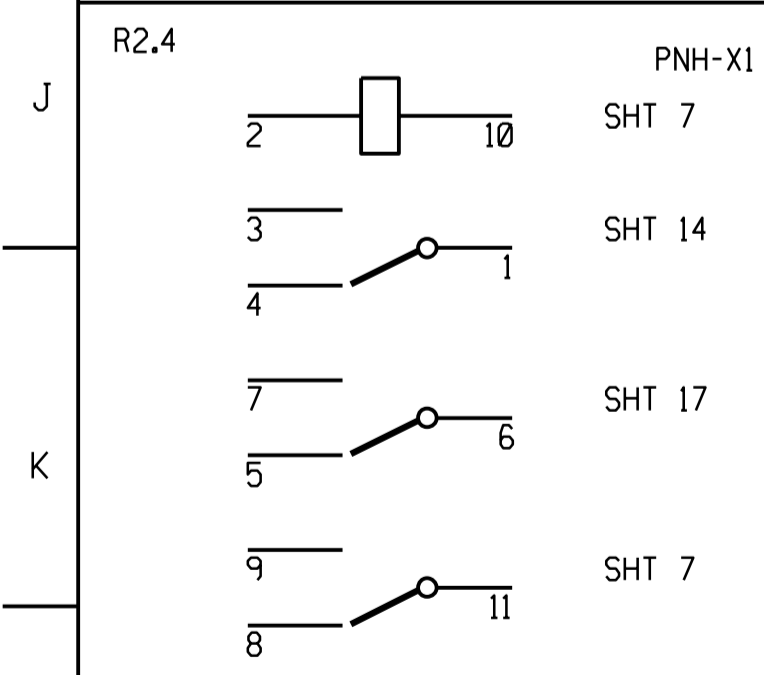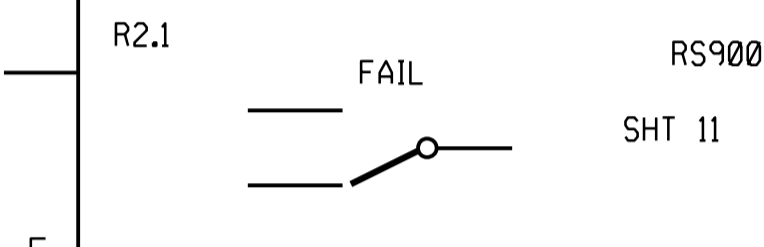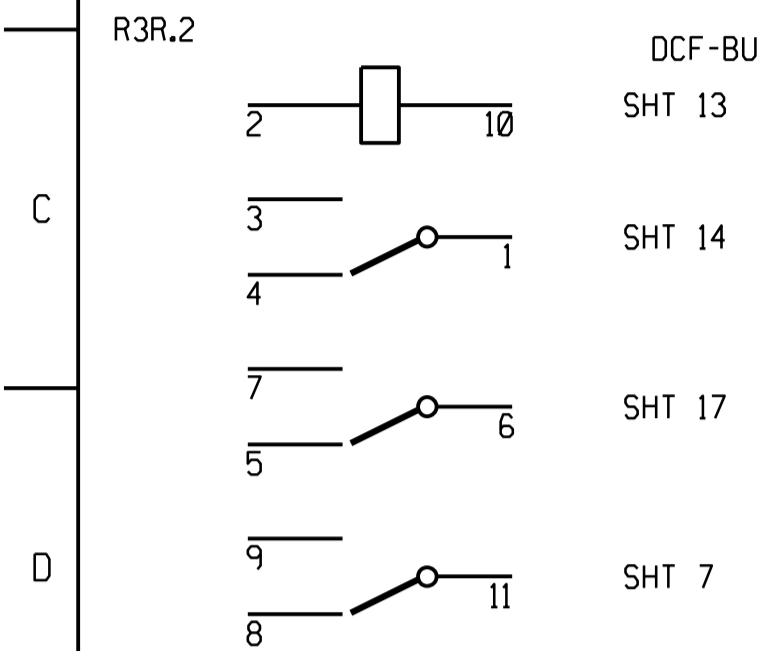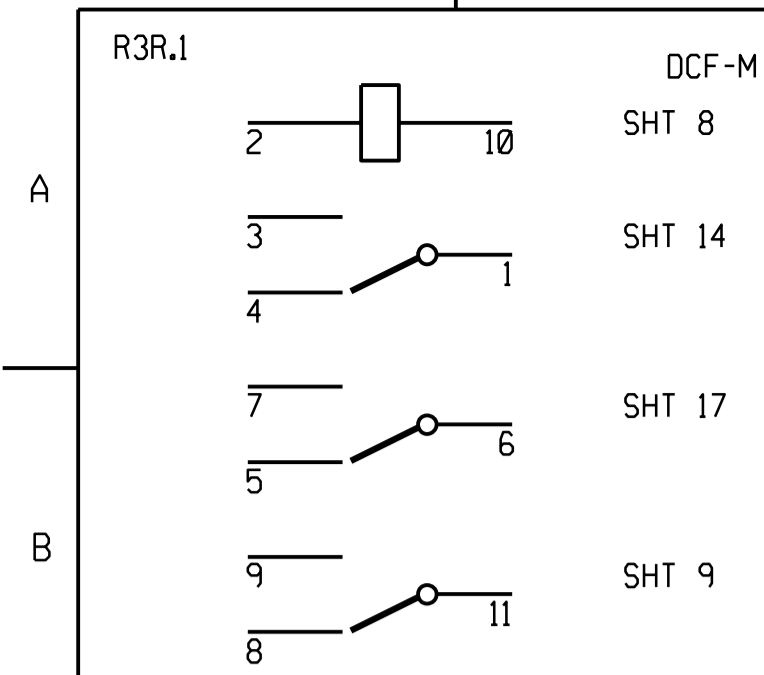

SHT 28	ISOLATOR JB
SHT 27	CABLE BLOCK
SHT 26	LINE VT DIAGRAM
SHT 25	CT JB CABLING
SHT 24	CABLING DIAGRAM
SHT 23	CABLING DIAGRAM
SHT 22	CABLING DIAGRAM
SHT 21	REFERENCE DIAG
SHT 20	REFERENCE DIAG
SHT 19	REFERENCE DIAG
SHT 18	DISTUR RECORDER
SHT 17	SUP ALARMS KEY
SHT 16	SUP STATUS, CONT
SHT 15	REA & MEAS KEY
SHT 14	SPR REW, AC KEY
SHT 13	INDICAT, DC KEY
SHT 12	CLOSE DC KEY
SHT 11	BACK-UP DC KEY
SHT 10	BACK-UP DC KEY
SHT 09	BACK-UP DC KEY
SHT 08	TELEPROT DC KEY
SHT 07	MAIN DC KEY
SHT 06	MAIN DC KEY
SHT 05	VT SUPPLY KEY
SHT 04	AC KEY DIAGRAM
SHT 03	SINGLE LINE
SHT 02	LOGIC DIAGRAM
SHT 01	PANEL LAYOUT
DRG No.	REFERENCE DRAWINGS:

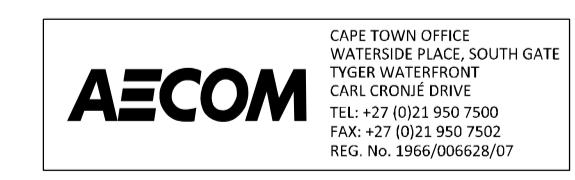

1	66kV VT & CB ADDED, FEEDER RENAMED.	KS	BH	CP	25/06/2021	153272156-00003
REV	REVISION DESCRIPTION	BY	CHKD	AUTH	DATE	PROJECT NUMBER

Eskom




ISCOR SUBSTATION 66kV FEEDER 2 PROTECTION REFERENCE DIAGRAM

PROJECT APPROVED C. PYM	DESIGN APPROVED A. CRAIB
DATE 25/06/21	DATE 13/13/10
PROJECT CHECKED B. HOMANN	DESIGN CHECKED N. MATHONSI
DATE 25/06/21	DATE 13/12/10
DRAWN BY K. STEYNBERG	DRAWN BY C. CANNON
DATE 25/06/21	DATE 26/02/10

D-WC-7104

SET NUMBER	SHEET NUMBER	REVISION
62	21	1

PANEL TYPE DESIGNATION 4FZD-3920

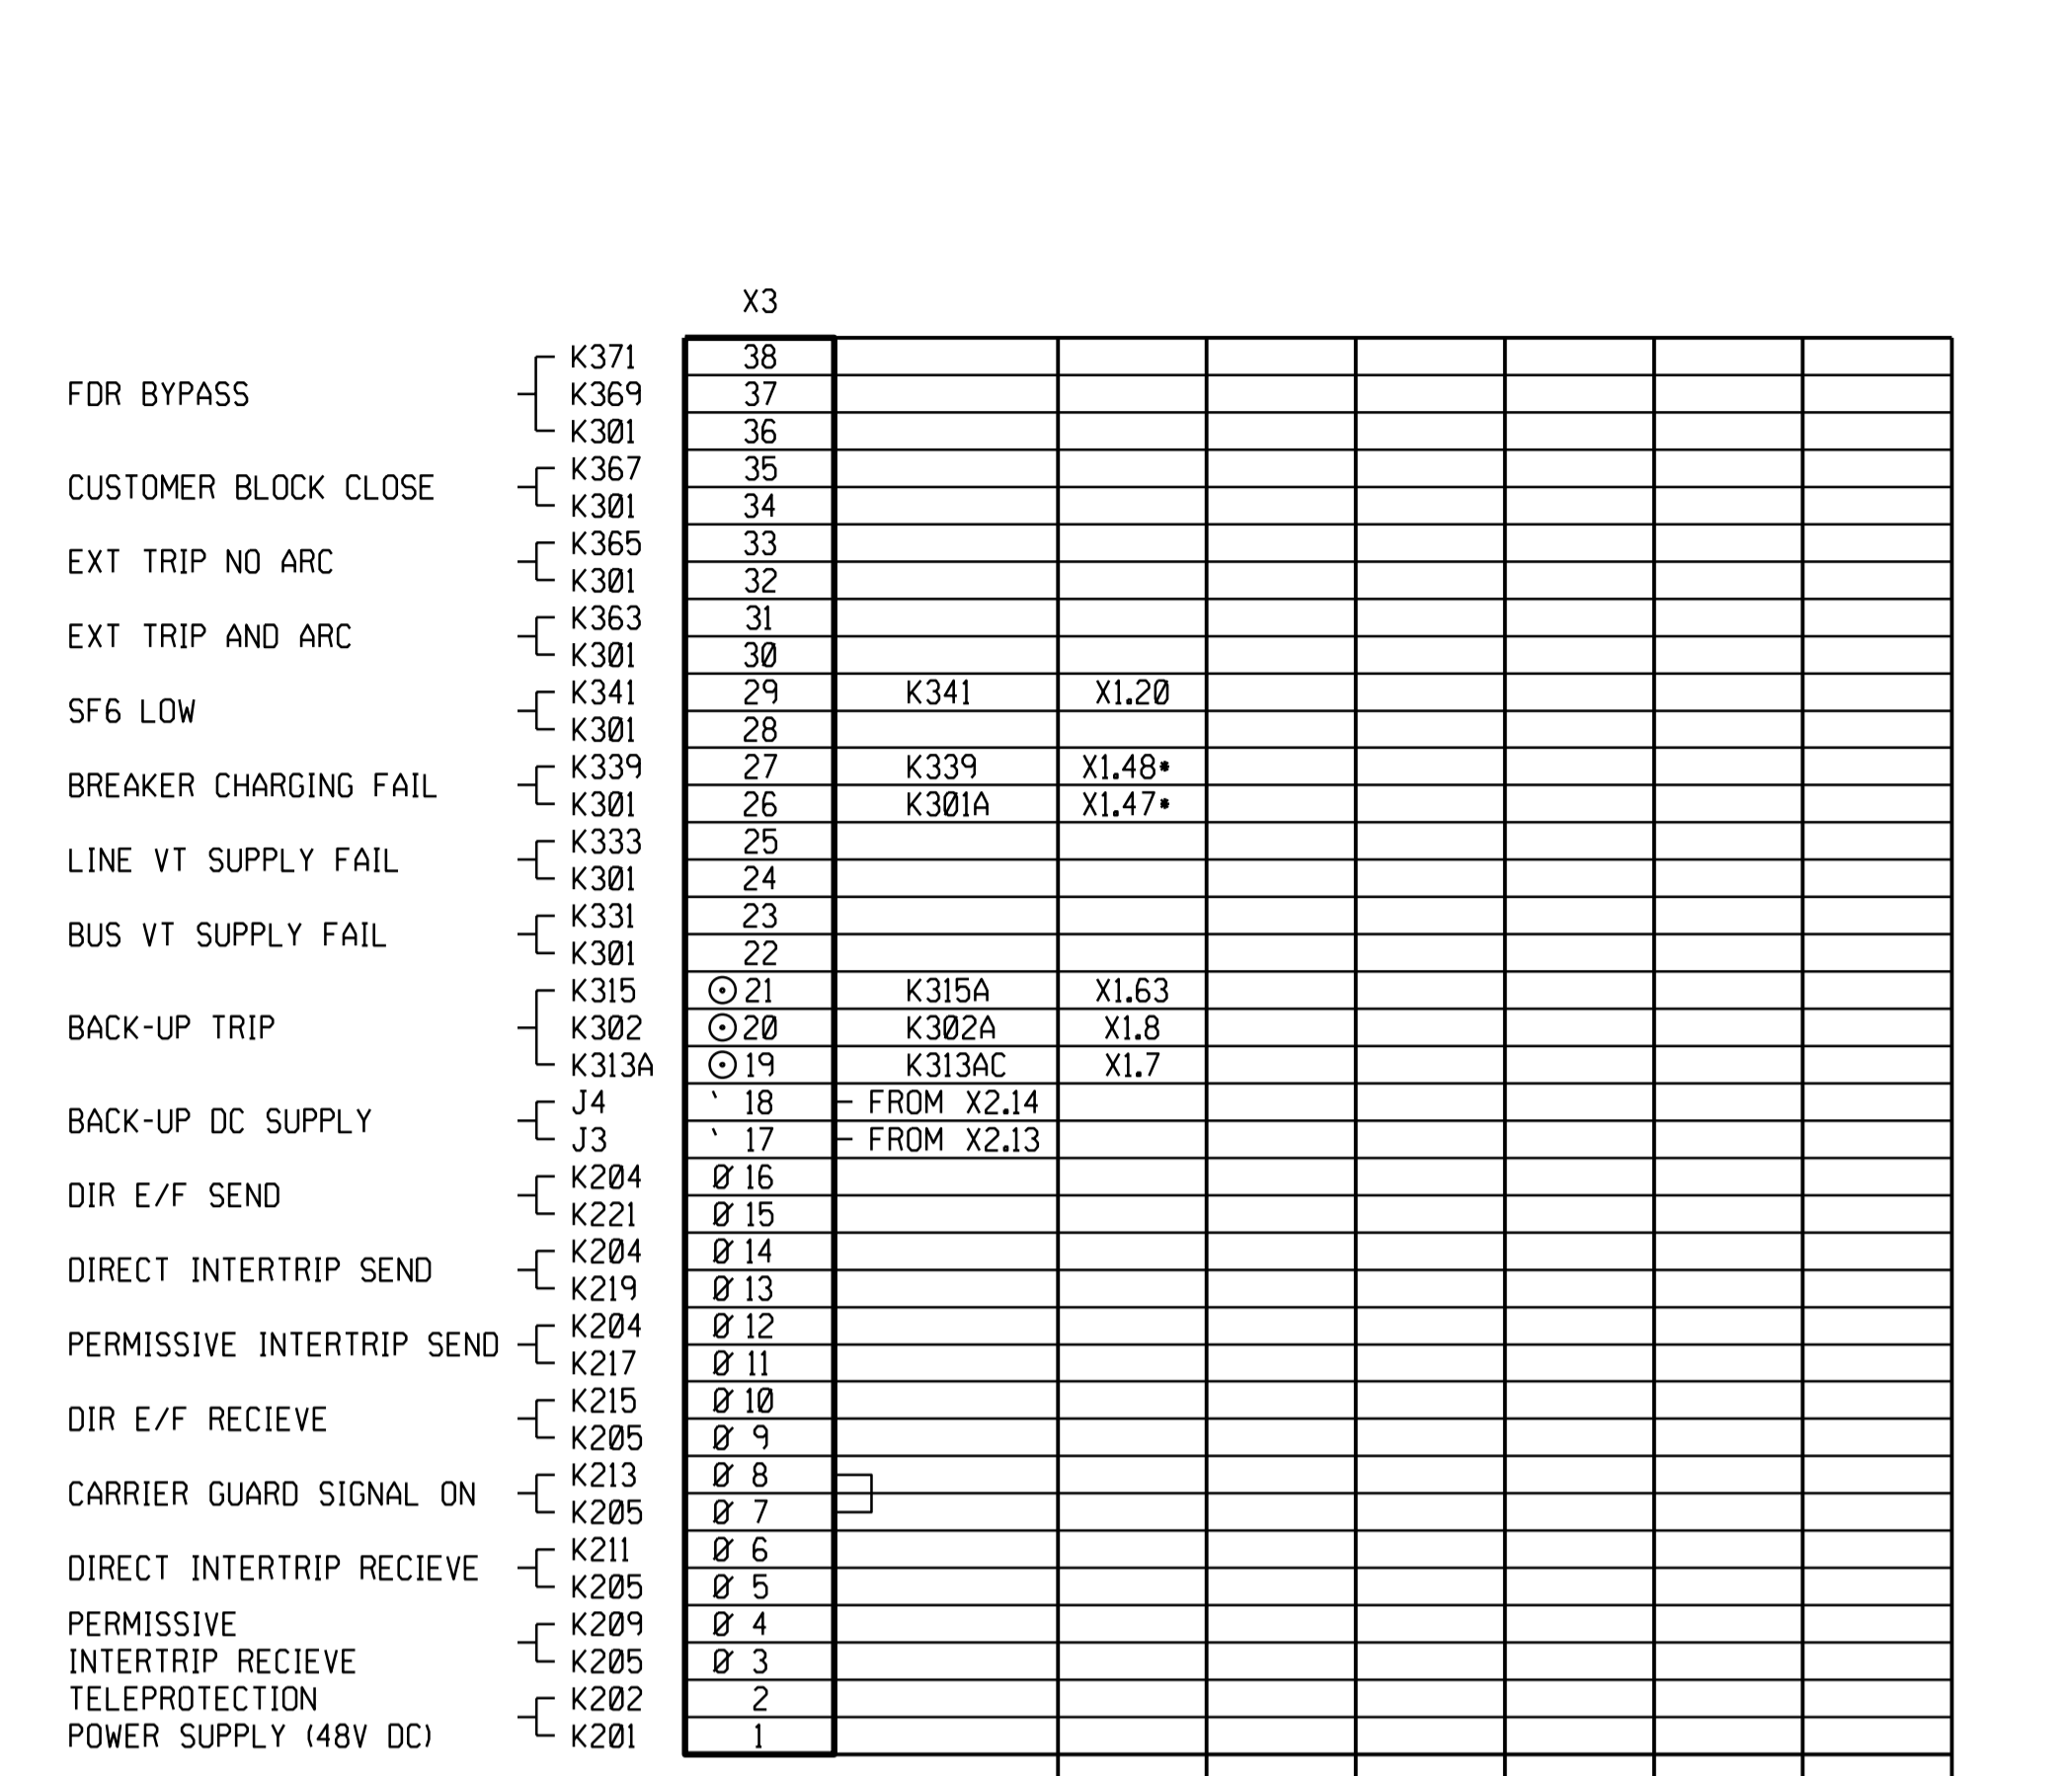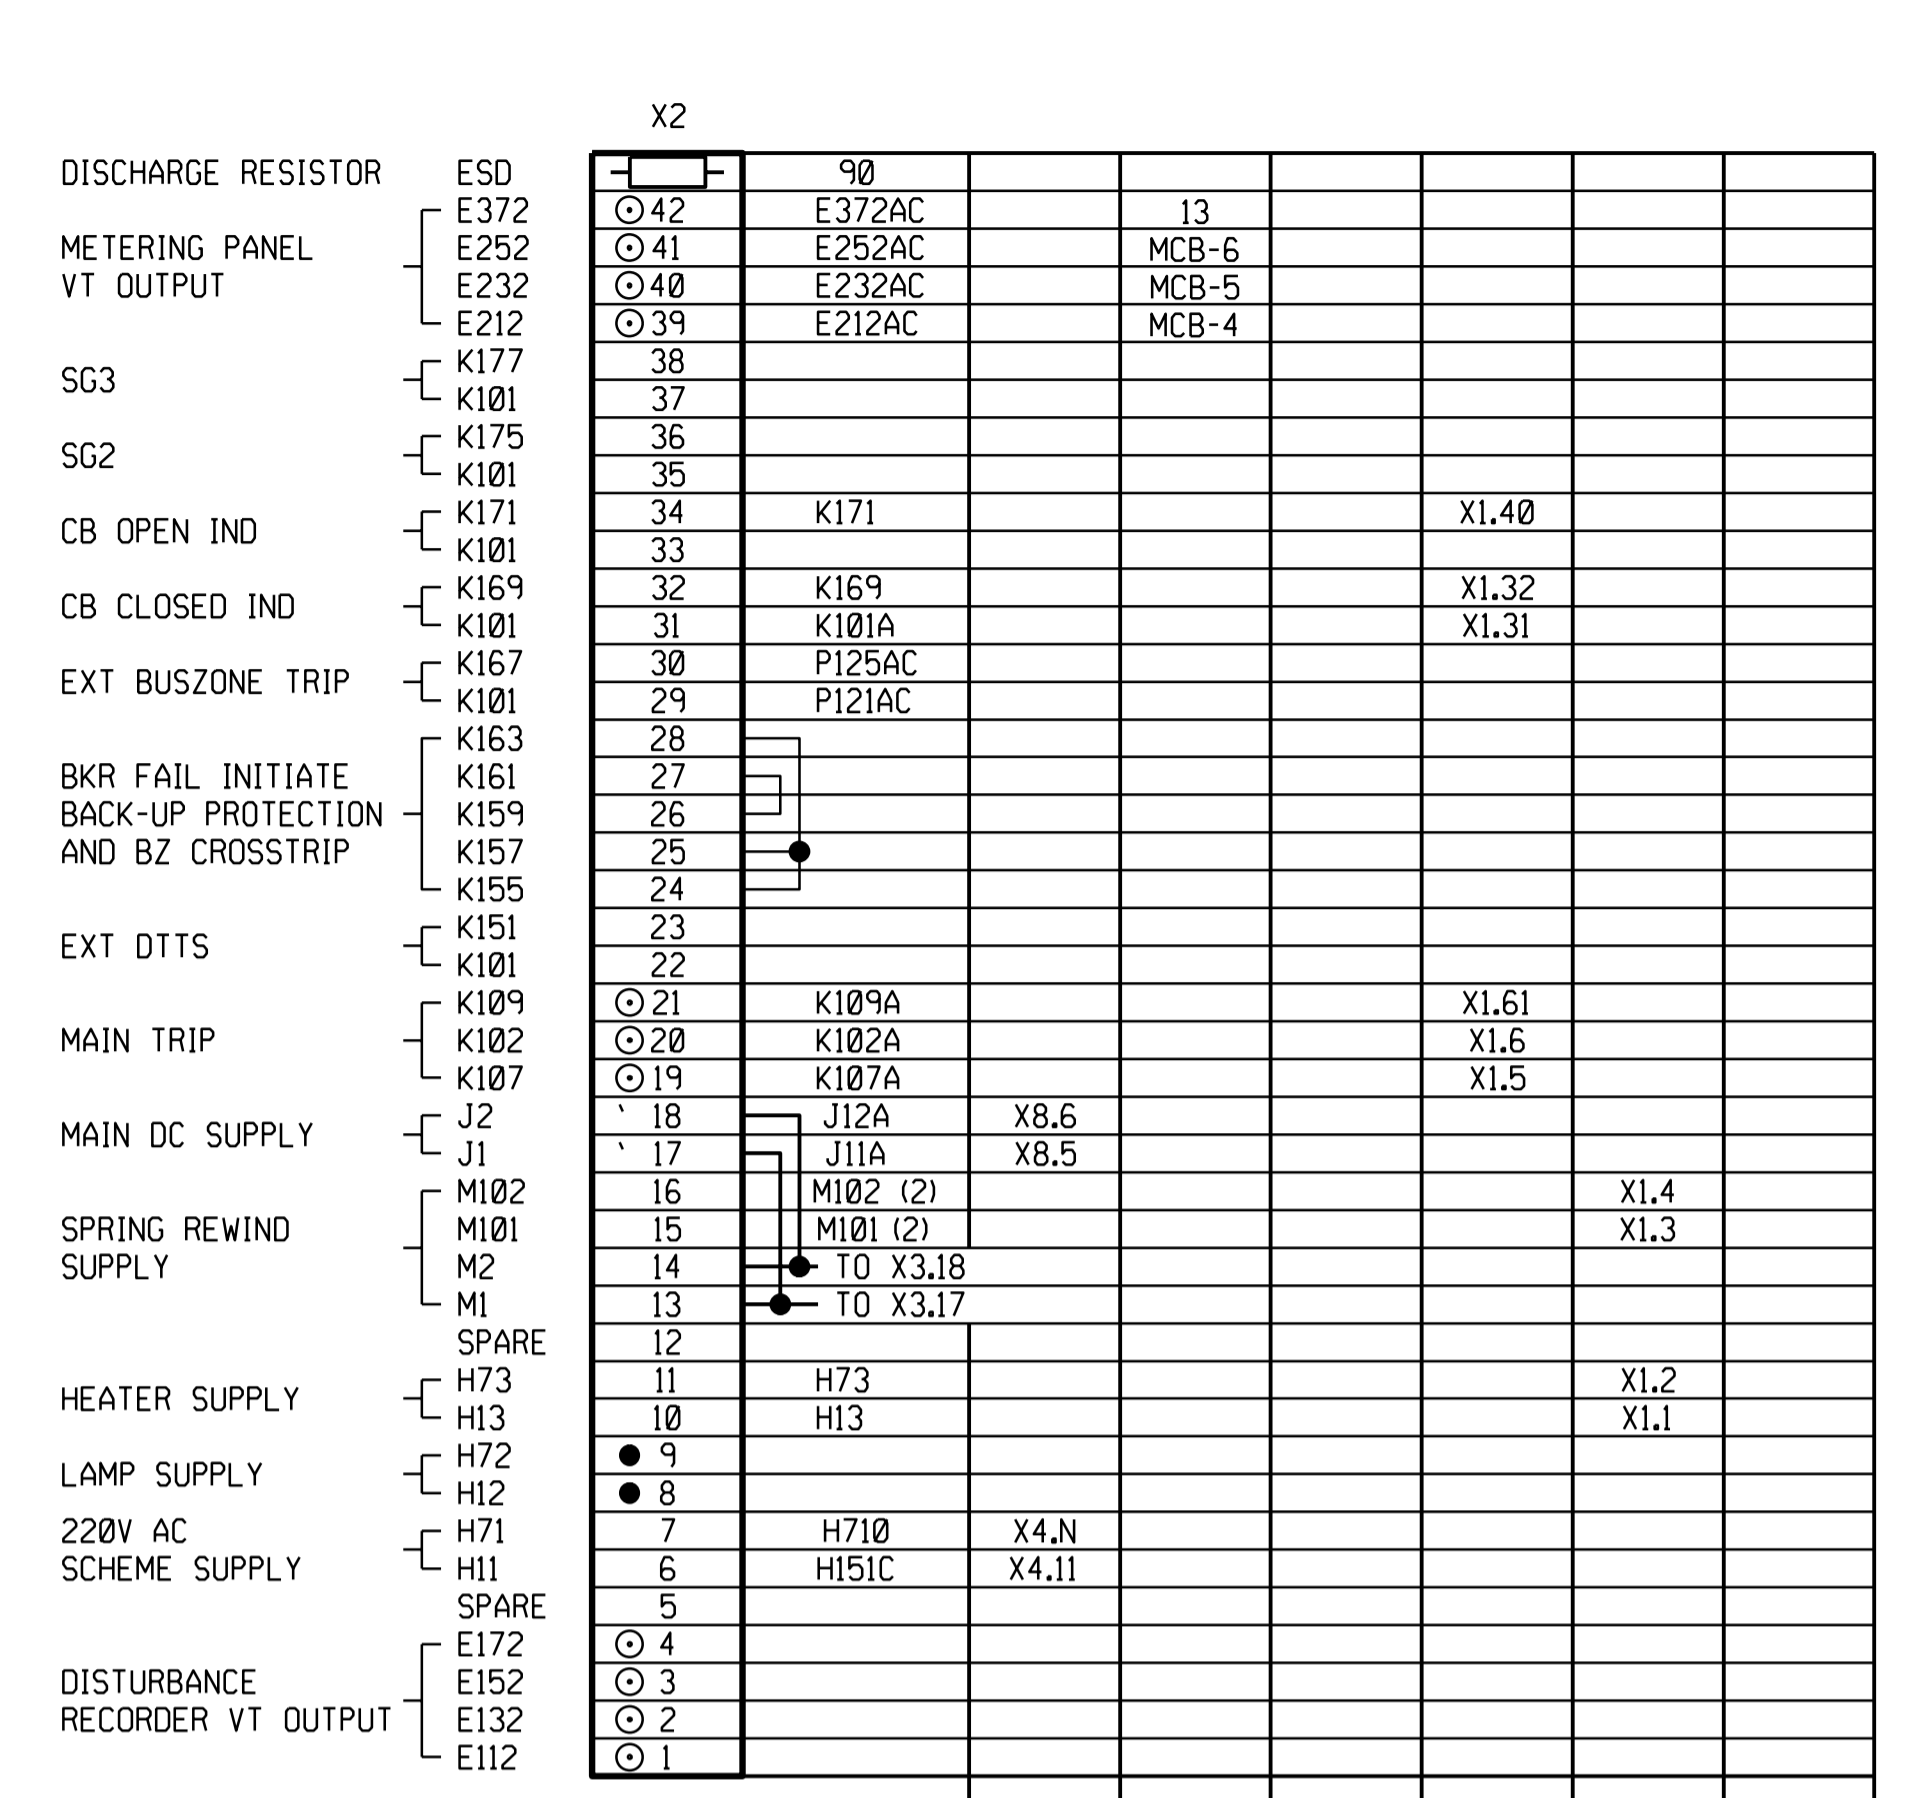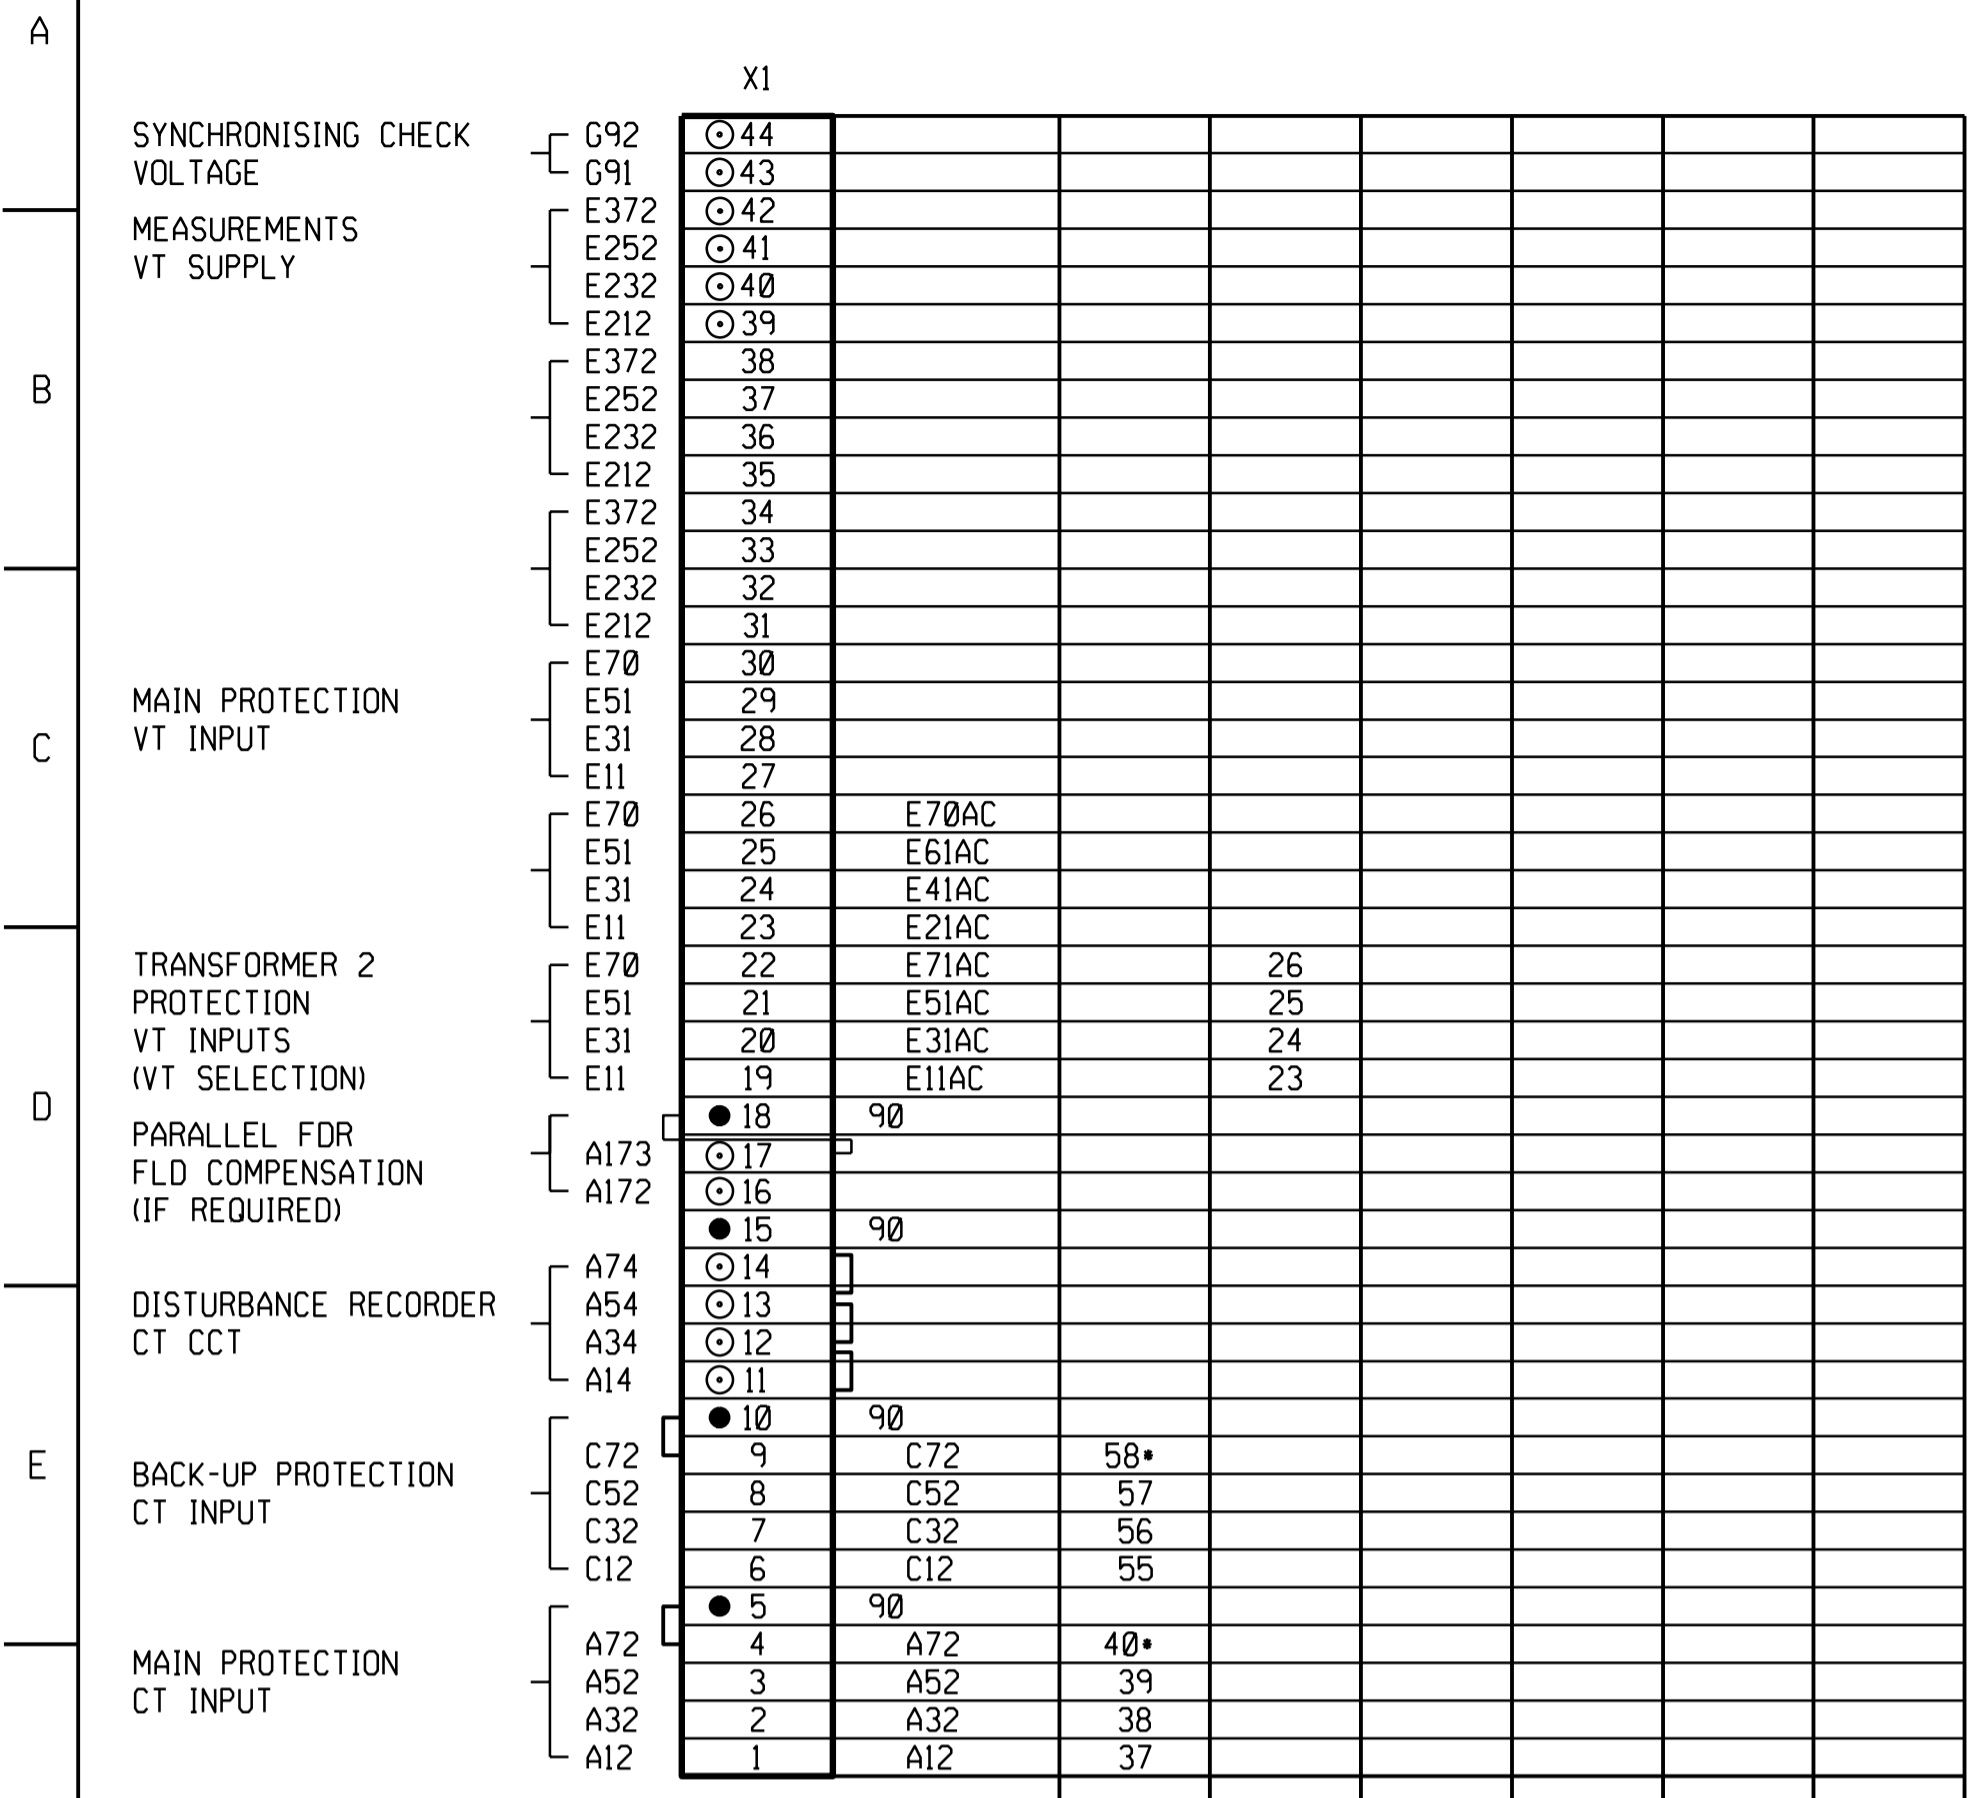

CABLE NUMBER	AC104	AC112
CABLE SIZE	12	12
NUMBER OF SPARES	4	8
DESTINATION	CT JUNCTION BOX	66KV TRANSFORMER 2 VTJB

CABLE NUMBER	AC122	AC107	AC105	AC106
CABLE SIZE	4	4	19	12
NUMBER OF SPARES	0	0	1	6
DESTINATION	AC/DC DISTRIBUTION BOARD	STATISTICAL METERING PANEL	HV CIRCUIT BREAKER	HV CIRCUIT BREAKER

CABLE NUMBER	AC105
CABLE SIZE	19
NUMBER OF SPARES	1
DESTINATION	HV CIRCUIT BREAKER

RP	TERMINAL LOOPS (*)
CB MB	X2.13 - X3.17; X2.14 - X3.18
CTJB	X1.17 - X1.19 - X1.47
	40 - 41 - 42; 46 - 47 - 48; 52 - 53 - 54;
	58 - 59 - 60; 61 - 62 - 63 - 64 - 65 - 66 - E; 70 - 71 - 72 - E

- NOTE:**
- (2) INDICATES TWO LEADS IN PARALLEL.
 - SPARE CABLE LEADS TO BE LEFT LONG ENOUGH TO REACH THE FURTHEST TERMINAL.
 - LEAD NUMBERS SHOWN THUS
 K101 K101 INDICATES NO CHANGE IN LEAD NUMBER.
 K301 K305 INDICATES CHANGE IN LEAD NUMBER.
 - SEE CABLE BLOCK DIAGRAM FOR PREFIXING.
- STANDARD TERMINALS USED ARE ENTRELEC M10/10.RS
- D6/8-ST-RS ENTRELEC SLIDING LINK TEST TERMINAL
 - D6/8 ST1 RS TEST AND SHORTING LINKS WITH SAFETY CONNECTIONS (YELLOW INSULATED TEST POINTS)
 - ∅ M4/6 RS SPRING LOADED ENTRELEC
 - : M4/6SNTS ENTRELEC SHORTING STRIP (ORANGE) SPRING LOADED TERMINALS
 - x D2.5/5 SN ADD ENTRELEC TERMINALS
 - M4/8 SF ENTRELEC FUSE TERMINALS
 - ' ENTRELEC ISNA168237R0500 TEST SOCKET - AL4 - DIA 4mm (INSTALLED IN CENTRE SPACING OF TERMINAL)
 - ▣ M4/6 RS SPRING LOADED ENTRELEC WITH RESISTOR INSERTED
- NOTE THAT D6/8 ST1 RS TERMINALS MAY BE USED IN PLACE OF D6/8-ST-RS TERMINALS. THE YELLOW INSULATED TEST POINTS MAY BE REMOVED FROM THE EARTH LINKS, AT THE COMMISSIONING TECHNICIANS DISCRETION.
 - FINE TOOTHED HORIZONTAL TRUNKING SHALL BE USED.

SHT No.	REFERENCE DRAWINGS:	DRG No.	REFERENCE DRAWINGS:
SHT 15	REA & MEAS KEY		
SHT 14	SPR REW, AC KEY		
SHT 13	INDICAT, DC KEY		
SHT 12	CLOSE DC KEY		
SHT 11	BACK-UP DC KEY		
SHT 10	BACK-UP DC KEY		
SHT 09	BACK-UP DC KEY		
SHT 08	TELEPROT DC KEY		
SHT 07	MAIN DC KEY		
SHT 06	MAIN DC KEY		
SHT 05	VT SUPPLY KEY		
SHT 04	AC KEY DIAGRAM		
SHT 03	SINGLE LINE		
SHT 02	LOGIC DIAGRAM		
SHT 01	PANEL LAYOUT		

66kV VT & CB ADDED, FEEDER RENAMED.		KS	BH	CP	25/06/2021	153272156-00003
REV	REVISION DESCRIPTION	BY	CHKD	AUTH	DATE	PROJECT NUMBER
PROJECT APPROVED C. PYM		DESIGN APPROVED A. CRAIB				
DATE 25/06/21		DATE 13/13/10				
PROJECT CHECKED B. HOMANN		DESIGN CHECKED N. MATHONSI				
DATE 25/06/21		DATE 13/12/10				
DRAWN BY K. STEYNBERG		DRAWN BY C. CANNON				
DATE 25/06/21		DATE 26/02/10				
REV	AUTH	DATE	REVISION TO MASTER	BY	CHKD	SCALE
-	-	-	-	-	-	-

ISCOR SUBSTATION

66kV FEEDER 2

PANEL CABLING DIAGRAM

D-WC-7104

SET NUMBER	SHEET NUMBER	REVISION
62	22	1


PANEL TYPE DESIGNATION 4FZD-3920



Terminal	Symbol	Terminal	Symbol	Terminal	Symbol	Terminal	Symbol
X4							
W4	: 49						
W3	: 48						
W2	: 47						
W1	: 46						
BSYNCH	: 45						
ASYNCH	: 44						
L141	: 43						
L139	: 42						
L137	: 41						
L135	: 40						
L133	: 39						
L131	: 38						
L102	● 37						
K502	● 36						
L101	● 35						
K501	● 34						
K502	● 33	K502A		X1.12A			
K523	● 32	K523A		X1.11			
K521	● 31						
K501	● 30						
K501	● A29	K515					
P17	● 28	P17AC					
P7	● 27	P7AC					
T7	● 26						
T3	● 25						
K302	○ 24	X102					
K301	○ 23	X101					
K302	● 22						
K301	● 21						
K302	● 20						
K301	● 19						
K302	● 18	K302B		X1.16			
K301	● 17	K301C		X1.15			
K391	● 16						
K389	● 15						
K301	● 14						
K387	● 13	K387		X2.6			
K385	● 12	K385		X2.5			
K301	● 11	K301E		X2.4			
K383	● 10	K383		X2.3			
K381	● 9	K381		X2.2			
K301	● 8	K301D		X2.1			
K302	● 7						
K377	● 6						
K301	● 5						
K375	● 4	K375A					
K301	● 3	K301A					
K373	● 2	K373		X1.28			
K301	● 1	K301B		X1.27			

CABLE NUMBER	AC115	AC105
CABLE SIZE	19	19
NUMBER OF SPARES	7	1
DESTINATION	66kV FEEDER 3 ISOLATOR JB	HV CIRCUIT BREAKER

Terminal	Terminal	Terminal	Terminal	Terminal	Terminal	Terminal	Terminal
X5							
X117	0 34	1b					
X115	0 33	1a					
X113	0 32	X113		X2.18			
X111	0 31	X111		X2.17			
X101	0 30	X101C		X2.16			
X109	0 29	X109		X2.15			
X107	0 28	X107		X2.14			
X101	0 27	X101D		X2.13			
X105	0 26	X105		X2.12			
X103	0 25	X103		X2.11			
X101	0 24	X101A		X2.10			
	: 23						
	: 22						
	: 21						
	: 20						
	: 19						
	: 18						
	: 17						
	: 16						
	: 15						
	: 14						
	: 13						
	: 12						
	: 11						
	: 10				X5.14		
	: 9				X5.13		
	: 8						
	: 7						
	: 6						
	: 5						
	: 4						
	: 3						
	: 2						
	: 1						

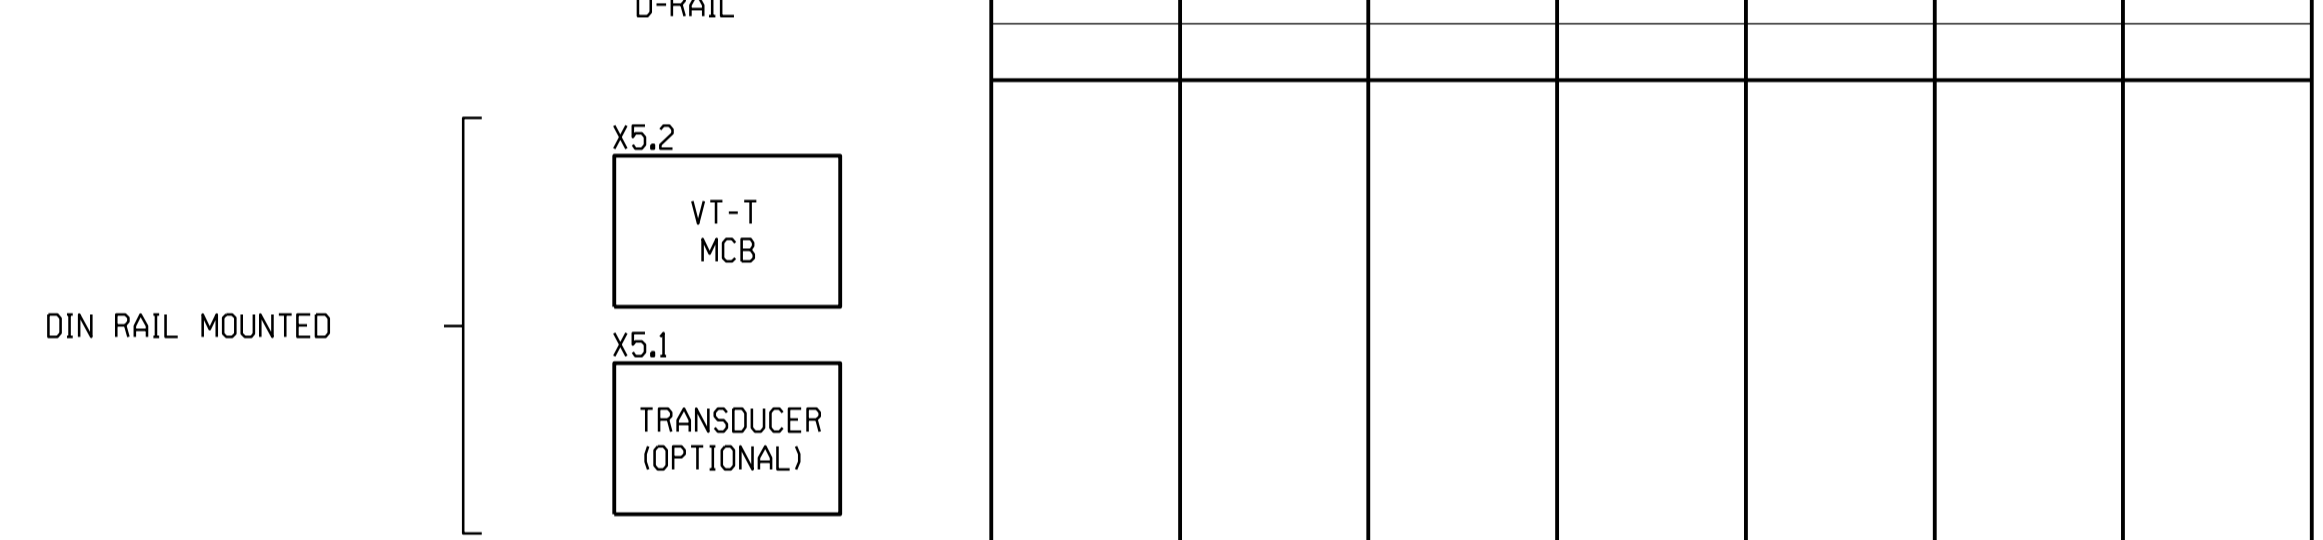

CABLE NUMBER	AC115	AA127	AC123
CABLE SIZE	19	4Pr	10Pr
NUMBER OF SPARES	7	3Pr	9Pr
DESTINATION	66kV FEEDER 3 ISOLATOR JB	66kV FEEDER 1 RP	IDF

LINE IS MB	Terminal
BB1 IS MB	X1.24 - X1.48
BB2 IS MB	X1.24 - X1.48

NOTE:

- SEE CABLE BLOCK DIAGRAM FOR PREFIXING.
STANDARD TERMINALS USED ARE ENTRELEC M10/10.RS
● D6/8-ST-RS ENTRELEC SLIDING LINK TEST TERMINAL
○ D6/8 ST1 RS TEST AND SHORTING LINKS WITH SAFETY CONNECTIONS (YELLOW INSULATED TEST POINTS)
⊗ M4/6 RS SPRING LOADED ENTRELEC
: M4/6SNTS ENTRELEC SHORTING STRIP (ORANGE) SPRING LOADED TERMINALS
x D2.5/5 SN ADD ENTRELEC TERMINALS
□ M4/8 SF ENTRELEC FUSE TERMINALS
ENTRELEC ISNA168237R0500 TEST SOCKET - AL4 - DIA 4mm (INSTALLED IN CENTRE SPACING OF TERMINAL)
⊞ M4/6 RS SPRING LOADED ENTRELEC WITH RESISTOR INSERTED
- NOTE THAT D6/8 ST1 RS TERMINALS MAY BE USED IN PLACE OF D6/8-ST-RS TERMINALS. THE YELLOW INSULATED TEST POINTS MAY BE REMOVED FROM THE EARTH LINKS, AT THE COMMISSIONING TECHNICIANS DISCRETION.
- THE DROPPING RESISTORS HAVE BEEN REMOVED FROM THE X5 RACK AT THE REQUEST OF ABB.

SHT No.	DESCRIPTION
SHT 28	ISOLATOR JB
SHT 27	CABLE BLOCK
SHT 26	LINE VT DIAGRAM
SHT 25	CT JB CABLING
SHT 24	CABLING DIAGRAM
SHT 23	CABLING DIAGRAM
SHT 22	CABLING DIAGRAM
SHT 21	REFERENCE DIAG
SHT 20	REFERENCE DIAG
SHT 19	REFERENCE DIAG
SHT 18	DISTUR RECORDER
SHT 17	SUP ALARMS KEY
SHT 16	SUP STATUS, CONT
SHT 15	REA & MEAS KEY
SHT 14	SPR REW, AC KEY
SHT 13	INDICAT, DC KEY
SHT 12	CLOSE DC KEY
SHT 11	BACK-UP DC KEY
SHT 10	BACK-UP DC KEY
SHT 09	BACK-UP DC KEY
SHT 08	TELEPROT DC KEY
SHT 07	MAIN DC KEY
SHT 06	MAIN DC KEY
SHT 05	VT SUPPLY KEY
SHT 04	AC KEY DIAGRAM
SHT 03	SINGLE LINE
SHT 02	LOGIC DIAGRAM
SHT 01	PANEL LAYOUT
DRG No.	REFERENCE DRAWINGS:


Eskom

ISCOR SUBSTATION
66kV FEEDER 2
PANEL CABLING DIAGRAM

D-WC-7104

SET NUMBER: 62 | SHEET NUMBER: 23 | REVISION: 1

PANEL TYPE DESIGNATION: 4FZD-3920

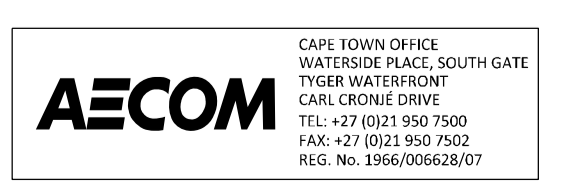


REV	AUTH	DATE	REVISION TO MASTER	BY	CHKD	SCALE
-	-	-	-	-	-	-

MASTER TRACING FILED UNDER D-DT-15007 SHEET 23 OF 28 REVISION 2

TOP OF TERMINAL STRIP

To CURRENT TRANSFORMERS				X1
		6S5	D171B	36
		6S1	D151	35
		5S5	D71B	34
		5S1	D51	33
		4S2	C71B	32
		4S1	C51	31
		3S5	B71B	30
		3S1	B51	29
		2S5	B171B	28
		2S1	B150	27
		1S2	A71B	26
		1S1	A51	25
	6S5		D171W	24
	6S1		D131	23
	5S5		D71W	22
	5S1		D31	21
	4S2		C71W	20
	4S1		C31	19
	3S5		B71W	18
	3S1		B31	17
	2S5		B171W	16
	2S1		B130	15
	1S2		A71W	14
	1S1		A31	13
6S5			D171R	12
6S1			D111	11
5S5			D71R	10
5S1			D11	9
4S2			C71R	8
4S1			C11	7
3S5			B71R	6
3S1			B11	5
2S5			B171R	4
2S1			B110	3
1S2			A71R	2
1S1			A11	1

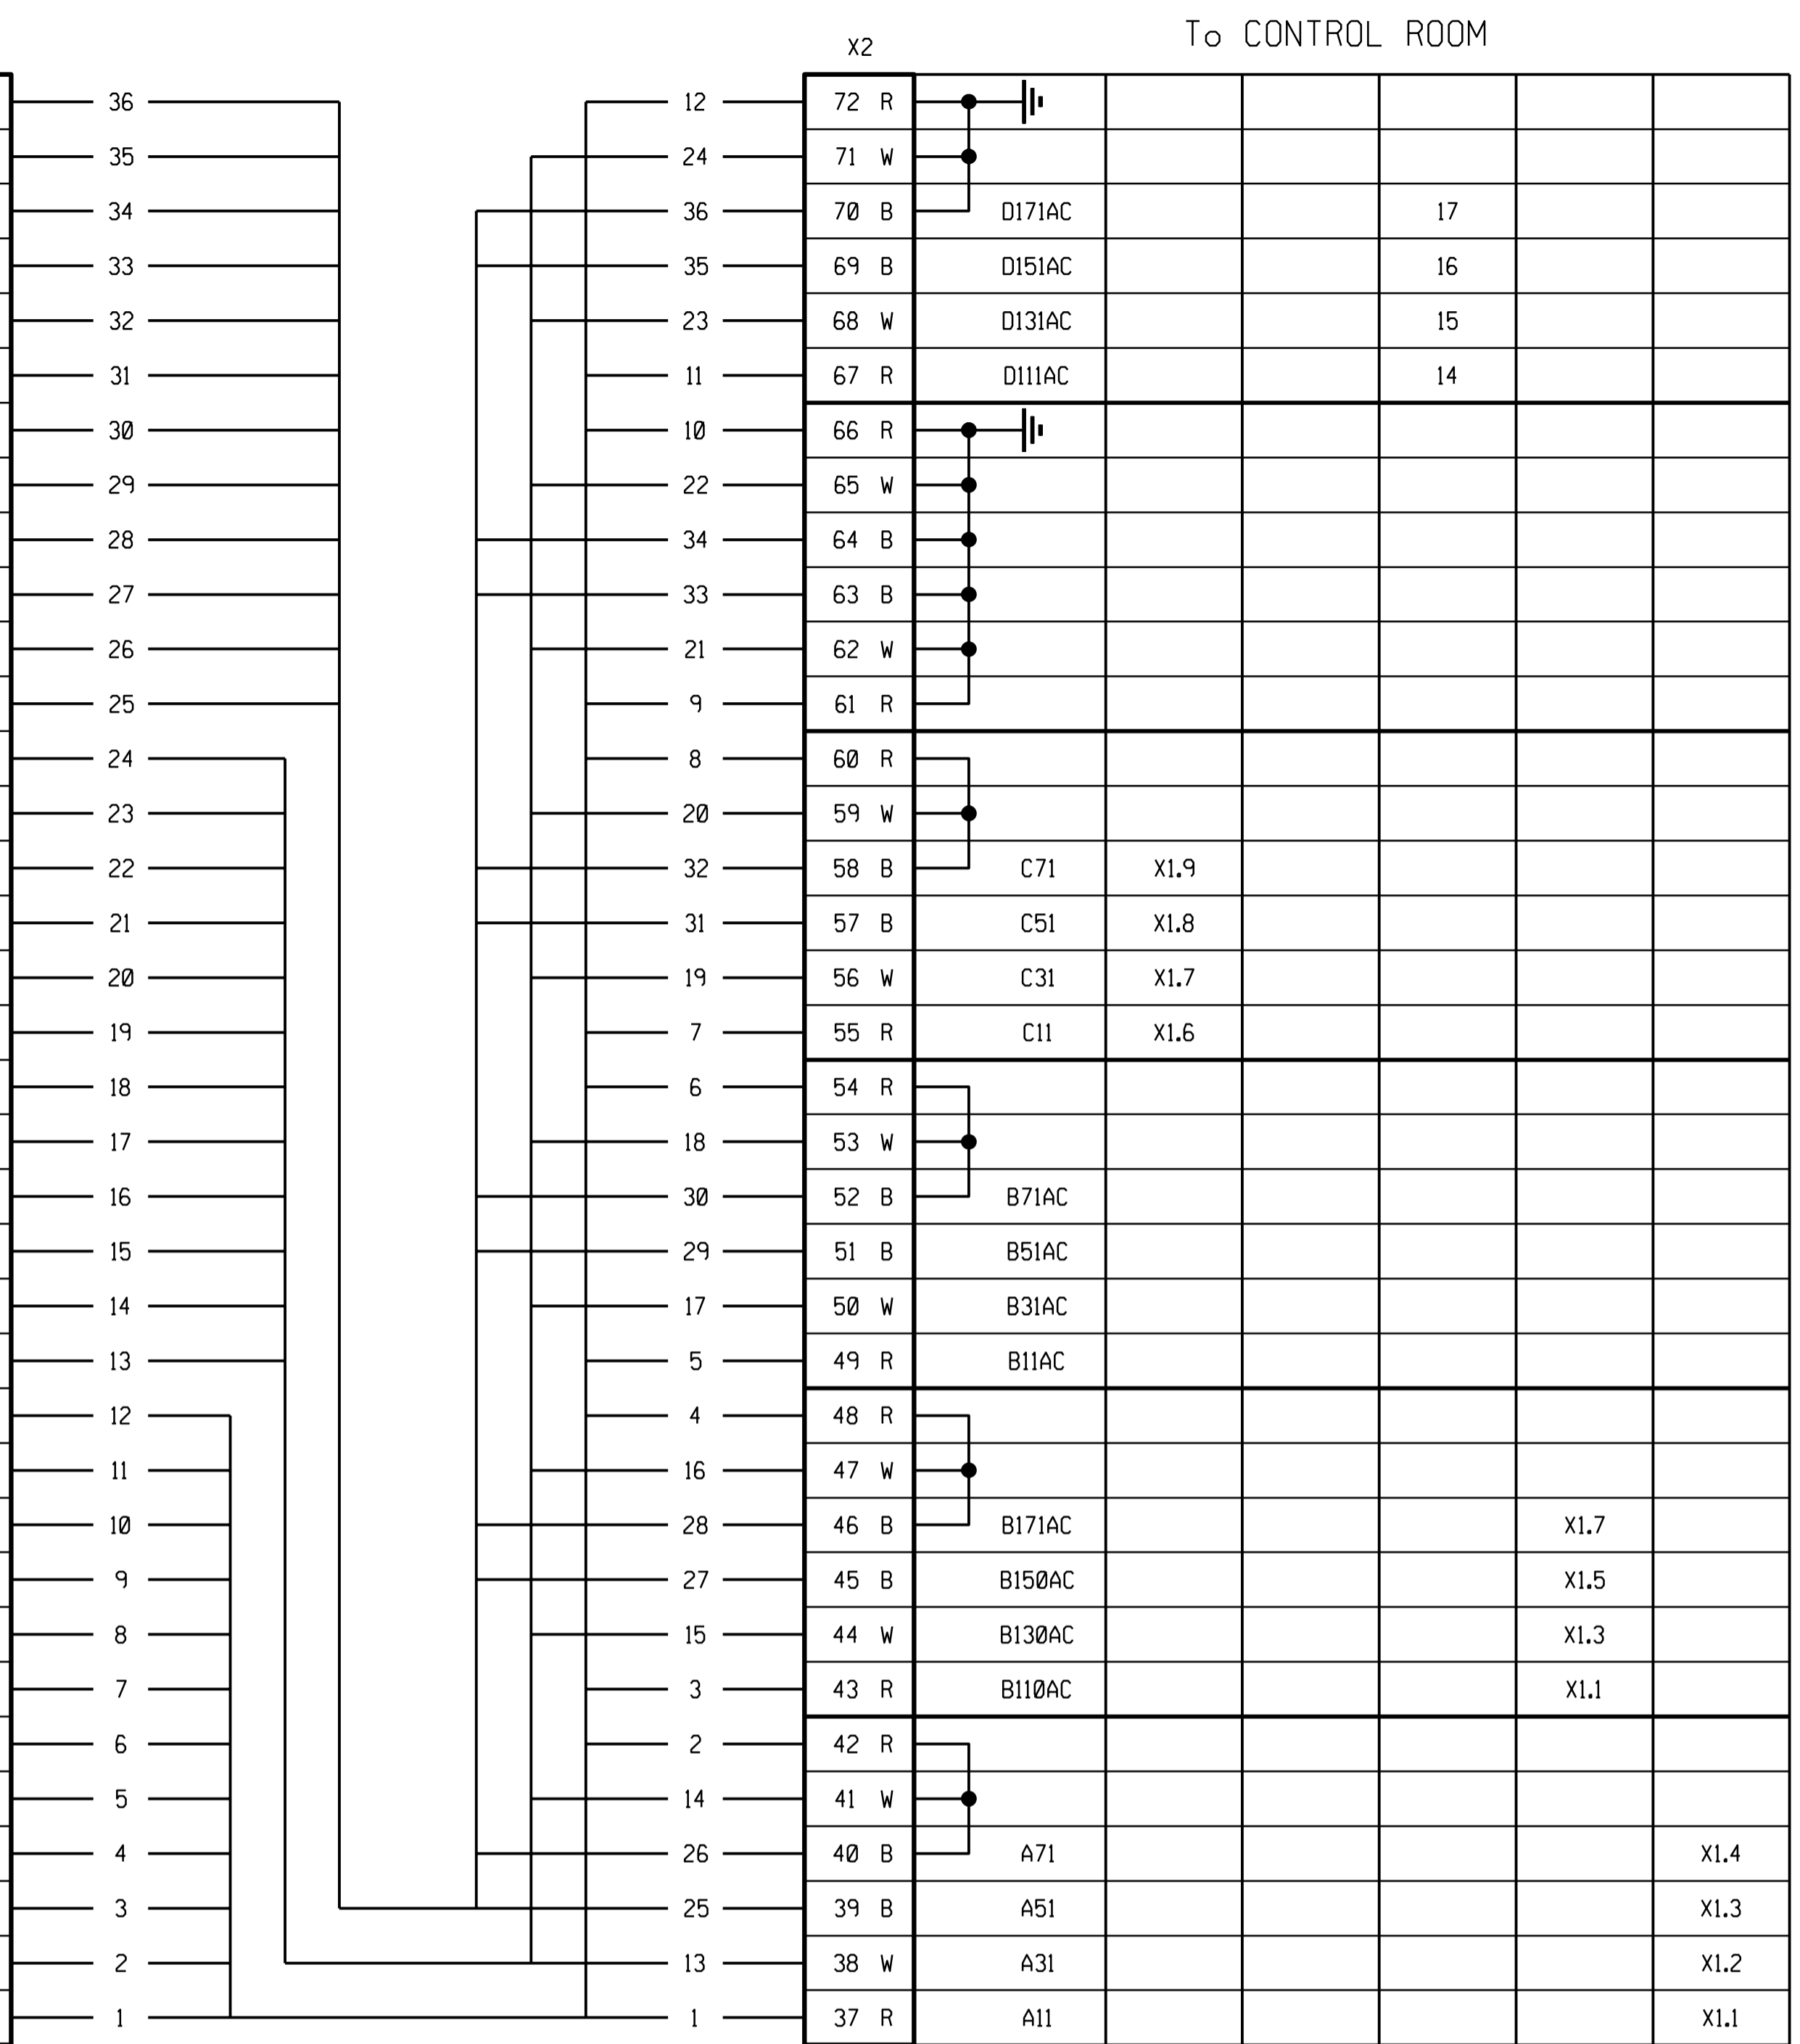

CABLE NUMBER	AC104	AC118	AC126	EB504
CABLE SIZE	12	4	4	12
NUMBER OF SPARES	8	0	0	8
DESTINATION	66kV FEEDER 1 RELAY PANEL	STATISTICAL METERING PANEL	66kV FEEDER 2 ISOLATOR JB	66/11kV TRANSFORMER 2 RELAY PANEL

AC101	AC102	AC103	CABLE NUMBER
12	12	12	CABLE SIZE
0	0	0	NUMBER OF SPARES
66kV FEEDER 1 66kV RED PHASE CT	66kV FEEDER 1 66kV WHITE PHASE CT	66kV FEEDER 1 66kV BLUE PHASE CT	DESTINATION

TERMINAL LOOPS (*)	
CT JB	40-41-42, 46-47-48, 52-53-54, 58-59-60, 61-62-63-64-65-66-E; 70-71-72-E.

SHT 28	ISOLATOR JB
SHT 27	CABLE BLOCK
SHT 26	LINE VT DIAGRAM
SHT 25	CT JB CABLING
SHT 24	CABLING DIAGRAM
SHT 23	CABLING DIAGRAM
SHT 22	CABLING DIAGRAM
SHT 21	REFERENCE DIAG
SHT 20	REFERENCE DIAG
SHT 19	REFERENCE DIAG
SHT 18	DISTUR RECORDER
SHT 17	SUP ALARMS KEY
SHT 16	SUP STATUS, CONT
SHT 15	REA & MEAS KEY
SHT 14	SPR REW, AC KEY
SHT 13	INDICAT, DC KEY
SHT 12	CLOSE DC KEY
SHT 11	BACK-UP DC KEY
SHT 10	BACK-UP DC KEY
SHT 09	BACK-UP DC KEY
SHT 08	TELEPROT DC KEY
SHT 07	MAIN DC KEY
SHT 06	MAIN DC KEY
SHT 05	VT SUPPLY KEY
SHT 04	AC KEY DIAGRAM
SHT 03	SINGLE LINE
SHT 02	LOGIC DIAGRAM
SHT 01	PANEL LAYOUT
DRG No.	REFERENCE DRAWINGS:

1	66kV VT & CB ADDED, FEEDER RENAMED.	KS	BH	CP	25/06/2021	153272156-00003
REV	REVISION DESCRIPTION	BY	CHKD	AUTH	DATE	PROJECT NUMBER

Eskom

PROJECT APPROVED
C. PYM

DESIGN APPROVED
A. CRAIB

DATE 25/06/21 DATE 13/13/10

PROJECT CHECKED
B. HOMANN

DESIGN CHECKED
N. MATHONSI

DATE 25/06/21 DATE 13/12/10

DRAWN BY
K. STEYBERG

CHECKED BY
C. CANNON

DATE 25/06/21 DATE 26/02/10

REV AUTH DATE REVISION TO MASTER BY CHKD SCALE

ISCOR SUBSTATION


66kV FEEDER 2

CTJB CABLING DIAGRAM

D-WC-7104

SET NUMBER	SHEET NUMBER	REVISION
62	25	1

PANEL TYPE DESIGNATION 4FZD-3920

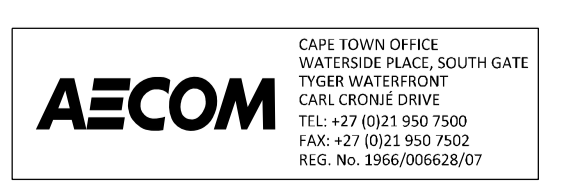

LEVELS	1	2	5	10	11	12	20	21	22	28
REV										


MASTER TRACING FILED UNDER D-DT-15007 SHEET 25 OF 28 REVISION 2

(NOT USED)



SHT 28	ISOLATOR JB
SHT 27	CABLE BLOCK
SHT 26	LINE VT DIAGRAM
SHT 25	CT JB CABLING
SHT 24	CABLING DIAGRAM
SHT 23	CABLING DIAGRAM
SHT 22	CABLING DIAGRAM
SHT 21	REFERENCE DIAG
SHT 20	REFERENCE DIAG
SHT 19	REFERENCE DIAG
SHT 18	DISTUR RECORDER
SHT 17	SUP ALARMS KEY
SHT 16	SUP STATUS, CONT
SHT 15	REA & MEAS KEY
SHT 14	SPR REW, AC KEY
SHT 13	INDICAT, DC KEY
SHT 12	CLOSE DC KEY
SHT 11	BACK-UP DC KEY
SHT 10	BACK-UP DC KEY
SHT 09	BACK-UP DC KEY
SHT 08	TELEPROT DC KEY
SHT 07	MAIN DC KEY
SHT 06	MAIN DC KEY
SHT 05	VT SUPPLY KEY
SHT 04	AC KEY DIAGRAM
SHT 03	SINGLE LINE
SHT 02	LOGIC DIAGRAM
SHT 01	PANEL LAYOUT
DRG No.	REFERENCE DRAWINGS:

153272156-00003						
REV	REVISION DESCRIPTION	BY	CHKD	AUTH	DATE	PROJECT NUMBER
PROJECT APPROVED		DESIGN APPROVED				
C. PYM		A. CRAIB				
DATE 25/06/21		DATE 13/13/10				
PROJECT CHECKED		DESIGN CHECKED				
B. HOMANN		N. MATHONSI				
DATE 25/06/21		DATE 13/12/10				
DRAWN BY		DRAWN BY				
K. STEYNBERG		C. CANNON				
DATE 25/06/21		DATE 26/02/10				
D-WC-7104				SET NUMBER	SHEET NUMBER	REVISION
				62	26	0


REV	AUTH	DATE	REVISION TO MASTER	BY	CHKD	SCALE
-	-	-	-	-	-	-

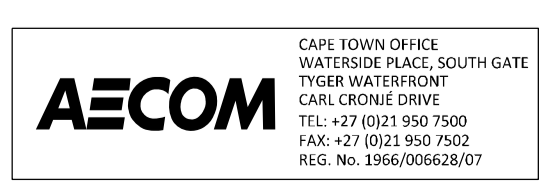


FRONT VIEW

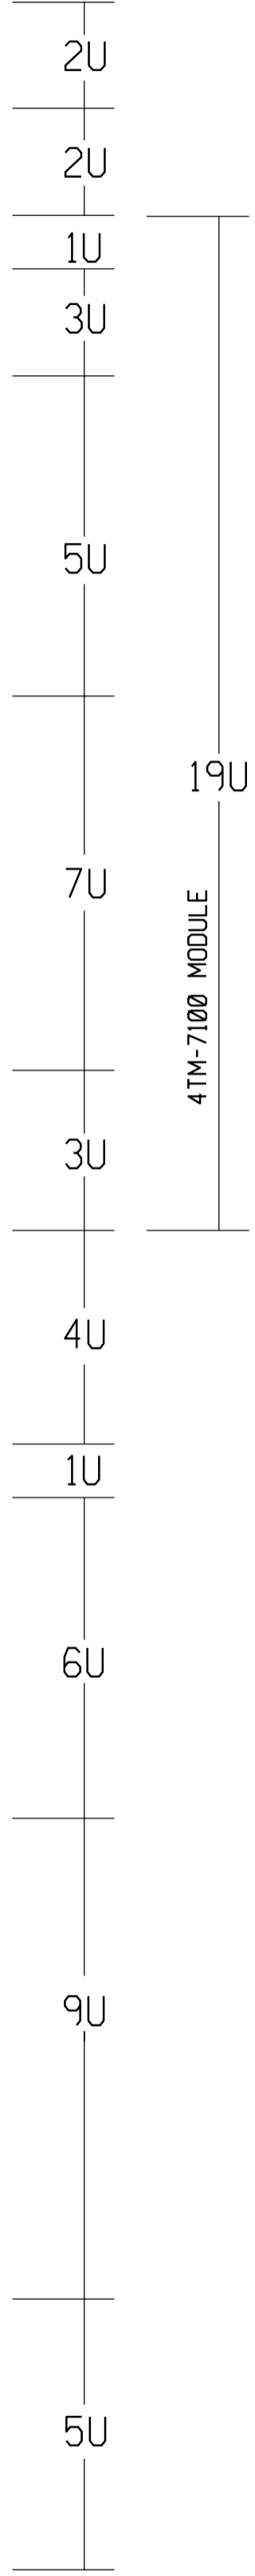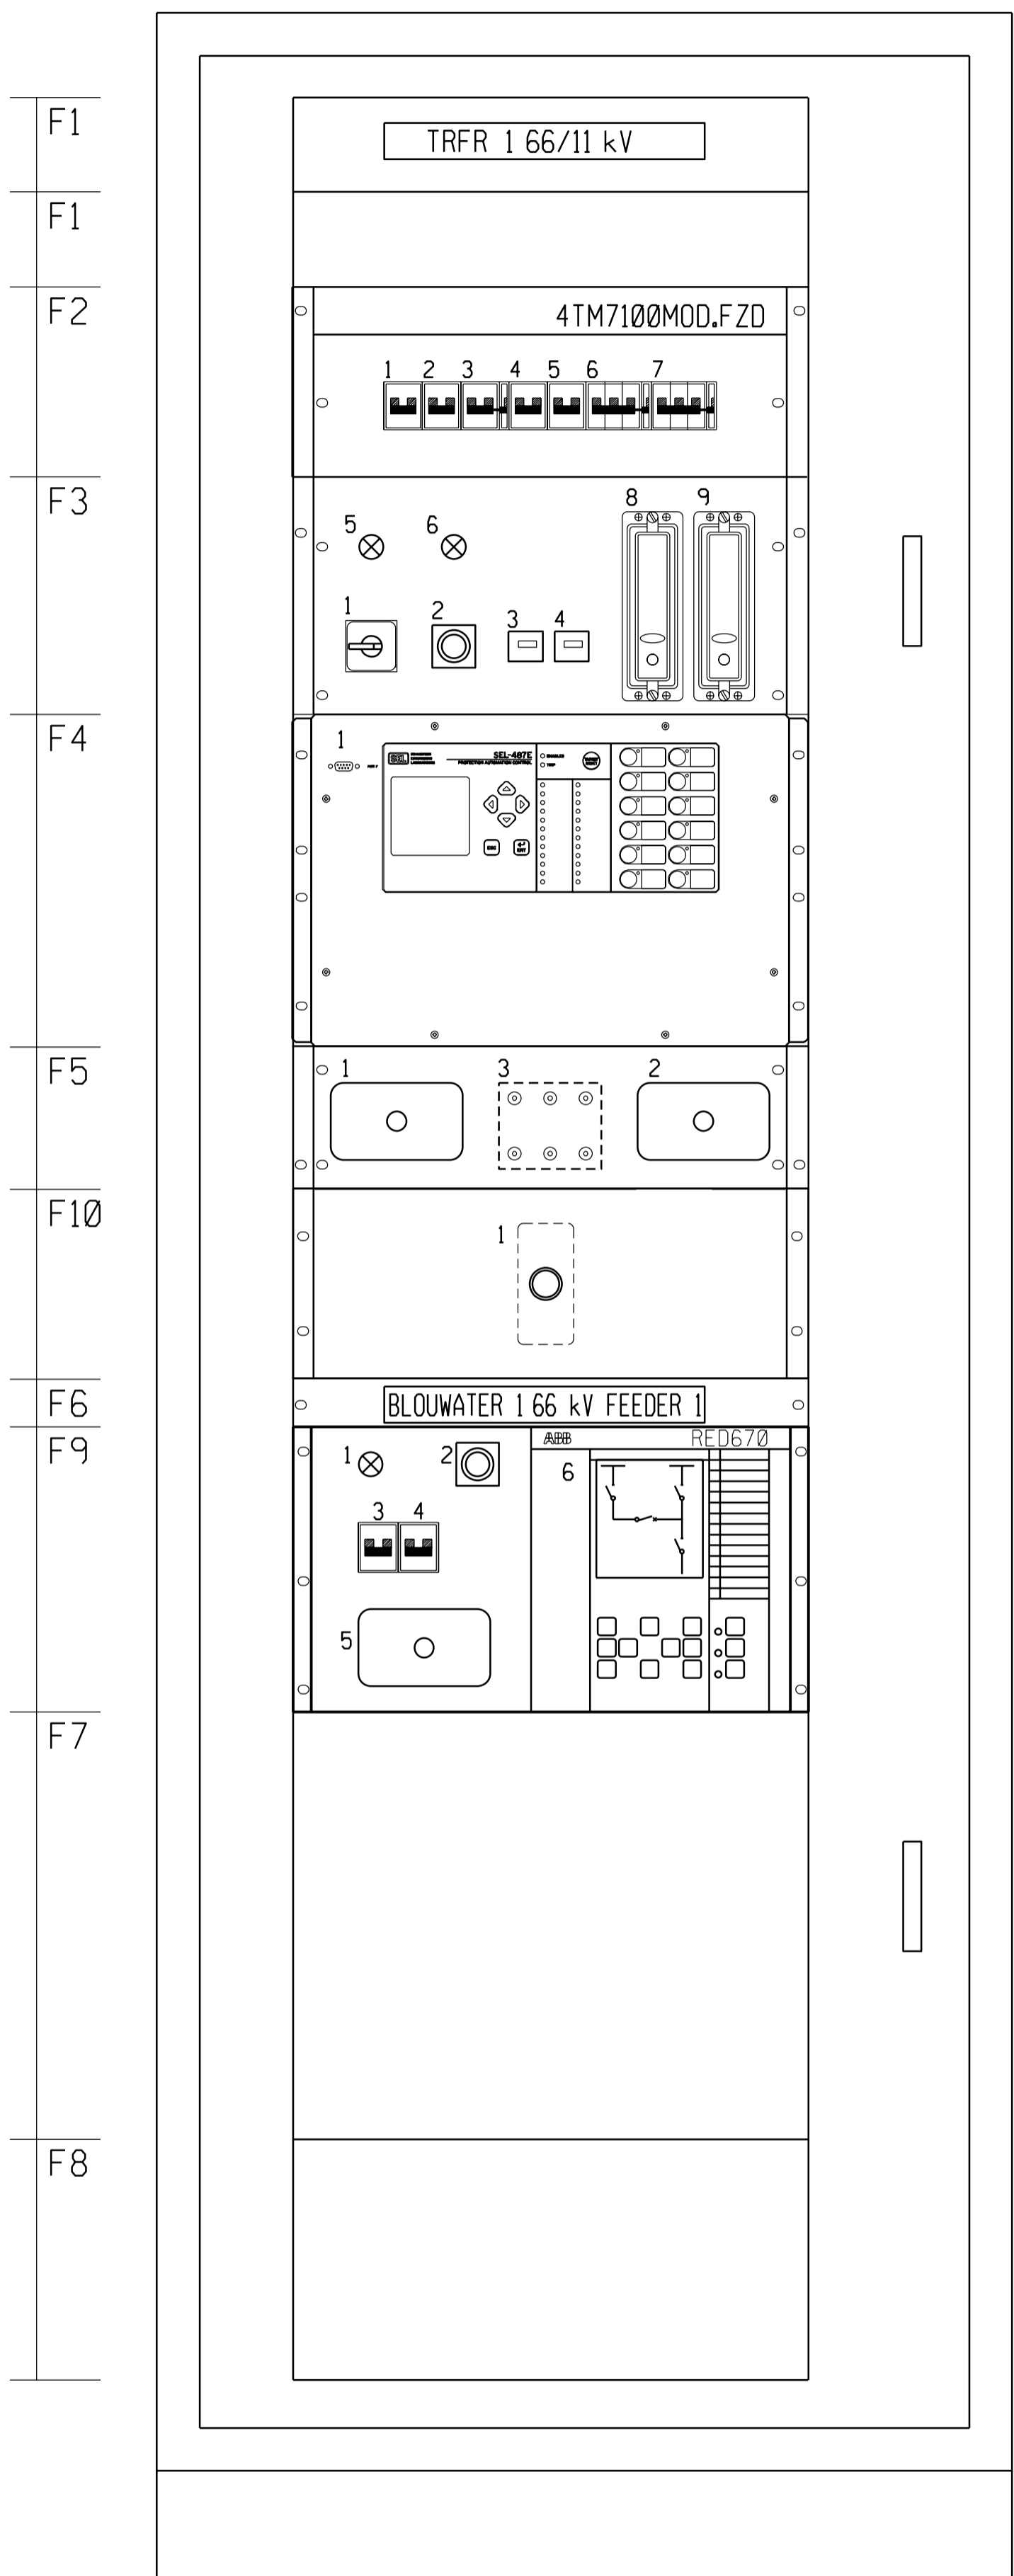

REAR OF MODULE

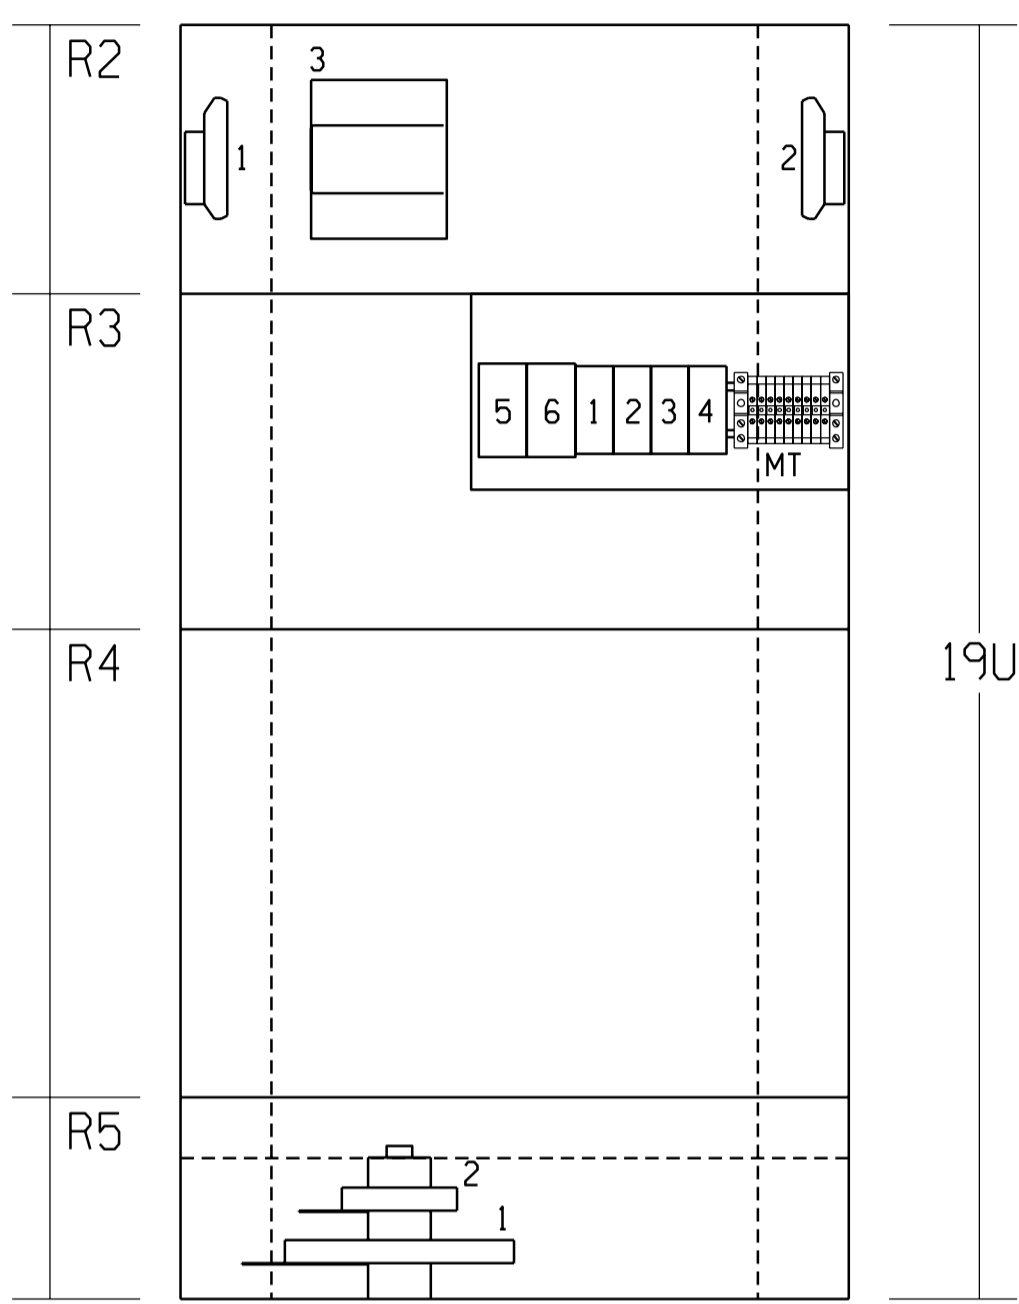


TERMINAL BACK PLATE

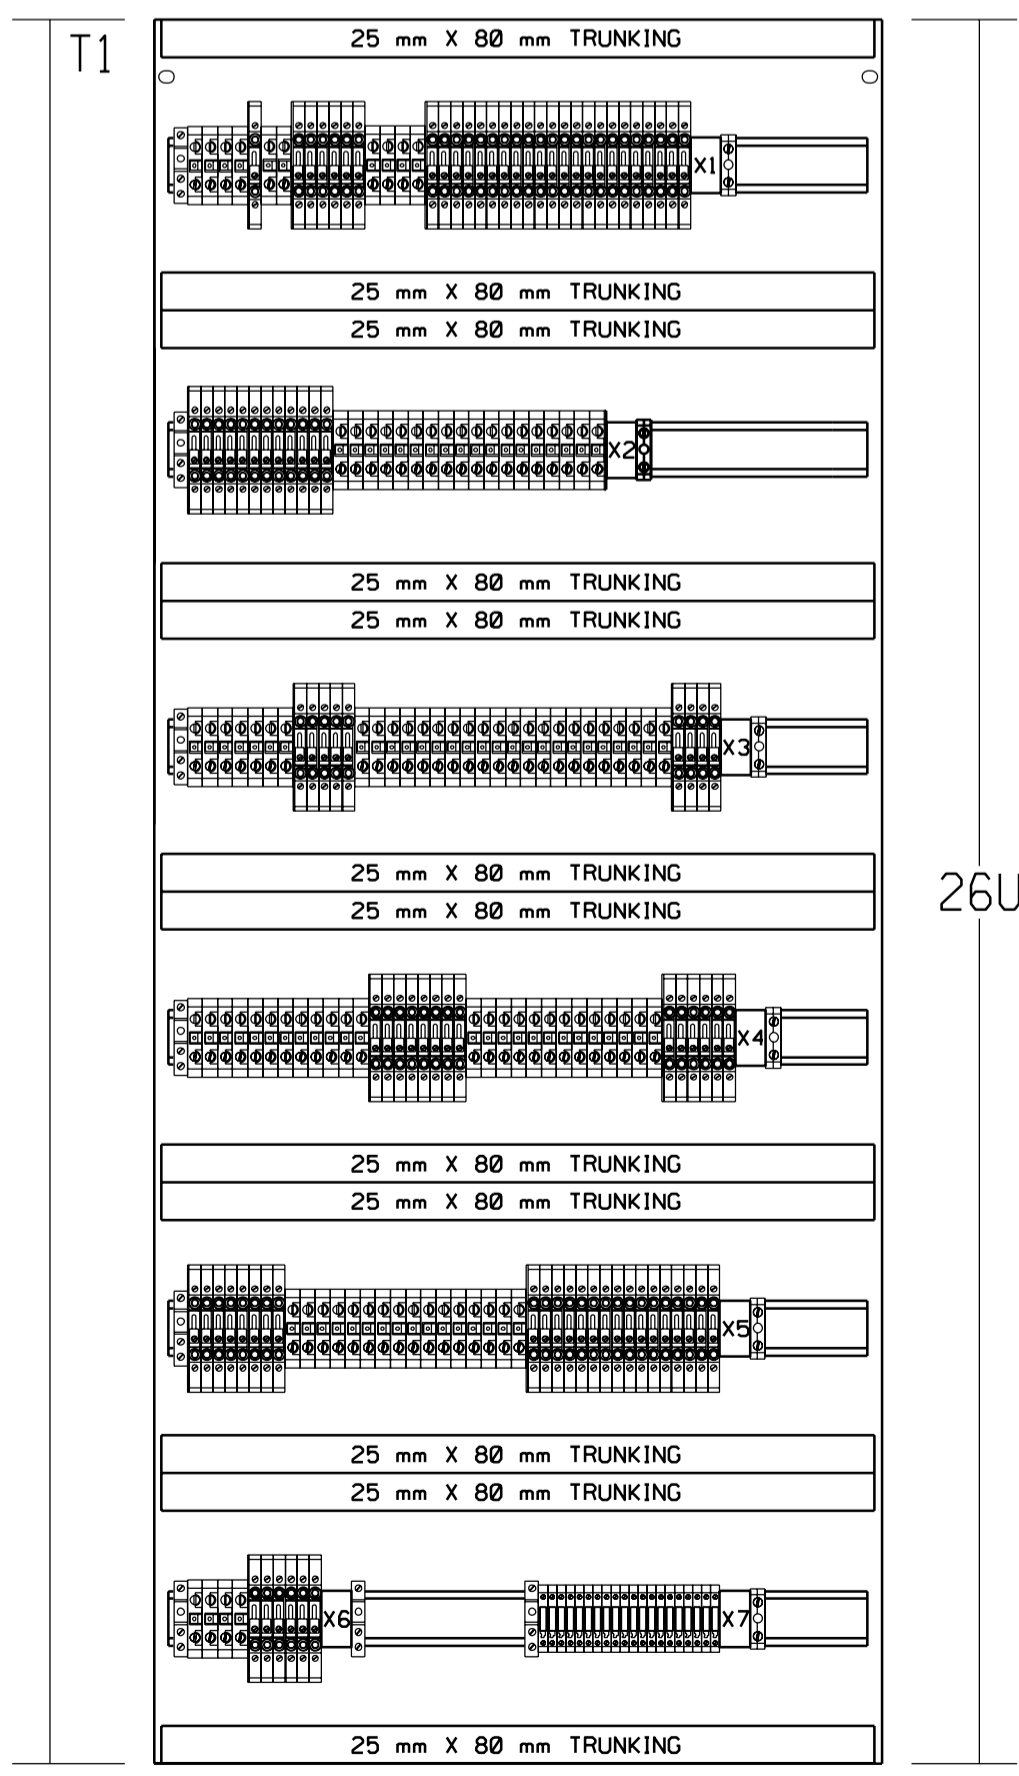

LOCATION	DESIGNATION	DESCRIPTION	TYPE	MANUFACTURER
FRONT VIEW				
F1		BLANKING PLATE		
F2	1	DC1 MCB (M)	DC ISOLATE MINIATURE CIRCUIT-BREAKER (MAIN CCT) (16A)	EP102UC(C16)
	2	DC1 MCB (BU)	DC ISOLATE MINIATURE CIRCUIT-BREAKER (BACK-UP CCT) (16A)	EP102UC(C16)
	3	DC1 MCB (SR)	DC ISOLATE MINIATURE CIRCUIT-BREAKER (SPRING REWIND) (20A)	EP102UC(C20)
	4	MCB (AC)	AC ISOLATE MINIATURE CIRCUIT-BREAKER (10A)	G62(C10) & CA H
	5	MCB (H)	HEATER SUPPLY AC MINIATURE CIRCUIT-BREAKER (6A)	G62(C06)
	6	MCB (VT-HV)	HV VOLTAGE TRANSFORMER MINIATURE CIRCUIT-BREAKER (2A)	G63(C02) & CA H
	7	MCB (VT-MV)	HV VOLTAGE TRANSFORMER MINIATURE CIRCUIT-BREAKER (2A)	G63(C02) & CA H
F3	1	BF1	CIRCUIT-BREAKER FAIL ISOLATE SWITCH	CA-10
	2	ETPB	EMERGENCY TRIP PUSH BUTTON WITH COVER (RED)	MP1-10R / MCBH-20
	3	FC (HV)	HV CIRCUIT-BREAKER FAULT/TRIP COUNTER (3 DIGIT)	3099
	4	FC (MV)	MV CIRCUIT-BREAKER FAULT/TRIP COUNTER (3 DIGIT)	3099
	5	PNH-I	PROTECTION NOT HEALTHY INDICATION (AMBER)	KRE-222-UL (230Vac)
	6	MTR-I	MASTER TRIP OPERATED INDICATION (RED)	KRE-222-UN
	8	(HI-Z) HV REF	HV HIGH IMPEDANCE RESTRICTED EARTH FAULT PROTECTION RELAY	2V73-AAA
	9	(HI-Z) MV REF	MV HIGH IMPEDANCE RESTRICTED EARTH FAULT PROTECTION RELAY	2V73-AAA
F4	1	SEL-487E	TRANSFORMER PROTECTION AND CONTROL RELAY	SEL-487E
F5	1	CTTB(HV)	HV DIFFERENTIAL CURRENT TRANSFORMER TEST BLOCK	PK2 4-WAY
	2	CTTB(MV)	MV DIFFERENTIAL CURRENT TRANSFORMER TEST BLOCK	PK2 4-WAY
	3	TPI-TP6	BANANA PLUG TEST POINTS (BLACK)	RC11 BK
F6		BLANKING PLATE		
F7		BLANKING PLATE		
F8		BLANKING PLATE		
F9	1	PNH-I	PROTECTION NOT HEALTHY INDICATION (RED 670) (AMBER)	KRE-222-UL (230 Vac)
	2	TTPB	TRIP TEST PUSH BUTTON WITH COVER (RED)	CP10-10R-10/ YSF
	3	DC1 MCB (M)	DC ISOLATE MINIATURE CIRCUIT-BREAKER (RED 670 CCT) (5A)	EP102UC(C5)
	4	MCB (AC)	AC ISOLATE MINIATURE CIRCUIT-BREAKER (RED 670 CCT) (2A)	G62(C2)
	5	CTTB(HV) - 2	HV DIFFERENTIAL CURRENT TRANSFORMER TEST BLOCK (RED 670)	PK2 4-WAY
	6	RED 670	LINE PROTECTION AND CONTROL RELAY	RED 670
F10	1	IS20	ARC FAULT RELAY	IS20(CAA)
REAR OF MODULE				
R2	1	DB1	DIODE BOARD 1 (8 TRIPPING DIODES)	10200
	2	DB2	DIODE BOARD 2 (8 TRIPPING DIODES)	10200
	3	MTR	MASTER TRIP RELAY	BJ8T **
R3		MT	MODULE TERMINALS	M4/6
	1	AS-HVM	HV MAIN TRIPPING CIRCUIT ARC SUPPRESSOR	SEL-9501
	2	AS-HVBU	HV BACK-UP TRIPPING CIRCUIT ARC SUPPRESSOR	SEL-9501
	3	AS-MVM	MV MAIN TRIPPING CIRCUIT ARC SUPPRESSOR	SEL-9501
	4	AS-MVBU	MV BACK-UP TRIPPING CIRCUIT ARC SUPPRESSOR	SEL-9501
	5	SEL-2885	ADDRESSABLE RS-232 TO RS-485 CONVERTER (REMOTE ENG. ACCESS)	SEL-2885
	6	SEL-2886	RS-232 TO RS-485 CONVERTER (SCADA COMMUNICATION)	SEL-2886
R4			REAR OF SEL-487E RELAY	
R5	1	HV METROSIL	SINGLE PHASE METROSIL FOR HI-Z HV REF RELAY (6 INCH)	600A/S1/S887
	2	MV METROSIL	SINGLE PHASE METROSIL FOR HI-Z MV REF RELAY (3 INCH)	300A/S1/S646
TERMINAL BACK PLATE				
T1	X1-X7		TERMINAL RAILS (RAISED FROM BACK PLATE BY 70 mm STAND-OFF POSTS). SCHEME WIRING TERMINATED AT BOTTOM SIDE OF TERMINAL STRIPS. REFER TO SHTs 20 - 22 FOR TERMINAL BLOCK MAKES AND TYPES	
T2	X8		TERMINAL RAILS SCHEME WIRING TERMINATED AT BOTTOM SIDE OF TERMINAL STRIPS. REFER TO SHT 22 FOR TERMINAL BLOCK MAKES AND TYPES	
	1	IRF-X	RED670 PNH AUXILIARY RELAY (110=110V DC)	CR-U110DC3L

** SPECIFY 110 Vdc OR 220 Vdc

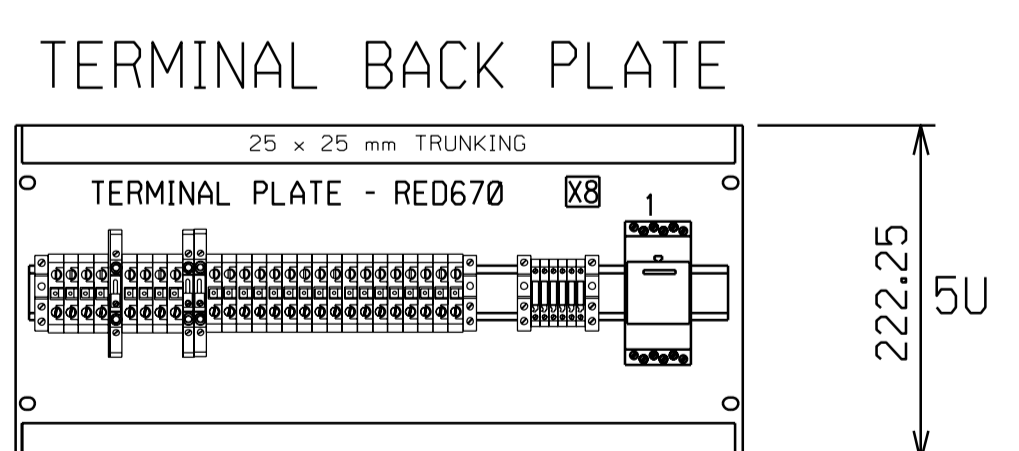

SHEET 8	AC KEY DIAGRAM	SHEET 17	SPR REV DC AC KEY DIAGRAM	SHEET 25	RED670 REFERENCE DIAGRAM
SHEET 7	RELAY LOGIC DIAGRAM	SHEET 16	BACK-UP DC KEY DIAGRAM	SHEET 24	RED670 AC/DC & SUP. KEY DIAGRAM
SHEET 6	RELAY LOGIC DIAGRAM	SHEET 15	BACK-UP DC KEY DIAGRAM	SHEET 23	HV CT JB CABLING DIAGRAM
SHEET 5	RELAY LOGIC DIAGRAM	SHEET 14	BACK-UP DC KEY DIAGRAM	SHEET 22	PANEL CABLING DIAGRAM
SHEET 4	RELAY LOGIC DIAGRAM	SHEET 13	MAIN DC KEY DIAGRAM	SHEET 21	PANEL CABLING DIAGRAM
SHEET 3	SCHEME LOGIC DIAGRAM	SHEET 12	MAIN DC KEY DIAGRAM	SHEET 20	PANEL CABLING DIAGRAM
SHEET 2	FRONT PANEL LABELS	SHEET 11	VT SUPPLY KEY DIAGRAM	SHEET 19	REFERENCE DIAGRAM
SHEET 1	PANEL EQUIPMENT LAYOUT	SHEET 10	AC KEY DIAGRAM	SHEET 18	SUPERVISORY/COMMS KEY DIAG
SHEET 0	COVER SHEET	SHEET 9	AC KEY DIAGRAM		

AECOM
CAPE TOWN OFFICE
WATERSIDE PLACE, SOUTH GATE
TYGER WATER FRONT
CARL CRONJE DRIVE
TEL: +27 (0)21 950 7500
FAX: +27 (0)21 950 7502
REG. No. 19666/006628/07

Eskom

ISCOR SUBSTATION
66/11 kV TRANSFORMER 1
PANEL EQUIPMENT LAYOUT

D-WC-7104 81 01 0

PROJECT APPROVED: C. PYM DESIGN APPROVED: S.J. van ZYL
DATE 25/06/21 DATE 11/06/18
PROJECT CHECKED: B. HOMANN DESIGN CHECKED: P.A. GERBER
DATE 25/06/21 DATE 11/06/18
DRAWN BY: K. STEYNBERG S.J. van ZYL
DATE 25/06/21 DATE 17/09/09




REVISION TO MASTER: 1 SvZ 15/11/2010 CHANGES AS PER SHEET 0 - COVER SHEET. 1 SvZ 25/06/21

SCALE: 1:5

1. 1U = 44.45mm
THE SCHEME IS DESIGNED FOR MOUNTING A 19 INCH RACK SYSTEM AS PER IEC 60297.
THE MODULE AND BACK PLATE ARE 482.6mm WIDE. THE MODULE IS 300mm DEEP.

SHEET 1 OF 26 REVISION 1 MASTER TRACING FILED UNDER D-DT-15202

DETAIL OF SEL-487E PROGRAMMABLE LEDs AND PUSH BUTTONS

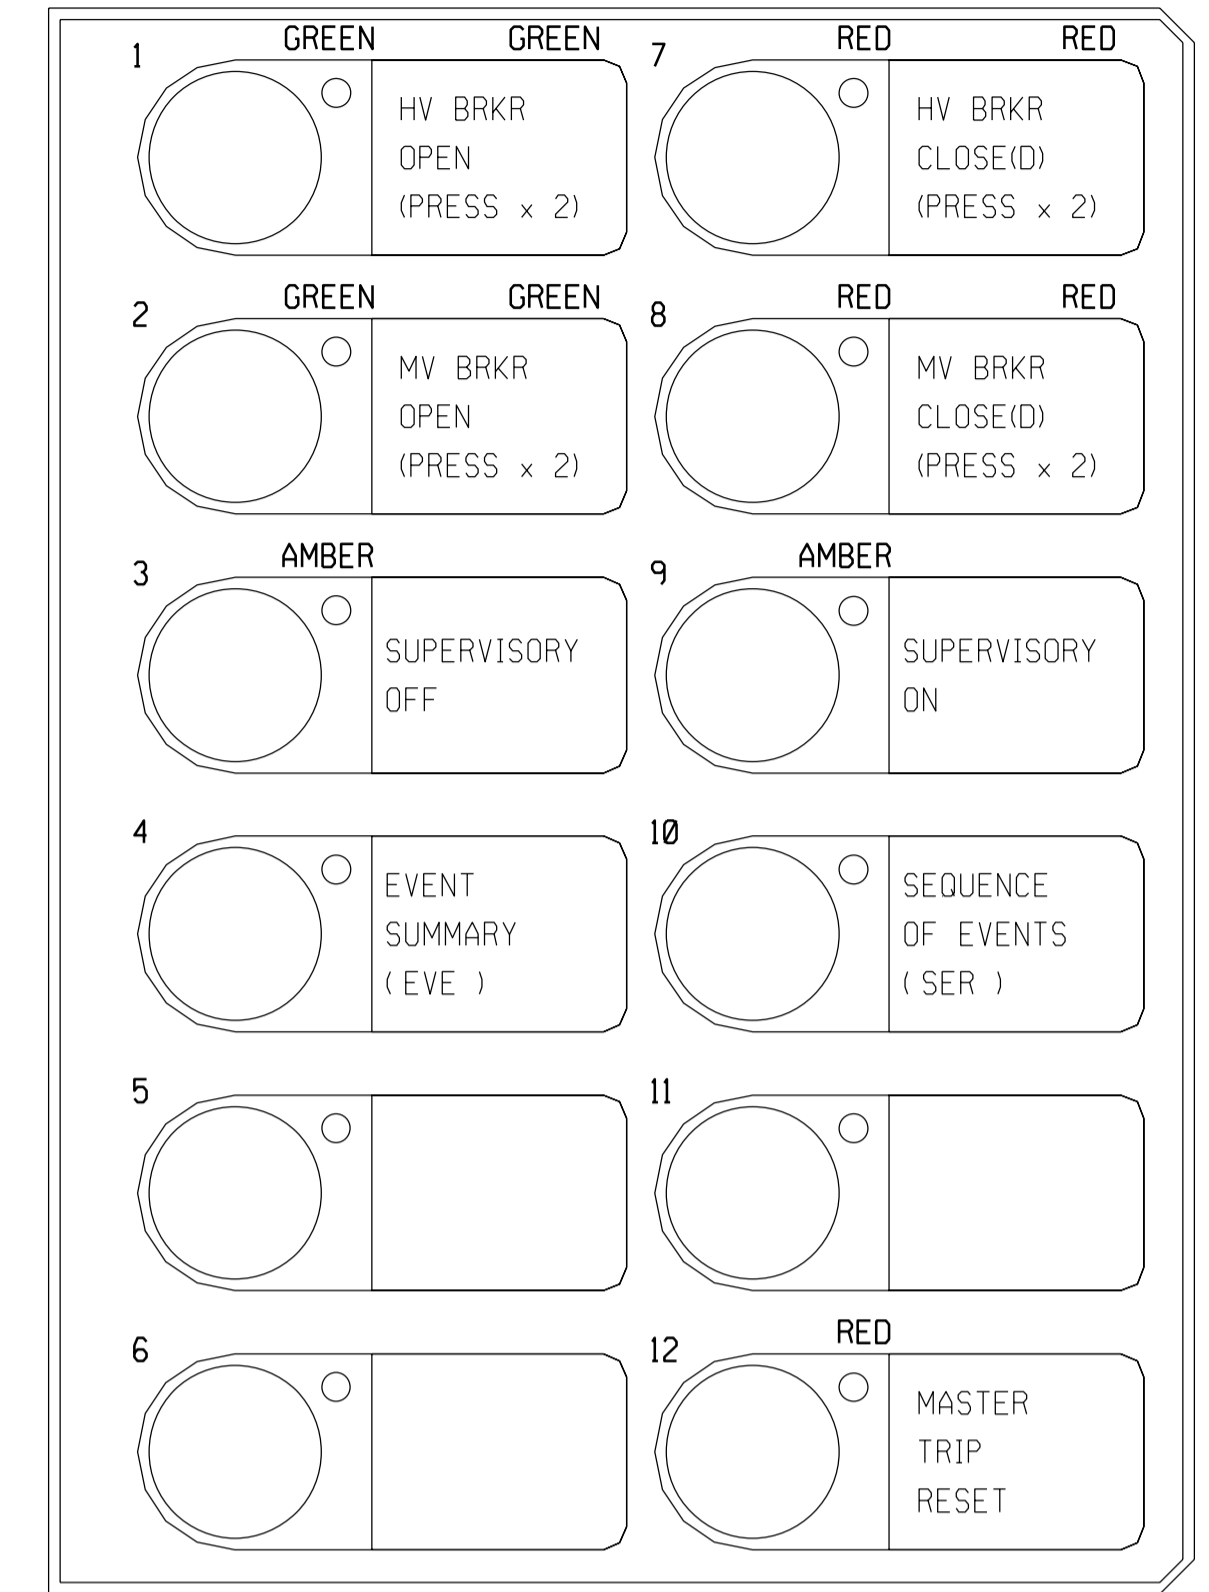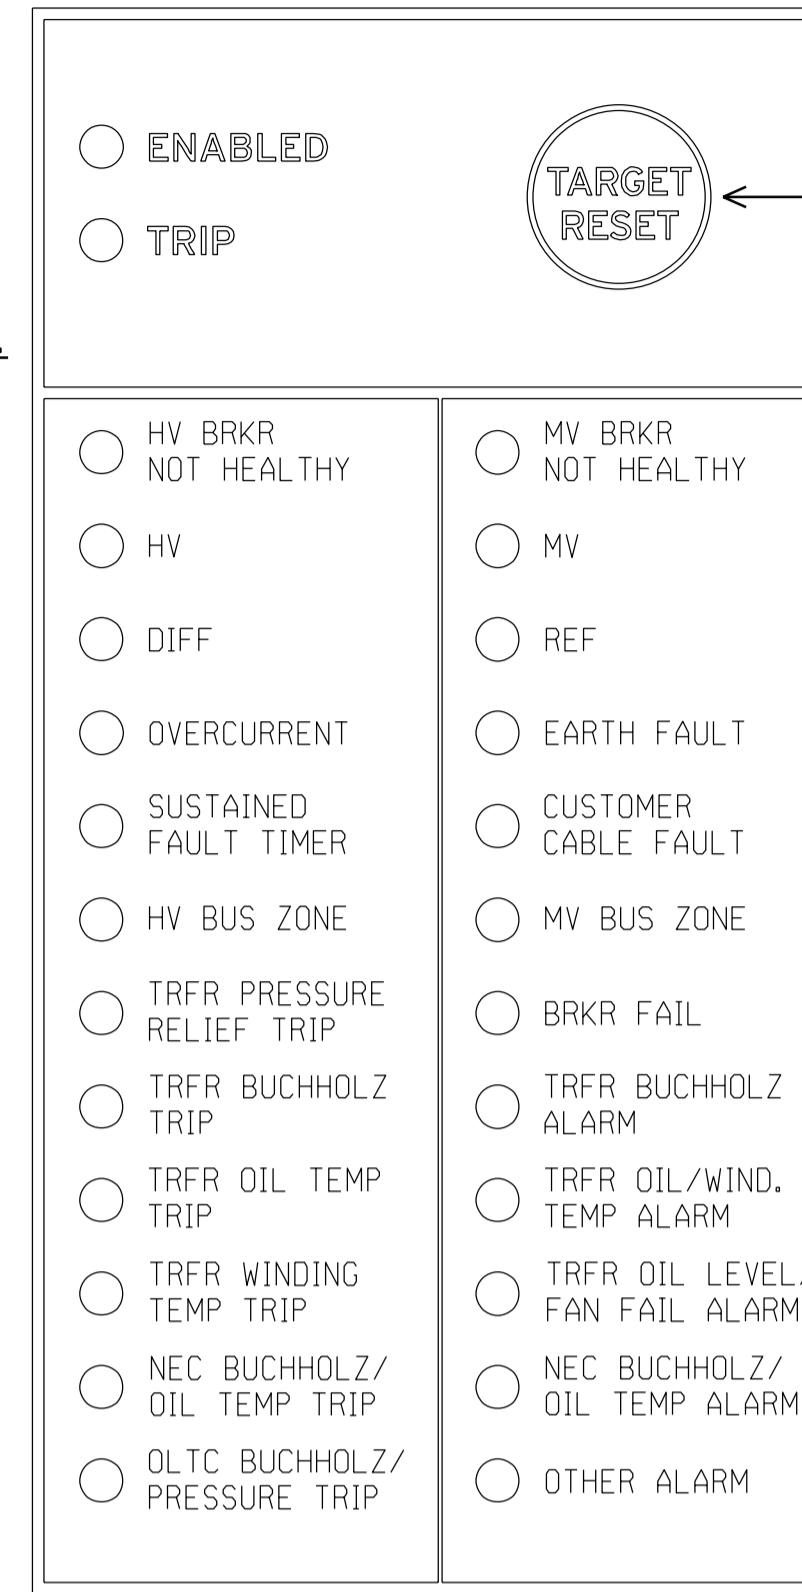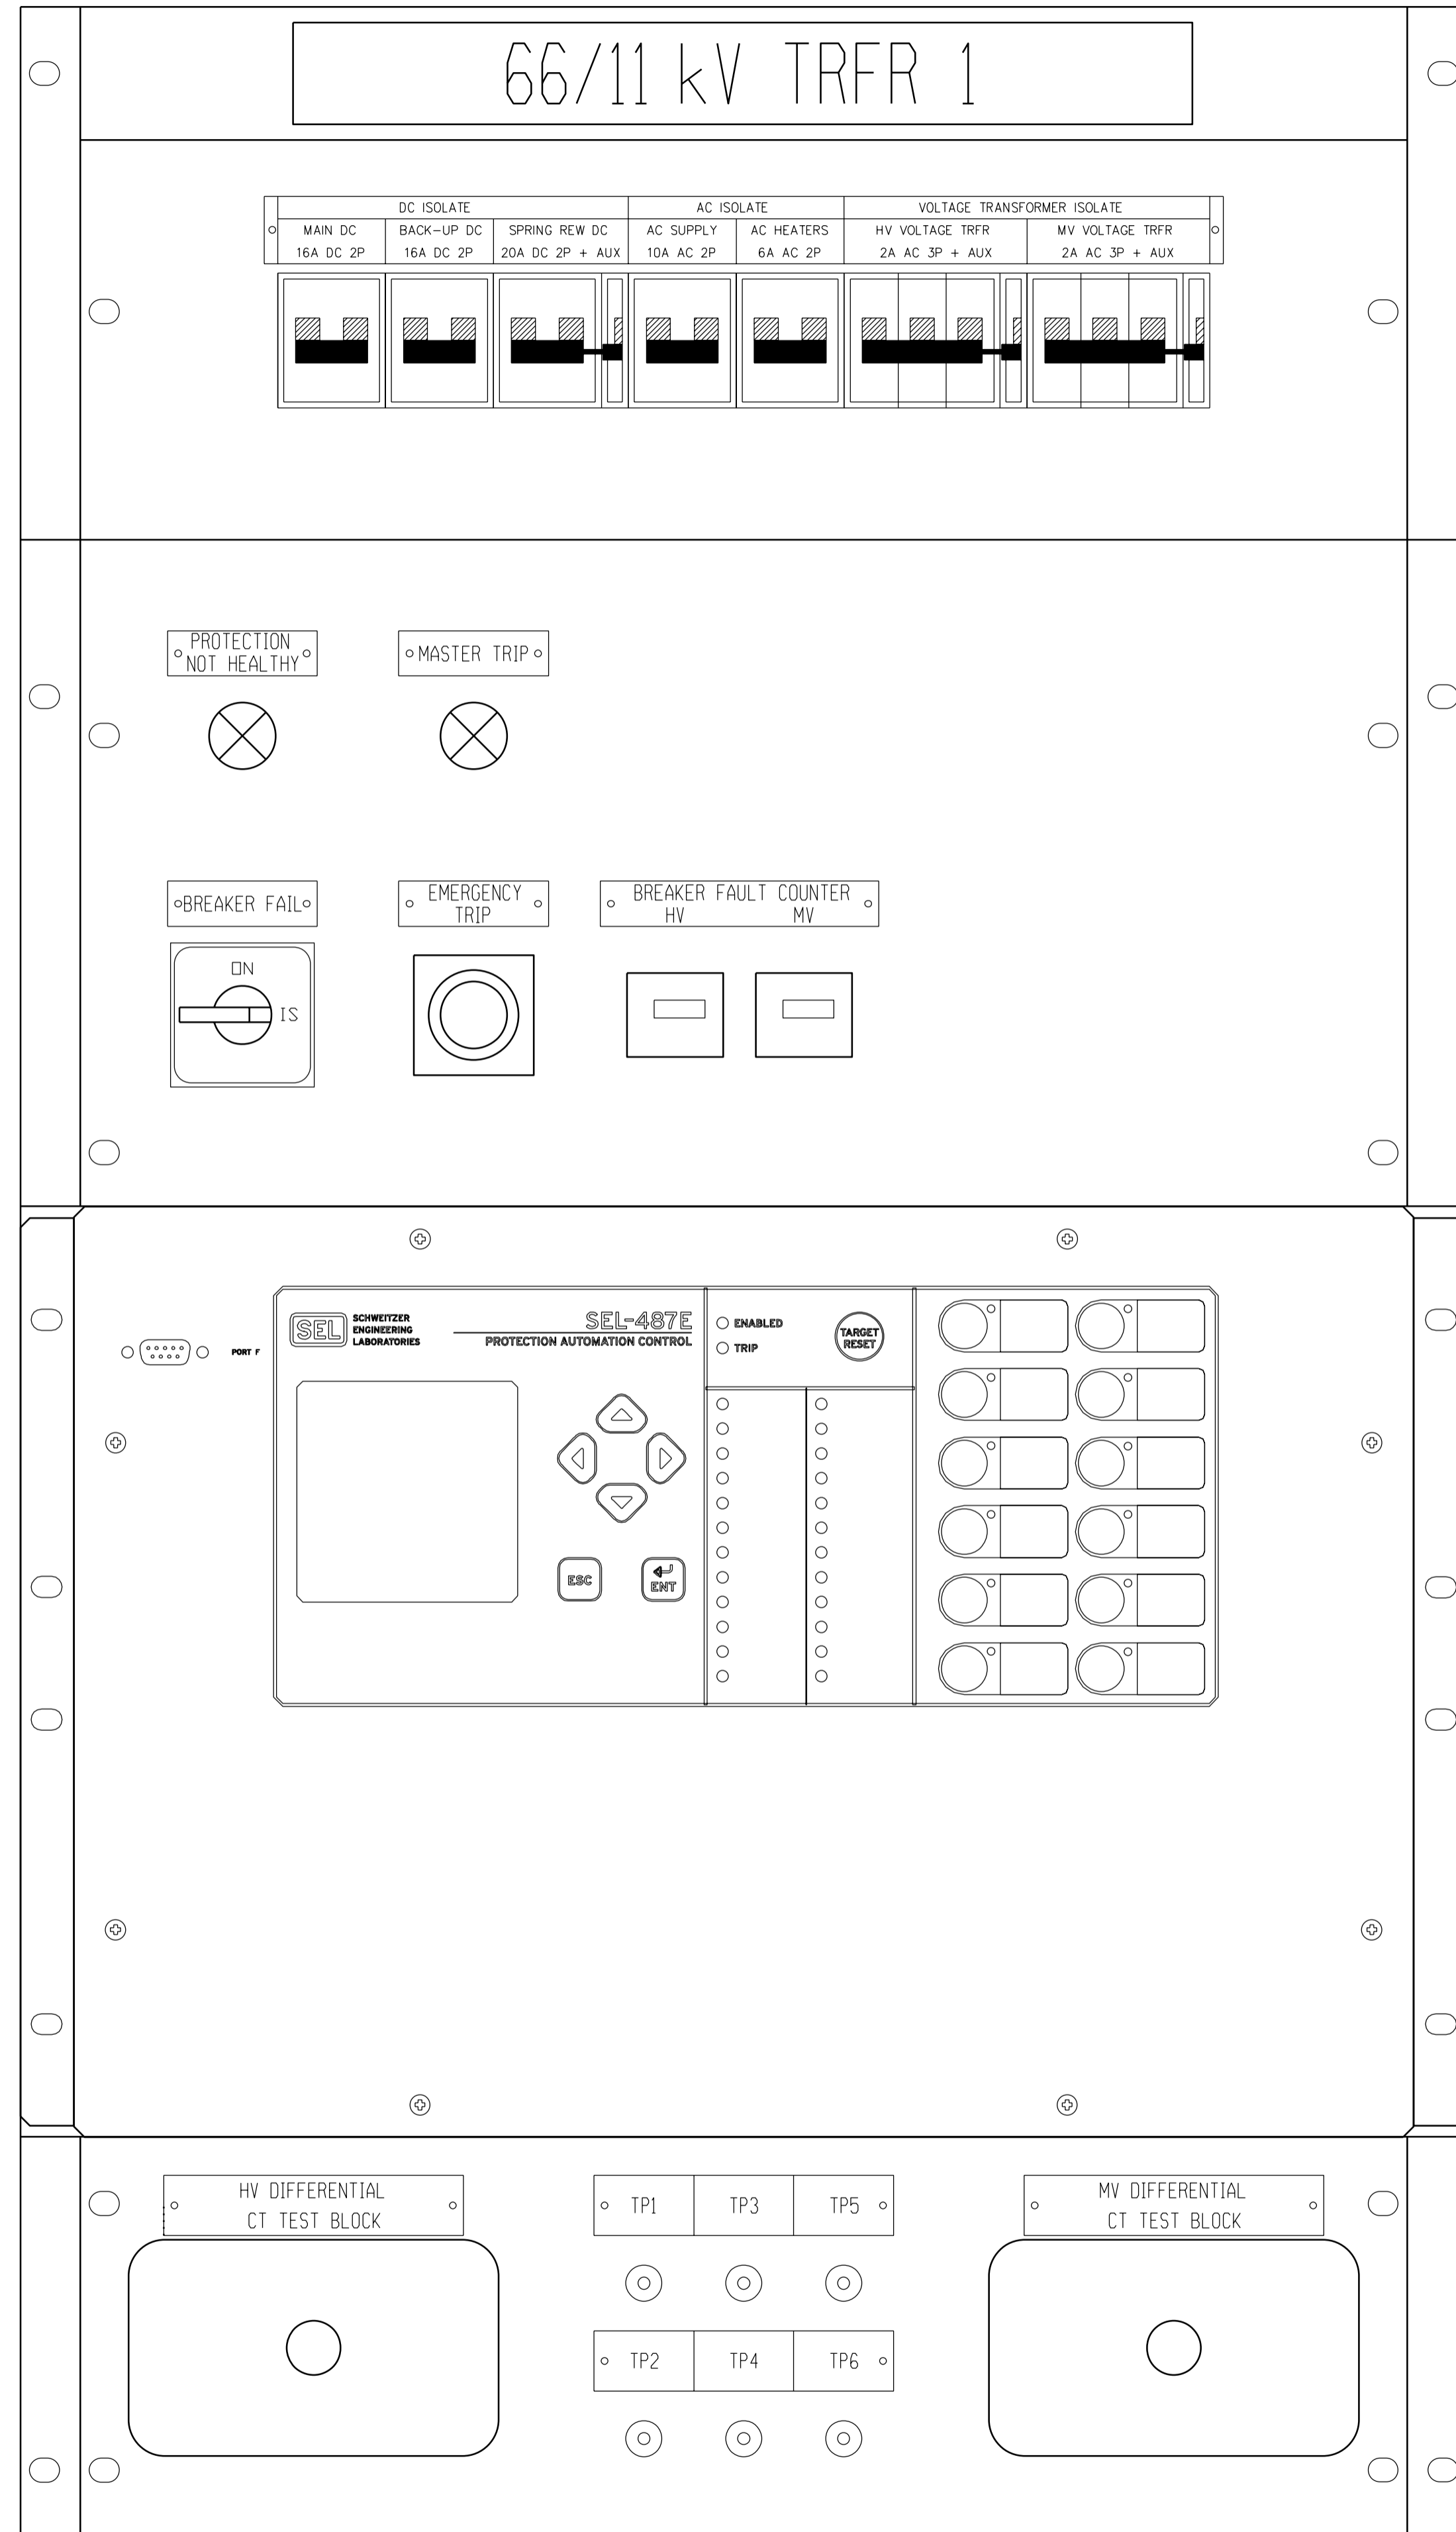

COLOUR	NO.
AMBER	1
RED	2
RED	3
RED	4
RED	5
RED	6
RED	7
RED	8
RED	9
RED	10
RED	11
RED	12

TARGET RESET & LAMP CHECK

NO.	COLOUR
13	AMBER
14	RED
15	RED
16	RED
17	RED
18	RED
19	RED
20	AMBER
21	AMBER
22	AMBER
23	AMBER
24	AMBER

NOTE 1
NOTE 1
NOTE 2

NOTES

- CIRCUIT-BREAKER CONTROLS REQUIRE THE RESPECTIVE BUTTON TO BE PRESSED TWICE WITHIN 3 SECONDS BEFORE ACTIVATION.
- PRESS PUSH BUTTON 3 FOR 5 SECONDS TO ACTIVATE DNP3 TEST MODE. WHILST IN TEST MODE, PUSH BUTTON 3 MAY BE USED TO SUCCESSIVELY SIMULATE EACH DNP3 ALARM POINT TO THE SUPERVISORY SYSTEM. PRESS PUSH BUTTON 9 TO EXIT DNP3 TEST MODE.

SHEET 25	RED670 REFERENCE DIAGRAM
SHEET 24	RED670 AC/DC & SUP. KEY DIAGRAM
SHEET 23	HV CT JB CABLING DIAGRAM
SHEET 22	PANEL CABLING DIAGRAM
SHEET 21	PANEL CABLING DIAGRAM
SHEET 20	PANEL CABLING DIAGRAM
SHEET 19	REFERENCE DIAGRAM
SHEET 18	SUPERVISORY/COMMS KEY DIAG
SHEET 17	SPP REW. DC, AC KEY DIAGRAM
SHEET 16	BACK-UP DC KEY DIAGRAM
SHEET 15	BACK-UP DC KEY DIAGRAM
SHEET 14	BACK-UP DC KEY DIAGRAM
SHEET 13	MAIN DC KEY DIAGRAM
SHEET 12	MAIN DC KEY DIAGRAM
SHEET 11	VT SUPPLY KEY DIAGRAM
SHEET 10	AC KEY DIAGRAM
SHEET 9	AC KEY DIAGRAM
SHEET 8	AC KEY DIAGRAM
SHEET 7	RELAY LOGIC DIAGRAM
SHEET 6	RELAY LOGIC DIAGRAM
SHEET 5	RELAY LOGIC DIAGRAM
SHEET 4	RELAY LOGIC DIAGRAM
SHEET 3	SCHEME LOGIC DIAGRAM
SHEET 2	FRONT PANEL LABELS
SHEET 1	PANEL EQUIPMENT LAYOUT
SHEET 0	COVER SHEET

AECOM
 CAPE TOWN OFFICE
 WATERSIDE PLACE, SOUTH GATE
 TYGER WATERFRONT
 CARL CRONJE DRIVE
 TEL: +27 (0)21 950 7500
 FAX: +27 (0)21 950 7502
 REG. No. 1966/006628/07

0	FIRST ISSUE. SUBSTATION REFURBISHED.	BY	CHKD	AUTH	DATE	3487A
1	CHANGES AS PER SHEET 0 - COVER SHEET.	SvZ	PAG	DATE 25/06/21	DATE 17/09/09	

Eskom


ISCOR SUBSTATION
 66/11 kV TRANSFORMER 1
 FRONT PANEL LABELS

D-WC-7104 81 02 0

LEVELS 1 3 10 11 17 23 24 25 26 27 30

PANEL TYPE DESIGNATION 4TM710MOD.F.ZD SIZE 00007TE AIL

MASTER TRACING FILED UNDER D-DT-15202 SHEET 2 OF 26 REVISION 1

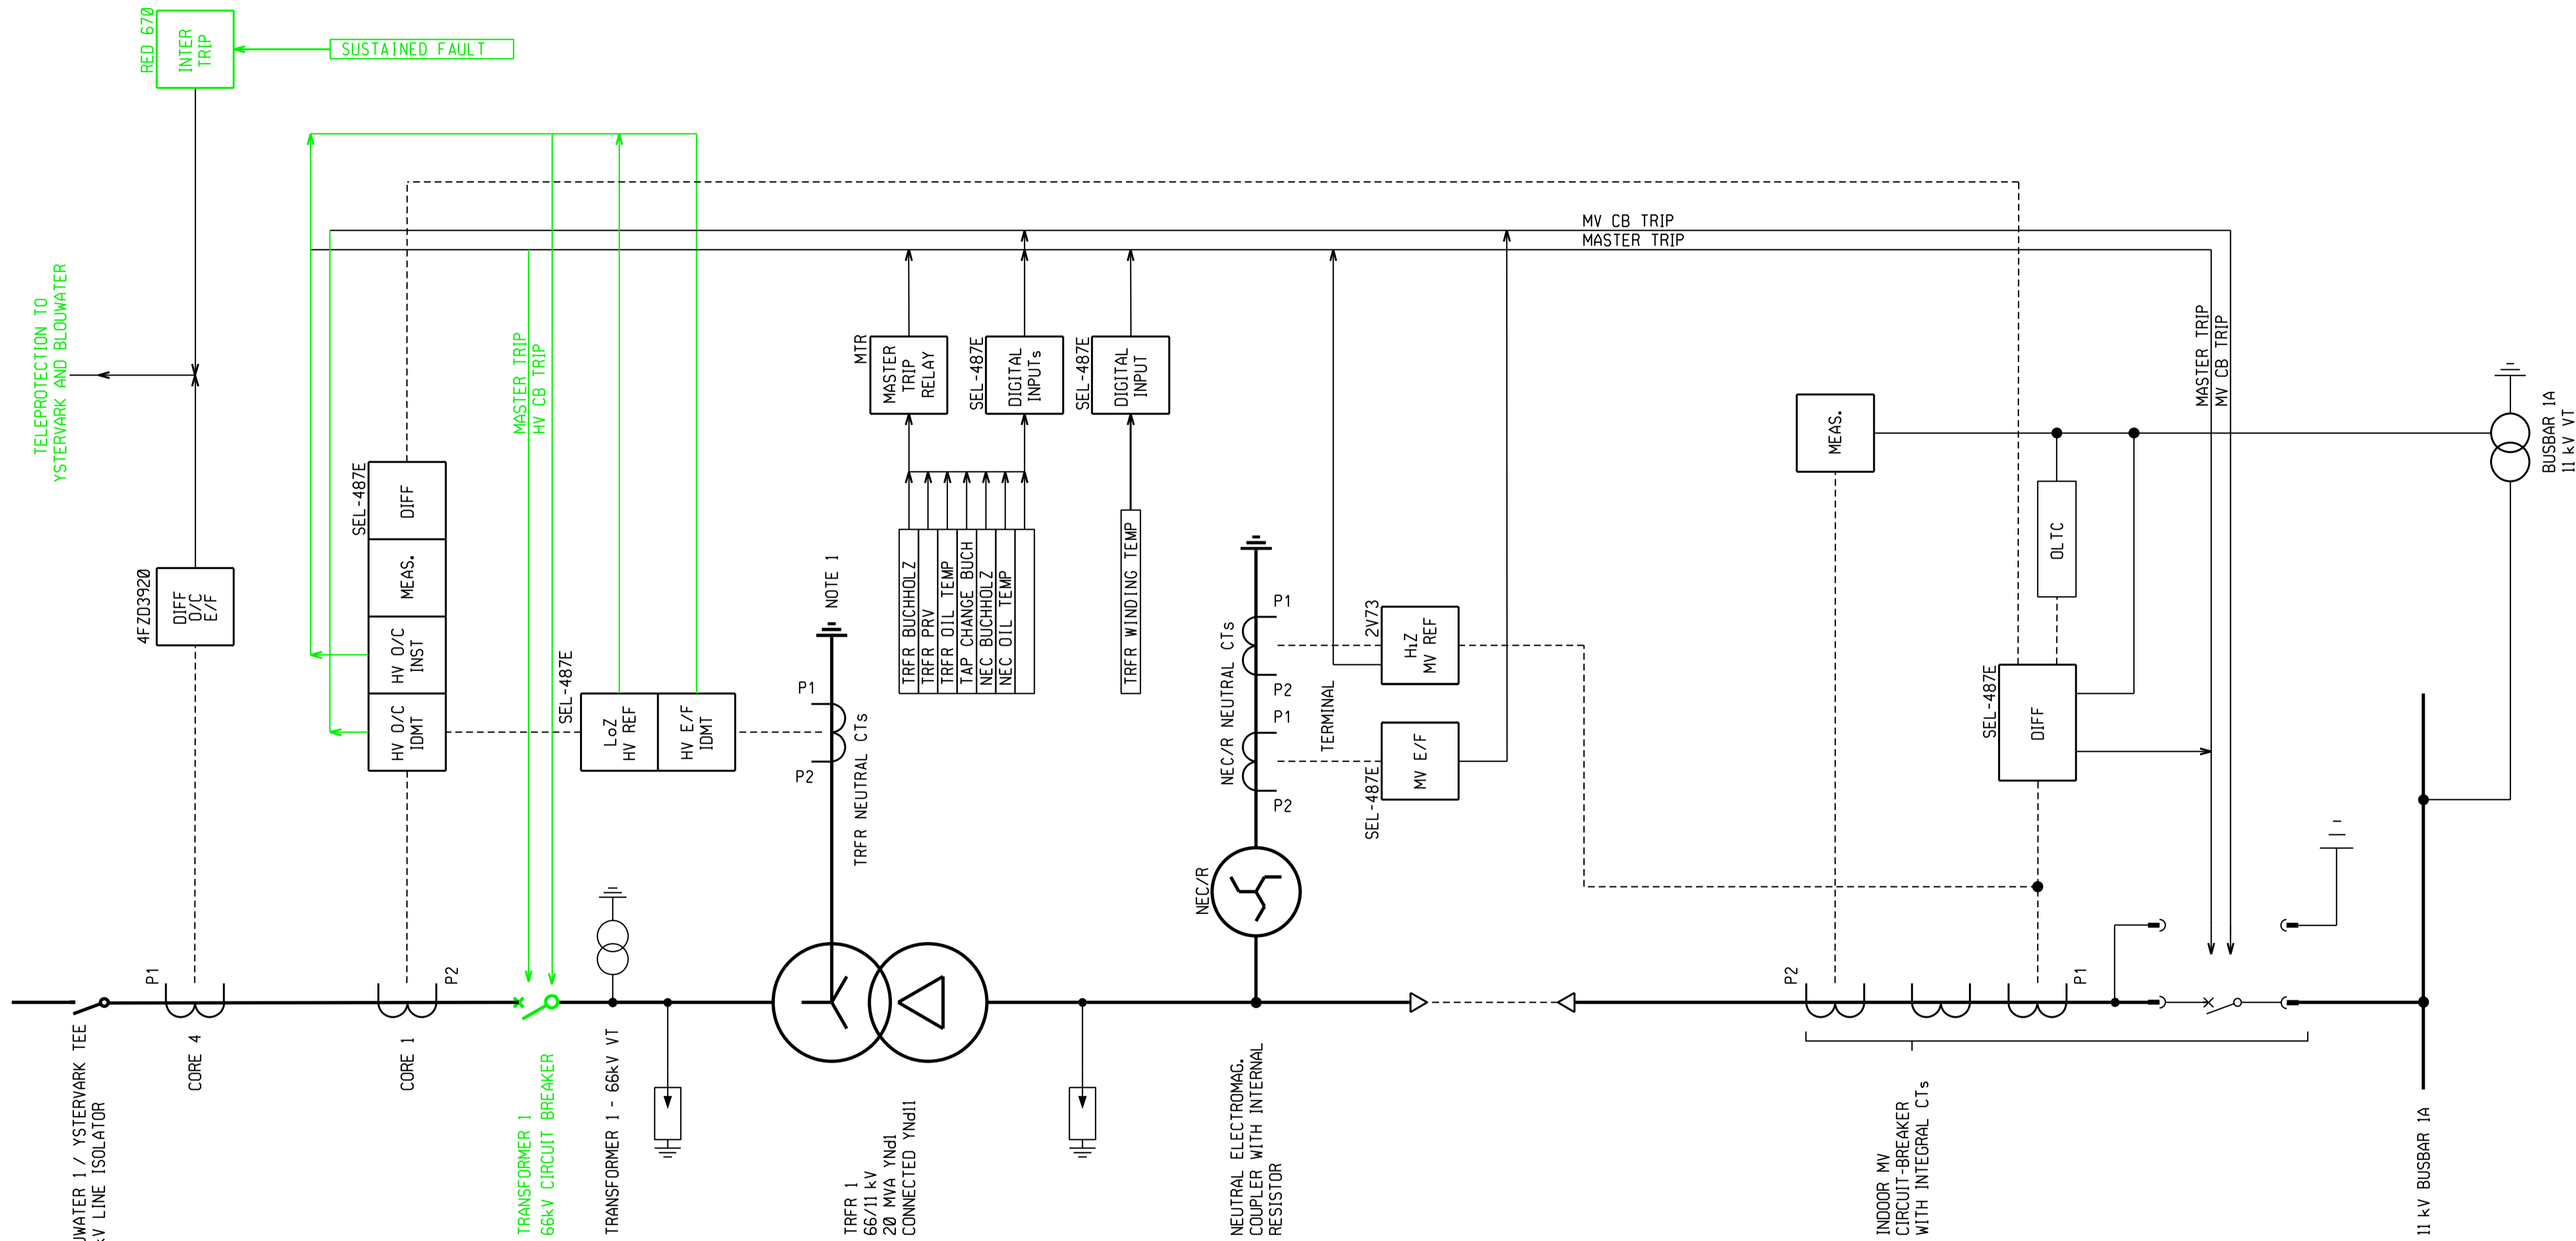

SHEET 25	RED670 REFERENCE DIAGRAM
SHEET 24	RED670 AC/DC & SUP. KEY DIAGRAM
SHEET 23	HV CT JB CABLING DIAGRAM
SHEET 22	PANEL CABLING DIAGRAM
SHEET 21	PANEL CABLING DIAGRAM
SHEET 20	PANEL CABLING DIAGRAM
SHEET 19	REFERENCE DIAGRAM
SHEET 18	SUPERVISORY/COMMS KEY DIAG
SHEET 17	SPR REW DC, AC KEY DIAGRAM
SHEET 16	BACK-UP DC KEY DIAGRAM
SHEET 15	BACK-UP DC KEY DIAGRAM
SHEET 14	BACK-UP DC KEY DIAGRAM
SHEET 13	MAIN DC KEY DIAGRAM
SHEET 12	MAIN DC KEY DIAGRAM
SHEET 11	VT SUPPLY KEY DIAGRAM
SHEET 10	AC KEY DIAGRAM
SHEET 9	AC KEY DIAGRAM
SHEET 8	AC KEY DIAGRAM
SHEET 7	RELAY LOGIC DIAGRAM
SHEET 6	RELAY LOGIC DIAGRAM
SHEET 5	RELAY LOGIC DIAGRAM
SHEET 4	RELAY LOGIC DIAGRAM
SHEET 3	SCHEME LOGIC DIAGRAM
SHEET 2	FRONT PANEL LABELS
SHEET 1	PANEL EQUIPMENT LAYOUT
SHEET 0	COVER SHEET
	REFERENCE DRAWINGS:

AECOM
 CAPE TOWN OFFICE
 WATERSIDE PLACE, SOUTH GATE
 TYGER WATERFRONT
 CARL CRONJE DRIVE
 TEL: +27 (0)21 950 7500
 FAX: +27 (0)21 950 7502
 REG. No. 1966/006628/07

2	66kV VT ADDED.	KS	BH	C. PYM	25/06/2021	
1	66kV CIRCUIT BREAKER ADDED	JF	BS	LMB	21/01/2018	
0	FIRST ISSUE. SUBSTATION REFURBISHED.				/ /	3487A
REV	REVISION DESCRIPTION	BY	CHKD	AUTH	DATE	PROJECT NUMBER

PROJECT APPROVED	DESIGN APPROVED
C. PYM	S.J. van ZYL
DATE 25/06/21	DATE 11/06/10
PROJECT CHECKED	DESIGN CHECKED
B. HOMANN	P.A. GERBER
DATE 25/06/21	DATE 11/06/10
DRAWN BY	DRAWN BY
K. STEYNBERG	S.J. van ZYL
DATE 15/11/2010	DATE 25/06/21
SvZ	SvZ
DATE 25/06/21	DATE 17/09/09
REVISION TO MASTER	SCALE

Eskom

ISCOR SUBSTATION
 66/11 kV TRANSFORMER 1










SCHEME LOGIC DIAGRAM

D-WC-7104 SET NUMBER: 81 SHEET NUMBER: 03 REVISION: 2

LEVELS 1 2 3 4 5 6 7 8 9 10 11 12 13 14 15 16 17 18 19 20 21 22 23 24 25 26 27 28 29 30 31

PANEL TYPE DESIGNATION 4TM710MOD.F.ZD SIZE 0000TE A1L

NOTES
 1. THE EARTHING OF TRANSFORMER NEUTRALS SHALL BE IN ACCORDANCE WITH DPL 34-2149.

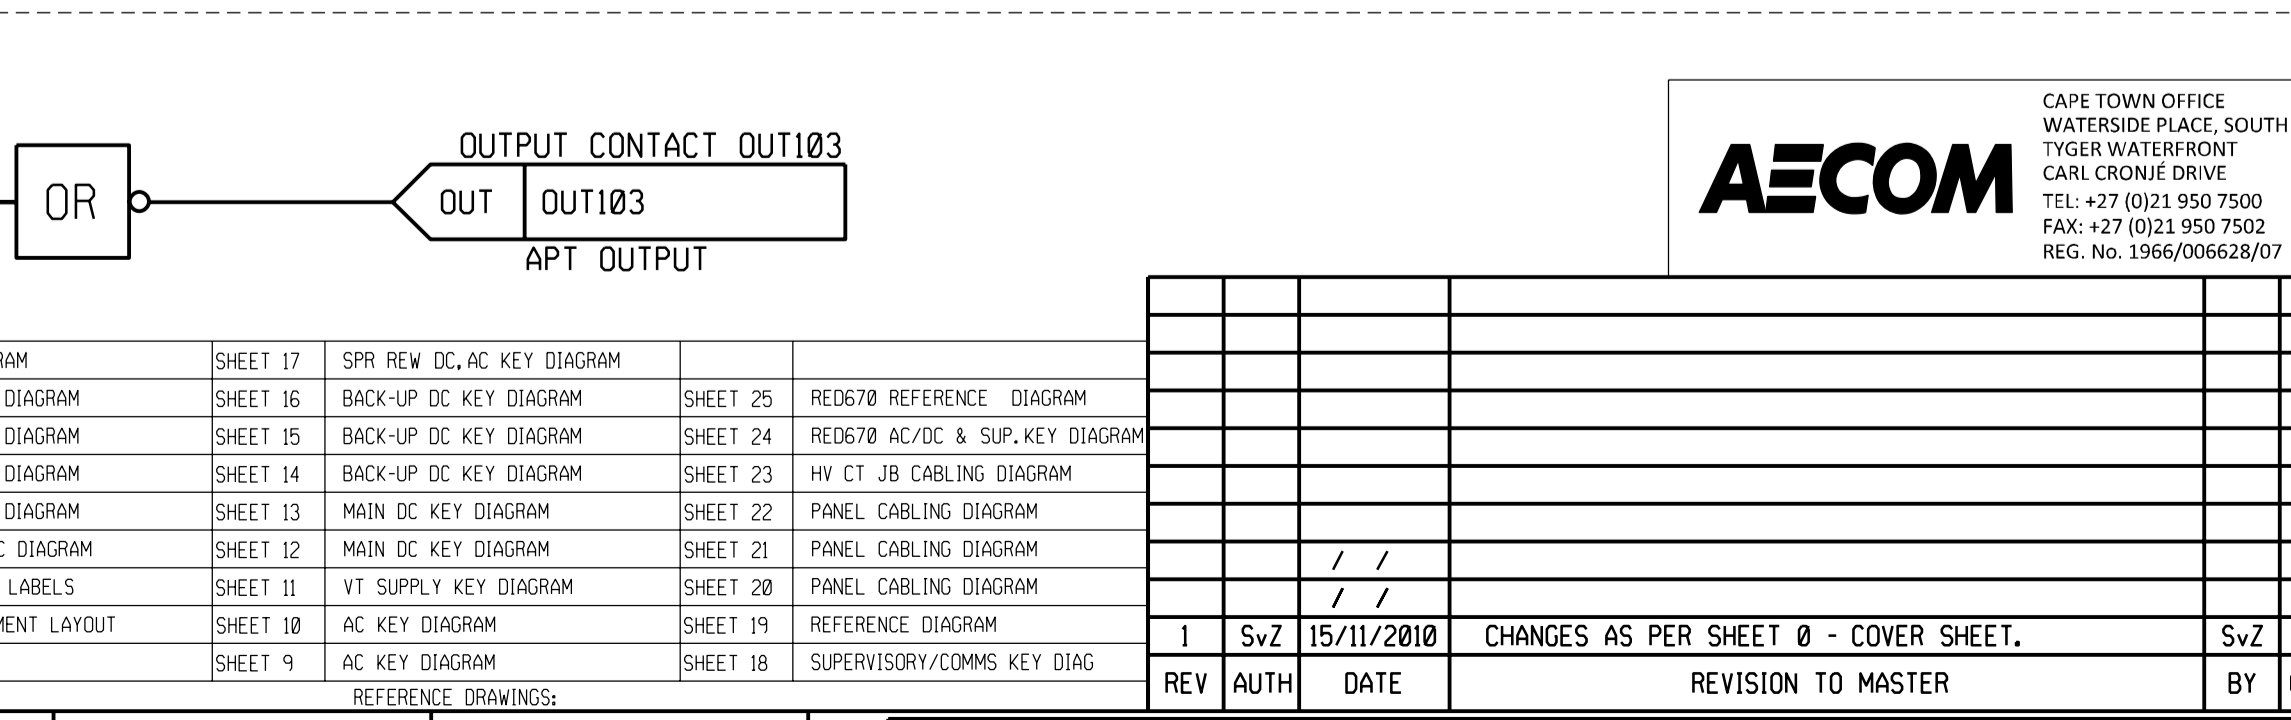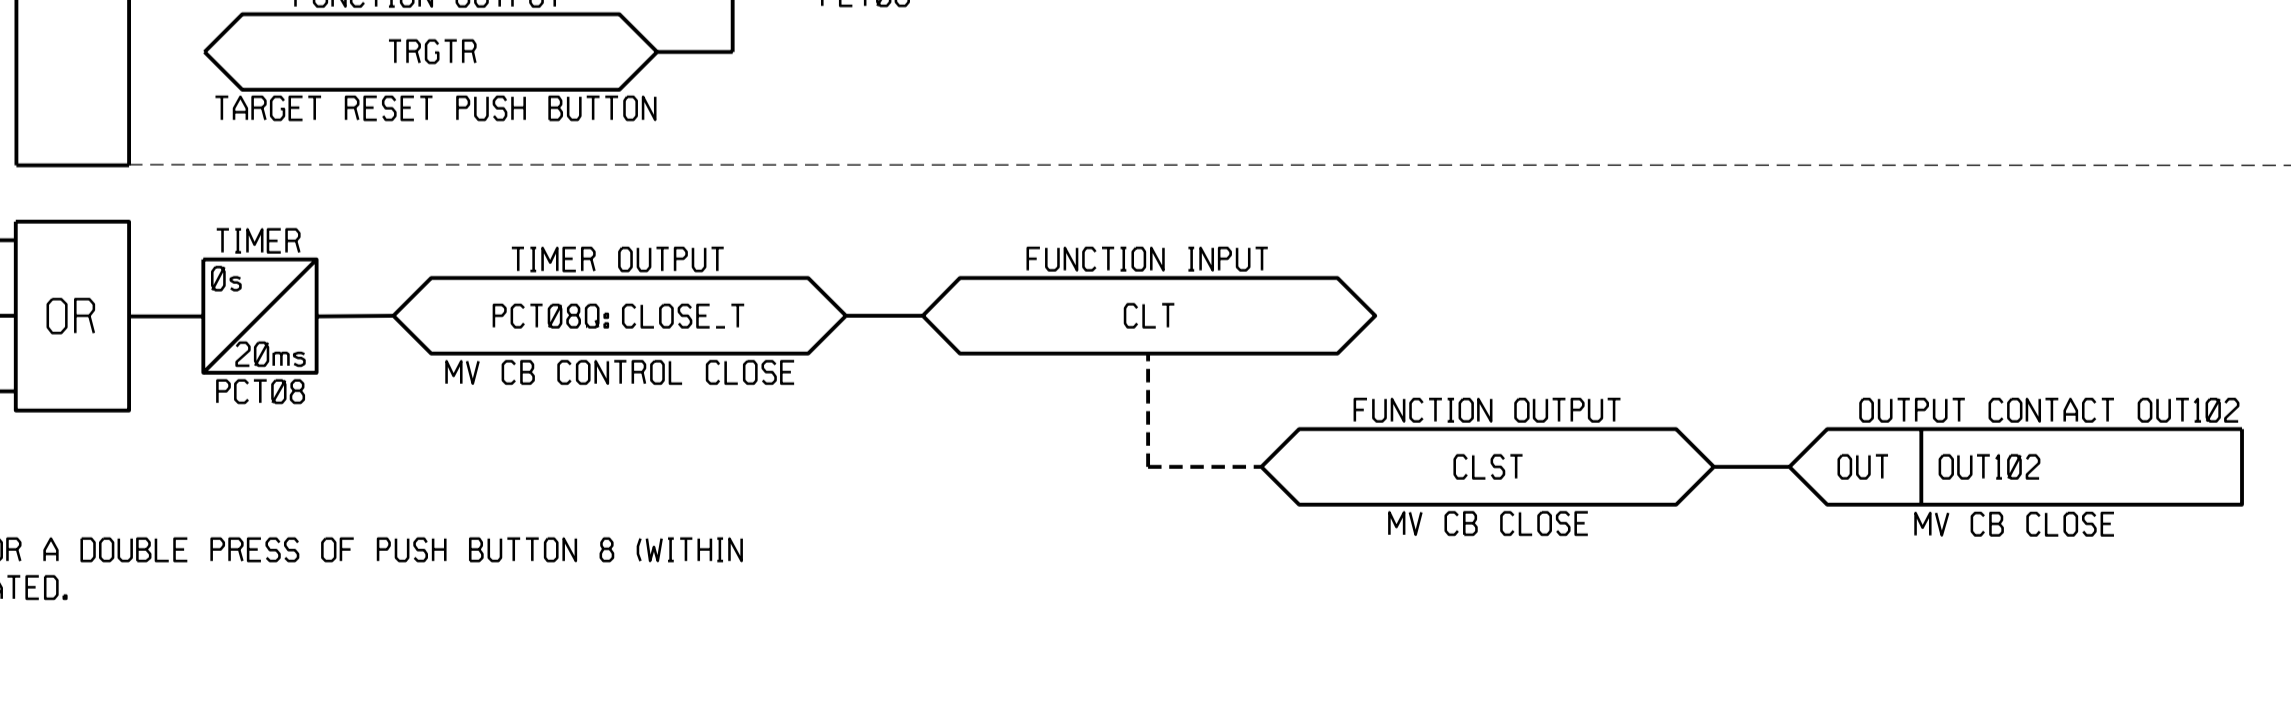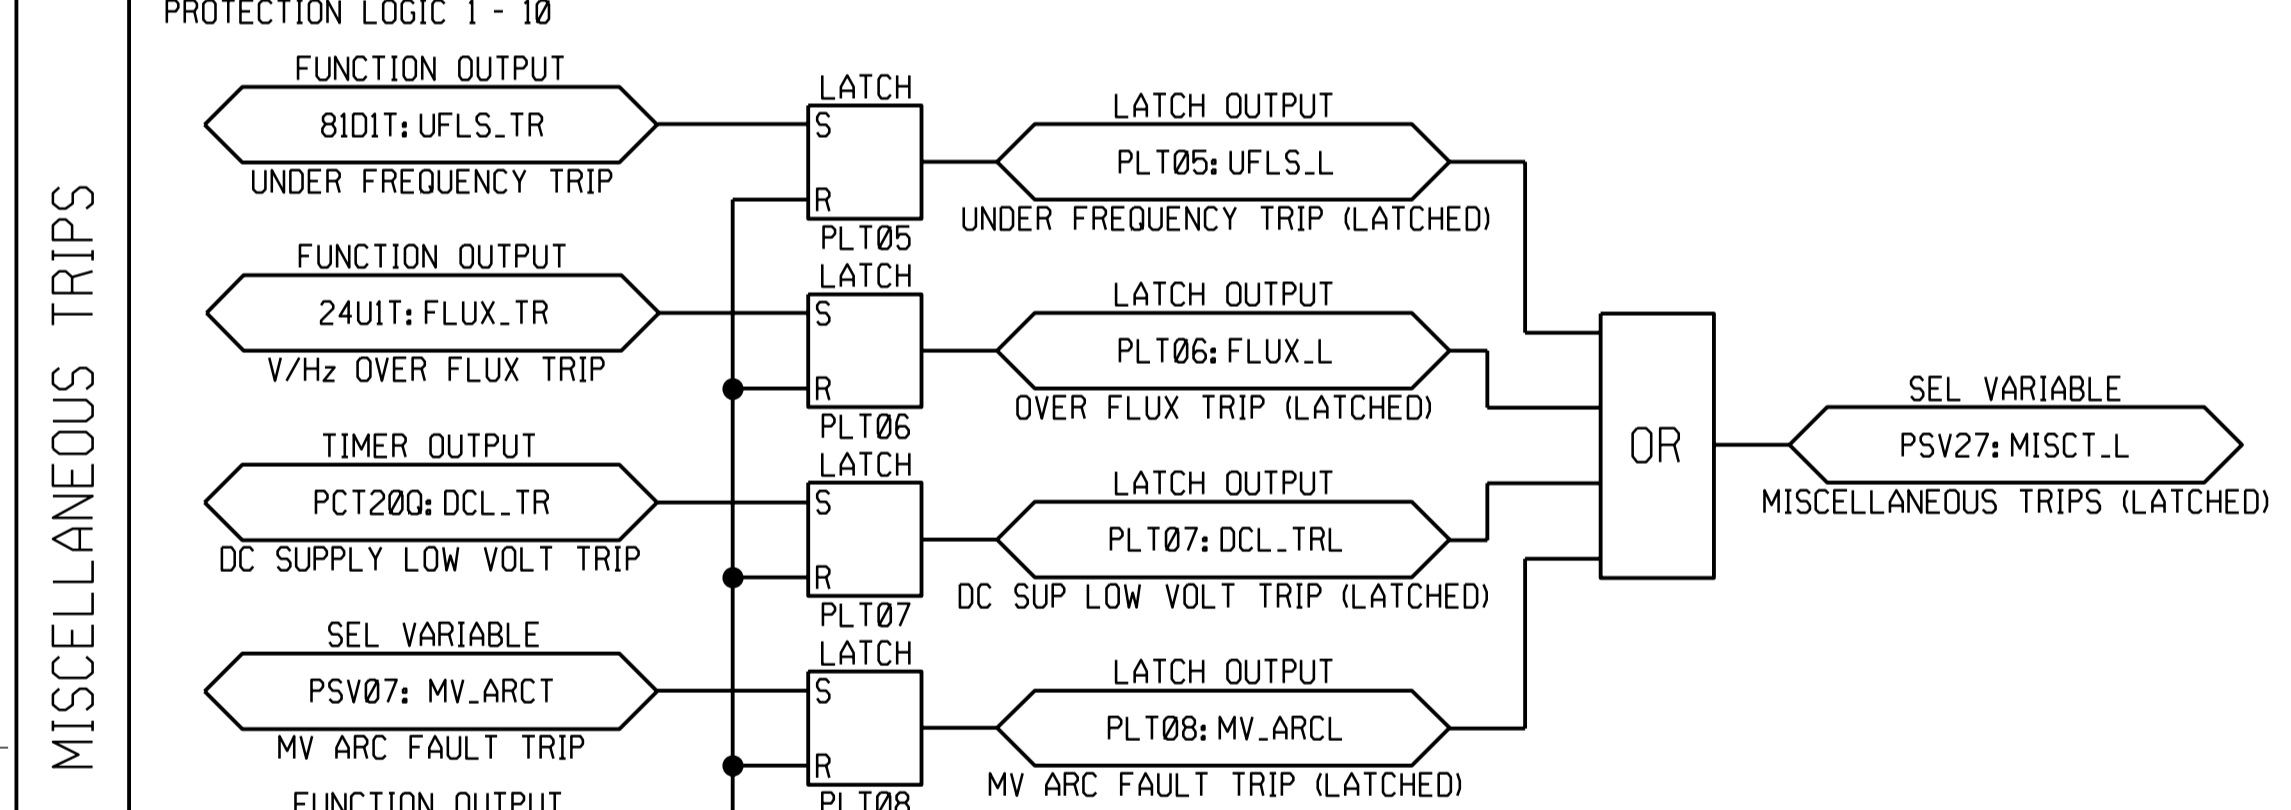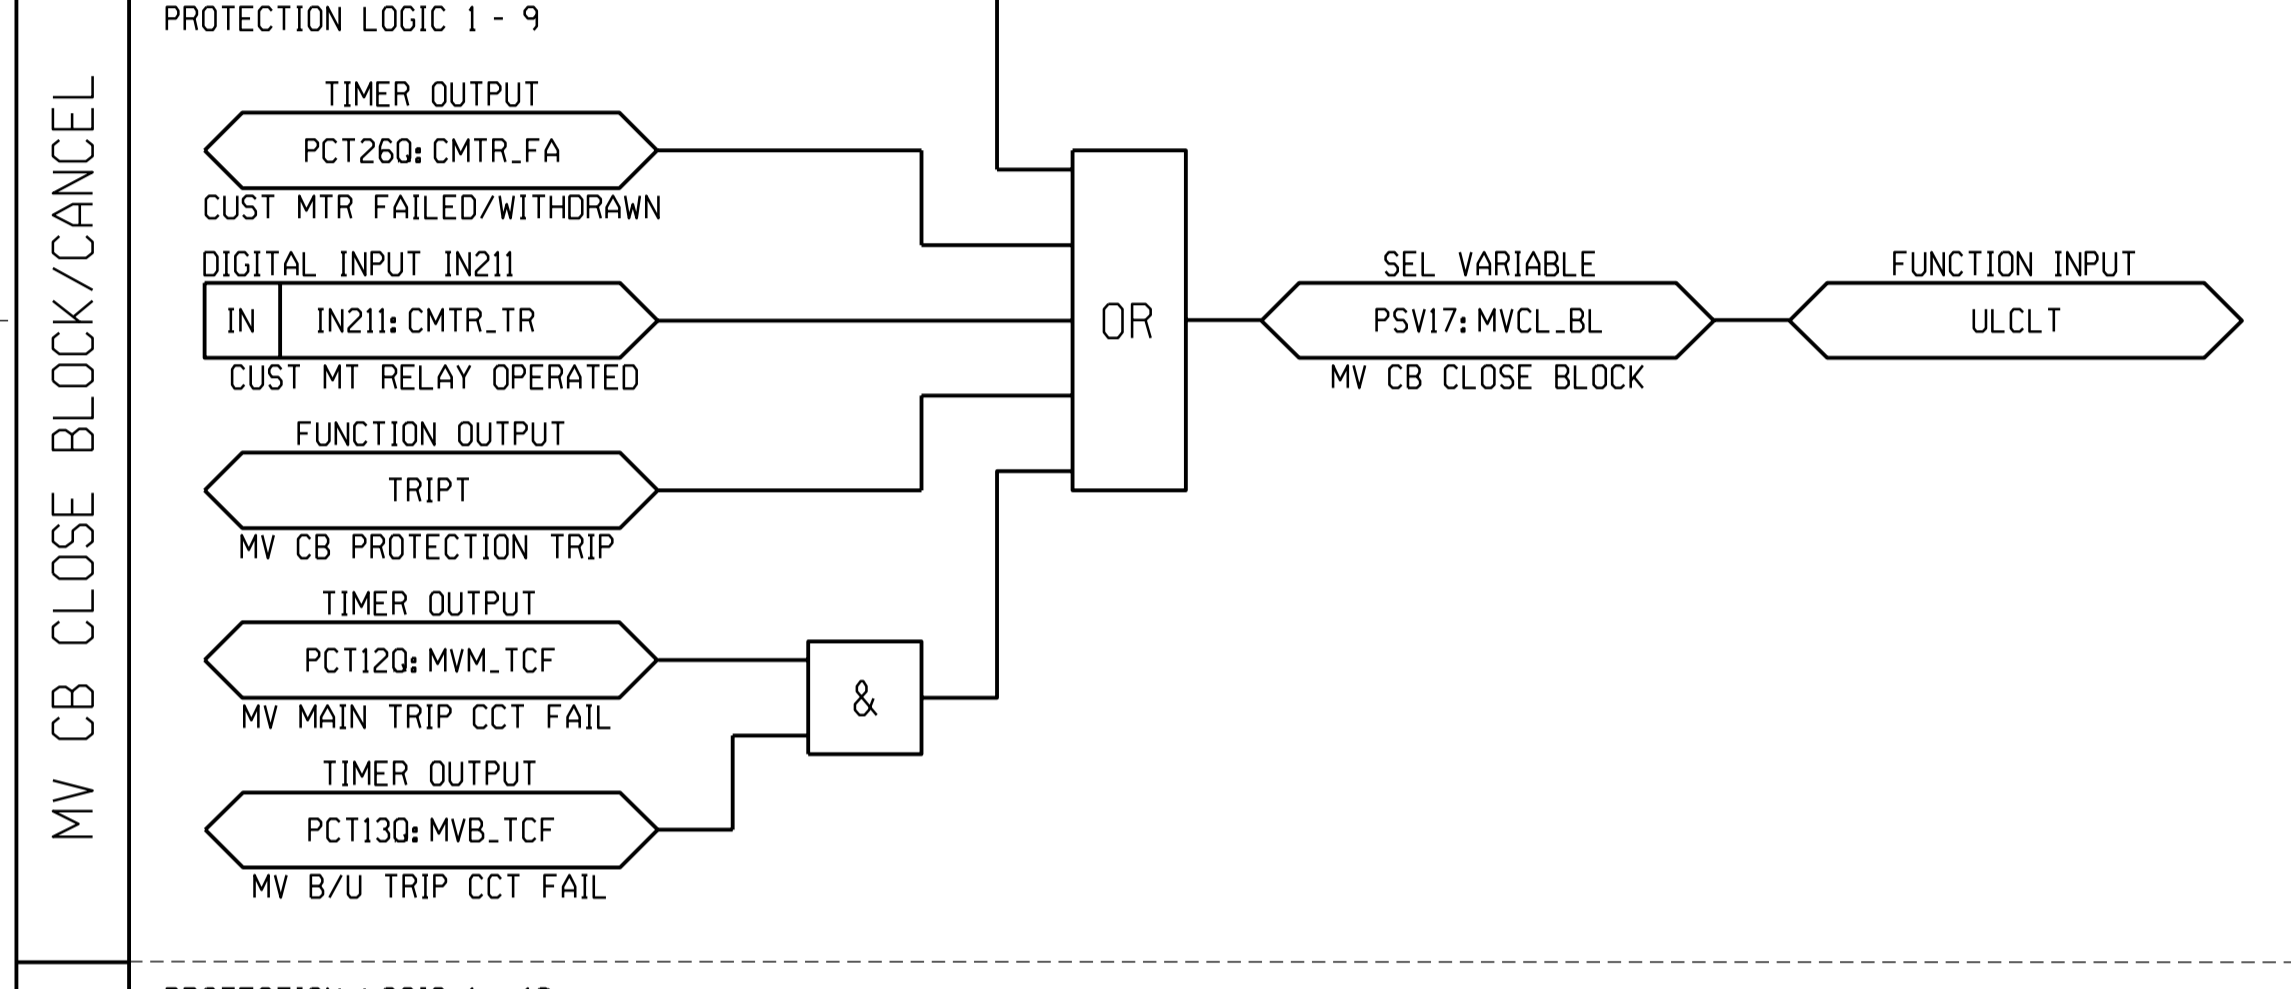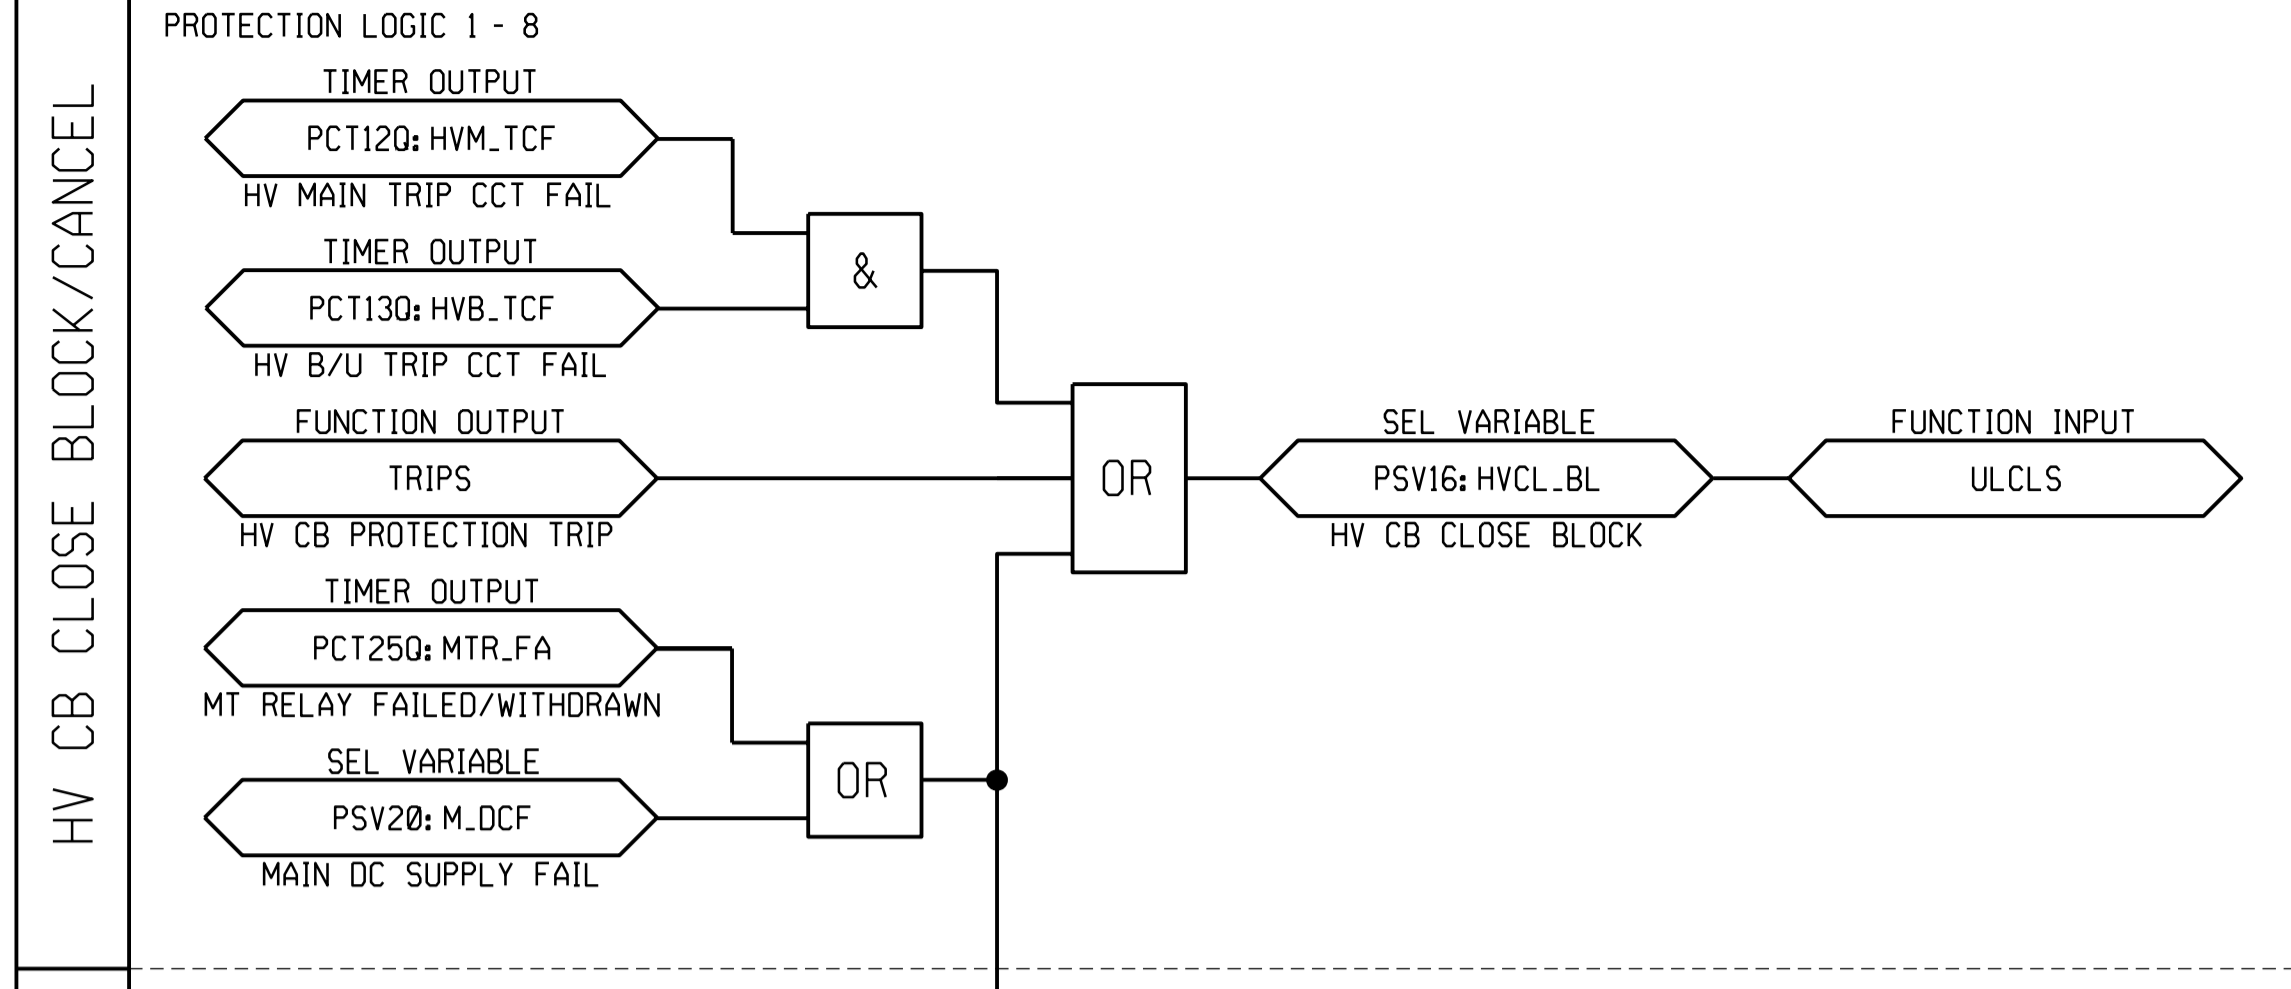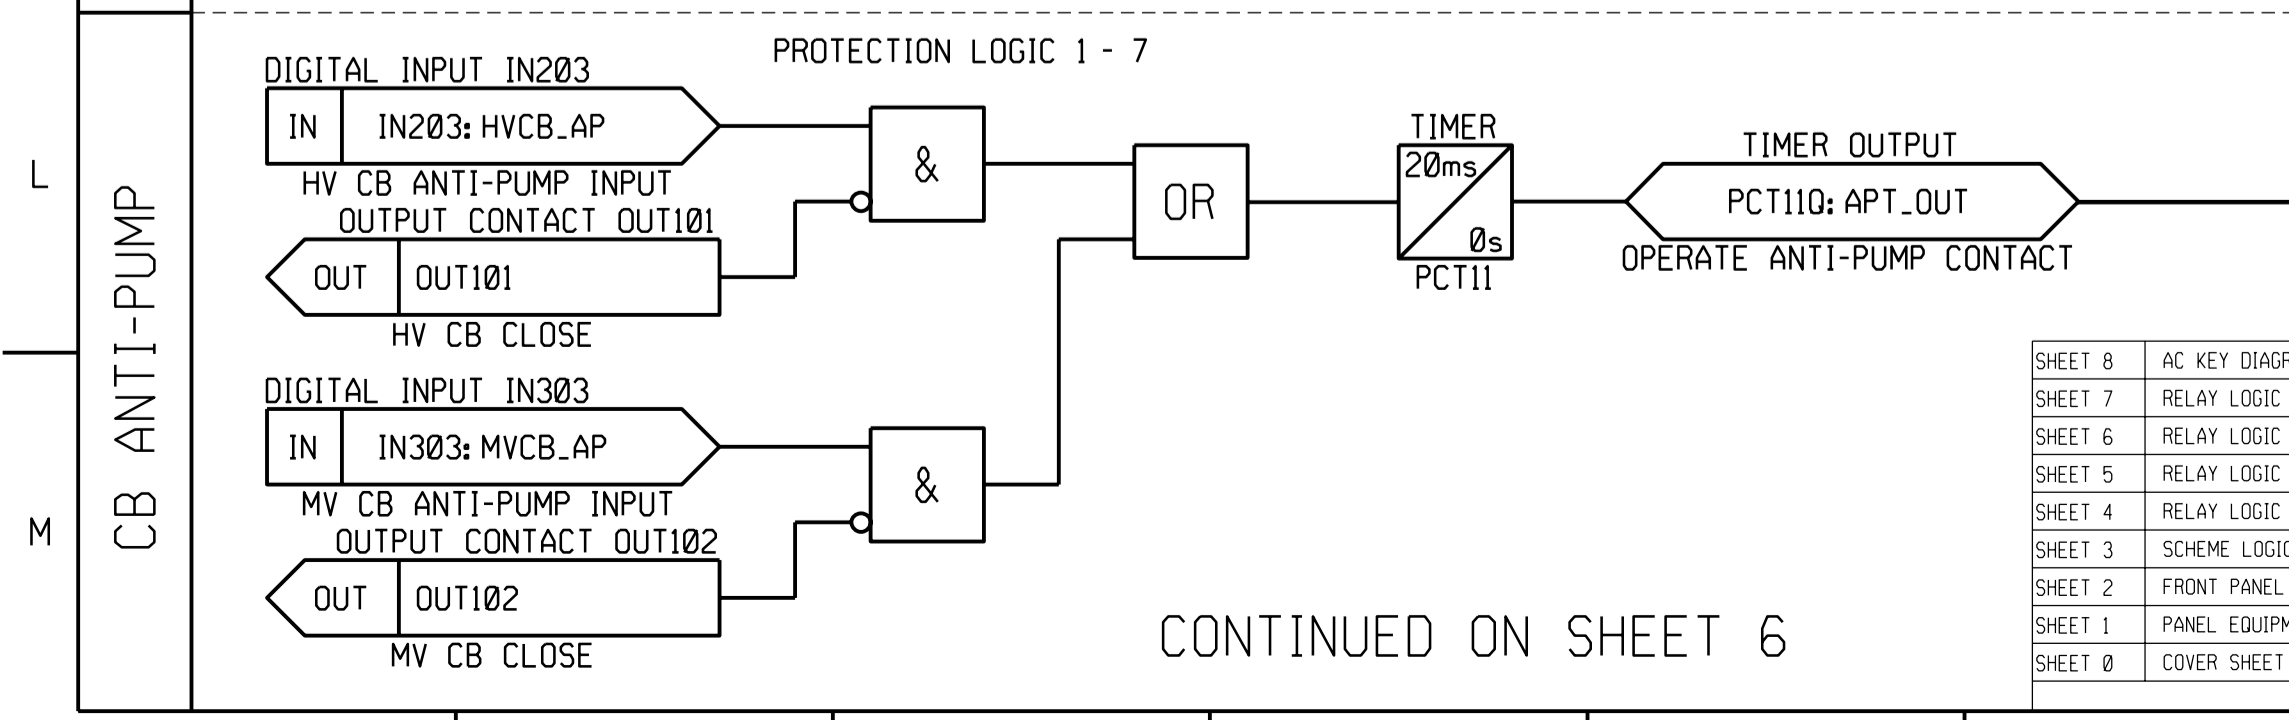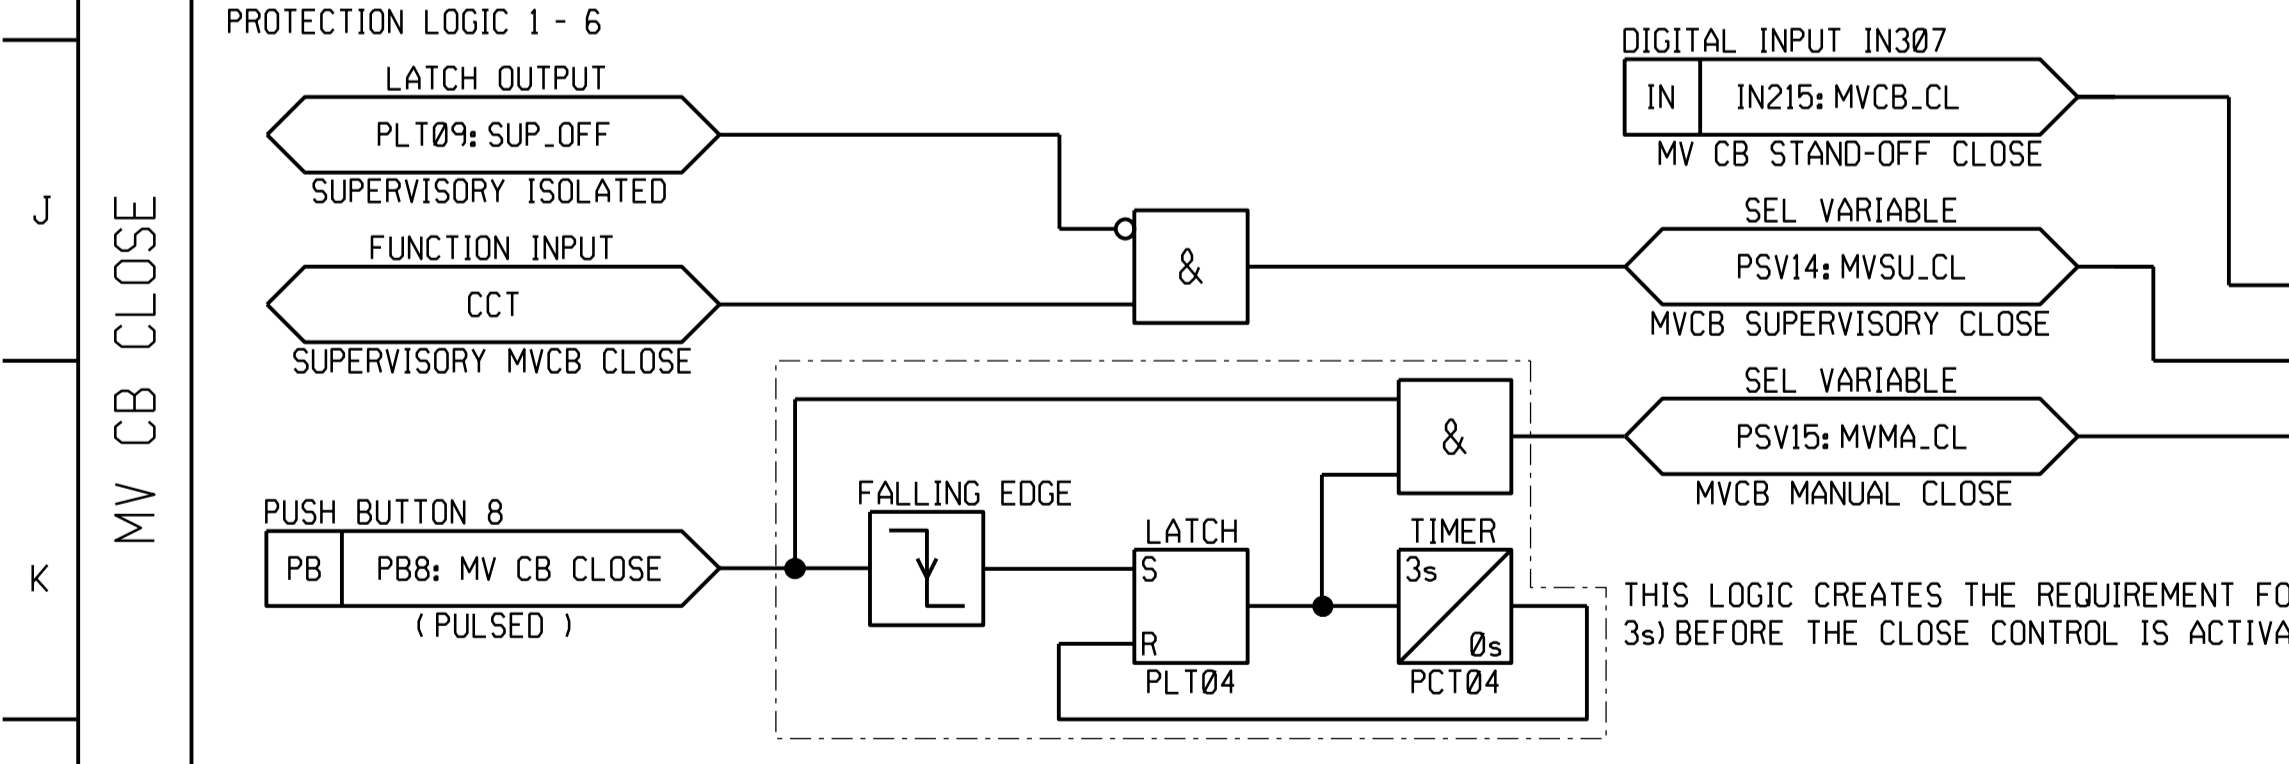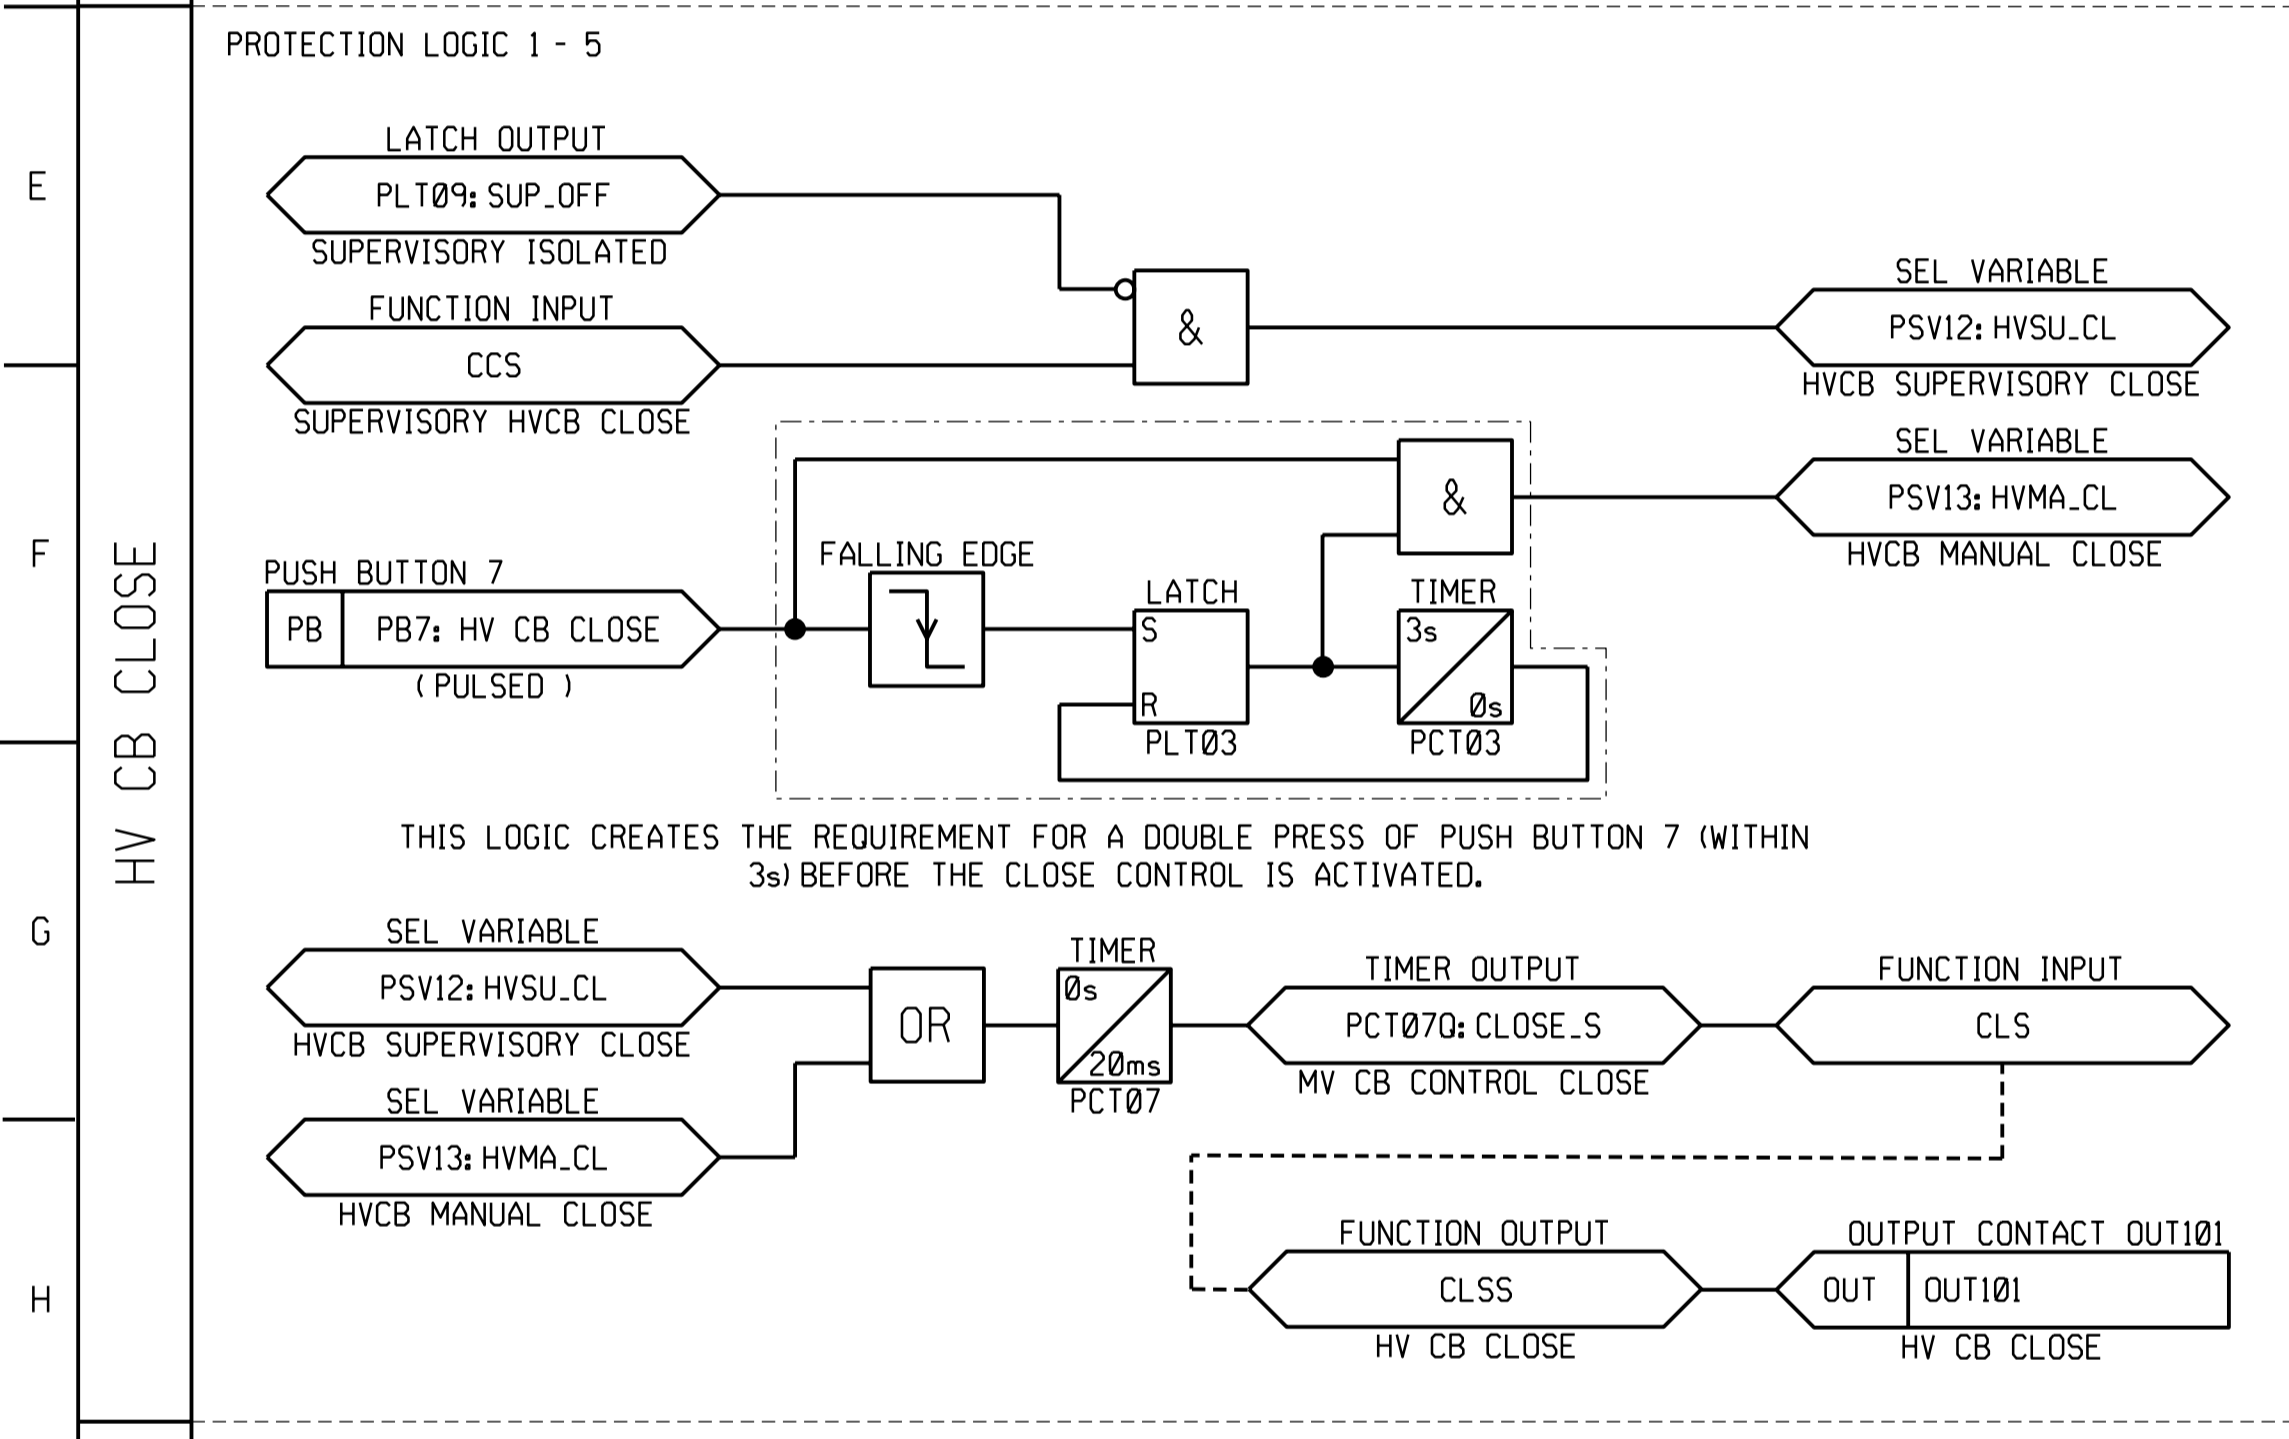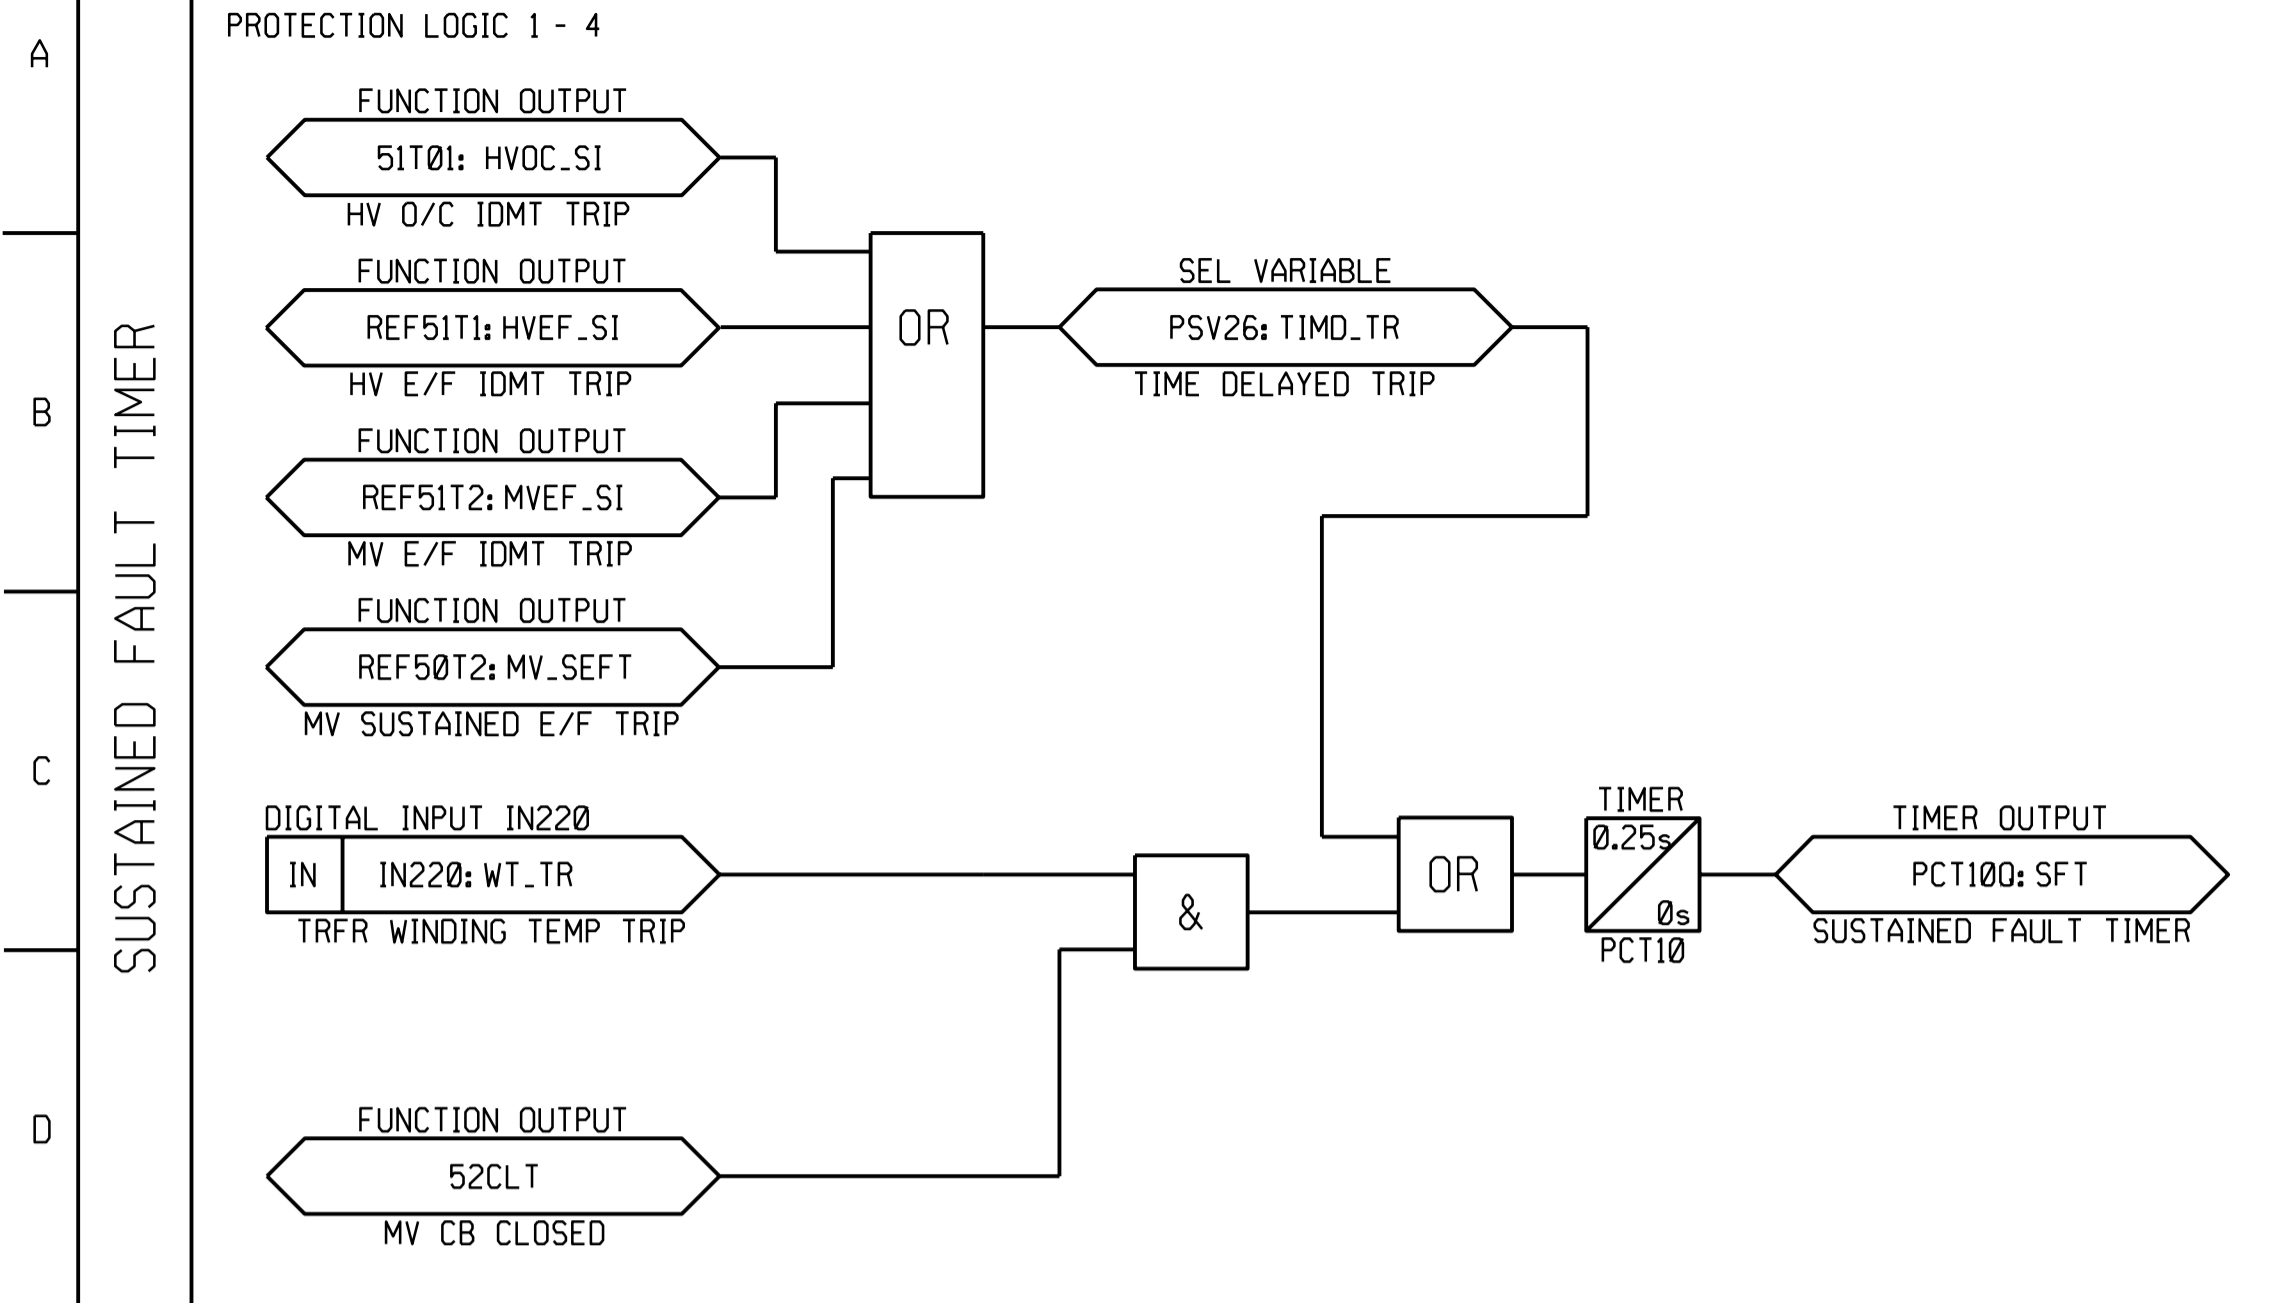

CAPE TOWN OFFICE
WATERSIDE PLACE, SOUTH GATE
TYGER WATERFRONT
CARL CROWE DRIVE
TEL: +27 (0)21 950 7500
FAX: +27 (0)21 950 7502
REG. No. 1966/006628/07



PROJECT APPROVED C. PYM	DESIGN APPROVED S.J. van ZYL
DATE 25/06/21	DATE 11/06/10
PROJECT CHECKED B. HOMANN	DESIGN CHECKED P.A. GERBER
DATE 25/06/21	DATE 11/06/10
DRAWN BY K. STEYNBERG	DRAWN BY S.J. van ZYL
DATE 25/06/21	DATE 17/09/09

ISCOR SUBSTATION
66/11 kV TRANSFORMER 1

RELAY LOGIC DIAGRAM








D-WC-7104	81	05	0
SET NUMBER	SHEET NUMBER	REVISION	

SHEET 8	AC KEY DIAGRAM	SHEET 17	SPR REW DC, AC KEY DIAGRAM	SHEET 25	RED670 REFERENCE DIAGRAM
SHEET 7	RELAY LOGIC DIAGRAM	SHEET 16	BACK-UP DC KEY DIAGRAM	SHEET 24	RED670 AC/DC & SUP. KEY DIAGRAM
SHEET 6	RELAY LOGIC DIAGRAM	SHEET 15	BACK-UP DC KEY DIAGRAM	SHEET 23	HV CT JB CABLING DIAGRAM
SHEET 5	RELAY LOGIC DIAGRAM	SHEET 14	BACK-UP DC KEY DIAGRAM	SHEET 22	PANEL CABLING DIAGRAM
SHEET 4	RELAY LOGIC DIAGRAM	SHEET 13	MAIN DC KEY DIAGRAM	SHEET 21	PANEL CABLING DIAGRAM
SHEET 3	SCHEME LOGIC DIAGRAM	SHEET 12	MAIN DC KEY DIAGRAM	SHEET 20	PANEL CABLING DIAGRAM
SHEET 2	FRONT PANEL LABELS	SHEET 11	VT SUPPLY KEY DIAGRAM	SHEET 19	REFERENCE DIAGRAM
SHEET 1	PANEL EQUIPMENT LAYOUT	SHEET 10	AC KEY DIAGRAM	SHEET 18	SUPERVISORY/COMMS KEY DIAG
SHEET 0	COVER SHEET	SHEET 9	AC KEY DIAGRAM		



1	SvZ	15/11/2010	CHANGES AS PER SHEET 0 - COVER SHEET.	SvZ	PAG	DATE 25/06/21	DATE 17/09/09
REV	AUTH	DATE	REVISION TO MASTER	BY	CHKD	SCALE	

CONTINUED ON SHEET 6




MASTER TRACING FILED UNDER D-DT-15202 SHEET 5 OF 26 REVISION 1

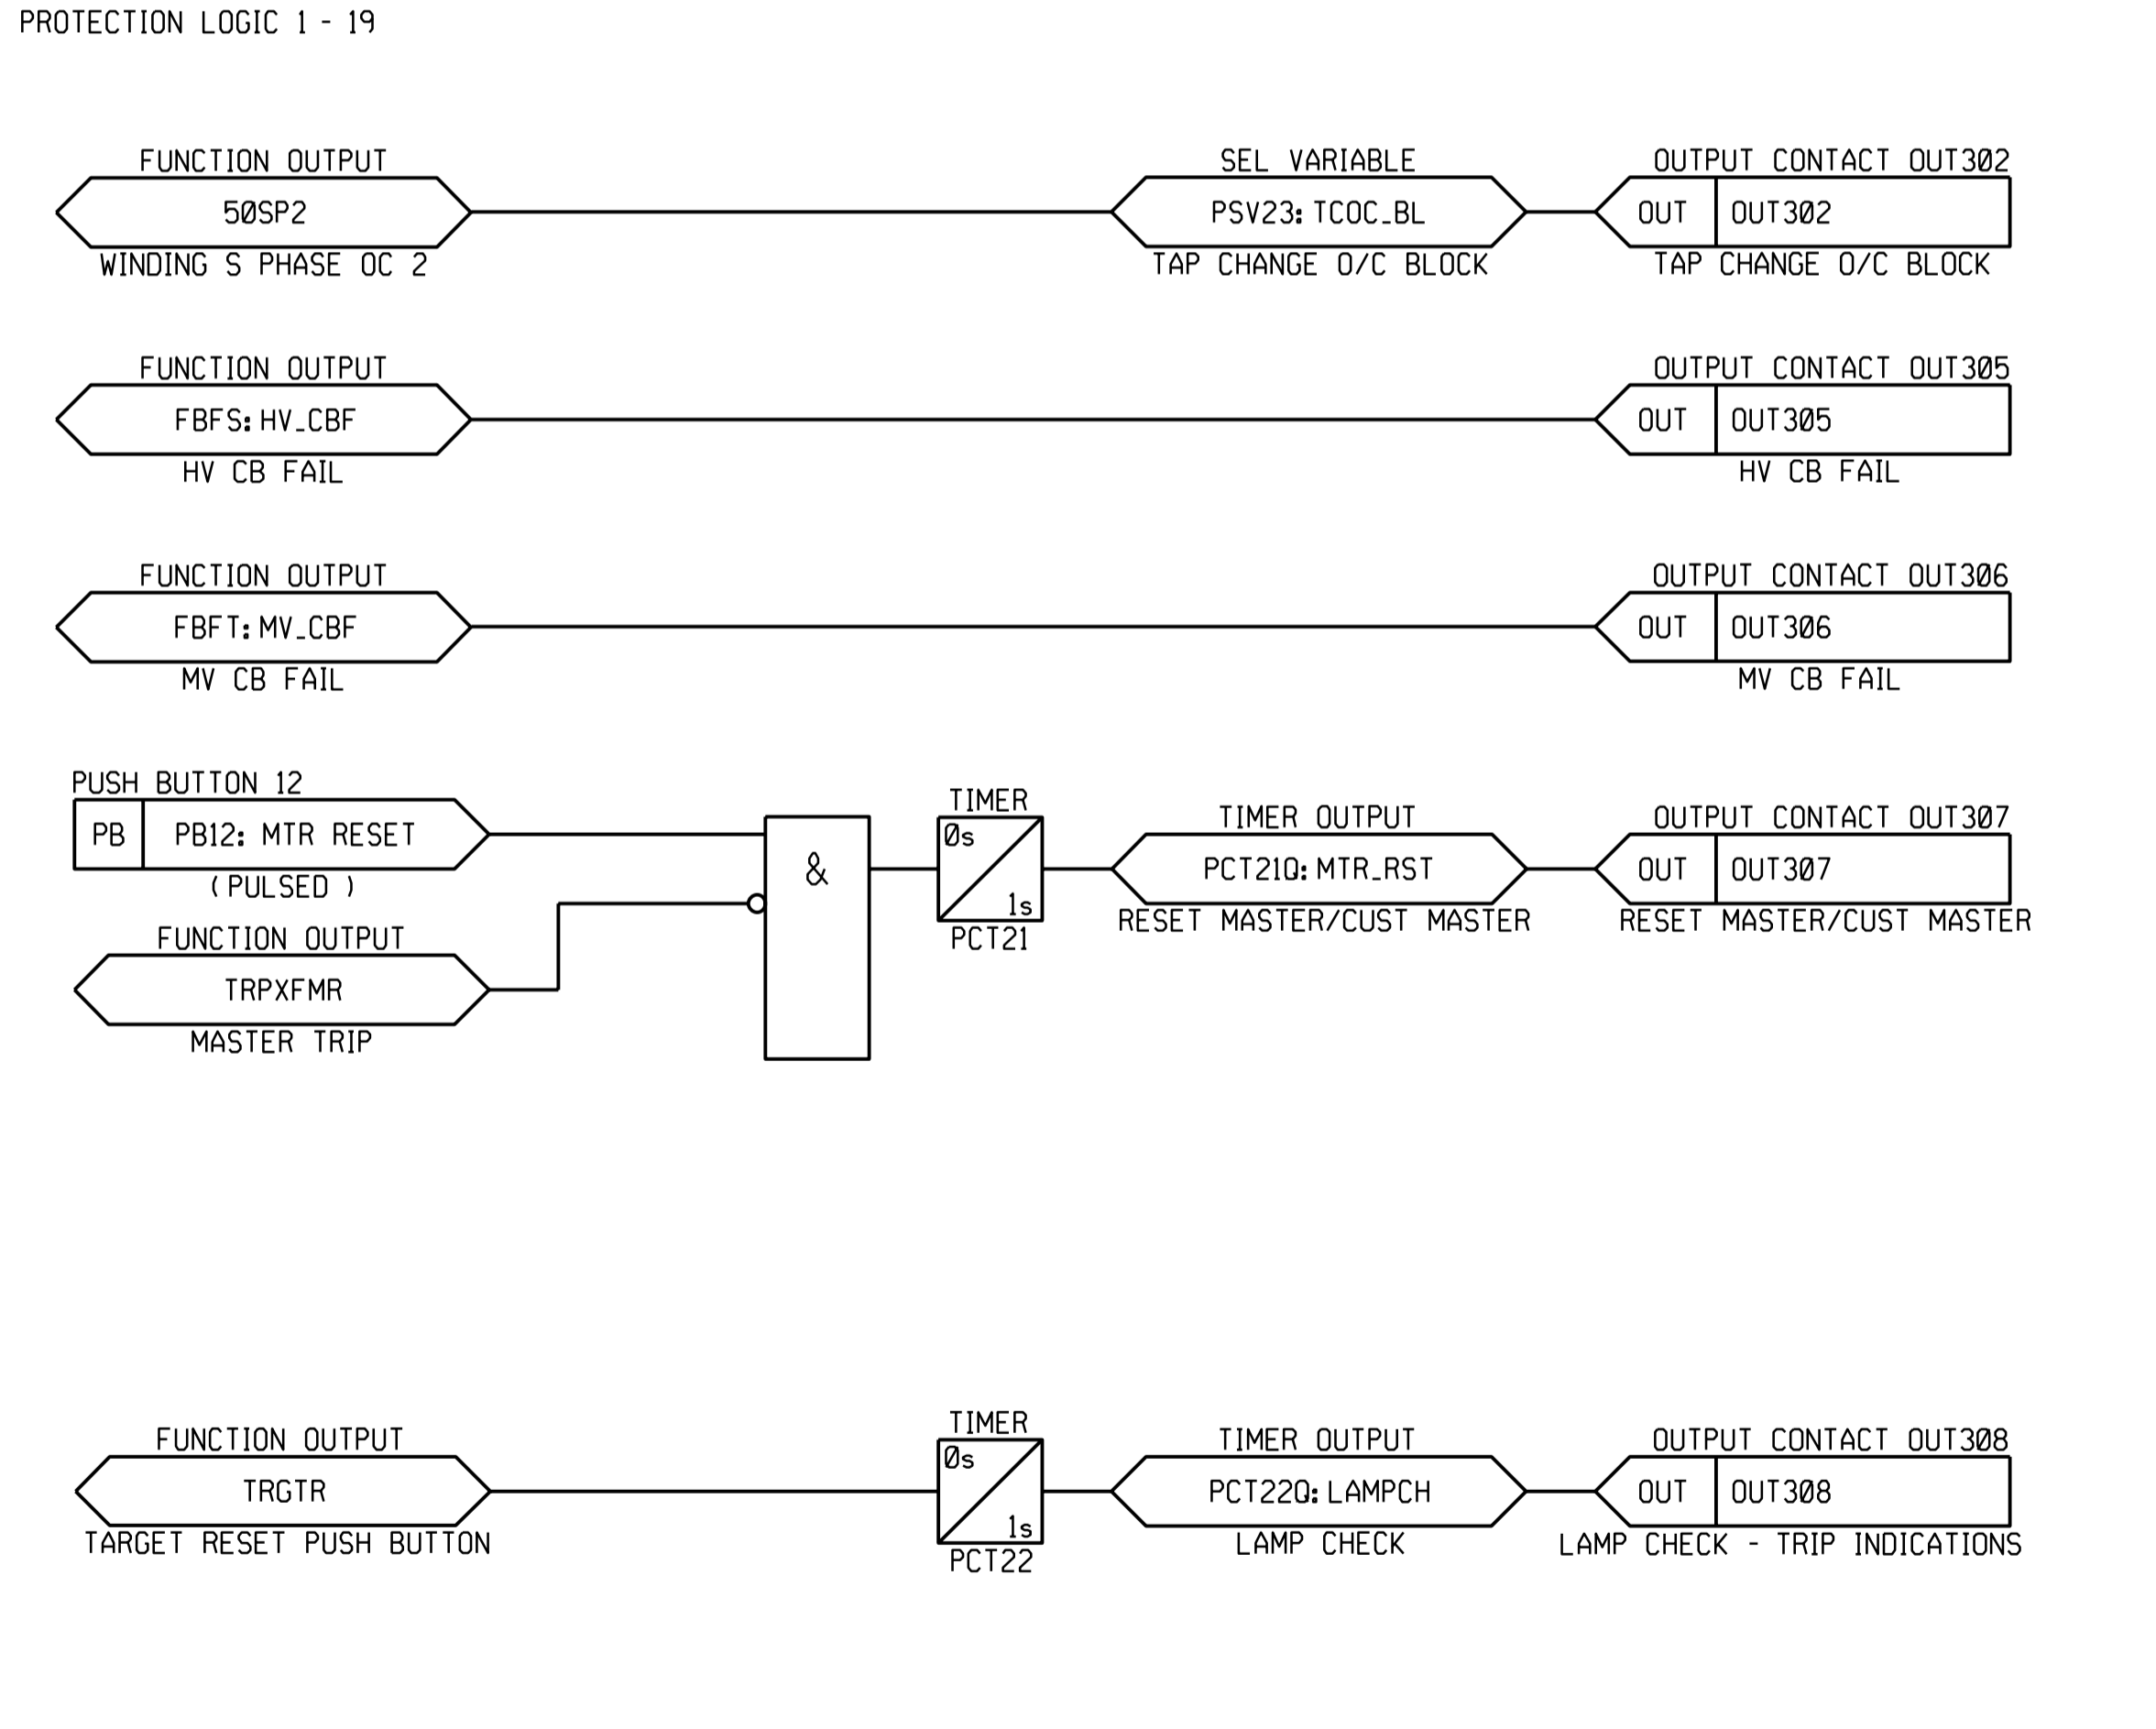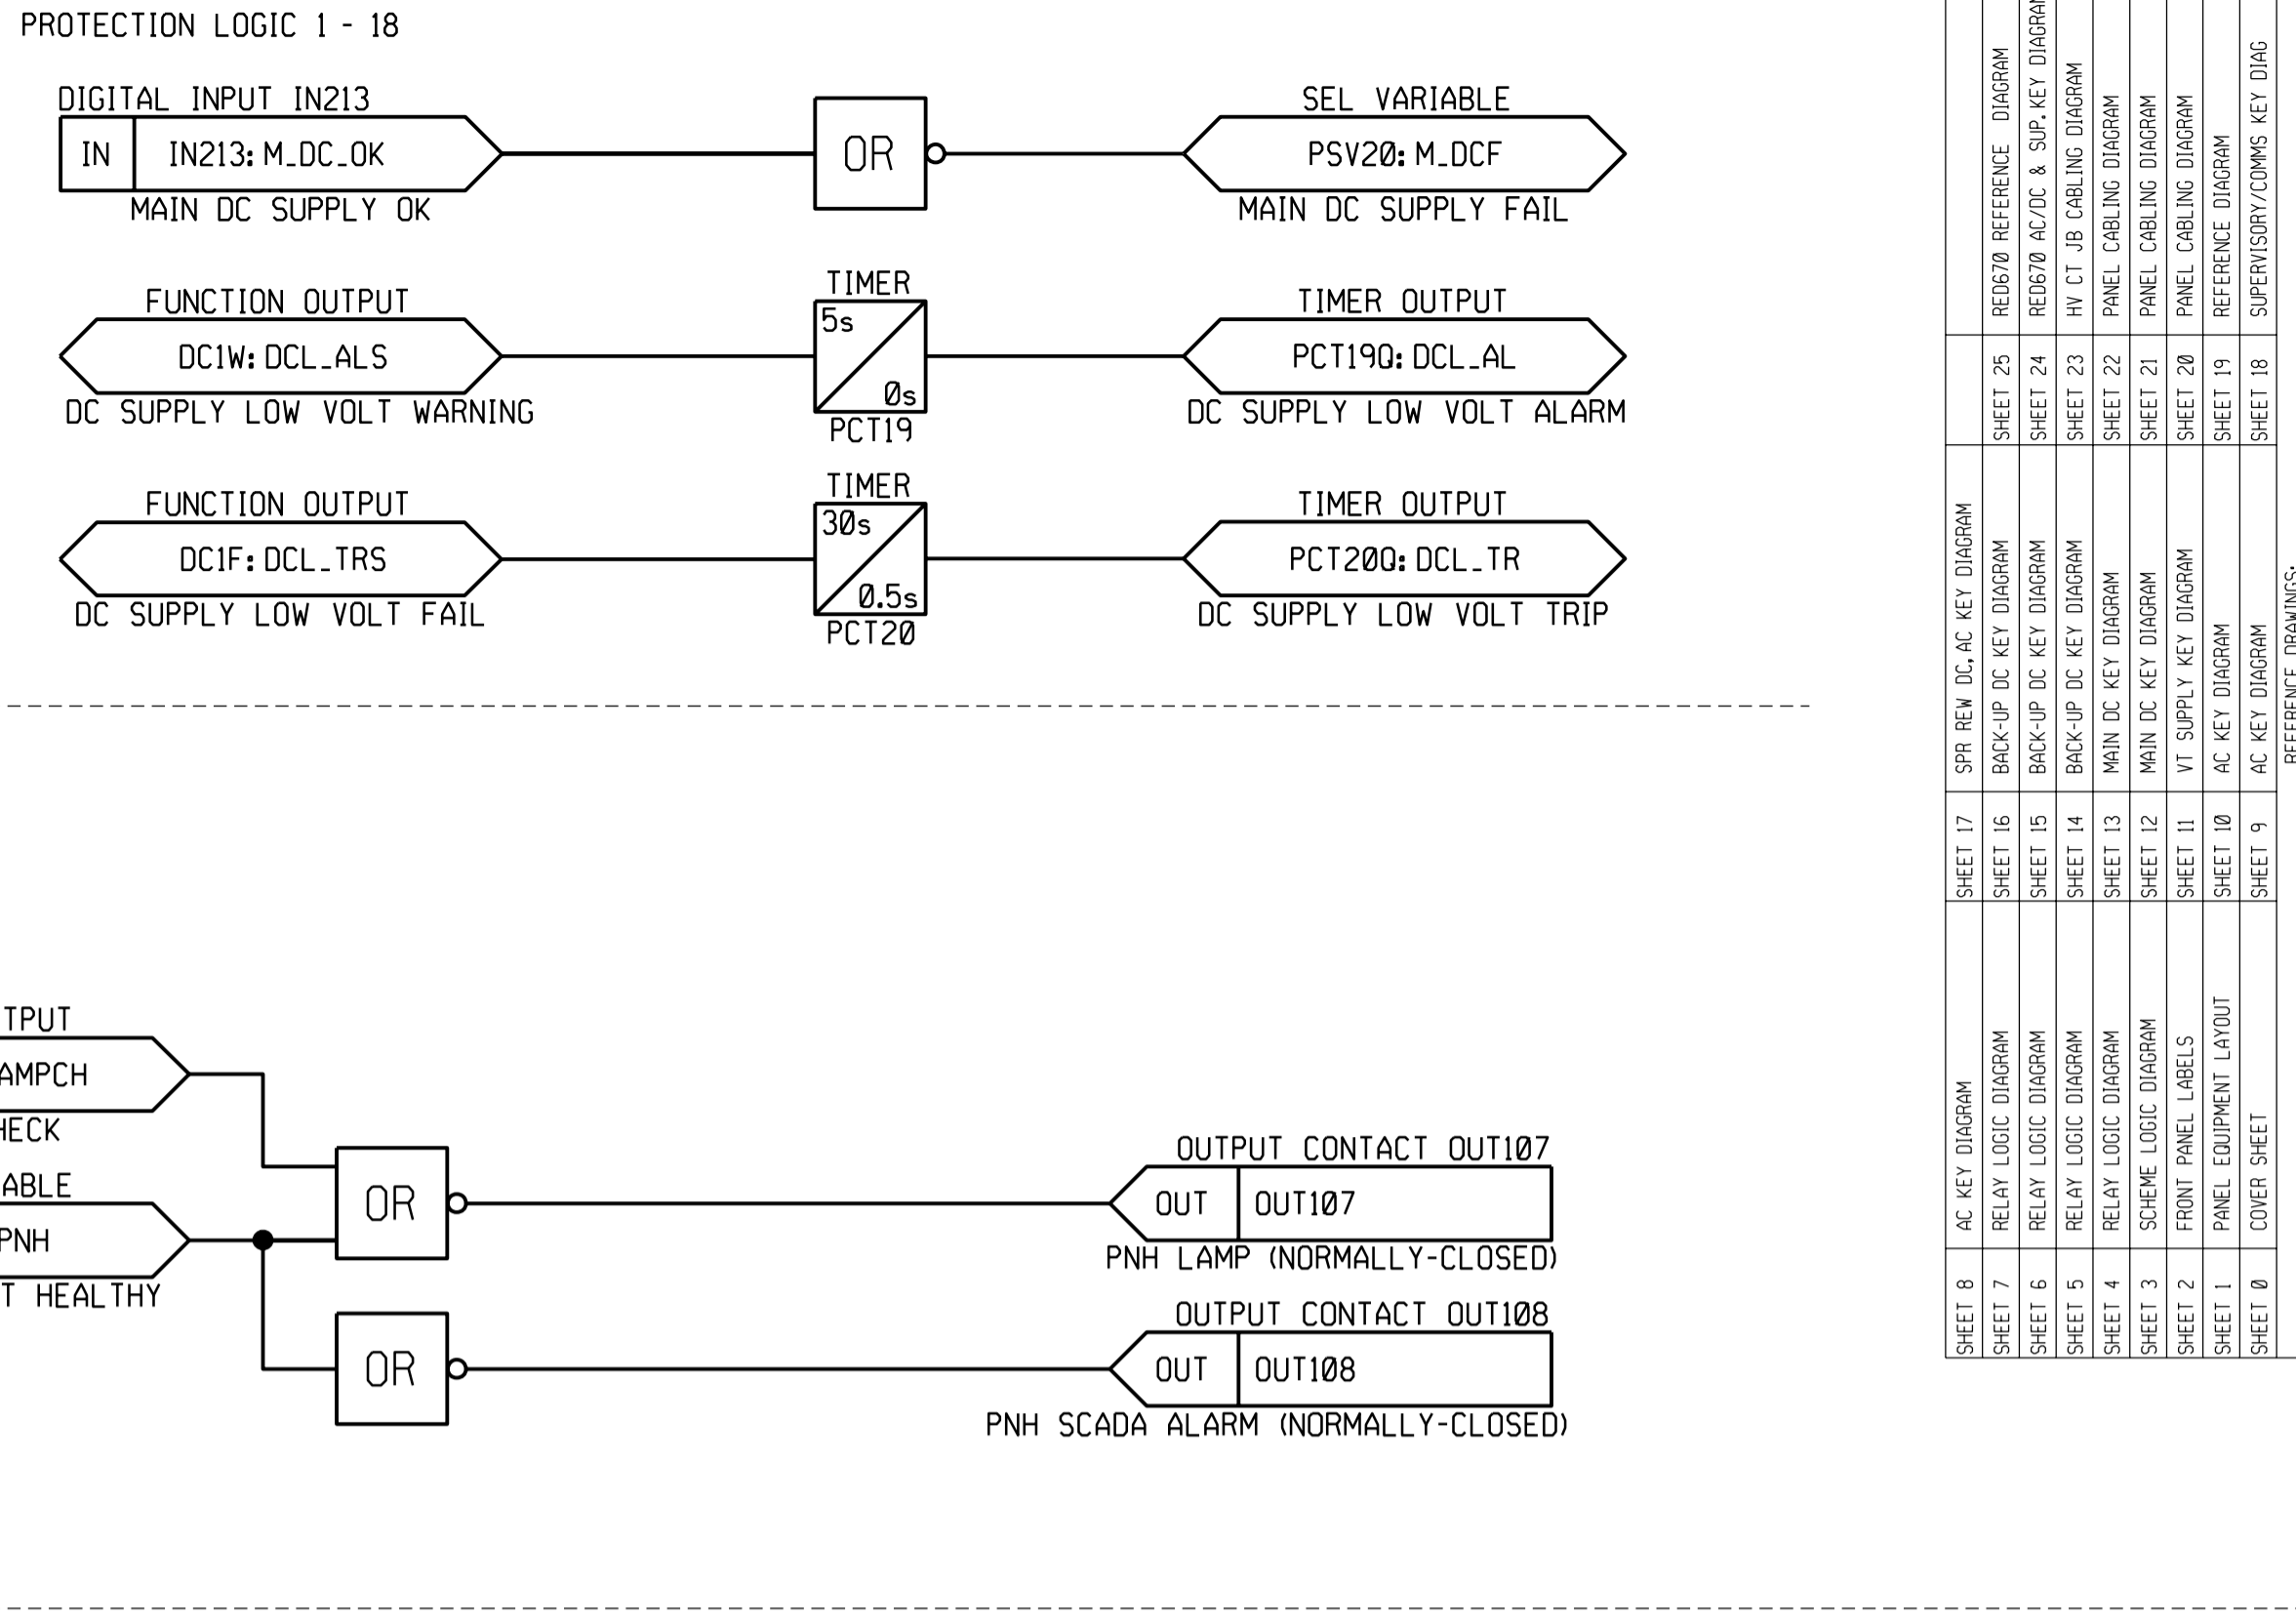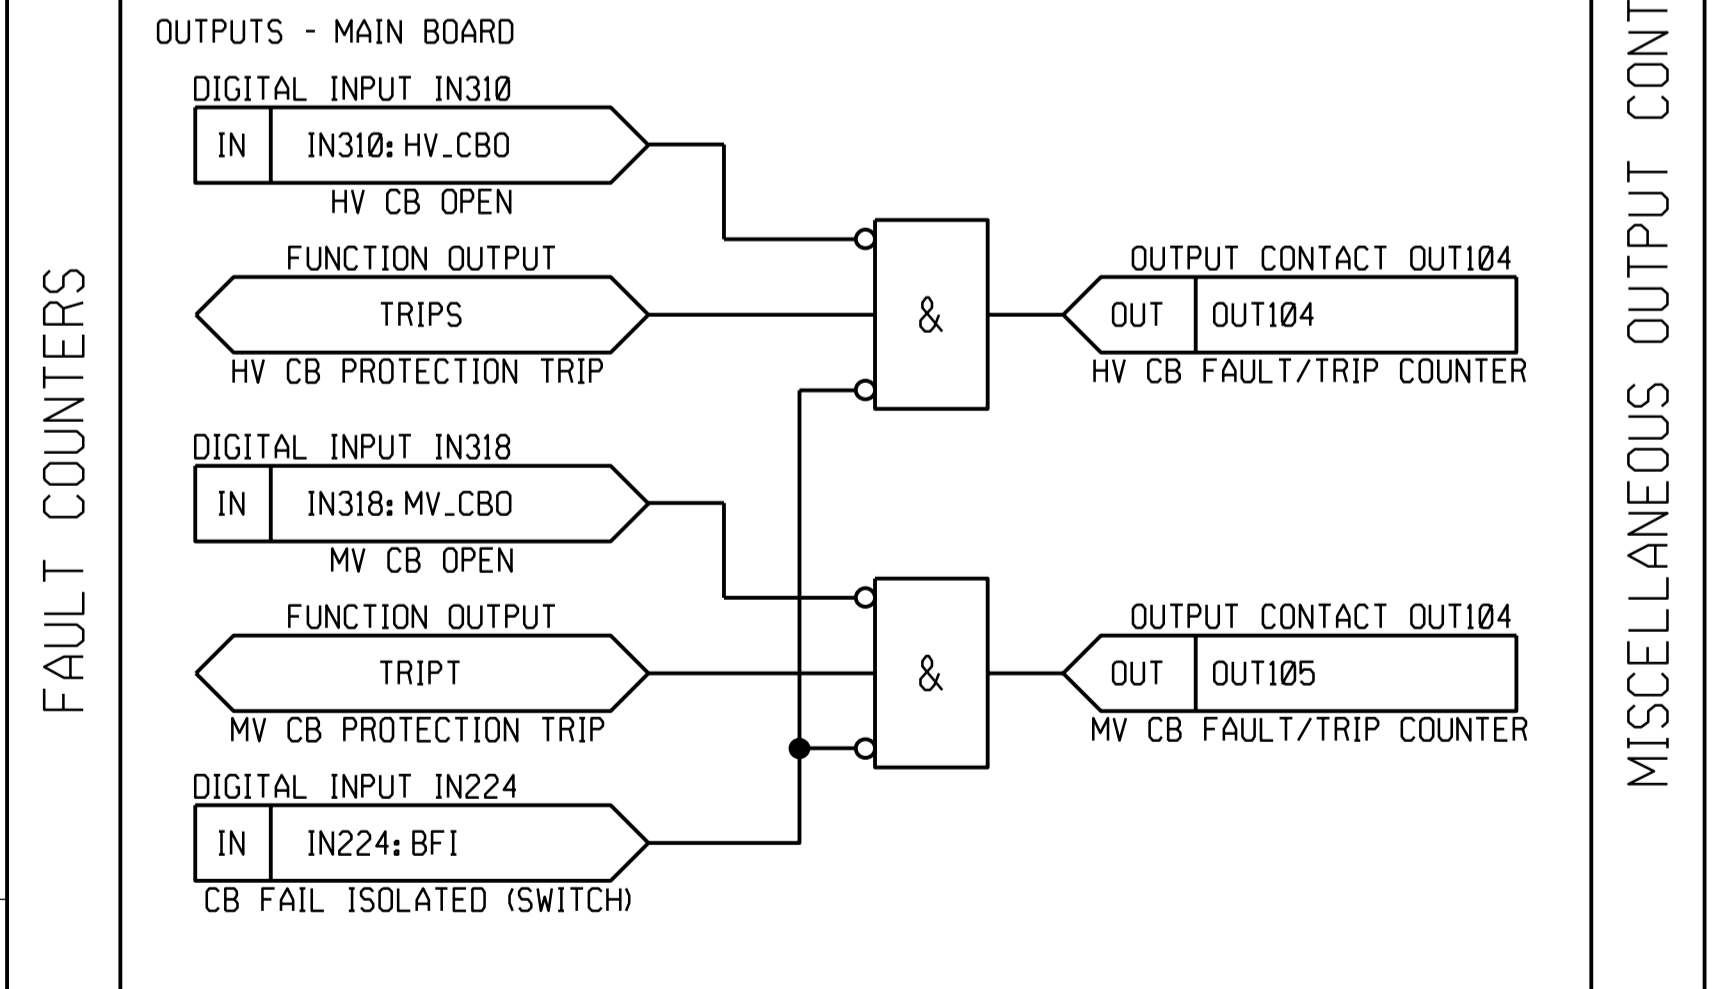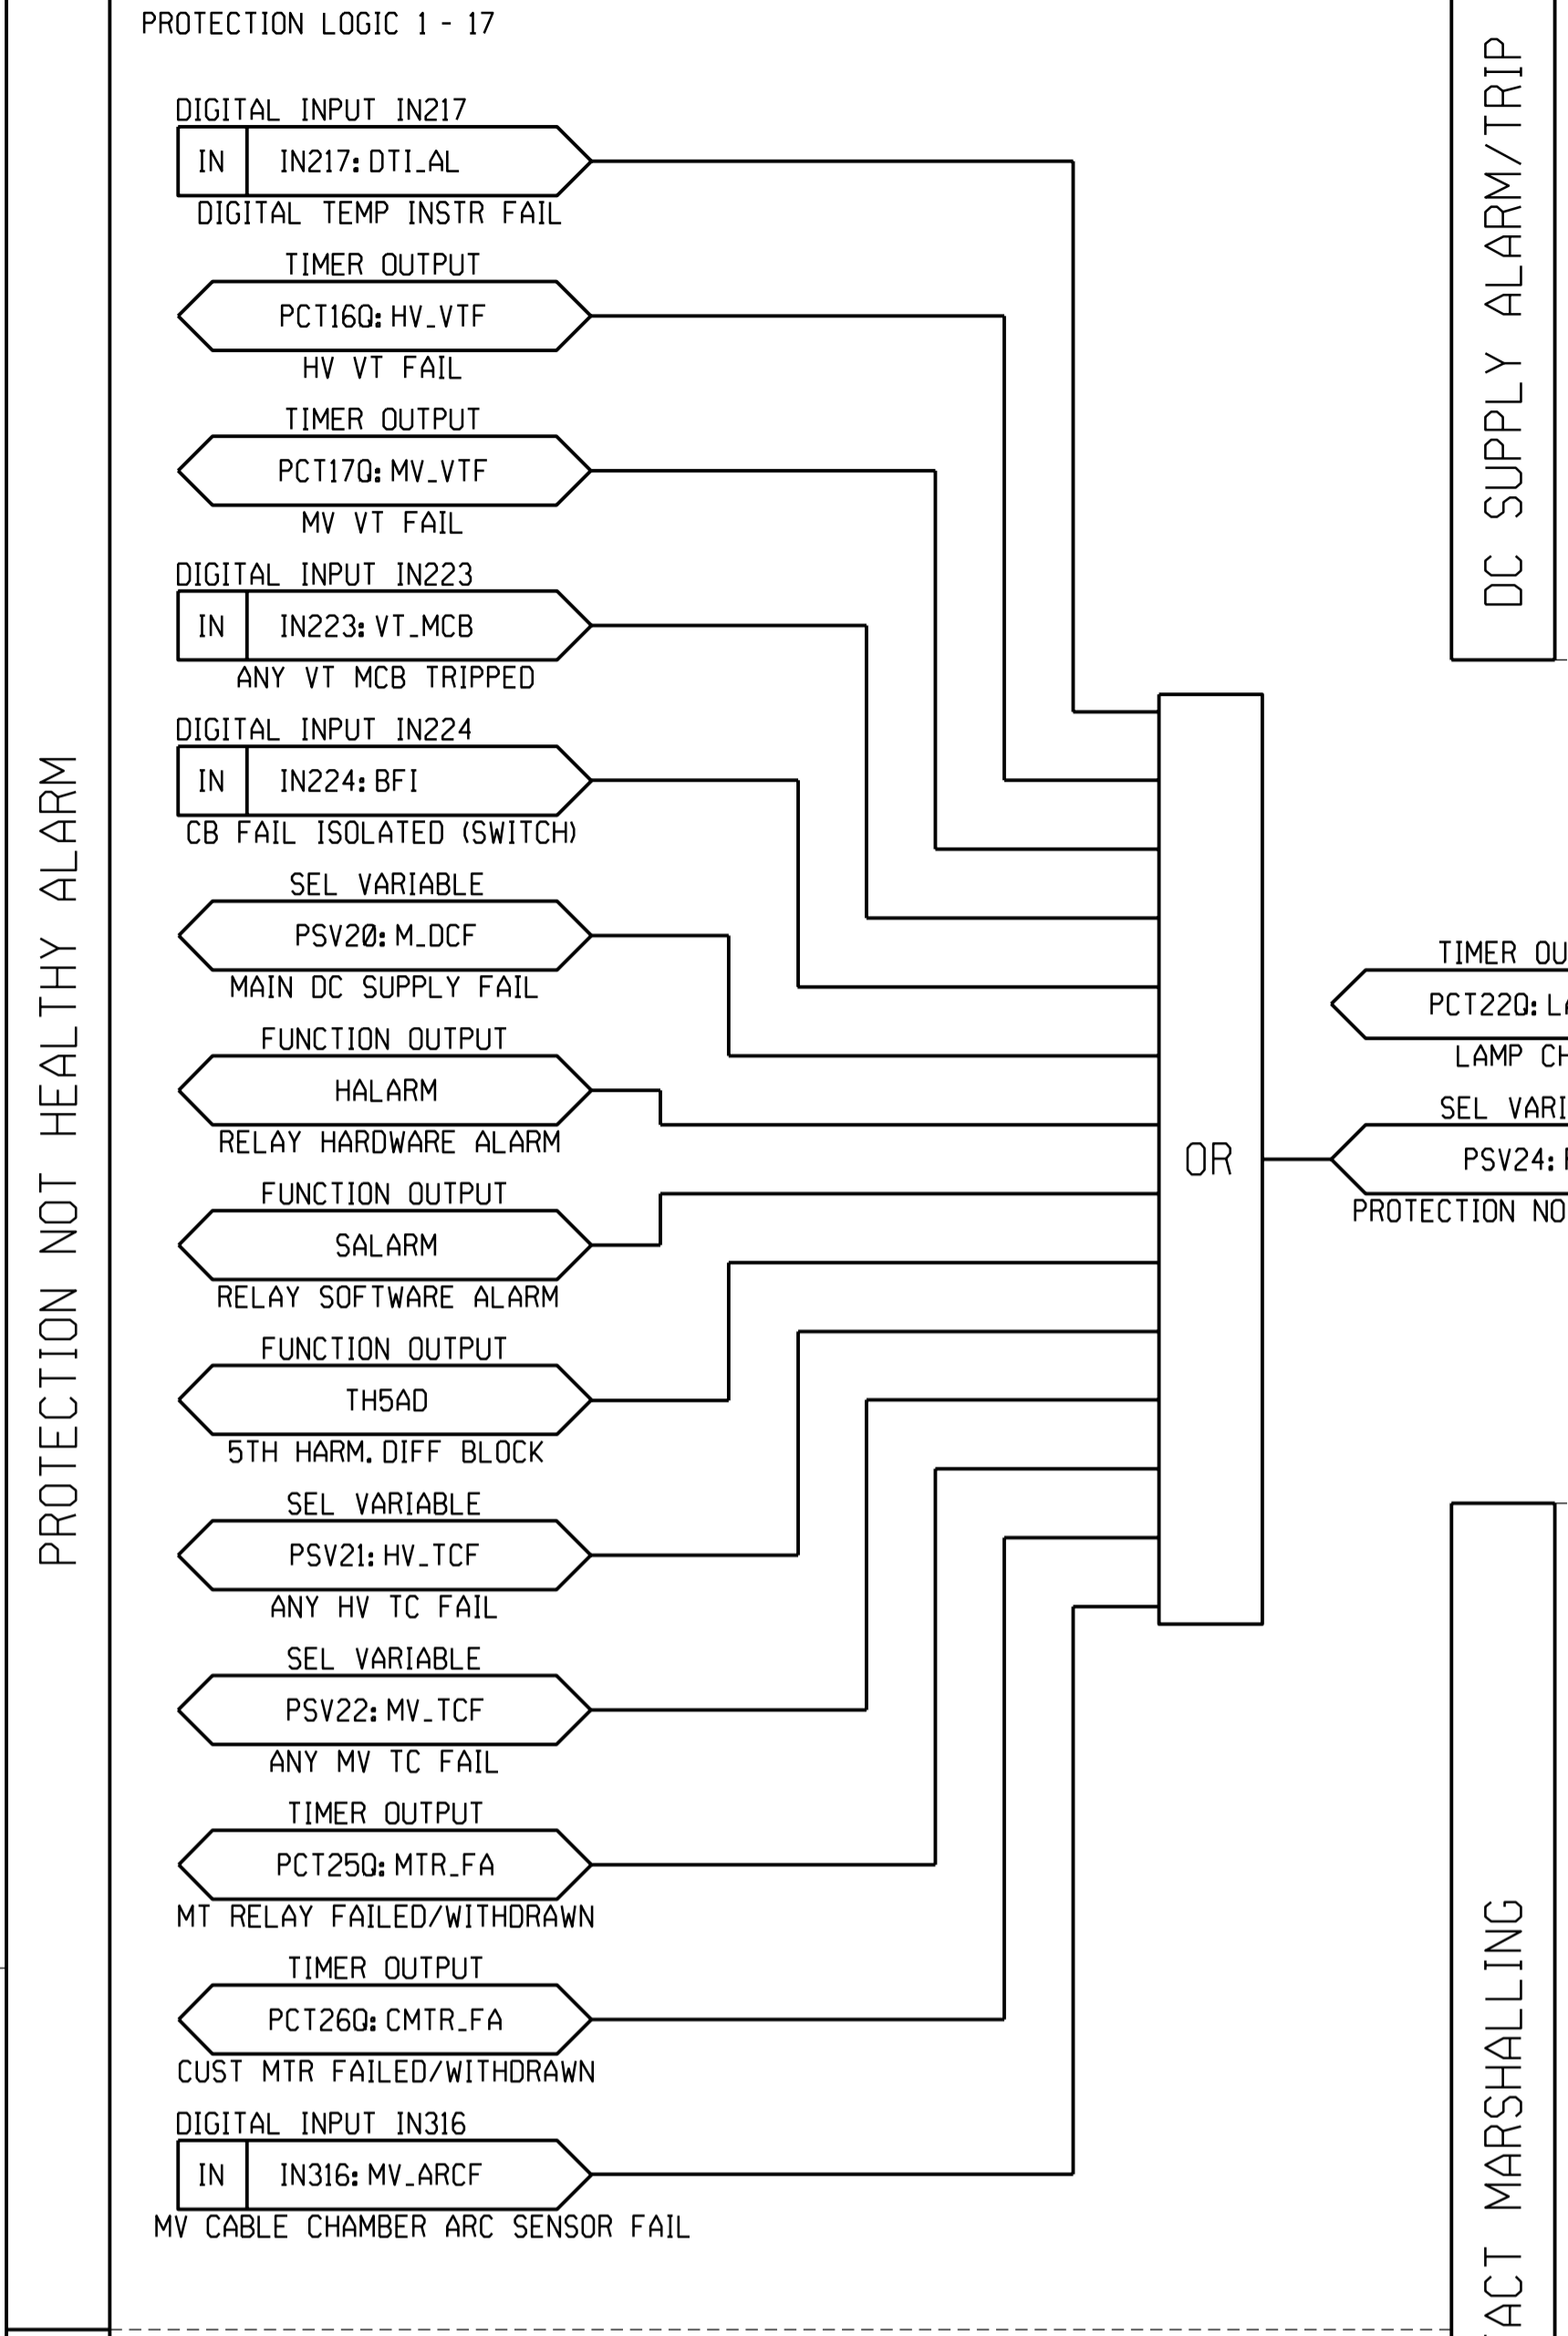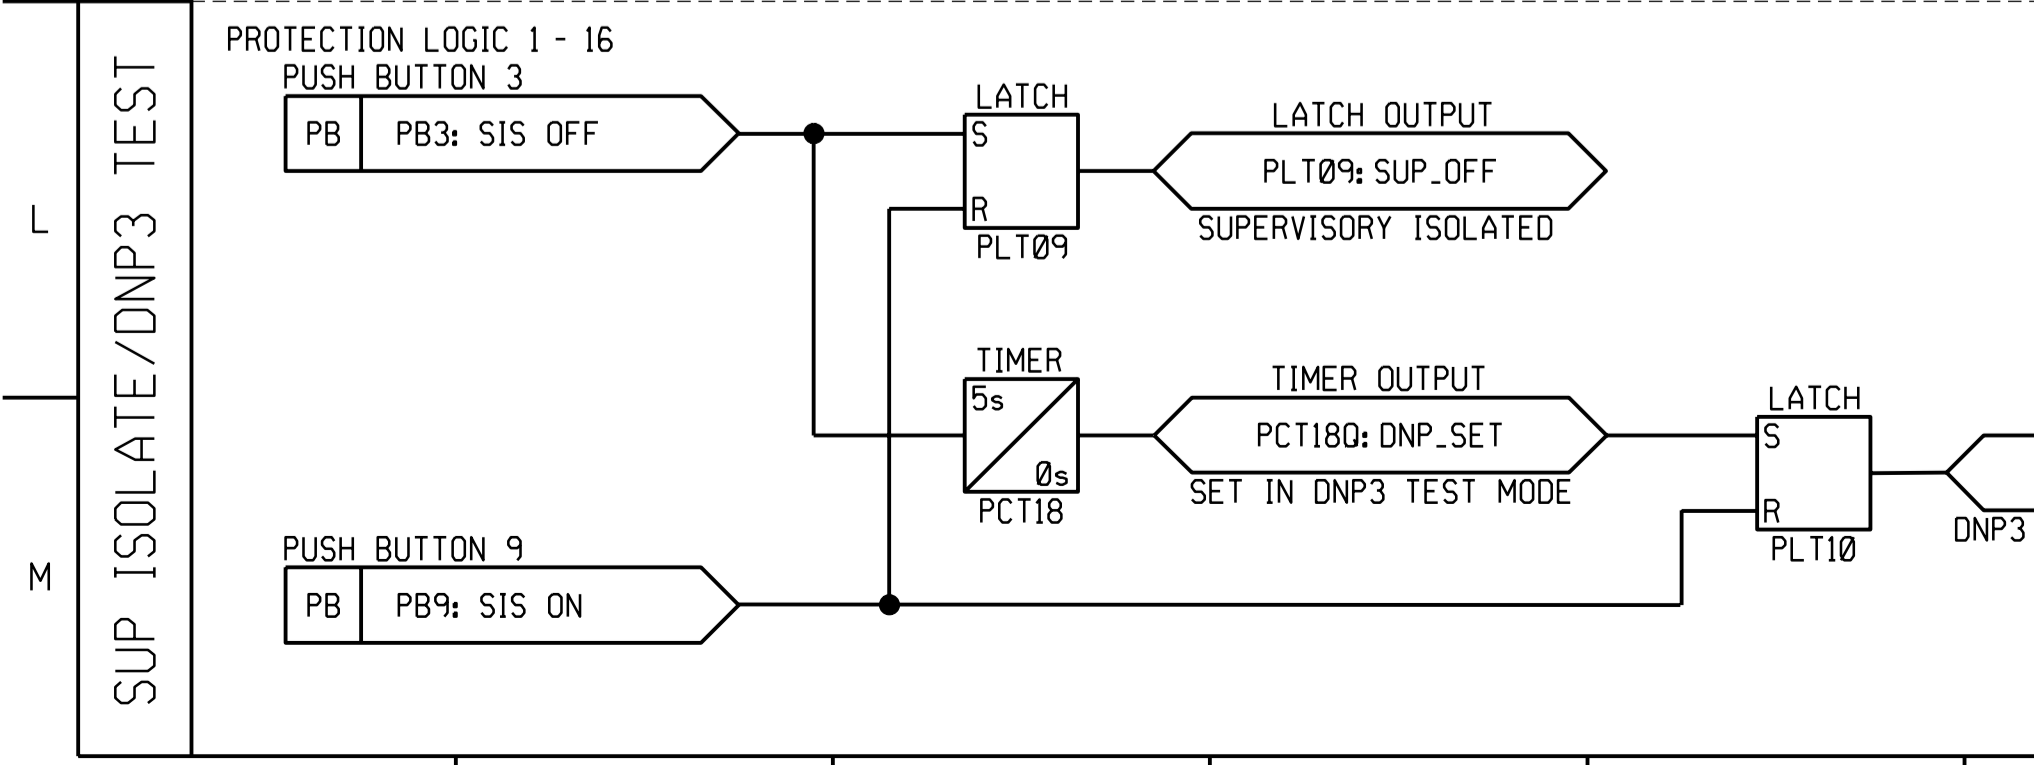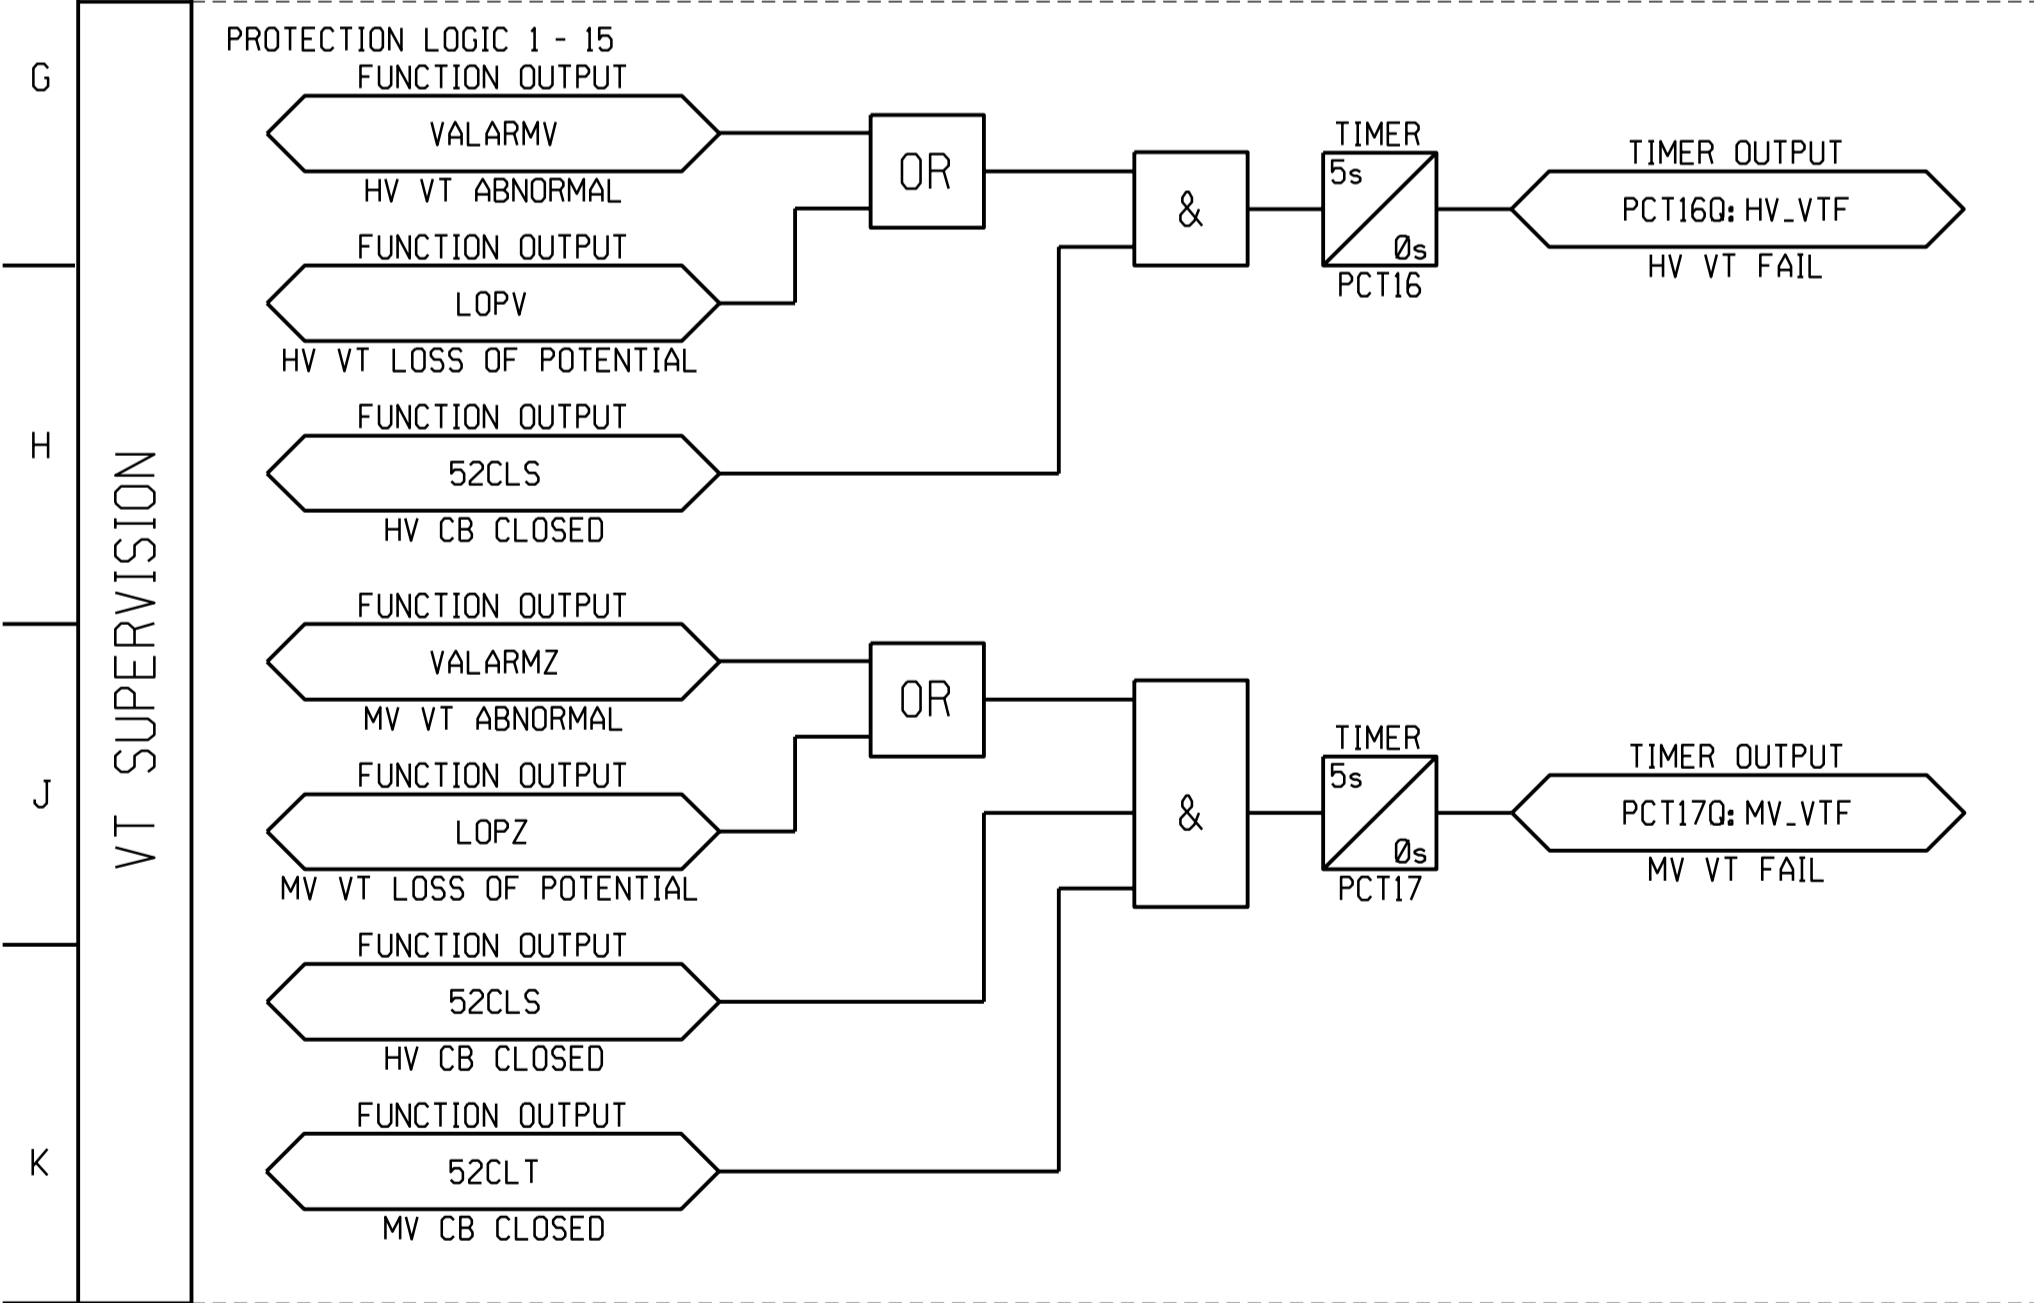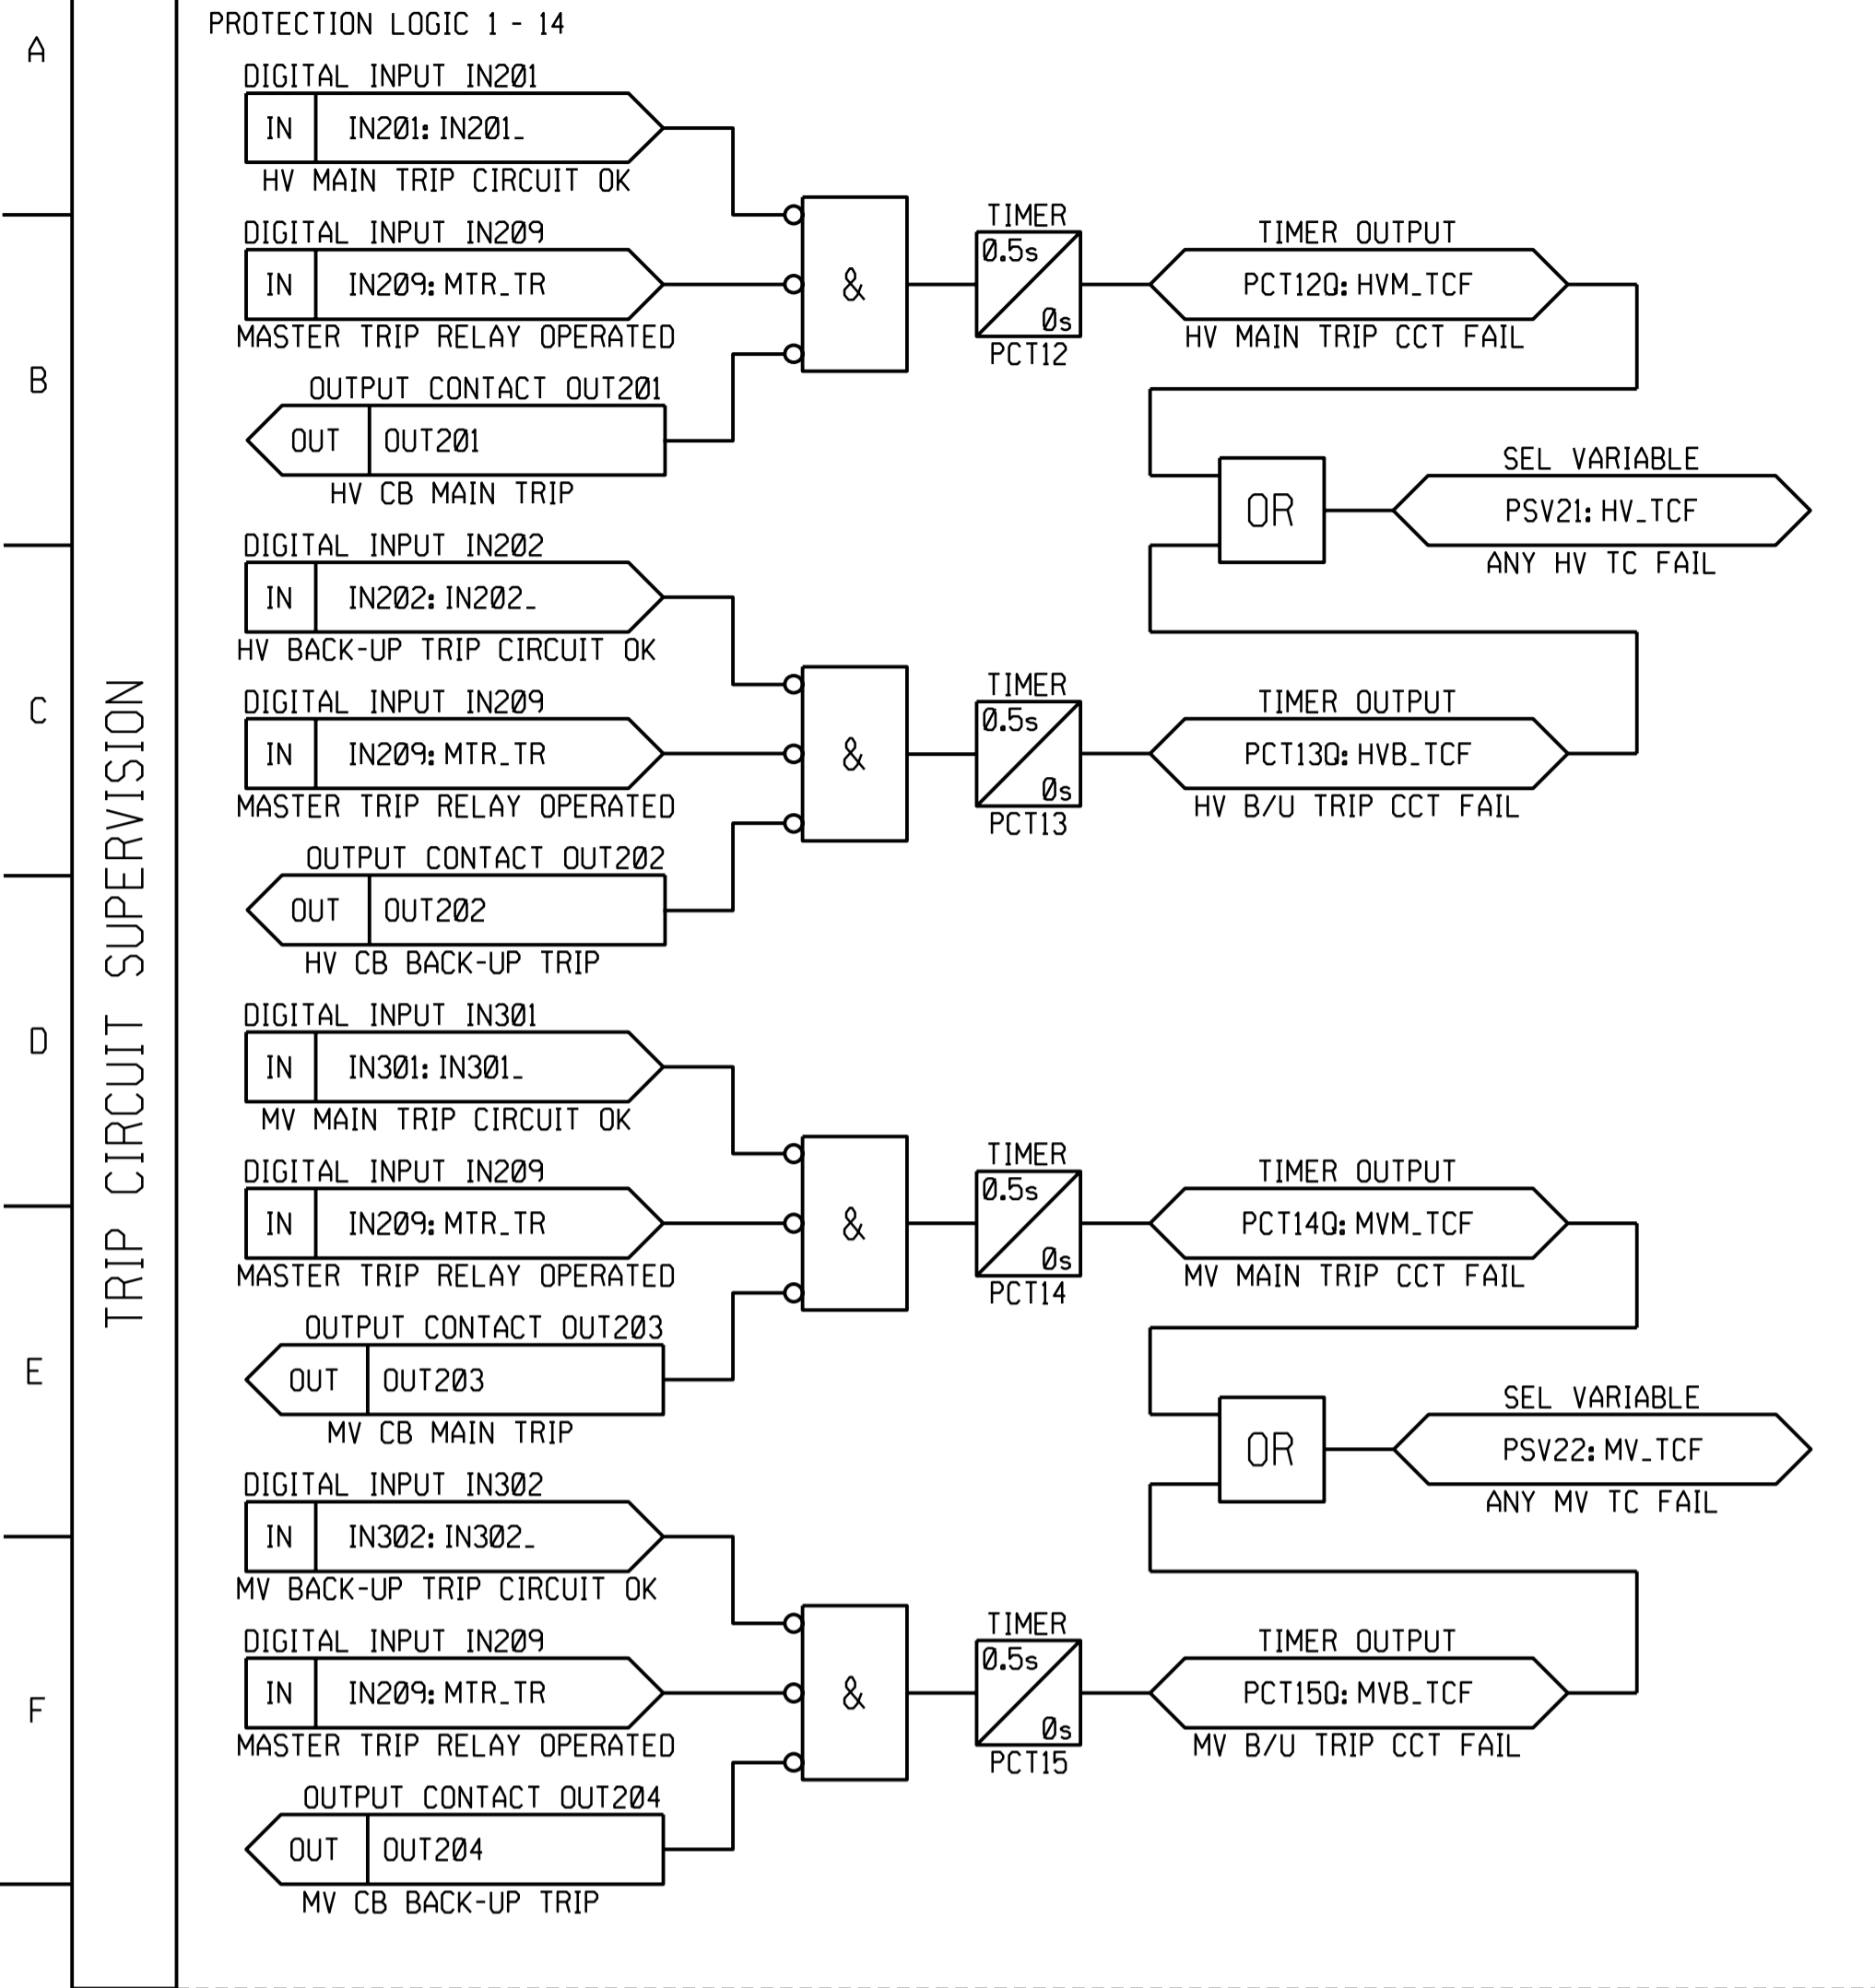

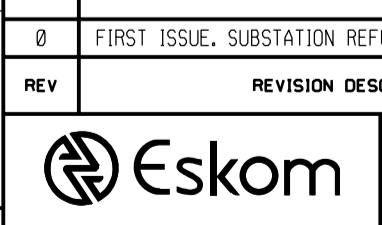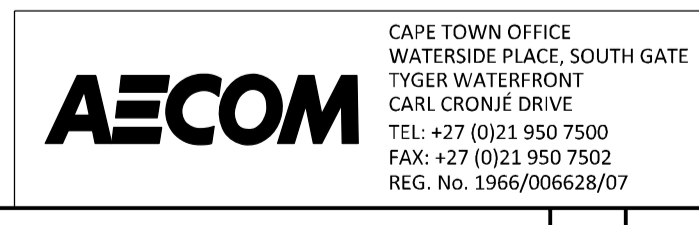

CAPE TOWN OFFICE WATERSIDE PLACE, SOUTH GATE TYGER WATERHOFONT CARL CROUWE DRIVE TEL: +27 (0)21 950 7500 FAX: +27 (0)21 950 7502 REG. No. 1966/006628/07		0 FIRST ISSUE, SUBSTATION REFURBISHED.		3487A		
REV	DESCRIPTION	BY	CHKD	AUTH	DATE	PROJECT NUMBER
1	SvZ 15/11/2010	CHANGES AS PER SHEET 0 - COVER SHEET.	SvZ	PAG	DATE 25/06/21	DATE 17/09/09
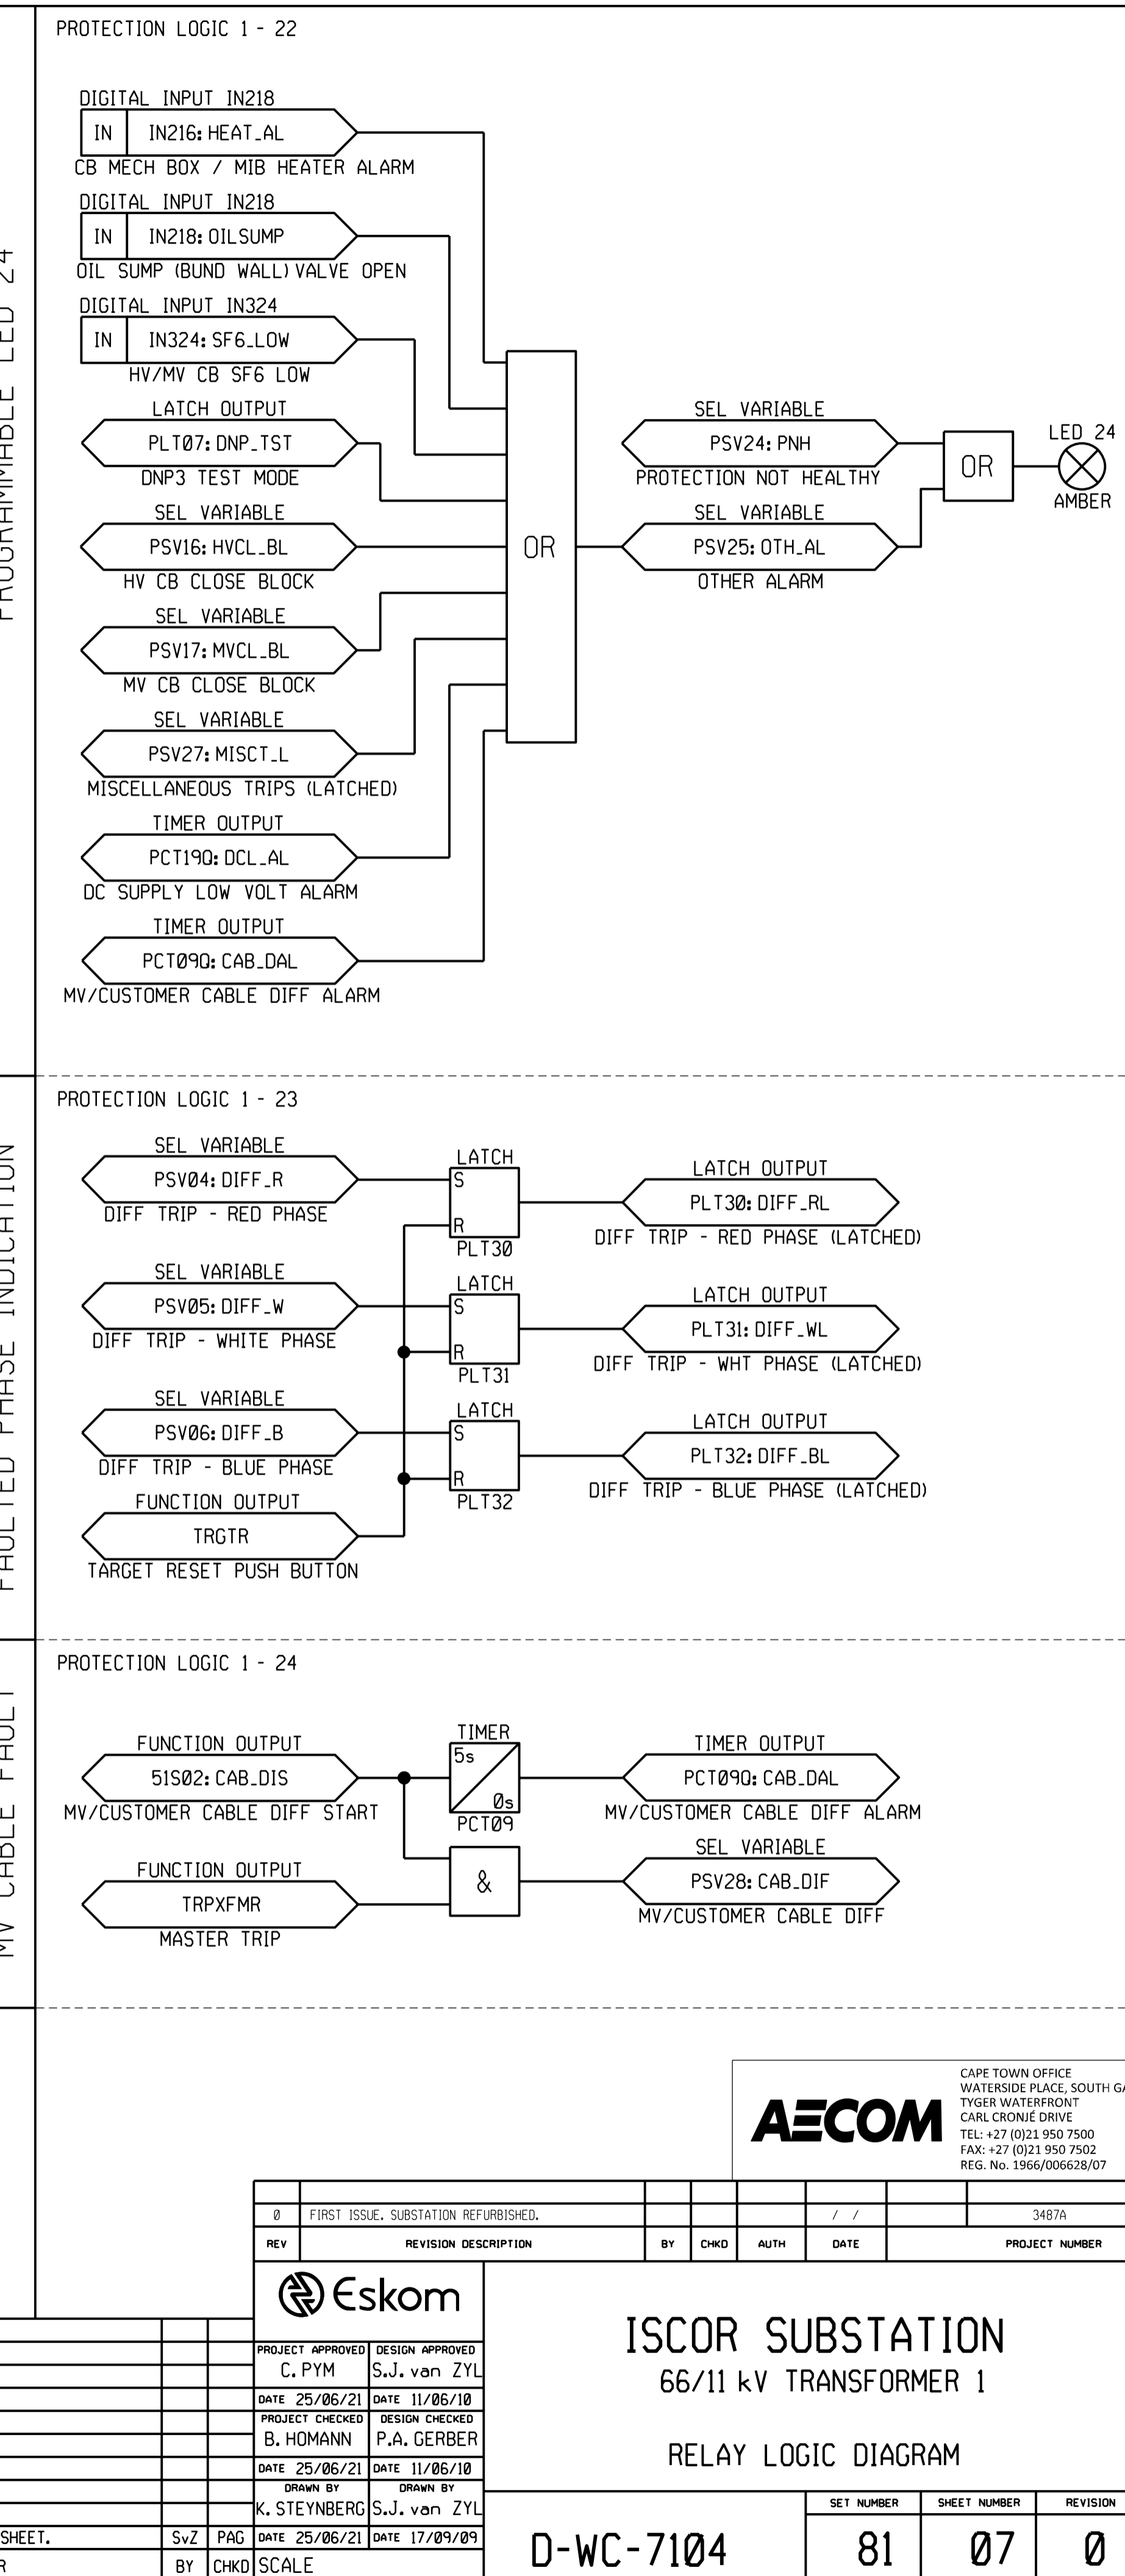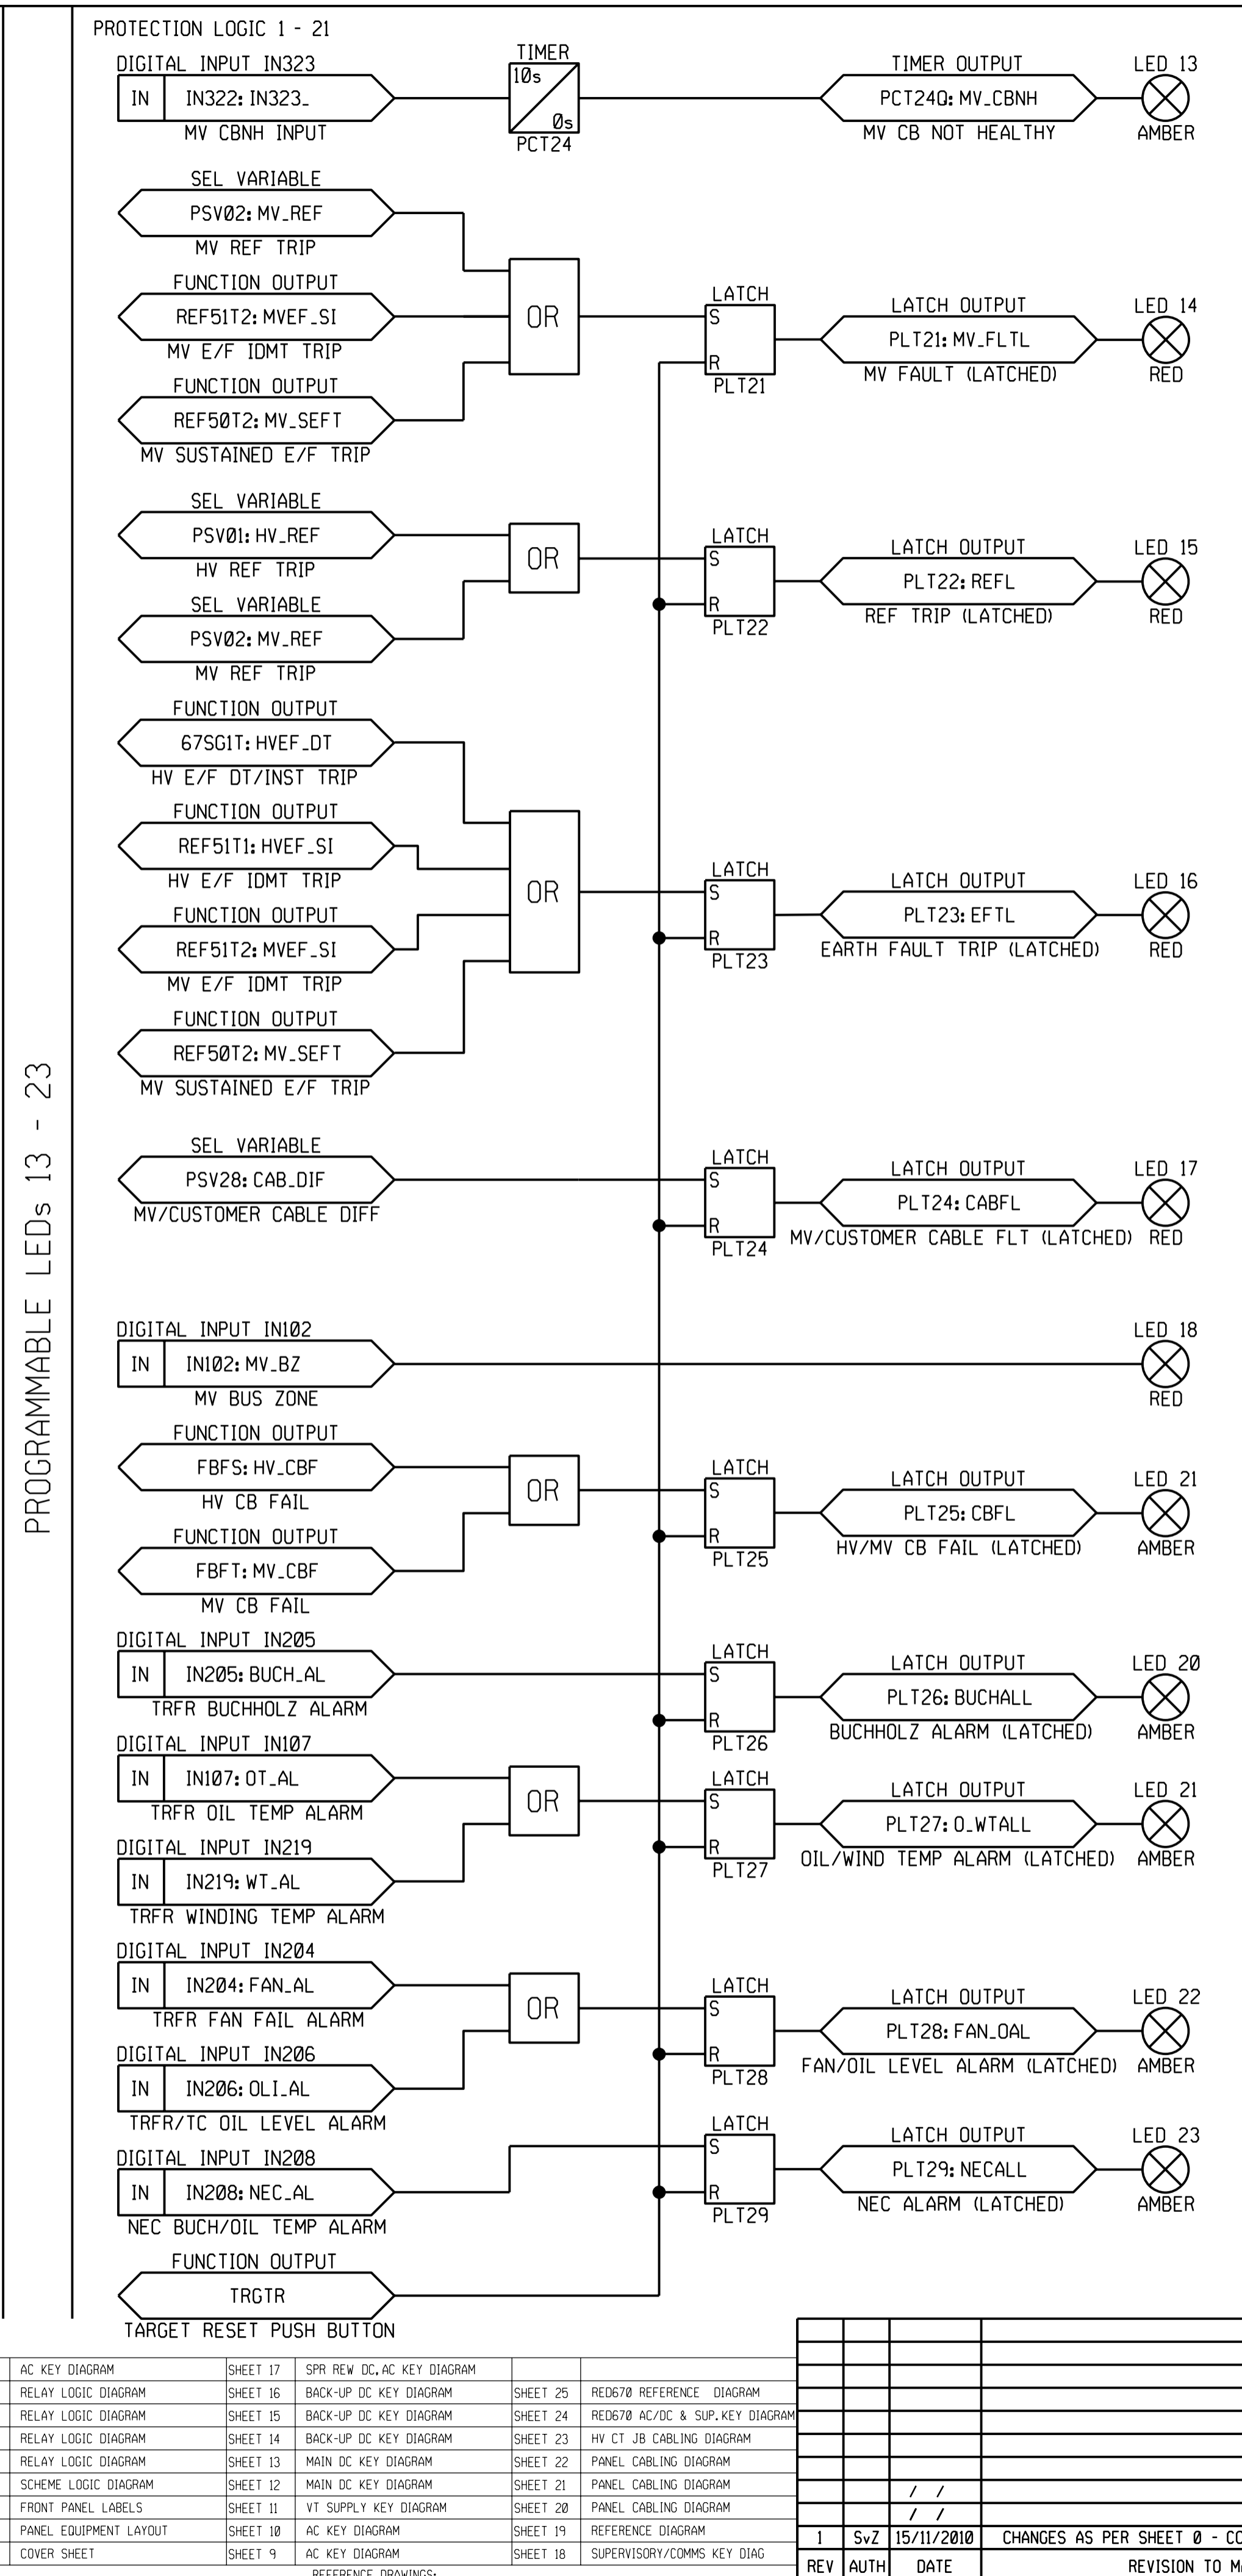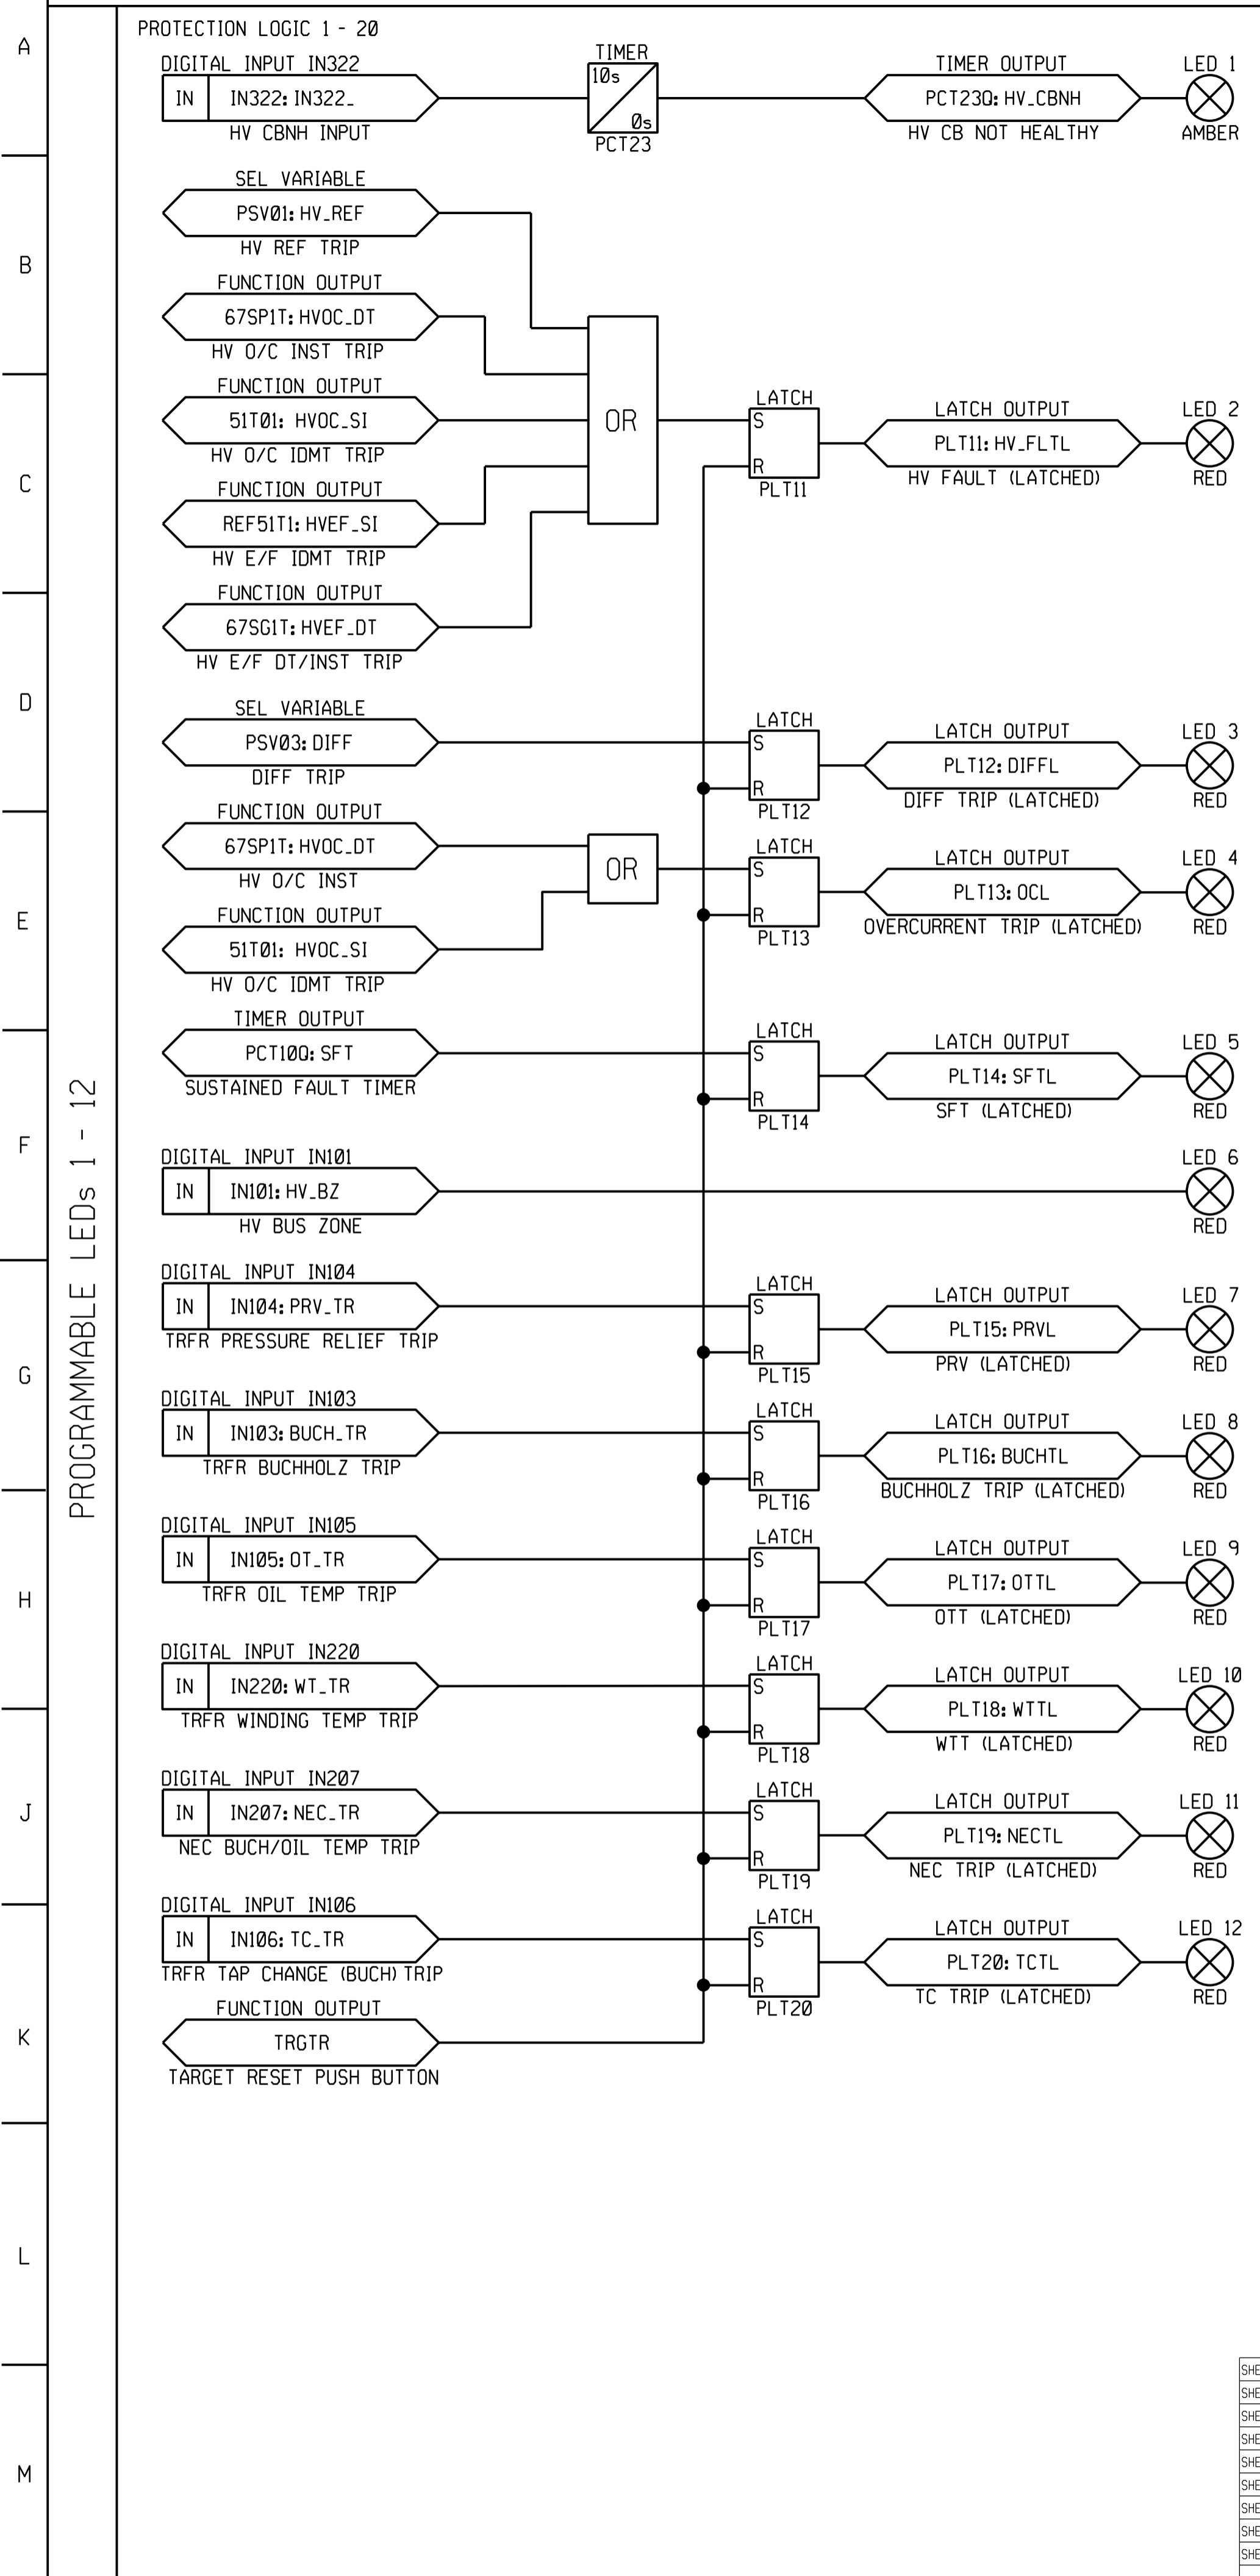

SHEET 8	AC KEY DIAGRAM	SHEET 17	SPR REV DC AC KEY DIAGRAM	SHEET 25	RED670 REFERENCE DIAGRAM
SHEET 7	RELAY LOGIC DIAGRAM	SHEET 16	BACK-UP DC KEY DIAGRAM	SHEET 24	RED670 AC/DC & SUPP. KEY DIAGRAM
SHEET 6	RELAY LOGIC DIAGRAM	SHEET 15	BACK-UP DC KEY DIAGRAM	SHEET 23	HV CT JB CABLING DIAGRAM
SHEET 5	RELAY LOGIC DIAGRAM	SHEET 14	BACK-UP DC KEY DIAGRAM	SHEET 22	PANEL CABLING DIAGRAM
SHEET 4	RELAY LOGIC DIAGRAM	SHEET 13	MAIN DC KEY DIAGRAM	SHEET 21	PANEL CABLING DIAGRAM
SHEET 3	SCHEME LOGIC DIAGRAM	SHEET 12	MAIN DC KEY DIAGRAM	SHEET 20	PANEL CABLING DIAGRAM
SHEET 2	FRONT PANEL LABELS	SHEET 11	VT SUPPLY KEY DIAGRAM	SHEET 19	PANEL CABLING DIAGRAM
SHEET 1	PANEL EQUIPMENT LAYOUT	SHEET 10	AC KEY DIAGRAM	SHEET 18	REFERENCE DIAGRAM
SHEET 0	COVER SHEET	SHEET 9	AC KEY DIAGRAM	SHEET 18	SUPERVISORY/COMMS KEY DIAG

1	SvZ	15/11/2010	CHANGES AS PER SHEET 0 - COVER SHEET.	SvZ	PAG	DATE 25/06/21	DATE 17/09/09
REV	AUTH	DATE	REVISION TO MASTER	BY	CHKD	SCALE	

AECOM

CAPE TOWN OFFICE
WATERSIDE PLACE, SOUTH GATE
TYGER WATERFRONT
CARL CRONIE DRIVE
TEL: +27 (0)21 950 7500
FAX: +27 (0)21 950 7502
REG. NO. 1966/006628/07

Eskom

ISCOR SUBSTATION
66/11 kV TRANSFORMER 1


RELAY LOGIC DIAGRAM

D-WC-7104

SET NUMBER	SHEET NUMBER	REVISION
81	07	0

PANEL TYPE DESIGNATION 4TM710MOD.F.ZD

MASTER TRACING FILED UNDER D-DT-15202 SHEET 7 OF 26 REVISION 1

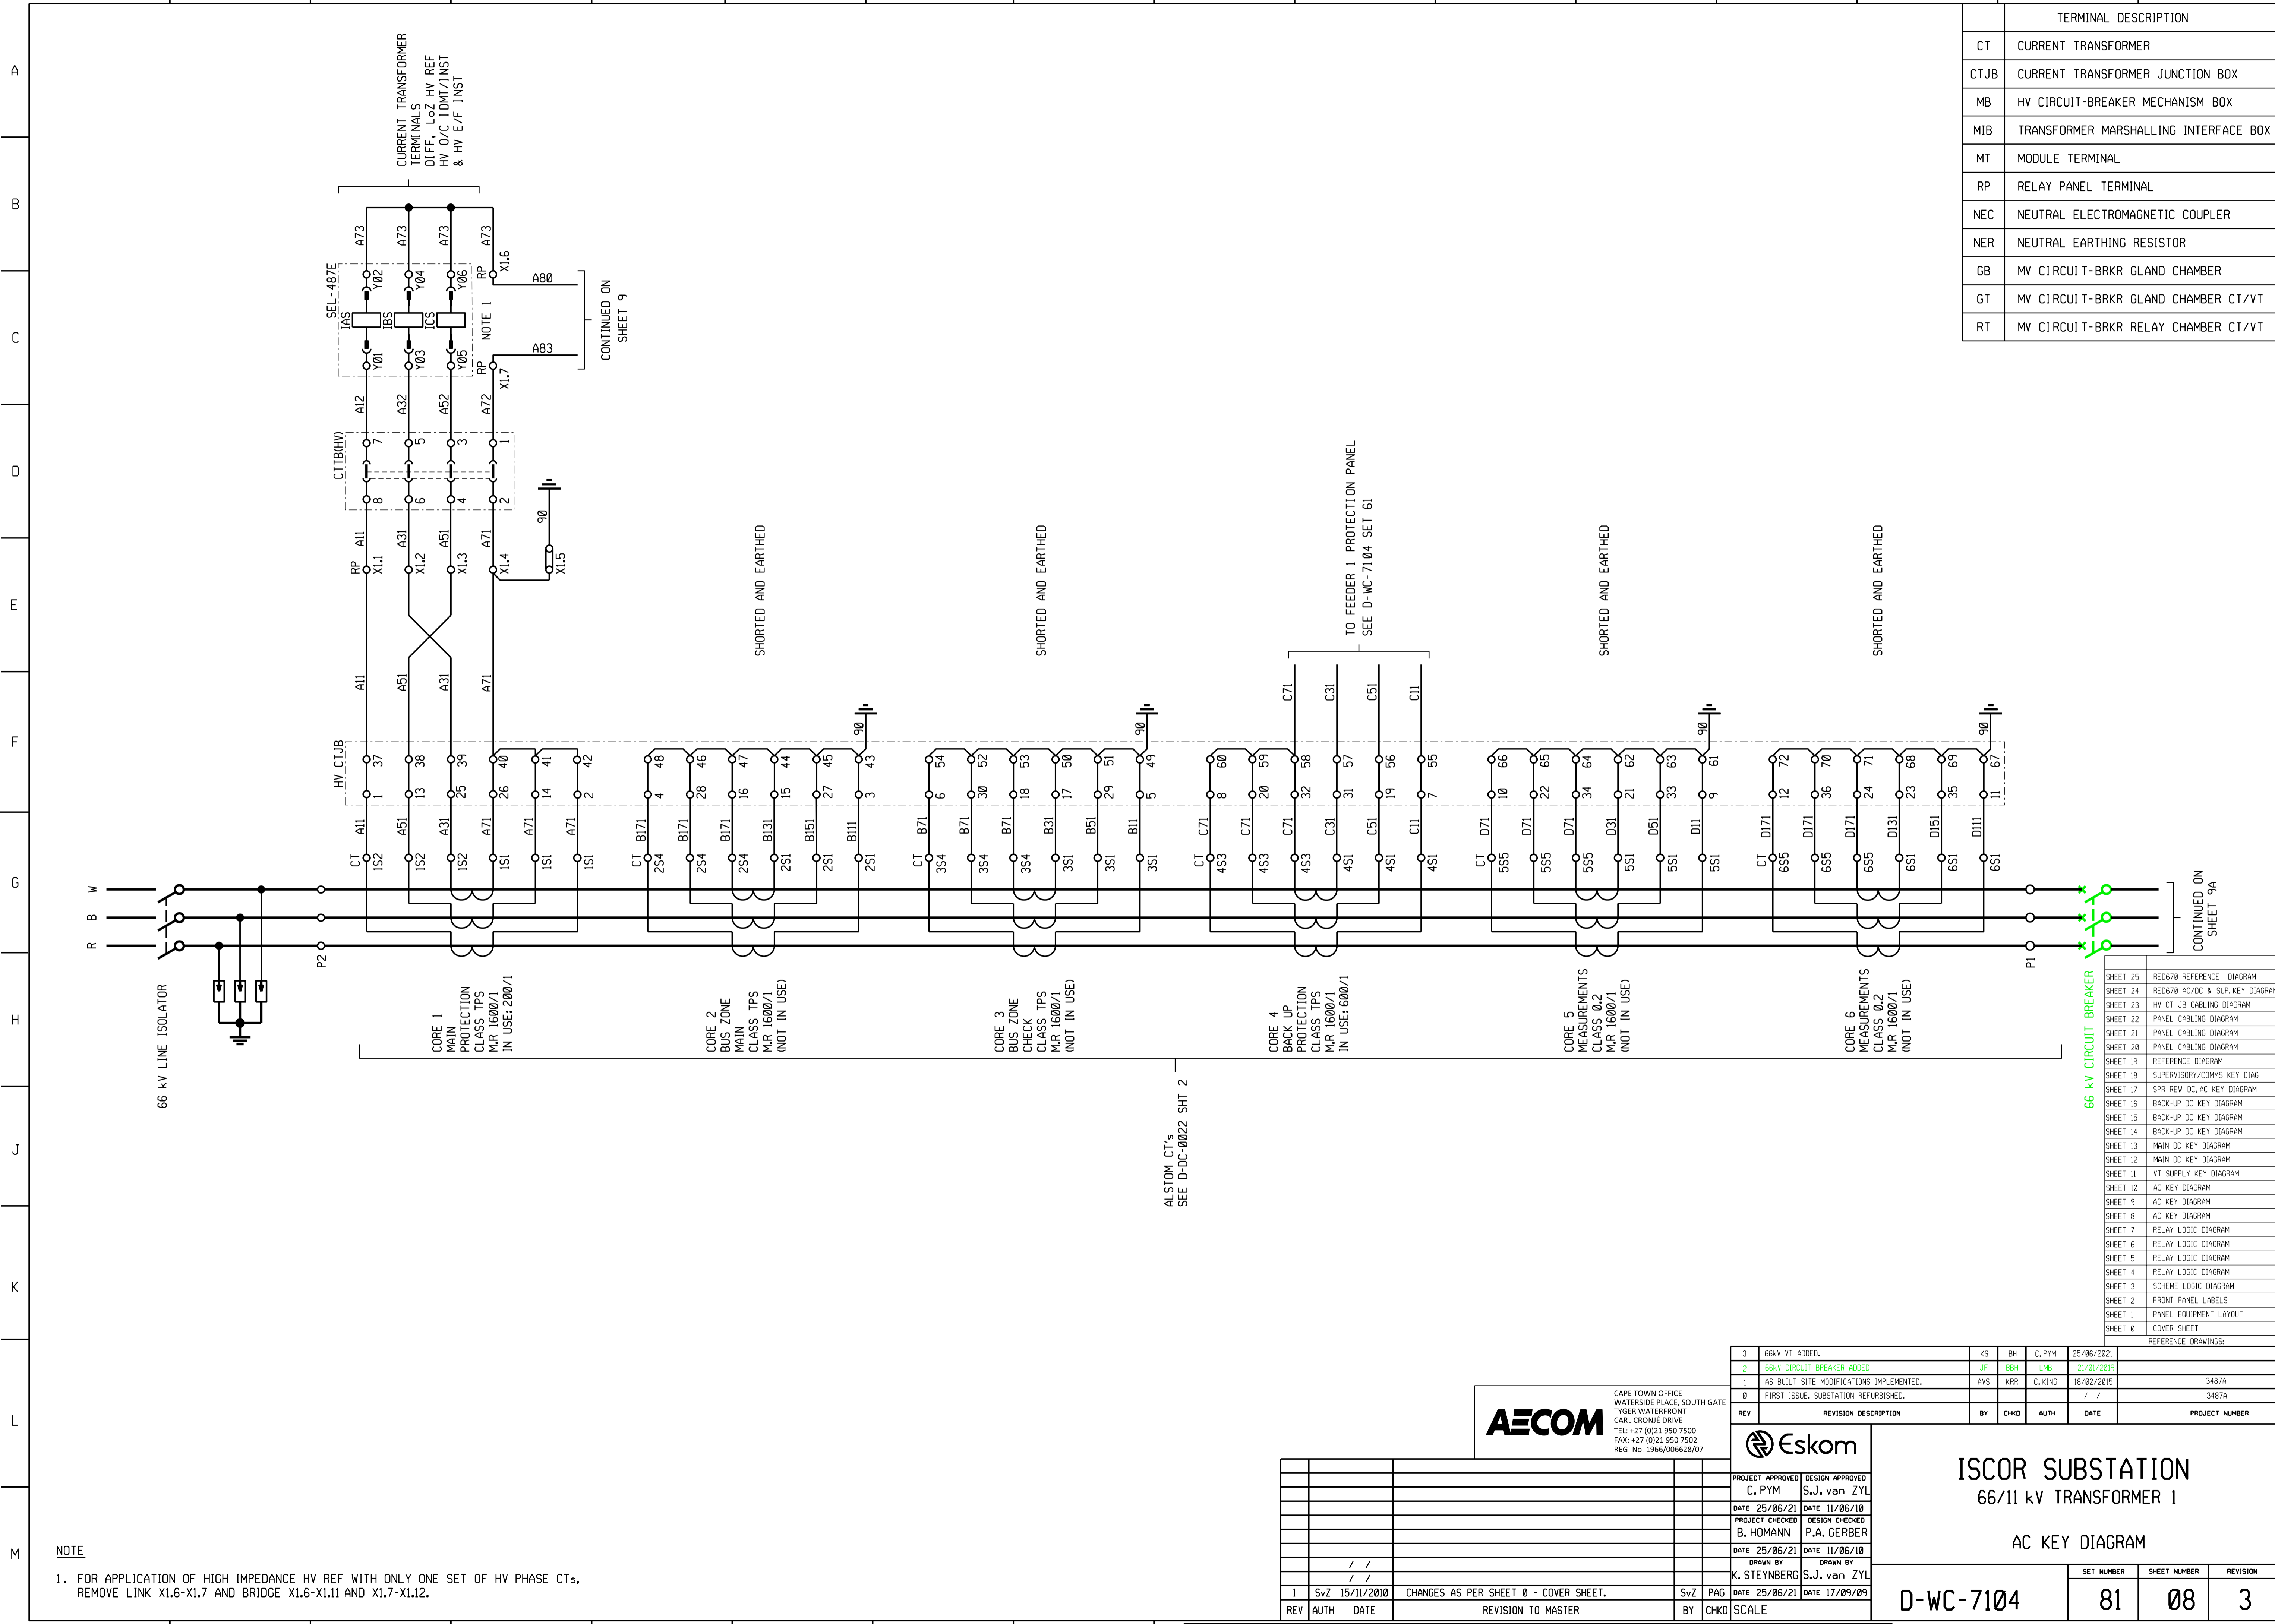

TERMINAL DESCRIPTION	
CT	CURRENT TRANSFORMER
CTJB	CURRENT TRANSFORMER JUNCTION BOX
MB	HV CIRCUIT-BREAKER MECHANISM BOX
MIB	TRANSFORMER MARSHALLING INTERFACE BOX
MT	MODULE TERMINAL
RP	RELAY PANEL TERMINAL
NEC	NEUTRAL ELECTROMAGNETIC COUPLER
NER	NEUTRAL EARTHING RESISTOR
GB	MV CIRCUIT-BRKR GLAND CHAMBER
GT	MV CIRCUIT-BRKR GLAND CHAMBER CT/VT
RT	MV CIRCUIT-BRKR RELAY CHAMBER CT/VT

REV	REVISION DESCRIPTION	BY	CHKD	AUTH	DATE	PROJECT NUMBER
3	66kV VT ADDED.	KS	BH	C.PYM	25/06/2021	
2	66kV CIRCUIT BREAKER ADDED	JF	BH	LMB	21/01/2019	
1	AS BUILT SITE MODIFICATIONS IMPLEMENTED.	AVS	KRR	C.KING	18/02/2015	3487A
0	FIRST ISSUE. SUBSTATION REFURBISHED.	/	/	/	/	3487A

SHEET	OF	REVISION
8	26	1

AECOM
 CAPE TOWN OFFICE
 WATERSIDE PLACE, SOUTH GATE
 TYGER WATERFRONT
 CARL CRONJE DRIVE
 TEL: +27 (0)21 950 7500
 FAX: +27 (0)21 950 7502
 REG. No. 1966/006628/07



ISCOR SUBSTATION
 66/11 kV TRANSFORMER 1

AC KEY DIAGRAM

D-WC-7104

SET NUMBER	SHEET NUMBER	REVISION
81	08	3

PANEL TYPE DESIGNATION 4TM710MOD.F.ZD

REV	AUTH	DATE	REVISION TO MASTER	SCALE
1	SvZ	15/11/2010	CHANGES AS PER SHEET 0 - COVER SHEET.	SvZ
	PAG	DATE 25/06/21		DATE 17/09/09
	BY	CHKD		

NOTE
 1. FOR APPLICATION OF HIGH IMPEDANCE HV REF WITH ONLY ONE SET OF HV PHASE CTs, REMOVE LINK X1.6-X1.7 AND BRIDGE X1.6-X1.11 AND X1.7-X1.12.


ALSTOM CT's
 SEE D-DC-0022 SHT 2

66 kV CIRCUIT BREAKER

MASTER TRACING FILED UNDER D-DT-15202 SHEET 8 OF 26 REVISION 1

A
B
C
D
E
F
G
H
J
K
L
M

A
B
C
D
E
F
G
H
J
K
L
M

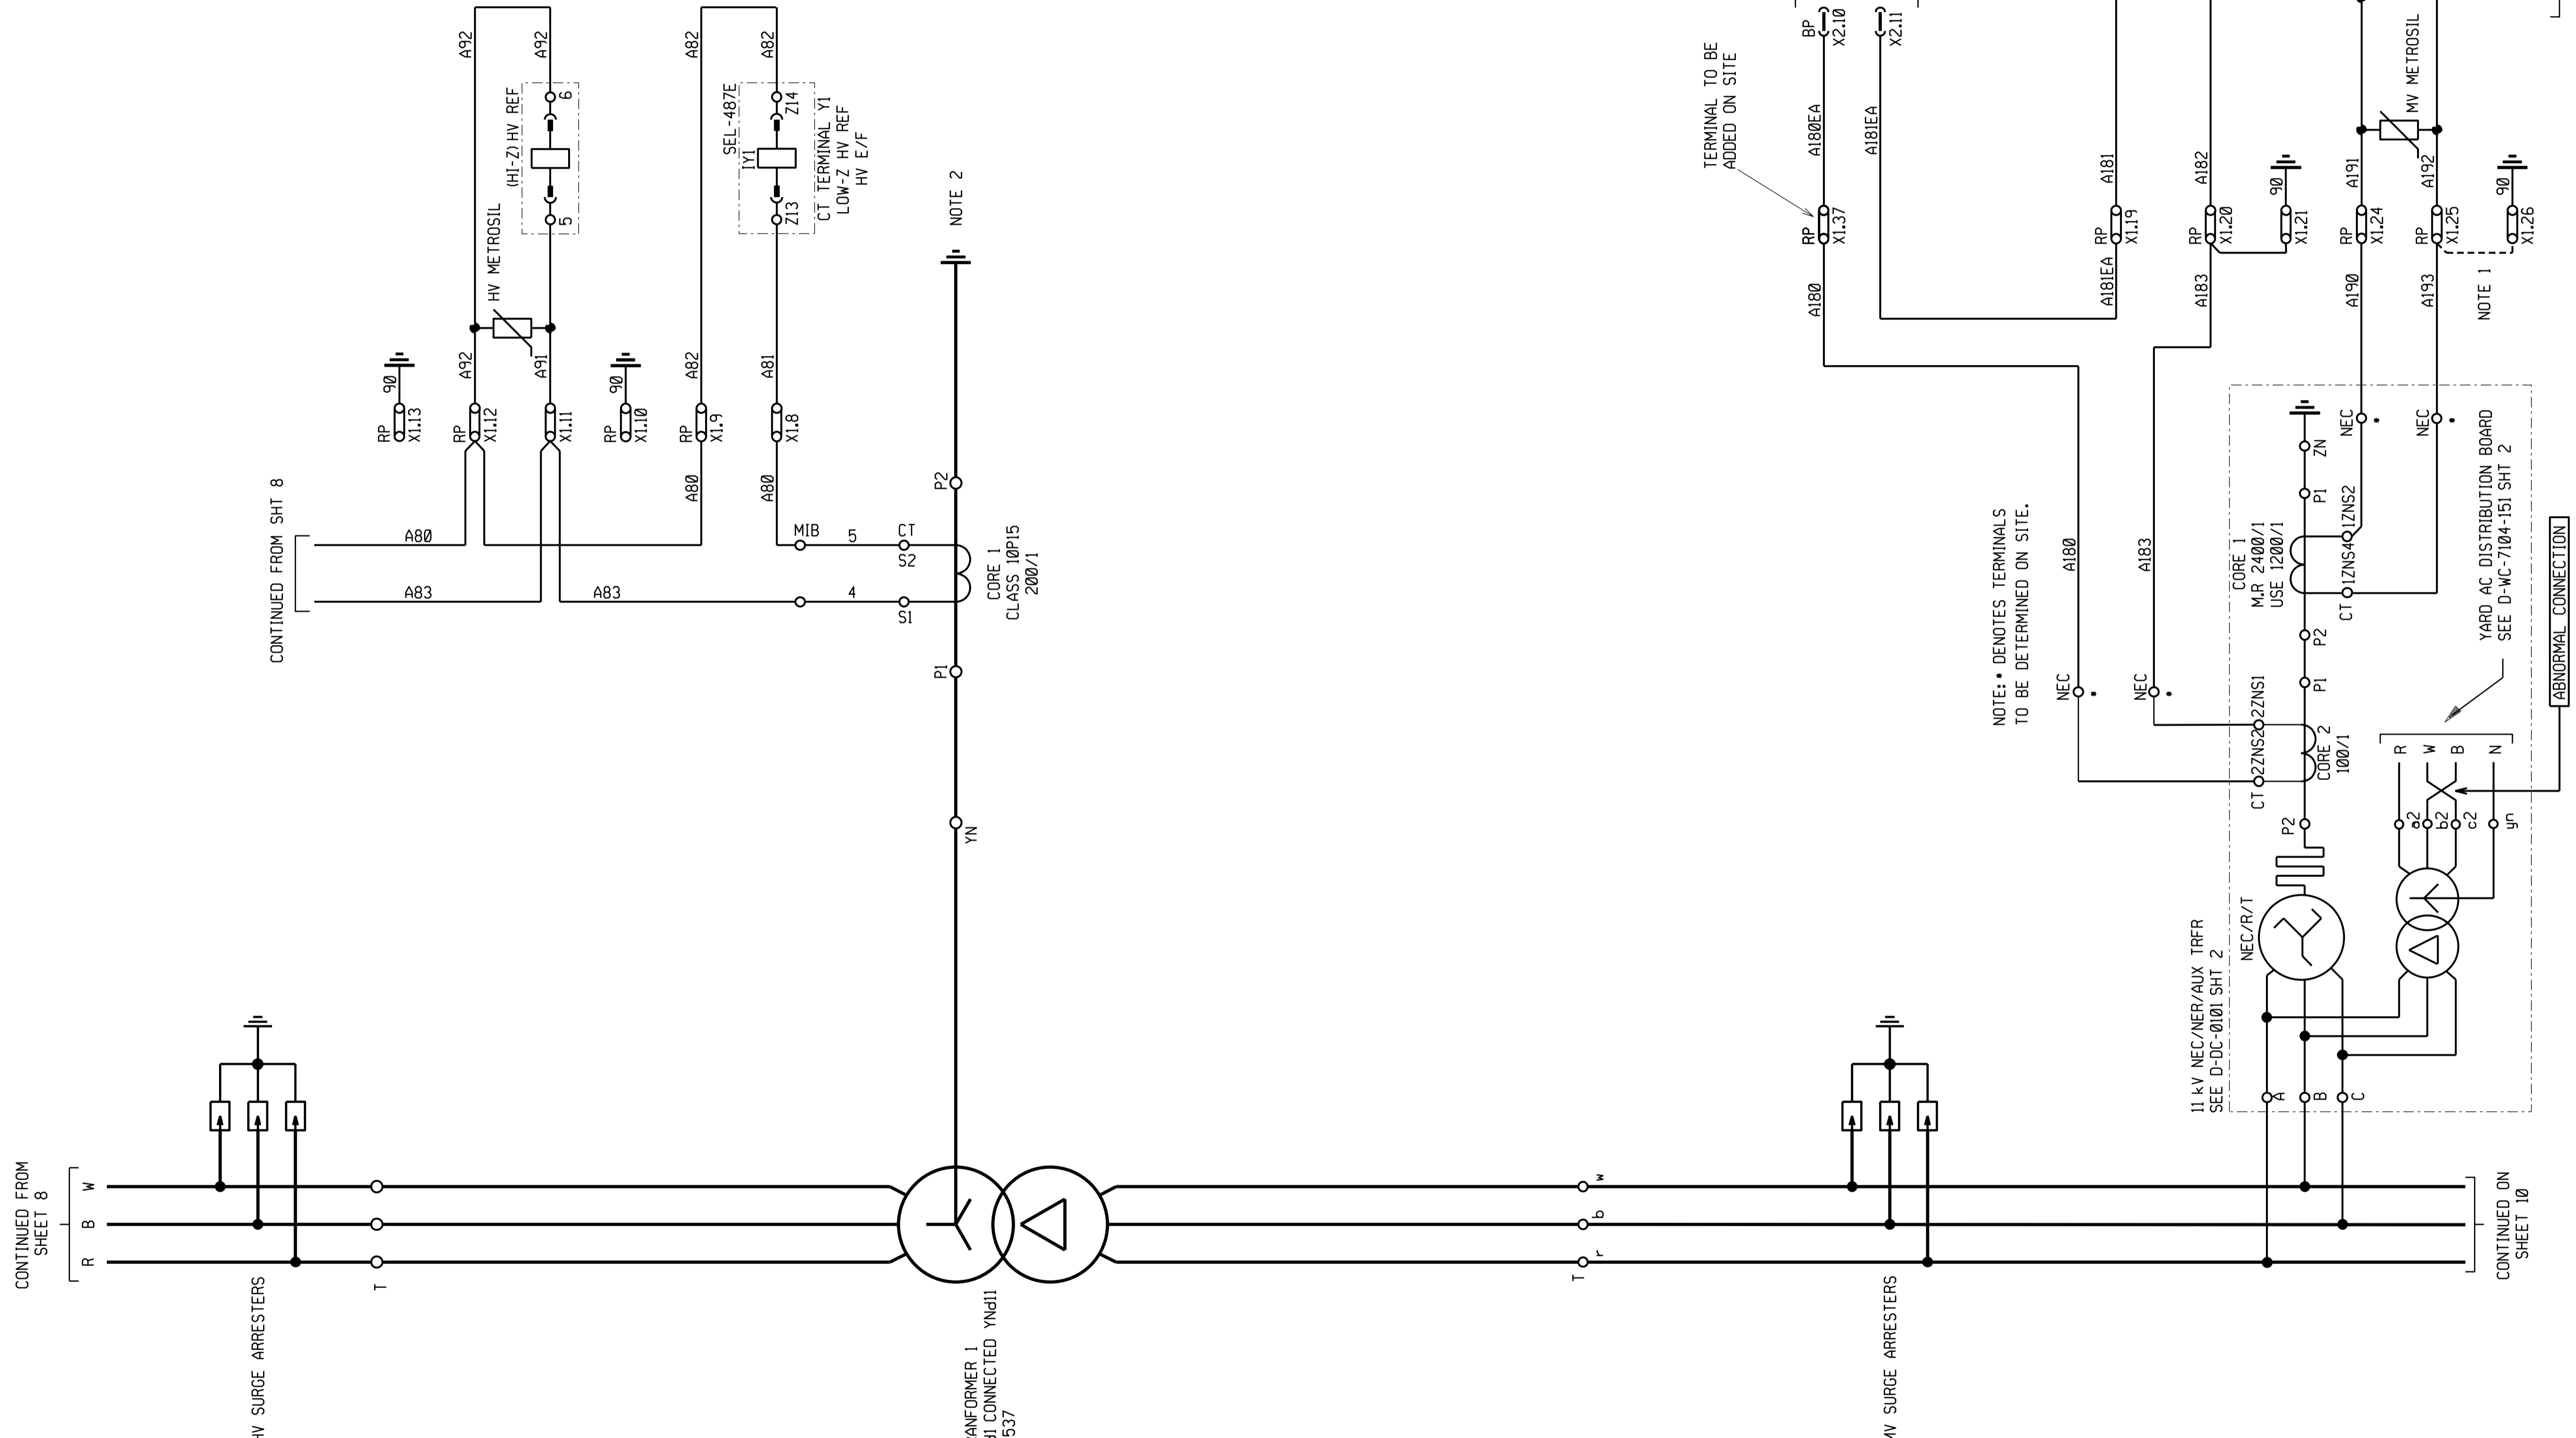

CONTINUED FROM SHT 8

CONTINUED ON SHEET 10

CONTINUED ON SHEET 10

ASEA
66/11 kV TRANSFORMER 1
20 MVA YNd1 CONNECTED YNd11
SEE 1.037/15537

CORE 1
CLASS 10P15
200/1

NOTE 2

NOTE: * DENOTES TERMINALS TO BE DETERMINED ON SITE.

TERMINAL TO BE ADDED ON SITE

11 kV BUS PROTECTION PANEL
SEE D-WC-7104-148 SHT 3

11 kV NEC/NER/AUX TRFR
SEE D-DC-0101 SHT 2

CORE 1
MR 2400/1
USE 1200/1

CORE 2
CT 02ZNS02ZNS1


YARD AC DISTRIBUTION BOARD
SEE D-WC-7104-151 SHT 2

ABNORMAL CONNECTION

NOTE

- ALL CT CIRCUITS ARE TO BE EARTHED AND EARTHED AT ONE POINT ONLY. REMOVE JUMPER X1.12-X1.13 AND/OR X1.25-X1.26 WHERE HV AND/OR MV HIGH IMPEDANCE REF USES LINE CTs (i.e. EARTHED VIA X1.5 AND X1.18).
- THE EARTHING OF TRANSFORMER NEUTRALS SHALL BE IN ACCORDANCE WITH DPL 34-214.9.



CAPE TOWN OFFICE
WATERSIDE PLACE, SOUTH GATE
TYGER WATERFRONT
CARL CRONJE DRIVE
TEL: +27 (0)21 950 7500
FAX: +27 (0)21 950 7502
REG. No. 1966/006628/07


REV	REVISION DESCRIPTION	BY	CHKD	AUTH	DATE	PROJECT NUMBER
1	AS BUILT SITE MODIFICATIONS IMPLEMENTED.	AVS	KRR	C.KING	18/02/2015	3487A
0	FIRST ISSUE. SUBSTATION REFURBISHED.	/	/	/	/	3487A

PROJECT APPROVED C. PYM	DESIGN APPROVED S.J. van ZYL
DATE 25/06/21	DATE 11/06/18
PROJECT CHECKED B. HOMANN	DESIGN CHECKED P.A. GERBER
DATE 25/06/21	DATE 11/06/18
DRAWN BY K. STEYNBERG	DRAWN BY S.J. van ZYL
PAGE 25/06/21	DATE 17/09/09
BY	SCALE

ISCOR SUBSTATION
66/11 kV TRANSFORMER 1
AC KEY DIAGRAM



D-WC-7104	81	09	1
SET NUMBER	SHEET NUMBER	REVISION	

SHEET	DESCRIPTION
SHEET 25	RED670 REFERENCE DIAGRAM
SHEET 24	RED670 AC/DC & SUP. KEY DIAGRAM
SHEET 23	HV CT JB CABLING DIAGRAM
SHEET 22	PANEL CABLING DIAGRAM
SHEET 21	PANEL CABLING DIAGRAM
SHEET 20	PANEL CABLING DIAGRAM
SHEET 19	REFERENCE DIAGRAM
SHEET 18	SUPERVISORY/COMMS KEY DIAG
SHEET 17	SPP REW. DC. AC KEY DIAGRAM
SHEET 16	BACK-UP DC KEY DIAGRAM
SHEET 15	BACK-UP DC KEY DIAGRAM
SHEET 14	BACK-UP DC KEY DIAGRAM
SHEET 13	MAIN DC KEY DIAGRAM
SHEET 12	MAIN DC KEY DIAGRAM
SHEET 11	VT SUPPLY KEY DIAGRAM
SHEET 10	AC KEY DIAGRAM
SHEET 9	AC KEY DIAGRAM
SHEET 8	AC KEY DIAGRAM
SHEET 7	RELAY LOGIC DIAGRAM
SHEET 6	RELAY LOGIC DIAGRAM
SHEET 5	RELAY LOGIC DIAGRAM
SHEET 4	RELAY LOGIC DIAGRAM
SHEET 3	SCHEME LOGIC DIAGRAM
SHEET 2	FRONT PANEL LABELS
SHEET 1	PANEL EQUIPMENT LAYOUT
SHEET 0	COVER SHEET

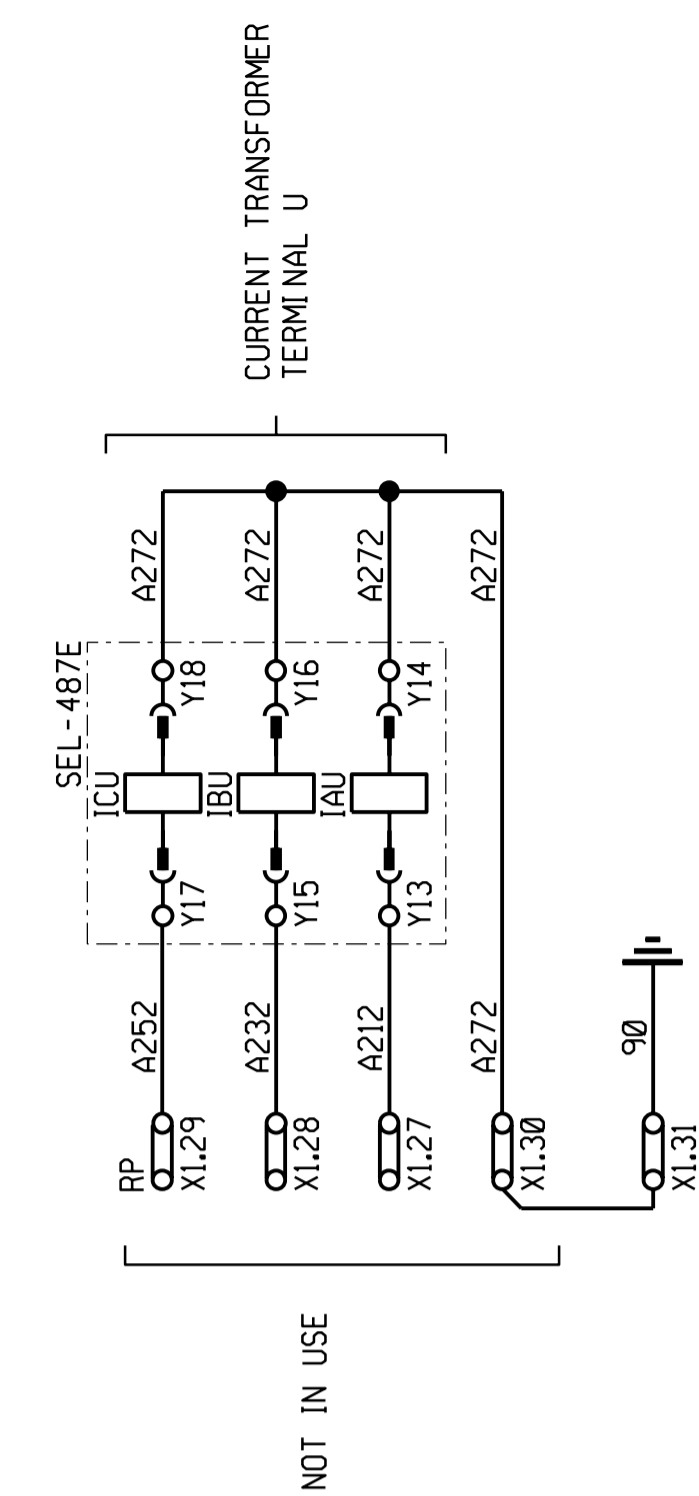

NOT IN USE


CURRENT TRANSFORMER TERMINAL U

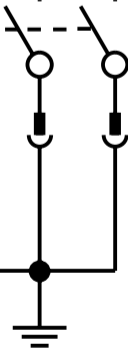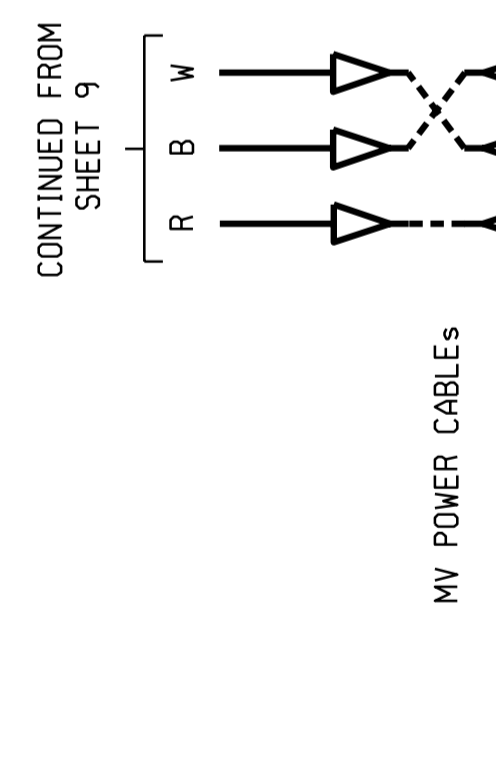

DISCONNECT ON SITE

CORE 3 MEASUREMENTS CLASS 0.2 M.R. 12000/1 USE 12000/1

TO MEASUREMENTS PANEL 1 66/11 kV TRANSFORMER 1 METER MODULE SEE D-WC-7104-29 SHT 2

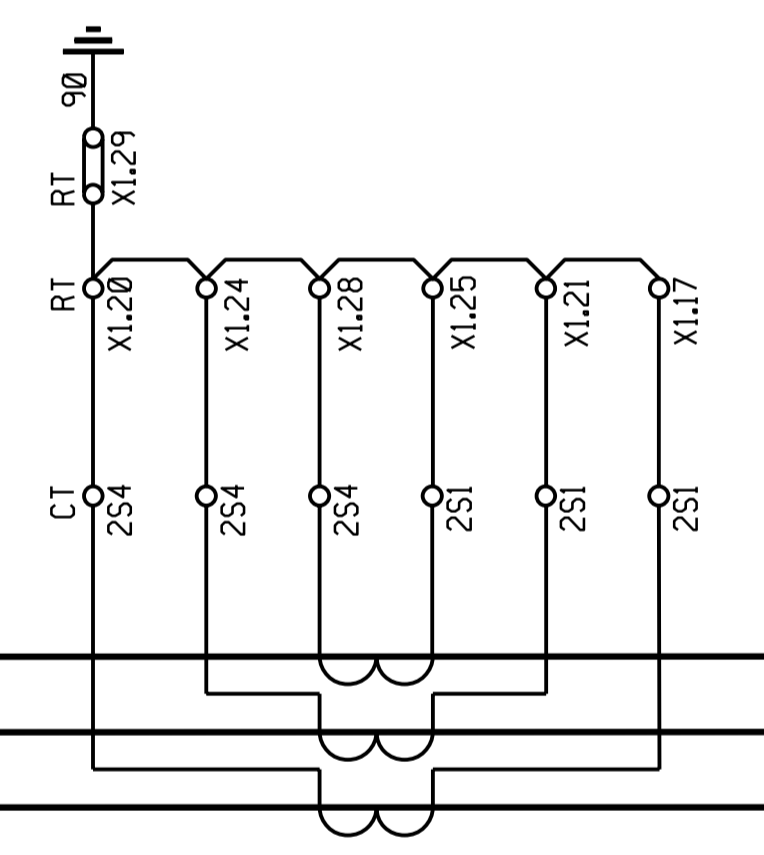


CORE 2 MEASUREMENTS CLASS 0.2 M.R. 12000/1 USE 12000/1

CONTINUED FROM SHEET 9



DISCONNECT ON SITE

CORE 1 PROTECTION CLASS TPS/PX M.R. 12000/1 USE 12000/1

WIRING TO BE MODIFIED ON SITE.

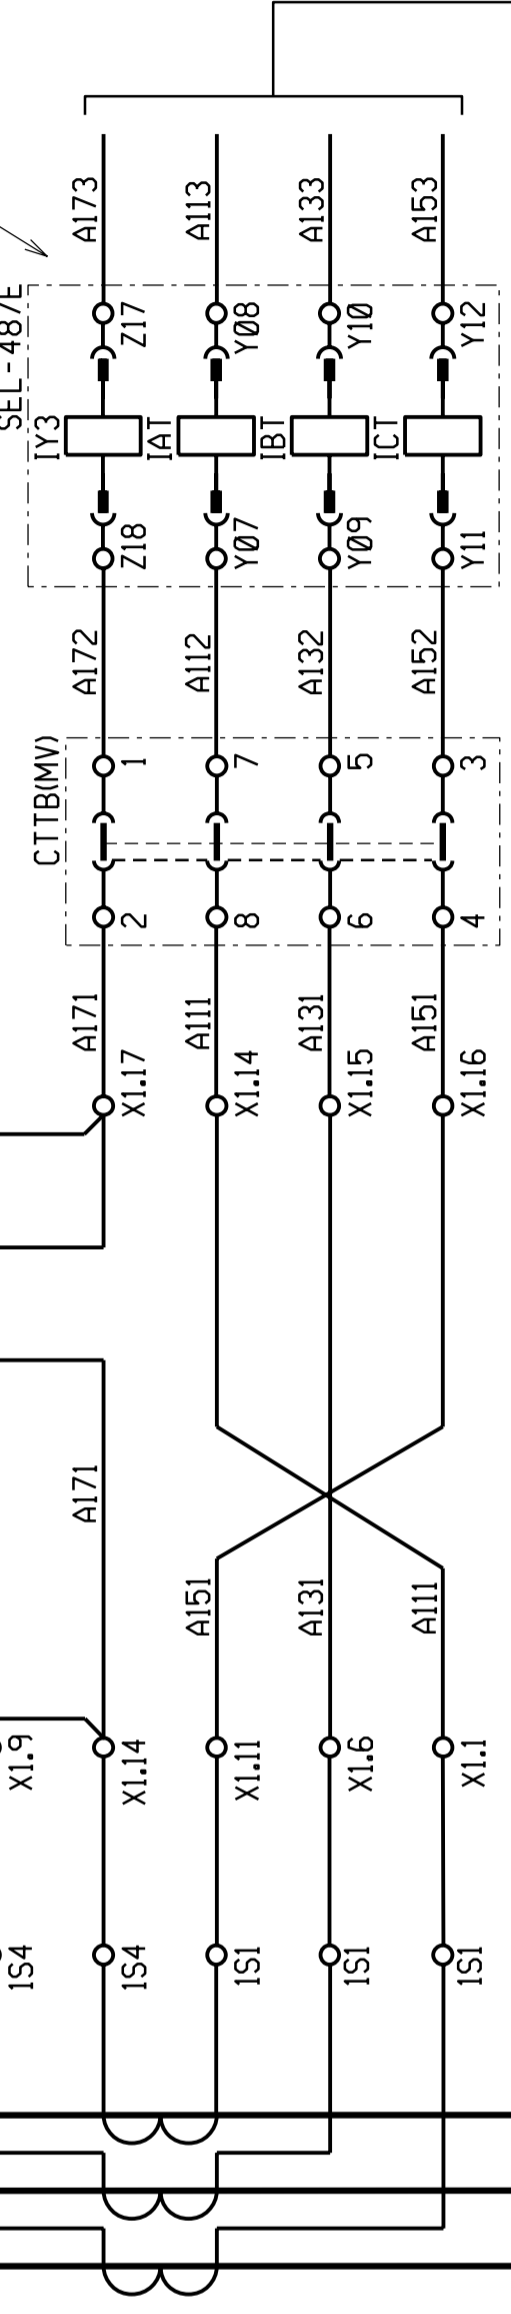

• DENOTES CT RATIO & TERMINAL NUMBERS TO BE DETERMINED ON SITE. SEE TABLE FOR APPLICABLE BREAKER MANUFACTURER.

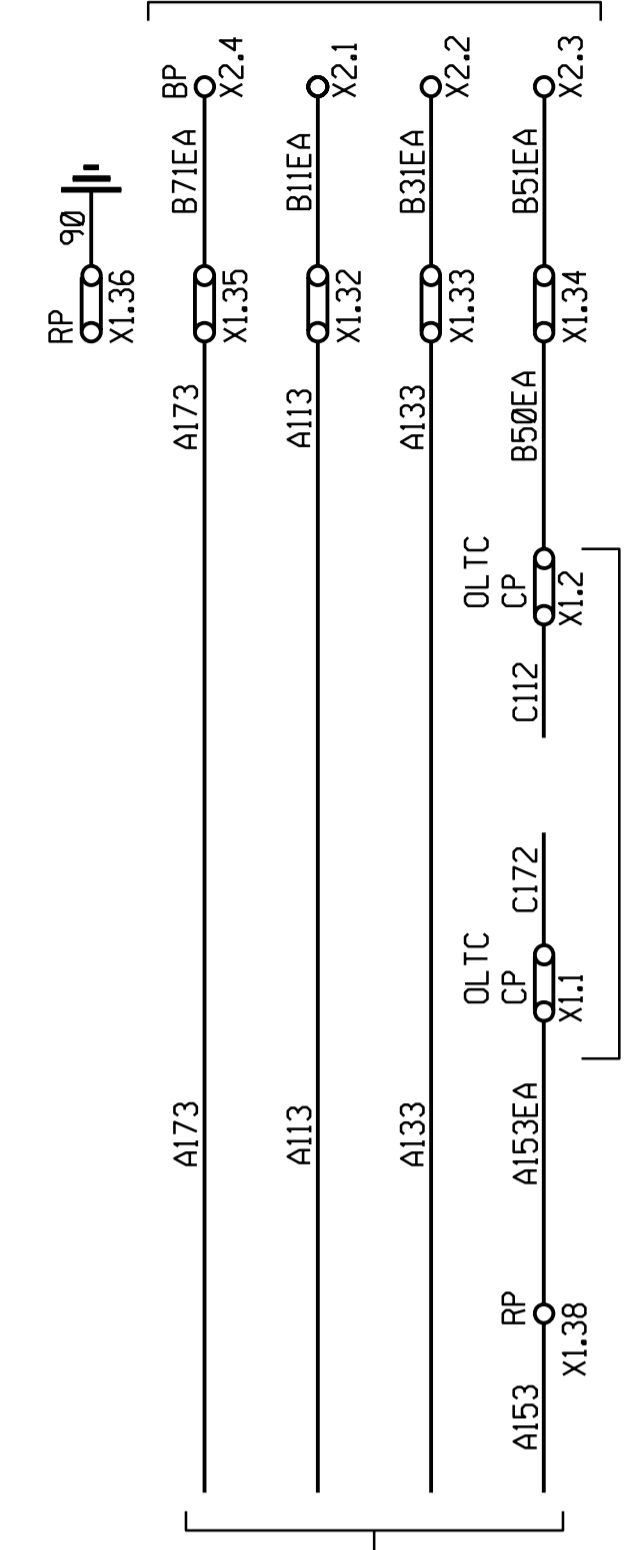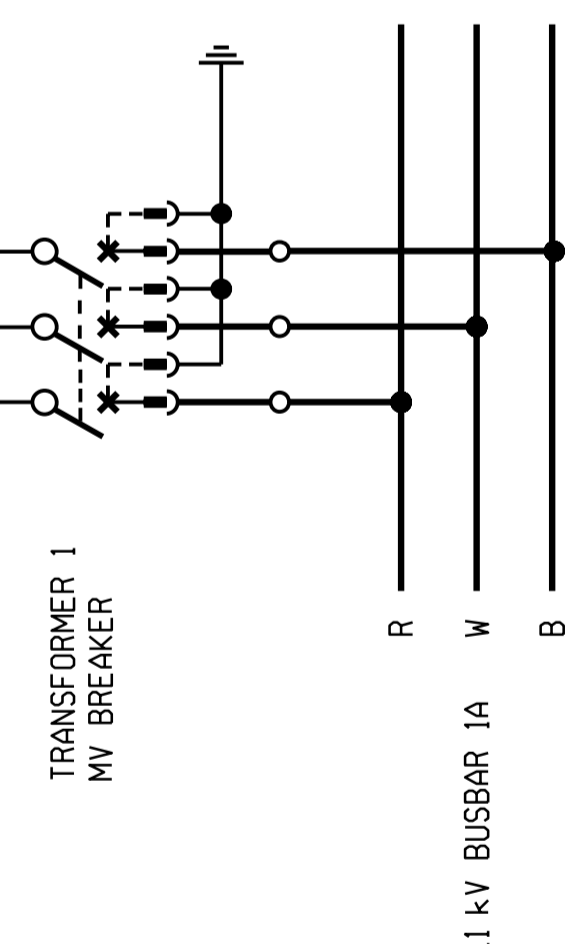

BUS PROTECTION PANEL SEE D-WC-7104-148 SHT 3

OLTC PANEL 66/11 kV TRANSFORMER 1 OLTC RACK SEE D-WC-7104-82 SHEET 4

ACTOM BREAKER - METERING CT RATIO SELECTION (CORE 3)						
RATIO	R I	W I	B I	N	BRIDGES	
200/1A (S1-S2)	RT X1.30	RT X1.34	RT X1.38	RT X1.39	RT X1.31, X1.35 & X1.39	
400/1A (S3-S4)	RT X1.32	RT X1.36	RT X1.40	RT X1.41	RT X1.33, X1.37 & X1.41	
600/1A (S2-S3)	RT X1.31	RT X1.35	RT X1.39	RT X1.40	RT X1.32, X1.36 & X1.40	
800/1A (S1-S3)	RT X1.30	RT X1.34	RT X1.38	RT X1.40	RT X1.32, X1.36 & X1.40	
1000/1A (S2-S4)	RT X1.31	RT X1.35	RT X1.39	RT X1.41	RT X1.33, X1.37 & X1.41	
1200/1A (S1-S4)	RT X1.30	RT X1.34	RT X1.38	RT X1.41	RT X1.33, X1.37 & X1.41	

ACTOM BREAKER - METERING CT RATIO SELECTION (CORE 2)						
RATIO	R I	W I	B I	N	BRIDGES	
200/1A (S1-S2)	RT X1.17	RT X1.21	RT X1.25	RT X1.26	RT X1.18, X1.22 & X1.26	
400/1A (S3-S4)	RT X1.19	RT X1.23	RT X1.27	RT X1.28	RT X1.20, X1.24 & X1.28	
600/1A (S2-S3)	RT X1.18	RT X1.22	RT X1.26	RT X1.27	RT X1.19, X1.23 & X1.27	
800/1A (S1-S3)	RT X1.17	RT X1.21	RT X1.25	RT X1.27	RT X1.19, X1.23 & X1.27	
1000/1A (S2-S4)	RT X1.18	RT X1.22	RT X1.26	RT X1.28	RT X1.20, X1.24 & X1.28	
1200/1A (S1-S4)	RT X1.17	RT X1.21	RT X1.25	RT X1.28	RT X1.20, X1.24 & X1.28	

ACTOM BREAKER - PROTECTION CT RATIO SELECTION (CORE 1)						
RATIO	R I	W I	B I	N	BRIDGES	
200/1A (S1-S2)	RT X1.1	RT X1.6	RT X1.11	RT X1.12	RT X1.2, X1.7 & X1.12	
400/1A (S3-S4)	RT X1.3	RT X1.8	RT X1.13	RT X1.14	RT X1.4, X1.9 & X1.14	
600/1A (S2-S3)	RT X1.2	RT X1.7	RT X1.12	RT X1.13	RT X1.3, X1.8 & X1.13	
800/1A (S1-S3)	RT X1.1	RT X1.6	RT X1.11	RT X1.13	RT X1.3, X1.8 & X1.13	
1000/1A (S2-S4)	RT X1.2	RT X1.7	RT X1.12	RT X1.13	RT X1.4, X1.9 & X1.14	
1200/1A (S1-S4)	RT X1.1	RT X1.6	RT X1.11	RT X1.14	RT X1.4, X1.9 & X1.14	

1	AS BUILT SITE MODIFICATIONS IMPLEMENTED.	AVS	KRR	C.KING	18/02/2015	3487A
0	FIRST ISSUE. SUBSTATION REFURBISHED.				/ /	3487A
REV	REVISION DESCRIPTION	BY	CHKD	AUTH	DATE	PROJECT NUMBER
PROJECT APPROVED C. PYM		DESIGN APPROVED S.J. van ZYL				
DATE 25/06/21		DATE 11/06/10				
PROJECT CHECKED B. HOMANN		DESIGN CHECKED P.A. GERBER				
DATE 25/06/21		DATE 11/06/10				
DRAWN BY K. STEYNBERG		DRAWN BY S.J. van ZYL				
1	SvZ	15/11/2010	CHANGES AS PER SHEET 0 - COVER SHEET.			SvZ
REV	AUTH	DATE	REVISION TO MASTER			BY
						SCALE

ISCOR SUBSTATION

66/11 kV TRANSFORMER 1

AC KEY DIAGRAM


SET NUMBER	SHEET NUMBER	REVISION
D-WC-7104	81	10
		1

SHEET 25	RED670 REFERENCE DIAGRAM
SHEET 24	RED670 AC/DC & SUP. KEY DIAGRAM
SHEET 23	HV CT JB CABLING DIAGRAM
SHEET 22	PANEL CABLING DIAGRAM
SHEET 21	PANEL CABLING DIAGRAM
SHEET 20	PANEL CABLING DIAGRAM
SHEET 19	REFERENCE DIAGRAM
SHEET 18	SUPERVISORY/COMMS KEY DIAG
SHEET 17	SPP REW. DC AC KEY DIAGRAM
SHEET 16	BACK-UP DC KEY DIAGRAM
SHEET 15	BACK-UP DC KEY DIAGRAM
SHEET 14	BACK-UP DC KEY DIAGRAM
SHEET 13	MAIN DC KEY DIAGRAM
SHEET 12	MAIN DC KEY DIAGRAM
SHEET 11	VT SUPPLY KEY DIAGRAM
SHEET 10	AC KEY DIAGRAM
SHEET 9	AC KEY DIAGRAM
SHEET 8	AC KEY DIAGRAM
SHEET 7	RELAY LOGIC DIAGRAM
SHEET 6	RELAY LOGIC DIAGRAM
SHEET 5	RELAY LOGIC DIAGRAM
SHEET 4	RELAY LOGIC DIAGRAM
SHEET 3	SCHEME LOGIC DIAGRAM
SHEET 2	FRONT PANEL LABELS
SHEET 1	PANEL EQUIPMENT LAYOUT
SHEET 0	COVER SHEET

CAPE TOWN OFFICE
WATERSIDE PLACE, SOUTH GATE
TYGER WATERFRONT
CARL CRONJE DRIVE
TEL: +27 (0)21 950 7500
FAX: +27 (0)21 950 7502
REG. No. 1966/006628/07

CONTINUED FROM SHEET 12

CONTINUED FROM SHEET 12

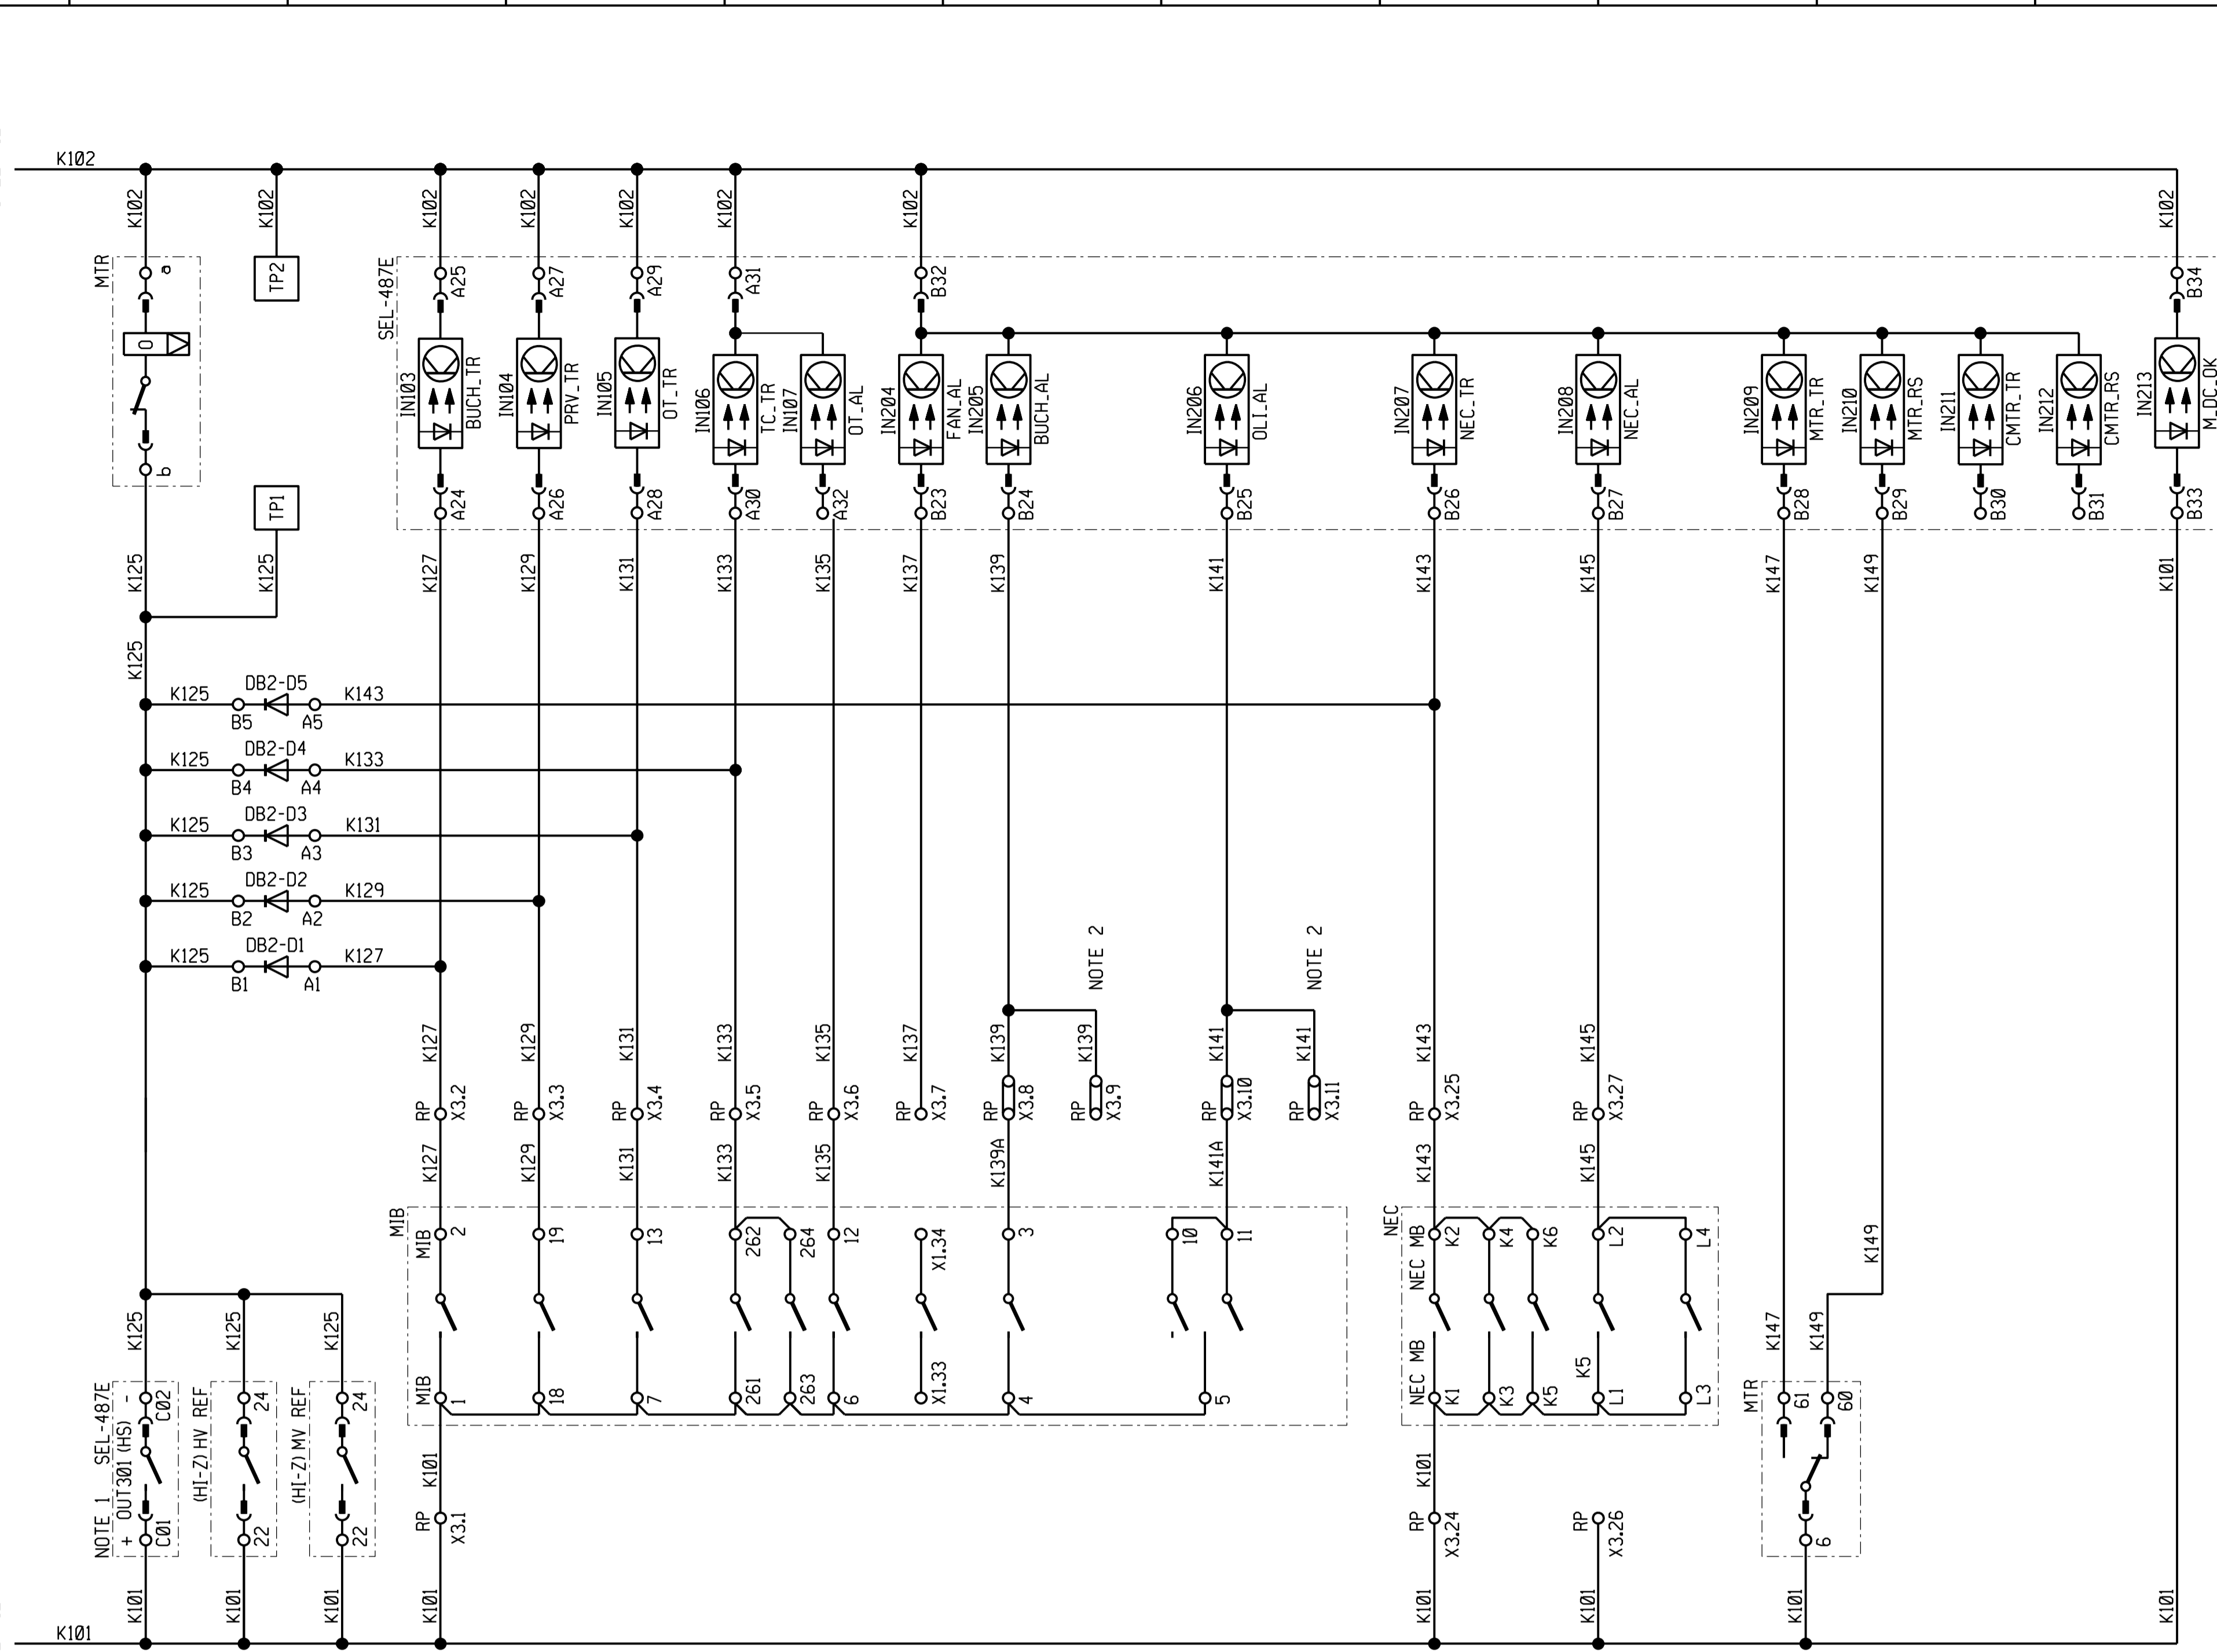

- DIFFERENTIAL, SUSTAINED FAULT TIMER, HV O/C (HI-SET) TRIP & IDMT
- HIGH IMPEDANCE HV REF TRIP
- HIGH IMPEDANCE MV REF TRIP
- TRANSFORMER BUCHHOLZ TRIP
- TRANSFORMER PRESSURE RELEASE TRIP
- TRANSFORMER OIL TEMPERATURE TRIP
- TAP CHANGER (BUCHHOLZ) TRIP/TEMP
- TRANSFORMER OIL TEMPERATURE ALARM
- (NOT IN USE) TRANSFORMER COOLER ABNORMAL ALARM
- TRANSFORMER BUCHHOLZ ALARM
- (NOT IN USE) TAP CHANGER BUCHHOLZ ALARM
- TRANSFORMER OIL LEVEL HIGH/LOW ALARM
- NOT IN USE TAP CHANGER OIL LEVEL HIGH/LOW ALARM
- NEC BUCHHOLZ TRIP
- NEC OIL TEMPERATURE TRIP
- NEC PRESSURE TRIP
- NEC BUCHHOLZ ALARM OR/AND LOW OIL LEVEL
- NEC OIL TEMPERATURE ALARM
- MASTER TRIP OPERATED, BREAKER FAIL INITIATE
- MASTER TRIP RELAY IN RESET STATE
- (NOT IN USE) CUSTOMER MASTER OPERATED, (ORDERING OPTION)
- (NOT IN USE) CUSTOMER MASTER TRIP RELAY IN RESET STATE (ORDERING OPTION)
- MAIN DC SUPPLY MONITORING

NOTE: * DENOTES TERMINAL NUMBER TO BE DETERMINED ON SITE.

NOTES

- SEL-487E OUTPUT CONTACTS DESIGNATED 'HS' ARE HIGH SPEED, HIGH CURRENT TYPES, WITH OPERATING TIMES LESS THAN 10ms, AND BREAKING CAPACITY 10Ade, L/R = 20ms.
- MANY ALSTOM/ACTOM POWER TRANSFORMERS FEATURE A TAP CHANGER BUCHHOLZ ALARM WIRED IN PARALLEL WITH THE TAP CHANGER OIL LEVEL ALARM (MIB X1.25-X1.30). THESE ALARMS MUST BE SEPARATED WITH THE TAP CHANGER BUCHHOLZ WIRED IN PARALLEL WITH THE MAIN TANK BUCHHOLZ ALARM, OR TO RP TERMINAL X3.9.

SHEET 25	RED670 REFERENCE DIAGRAM
SHEET 24	RED670 AC/DC & SUP. KEY DIAGRAM
SHEET 23	HV CT JB CABLING DIAGRAM
SHEET 22	PANEL CABLING DIAGRAM
SHEET 21	PANEL CABLING DIAGRAM
SHEET 20	PANEL CABLING DIAGRAM
SHEET 19	REFERENCE DIAGRAM
SHEET 18	SUPERVISORY/COMMS KEY DIAG
SHEET 17	SPP REV. DC AC KEY DIAGRAM
SHEET 16	BACK-UP DC KEY DIAGRAM
SHEET 15	BACK-UP DC KEY DIAGRAM
SHEET 14	BACK-UP DC KEY DIAGRAM
SHEET 13	MAIN DC KEY DIAGRAM
SHEET 12	MAIN DC KEY DIAGRAM
SHEET 11	VT SUPPLY KEY DIAGRAM
SHEET 10	AC KEY DIAGRAM
SHEET 9	AC KEY DIAGRAM
SHEET 8	AC KEY DIAGRAM
SHEET 7	RELAY LOGIC DIAGRAM
SHEET 6	RELAY LOGIC DIAGRAM
SHEET 5	RELAY LOGIC DIAGRAM
SHEET 4	RELAY LOGIC DIAGRAM
SHEET 3	SCHEME LOGIC DIAGRAM
SHEET 2	FRONT PANEL LABELS
SHEET 1	PANEL EQUIPMENT LAYOUT
SHEET 0	COVER SHEET

AECOM
 CAPE TOWN OFFICE
 WATERSIDE PLACE, SOUTH GATE
 TYGER WATERFRONT
 CARL CRONJE DRIVE
 TEL: +27 (0)21 950 7500
 FAX: +27 (0)21 950 7502
 REG. No. 1966/006628/07

1	AS BUILT SITE MODIFICATIONS IMPLEMENTED.	AVS	KRR	C. KING	18/02/2015	3487A
0	FIRST ISSUE. SUBSTATION REFURBISHED.				/ /	3487A
REV	REVISION DESCRIPTION	BY	CHKD	AUTH	DATE	PROJECT NUMBER

Eskom

ISCOR SUBSTATION
 66/11 kV TRANSFORMER 1

MAIN DC KEY DIAGRAM


PROJECT APPROVED	DESIGN APPROVED
C. PYM	S.J. van ZYL
DATE 25/06/21	DATE 11/06/10
PROJECT CHECKED	DESIGN CHECKED
B. HOMANN	P.A. GERBER
DATE 25/06/21	DATE 11/06/10
DRAWN BY	DRAWN BY
K. STEYNBERG	S.J. van ZYL
DATE 15/11/2010	DATE 25/06/21
DATE 17/09/09	

REV	1	2	3	4	5	6	7	8	9	10	11	12	13	14	15	16	17	18	19	20	21	22	23	24	25	26	27	28	29	30
LEVELS	1	3																												

SET NUMBER	81
SHEET NUMBER	13
REVISION	1

D-WC-7104

PANEL TYPE DESIGNATION 4TM7100MOD.F.ZD SIZE 0000TE AIL

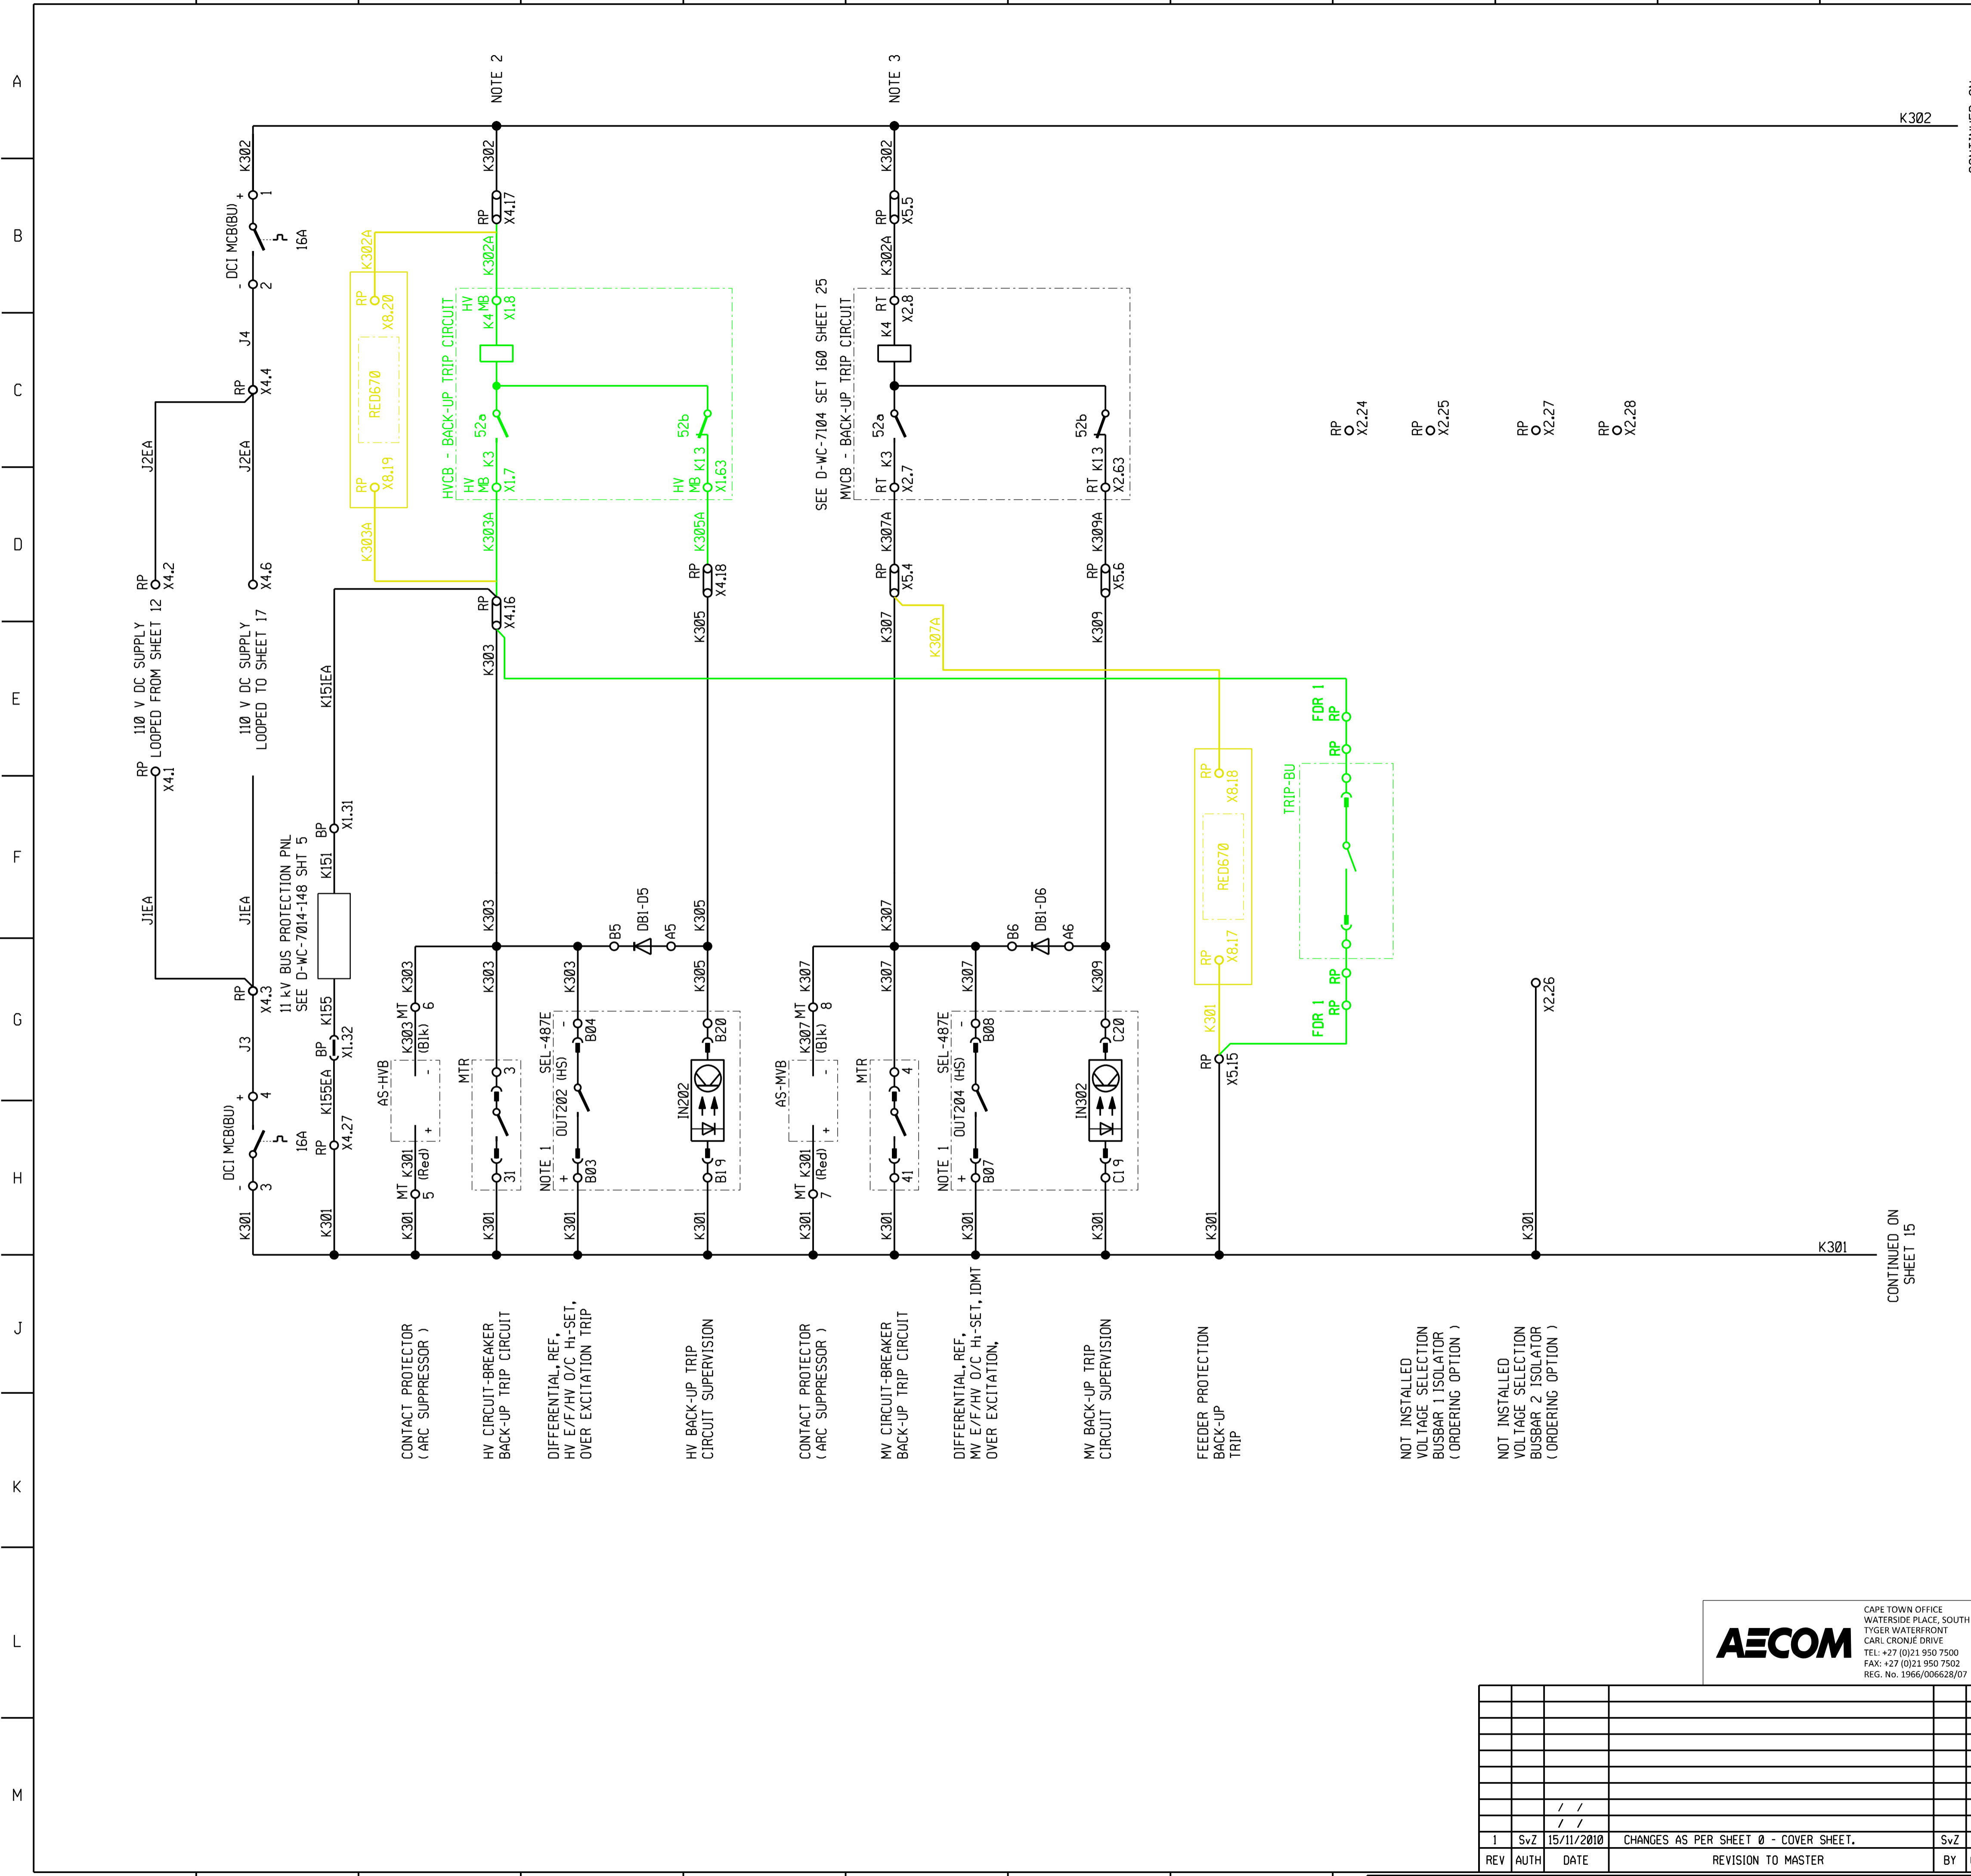

CONTINUED ON SHEET 15

CONTINUED ON SHEET 15

NOTES

- SEL-487E OUTPUT CONTACTS DESIGNATED 'HS' ARE HIGH SPEED, HIGH CURRENT TYPES, WITH OPERATING TIMES LESS THAN 10ms, AND BREAKING CAPACITY 10kA, L/R = 20ms.
- THE K13 (X1.63) TERMINAL MAY NOT BE AVAILABLE ON OLDER GENERATION CIRCUIT-BREAKERS. WIRE A CIRCUIT-BREAKER AUXILIARY (52b) CONTACT ACROSS X4.17-X4.18 IN THIS CASE.
- THE K13 (X1.63) TERMINAL MAY NOT BE AVAILABLE ON OLDER GENERATION CIRCUIT-BREAKERS. WIRE A CIRCUIT-BREAKER AUXILIARY (52b) CONTACT ACROSS X5.5-X5.6 IN THIS CASE.
- IN THE EVENT THAT ONLY ONE TRIP CIRCUIT IS PROVIDED IN THE CIRCUIT-BREAKER DESIGN, THIS CIRCUIT SHALL BE WIRED INTO THE MAIN TRIPPING CIRCUIT OF THE SCHEME (SEE SHEET 12). IN THIS CASE, BRIDGE TERMINALS X4.17-X4.18 (HV) AND/OR X5.5-X5.6 (MV) OF THE CORRESPONDING BACK-UP TRIP CIRCUIT SO AS TO OVERRIDE THE TRIP CIRCUIT SUPERVISION FEATURE.
- DISCONNECT RED670 BY REMOVING JUMPERS BETWEEN TERMINALS X4.16 AND X8.19; AND X4.17 AND X8.20; WIRE CIRCUIT BREAKER TRIP CIRCUIT IN ITS PLACE; MASK OUT 106 TO SUSTAINED FAULT AND CONNECT TO X8.19.

SHEET	DESCRIPTION
SHEET 25	RED670 REFERENCE DIAGRAM
SHEET 24	RED670 AC/DC & SUP. KEY DIAGRAM
SHEET 23	HV CT JB CABLING DIAGRAM
SHEET 22	PANEL CABLING DIAGRAM
SHEET 21	PANEL CABLING DIAGRAM
SHEET 20	PANEL CABLING DIAGRAM
SHEET 19	REFERENCE DIAGRAM
SHEET 18	SUPERVISORY/COMMS KEY DIAG
SHEET 17	SPR REV DC, AC KEY DIAGRAM
SHEET 16	BACK-UP DC KEY DIAGRAM
SHEET 15	BACK-UP DC KEY DIAGRAM
SHEET 14	BACK-UP DC KEY DIAGRAM
SHEET 13	MAIN DC KEY DIAGRAM
SHEET 12	MAIN DC KEY DIAGRAM
SHEET 11	VT SUPPLY KEY DIAGRAM
SHEET 10	AC KEY DIAGRAM
SHEET 9	AC KEY DIAGRAM
SHEET 8	AC KEY DIAGRAM
SHEET 7	RELAY LOGIC DIAGRAM
SHEET 6	RELAY LOGIC DIAGRAM
SHEET 5	RELAY LOGIC DIAGRAM
SHEET 4	RELAY LOGIC DIAGRAM
SHEET 3	SCHEME LOGIC DIAGRAM
SHEET 2	FRONT PANEL LABELS
SHEET 1	PANEL EQUIPMENT LAYOUT
SHEET 0	COVER SHEET

REV	REVISION DESCRIPTION	BY	CHKD	AUTH	DATE	PROJECT NUMBER
3	66kV VT ADDED.	KS	BH	C. PYM	25/06/2021	
2	66kV CIRCUIT BREAKER ADDED	JF	BSH	LMB	21/01/2019	
1	AS BUILT SITE MODIFICATIONS IMPLEMENTED.	AVS	KRR	C. KING	18/02/2015	3487A
0	FIRST ISSUE. SUBSTATION REFURBISHED.	/	/	/	/	3487A

AECOM
 CAPE TOWN OFFICE
 WATERSIDE PLACE, SOUTH GATE
 TYGER WATERFRONT
 CARL CRONJE DRIVE
 TEL: +27 (0)21 950 7500
 FAX: +27 (0)21 950 7502
 REG. No. 1966/006628/07


Eskom
 PROJECT APPROVED
 C. PYM
 DESIGN APPROVED
 S.J. van ZYL
 DATE 25/06/21
 PROJECT CHECKED
 B. HOMANN
 DESIGN CHECKED
 P.A. GERBER
 DATE 25/06/21
 DRAWN BY
 K. STEYNBERG
 DATE 15/11/2010
 CHANGES AS PER SHEET 0 - COVER SHEET.
 SCALE

ISCOR SUBSTATION
 66/11 kV TRANSFORMER 1
 BACK-UP DC KEY DIAGRAM

D-WC-7104

SET NUMBER	SHEET NUMBER	REVISION
81	14	3

REV	AUTH	DATE	REVISION TO MASTER	BY	CHKD	SCALE
1	SvZ	15/11/2010	CHANGES AS PER SHEET 0 - COVER SHEET.	SvZ	PAG	DATE 25/06/21
						DATE 17/09/09

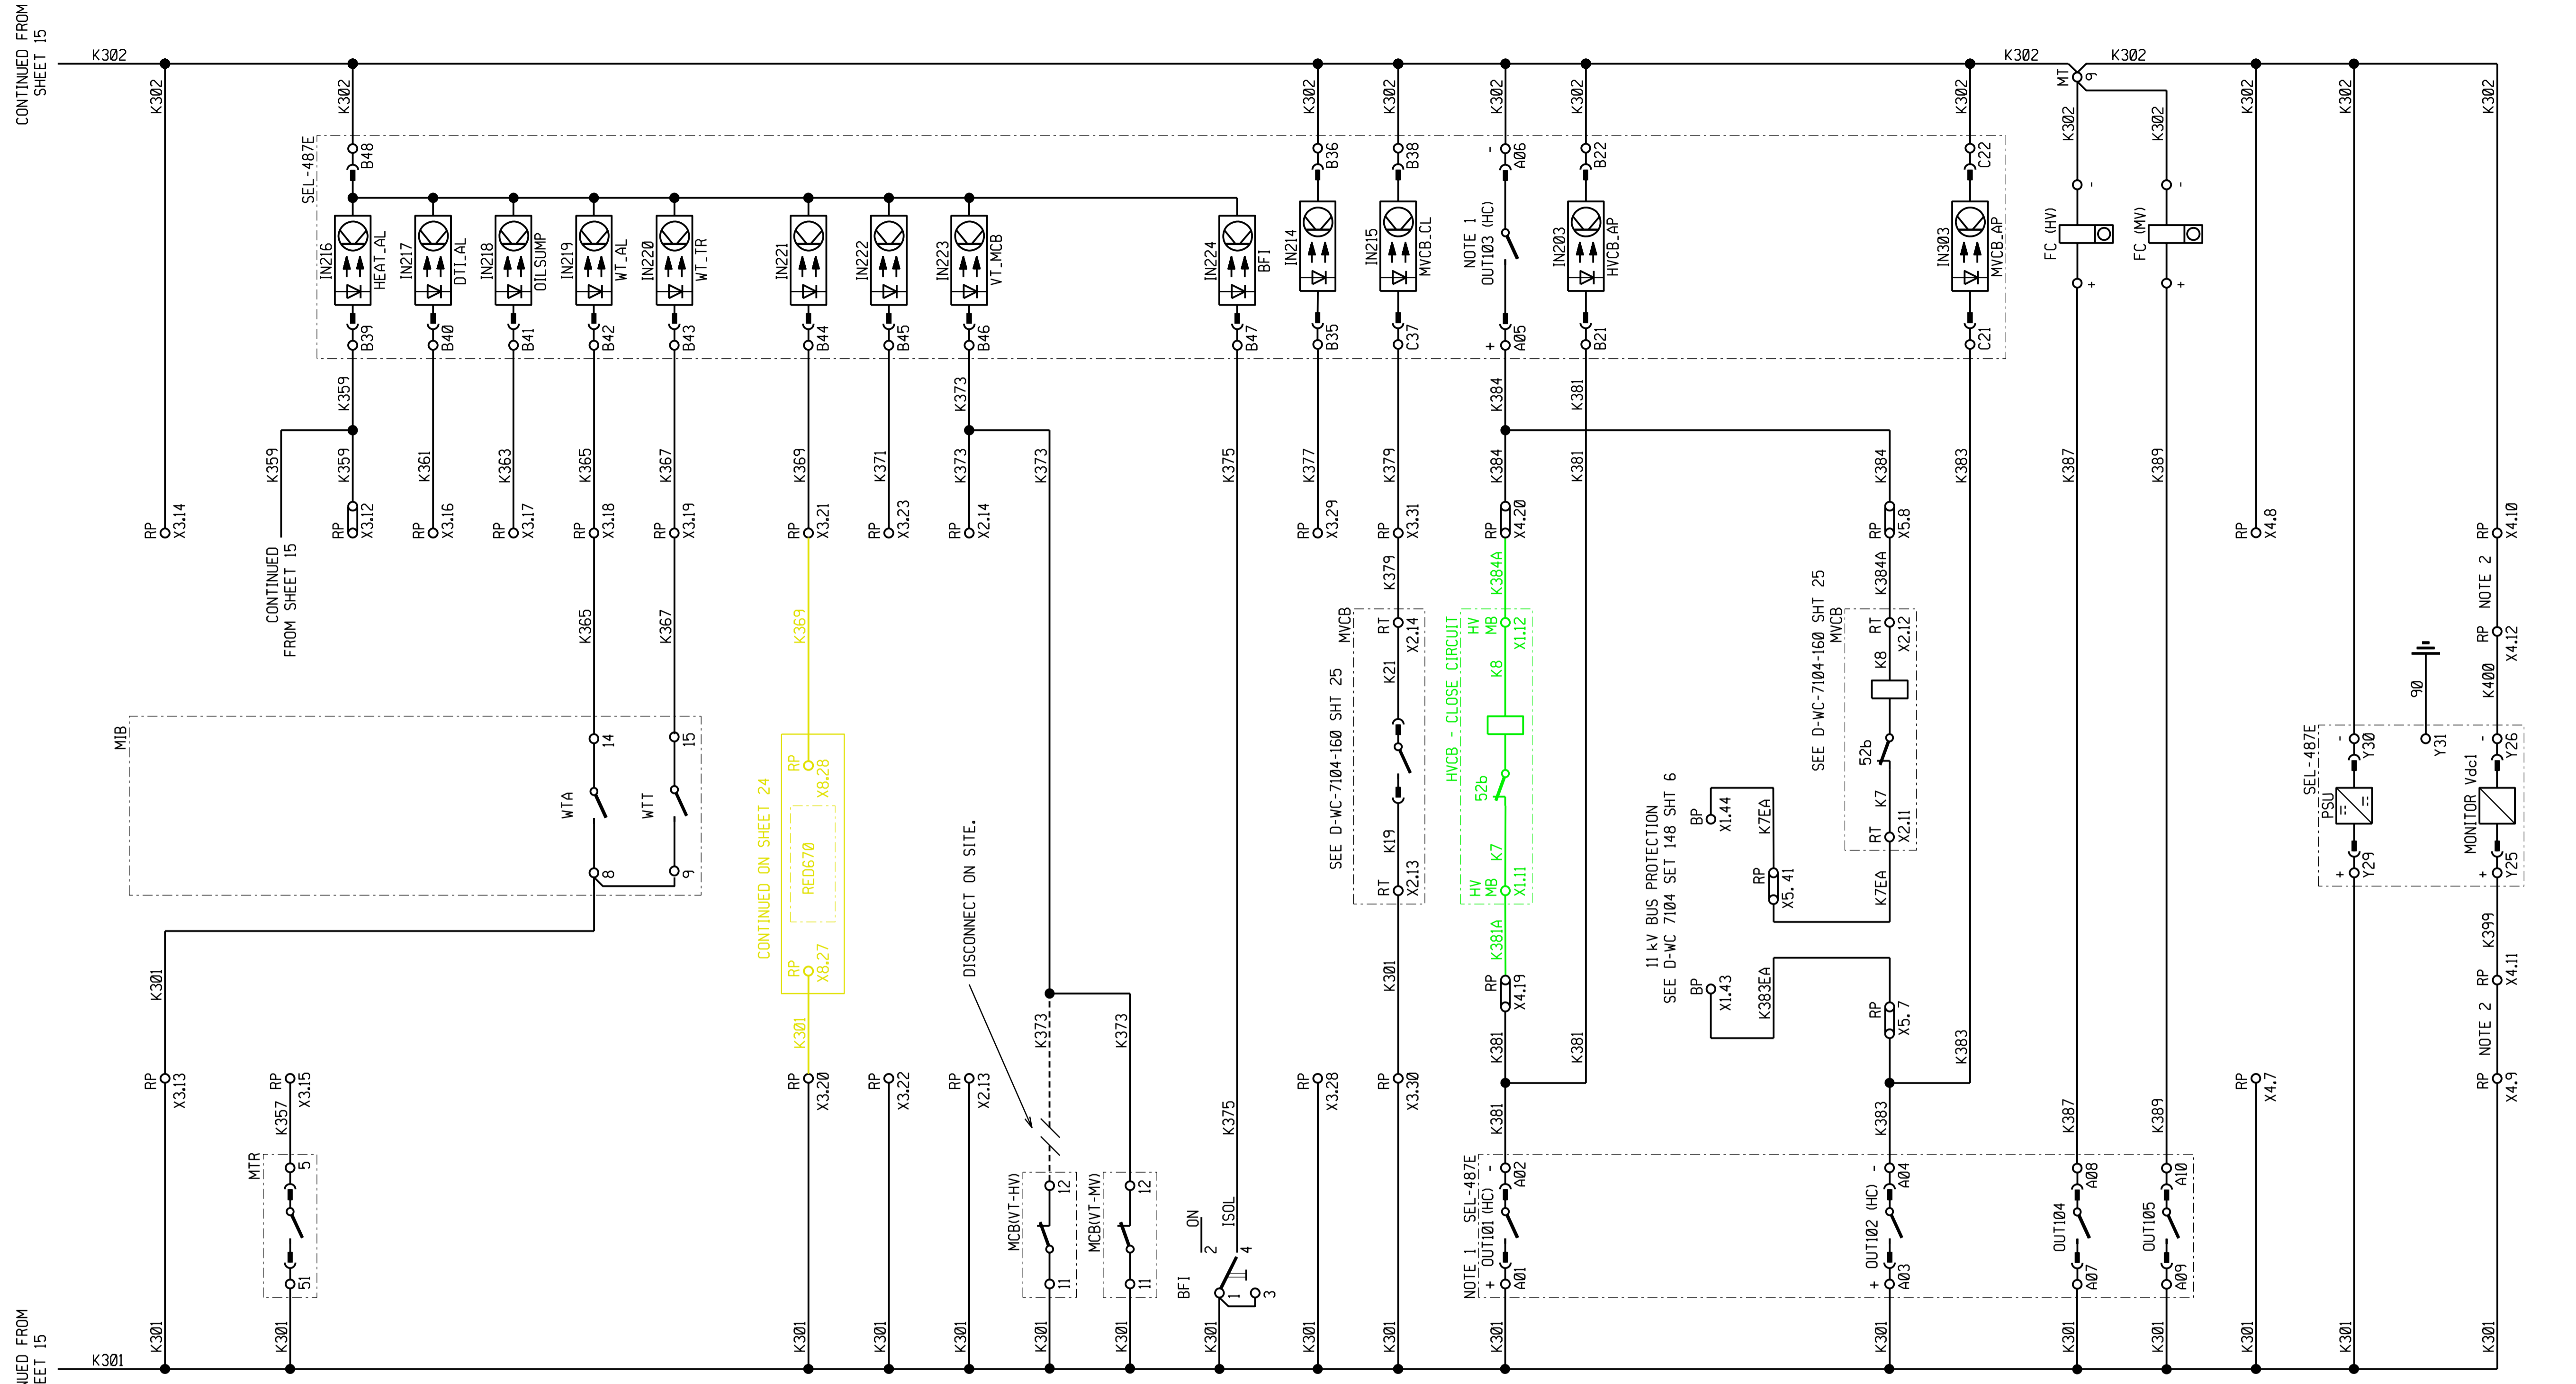

CONTINUED FROM SHEET 15

NOT INSTALLED
DIGITAL TEMPERATURE
INSTRUMENT POWER SUPPLY

NOT INSTALLED MIB DC SUPPLY
(COOLER CONTROL)

NOT IN USE COOLER FAN TRIP

NOT IN USE MIB HEATER ALARM

NOT IN USE DIGITAL TEMPERATURE
INSTRUMENT FAIL

NOT IN USE OIL SUMP (BUND WALLS)
DRAIN VALVE OPEN

TRANSFORMER WINDING
TEMPERATURE ALARM

TRANSFORMER WINDING
TEMPERATURE TRIP

SPARE INPUT

SPARE INPUT

VT MCB TRIPPED

NOT IN USE HV VOLTAGE TRANSFORMER
MCB TRIPPED

MV VOLTAGE TRANSFORMER
MCB TRIPPED

CIRCUIT-BREAKER FAIL
ISOLATED

SPARE INPUT

MV CIRCUIT-BREAKER
STAND-OFF CLOSE
(VIA UMBILICAL CORD)

HV CIRCUIT-BREAKER
CLOSE & ANTI-PUMP

HV CIRCUIT-BREAKER
ANTI-PUMP INPUT

MV CIRCUIT-BREAKER
CLOSE

MV CIRCUIT-BREAKER
ANTI-PUMP INPUT

HV CIRCUIT-BREAKER
FAULT/TRIP COUNTER

MV CIRCUIT-BREAKER
FAULT/TRIP COUNTER

SPARE SUPPLY

SEL-487E
POWER SUPPLY

BACK-UP / CUSTOMER
DC SUPPLY MONITORING

SHEET	DESCRIPTION
SHEET 25	RED670 REFERENCE DIAGRAM
SHEET 24	RED670 AC/DC & SUP. KEY DIAGRAM
SHEET 23	HV CT JB CABLING DIAGRAM
SHEET 22	PANEL CABLING DIAGRAM
SHEET 21	PANEL CABLING DIAGRAM
SHEET 20	PANEL CABLING DIAGRAM
SHEET 19	REFERENCE DIAGRAM
SHEET 18	SUPERVISORY/COMMS KEY DIAG
SHEET 17	SPR REV DC AC KEY DIAGRAM
SHEET 16	BACK-UP DC KEY DIAGRAM
SHEET 15	BACK-UP DC KEY DIAGRAM
SHEET 14	BACK-UP DC KEY DIAGRAM
SHEET 13	MAIN DC KEY DIAGRAM
SHEET 12	MAIN DC KEY DIAGRAM
SHEET 11	VT SUPPLY KEY DIAGRAM
SHEET 10	AC KEY DIAGRAM
SHEET 9	AC KEY DIAGRAM
SHEET 8	AC KEY DIAGRAM
SHEET 7	RELAY LOGIC DIAGRAM
SHEET 6	RELAY LOGIC DIAGRAM
SHEET 5	RELAY LOGIC DIAGRAM
SHEET 4	RELAY LOGIC DIAGRAM
SHEET 3	SCHEME LOGIC DIAGRAM
SHEET 2	FRONT PANEL LABELS
SHEET 1	PANEL EQUIPMENT LAYOUT
SHEET 0	COVER SHEET

REV	REVISION DESCRIPTION	BY	CHKD	AUTH	DATE	PROJECT NUMBER
3	66kV VT ADDED.	KS	BH	C.PYM	25/06/2021	
2	66kV CIRCUIT BREAKER ADDED	JF	BSH	LMB	21/01/2019	
1	AS BUILT SITE MODIFICATIONS IMPLEMENTED.	AVS	KRR	C.KING	18/02/2015	3487A
0	FIRST ISSUE. SUBSTATION REFURBISHED.	/	/	/	/	3487A

AECOM
CAPE TOWN OFFICE
WATERSIDE PLACE, SOUTH GATE
TYGER WATER FRONT
CARL CRONJE DRIVE
TEL: +27 (0)21 950 7500
FAX: +27 (0)21 950 7502
REG. No. 19666/006628/07



PROJECT APPROVED
C. PYM

DESIGN APPROVED
S.J. van ZYL

DATE 25/06/21 DATE 11/06/18

PROJECT CHECKED
B. HOMANN

DESIGN CHECKED
P.A. GERBER

DATE 25/06/21 DATE 11/06/18

DRAWN BY
K. STEYNBERG

DATE 15/11/2010 DATE 17/09/09

REVISION TO MASTER

BY SVZ

SCALE

PROJECT NUMBER

SET NUMBER

SHEET NUMBER

REVISION

D-WC-7104

81

16

3


- NOTES**
- SEL-487E OUTPUT CONTACTS DESIGNATED 'HC' ARE HIGH CURRENT (NORMAL SPEED) TYPES, WITH BREAKING CAPACITY 100kV, L/R = 20ms.
 - REMOVE LINKS IN THE EVENT THAT THE SEL-487E IS TO BE USED TO MONITOR THE CUSTOMER'S DC SUPPLY. IN THIS CASE, WIRE THE CUSTOMER'S POSITIVE SUPPLY TO X4.11 AND THE NEGATIVE TO X4.12 (MAX. 350Vdc).
 - REFERENCE CONDITIONS: DIGITAL TEMPERATURE INSTRUMENT SHOWN IN THE DE-ENERGISED (FAILED) STATE. OIL SUMP DRAIN VALVE SHOWN IN THE OPEN POSITION.

ALARM WORDING

SUPERVISORY ALARM

PNT NAME DESCRIPTION/
PNT NAME

PROTECTION
NOT HEALTHY

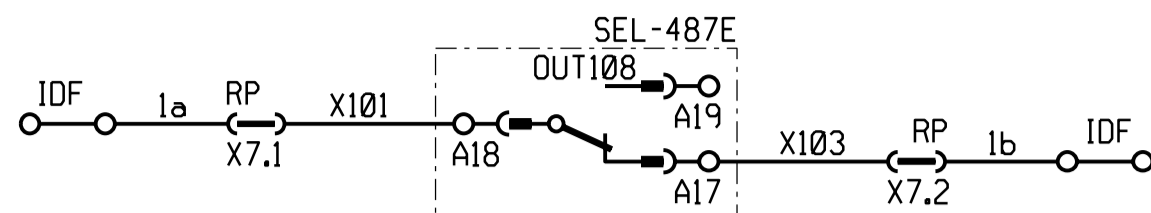

PROTECTION
(PNH)

SEL-487E MAIN PRINTED CIRCUIT (PC) BOARD JUMPER SETTINGS

THE FOLLOWING MAIN PC BOARD JUMPER SELECTIONS SHALL BE MADE BY CONCO PRIOR TO DELIVERY OF SCHEMES TO ESKOM.

JUMPER NAME	SETTING	FUNCTION
J21-A	N/A	RESERVED FOR USE BY SEL
J21-PASSWORD	OFF	DISABLE PASSWORD PROTECTION
J21-BREAKER	ON	ALLOW ASCII SERIAL COMMANDS 'OPEN', 'CLOSE' AND 'PULSE'
J21-D	N/A	RESERVED FOR USE BY SEL
JMP1	OFF	IRIG-B TERMINATING Z (OFF = 2550 Ohms, ON = 50 Ohms)
JMP2	ON	PORT 3 PIN 1 (ON = +5Vdc, OFF = NO FUNCTION)
JMP3	ON	PORT 2 PIN 1 (ON = +5Vdc, OFF = NO FUNCTION)
JMP4	OFF	PORT 1 PIN 1 (ON = +5Vdc, OFF = NO FUNCTION)

COMMS INTERFACE AND TIME SYNCHRONISATION

SEL-2886 DIP SWITCH SETTINGS

THE FOLLOWING DIP SWITCH SELECTIONS SHALL BE MADE BY CONCO PRIOR TO DELIVERY OF SCHEMES TO ESKOM.


NO.	1	2	3	4	5	6	7	8
ON-1								
OFF-0								

THE SEL-2886 IS SET IN SEND DATA CONTROL (SDC) MODE (DIP SWITCH 4 OFF), CONFIGURED FOR COMPATIBILITY WITH 9600 BAUD (DIP SWITCHES 1-3) AND WITH ECHO OFF (DIP SWITCH 6).

ALTERNATIVE BAUD RATE SETTINGS ARE AS FOLLOWS:

BAUD	1	2	3
1200	1	1	1
2400	0	1	1
4800	1	0	1
9600	0	0	1
19200	1	1	0
38400	0	1	0
57600	1	0	0
115200	0	0	0





SPARE RS232 PORT
(e.g. FOR MIRROR-BIT COMMUNICATION)

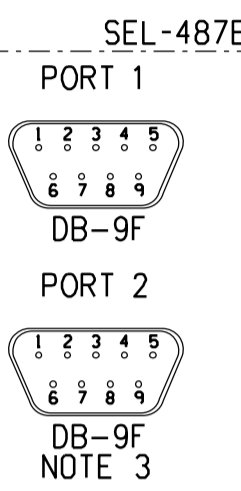


REMOTE ENGINEERING ACCESS
RS232 REAR PORT SUPPORTING SEL OR LMD PROTOCOL



SERIAL SCADA COMMUNICATION
RS232 REAR PORT SUPPORTING DNP3 PROTOCOL

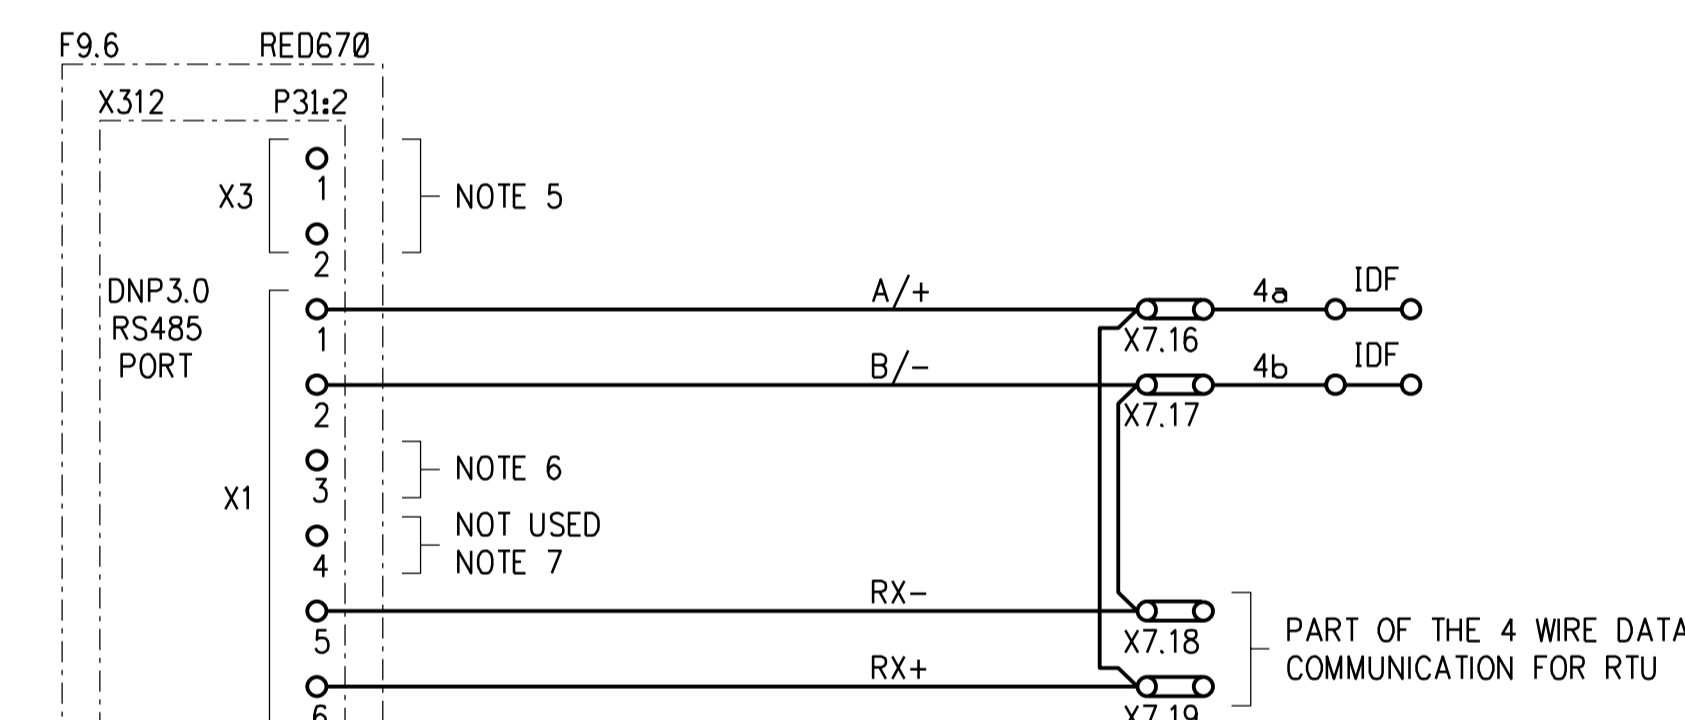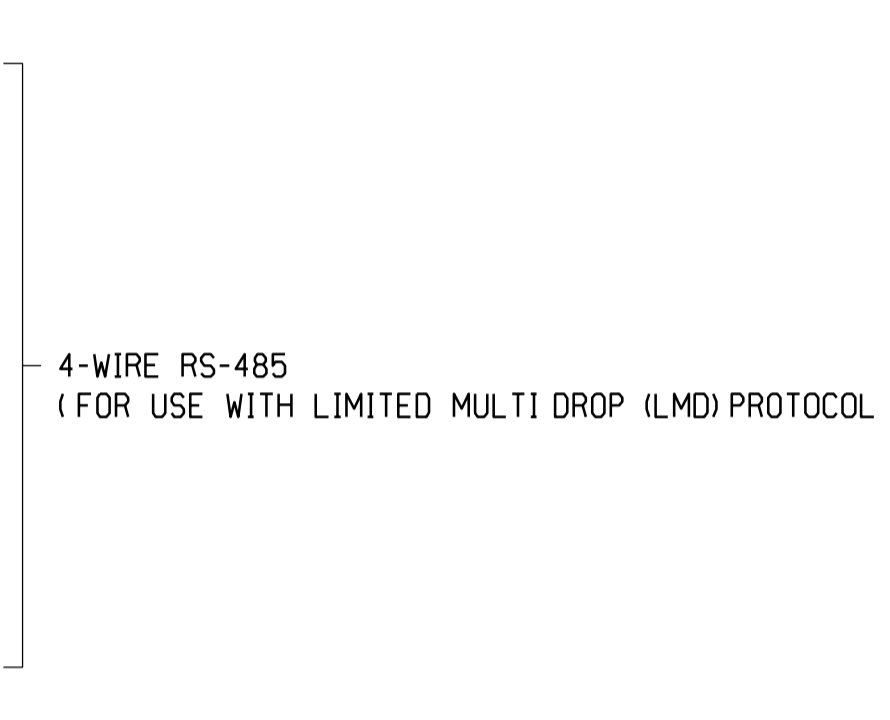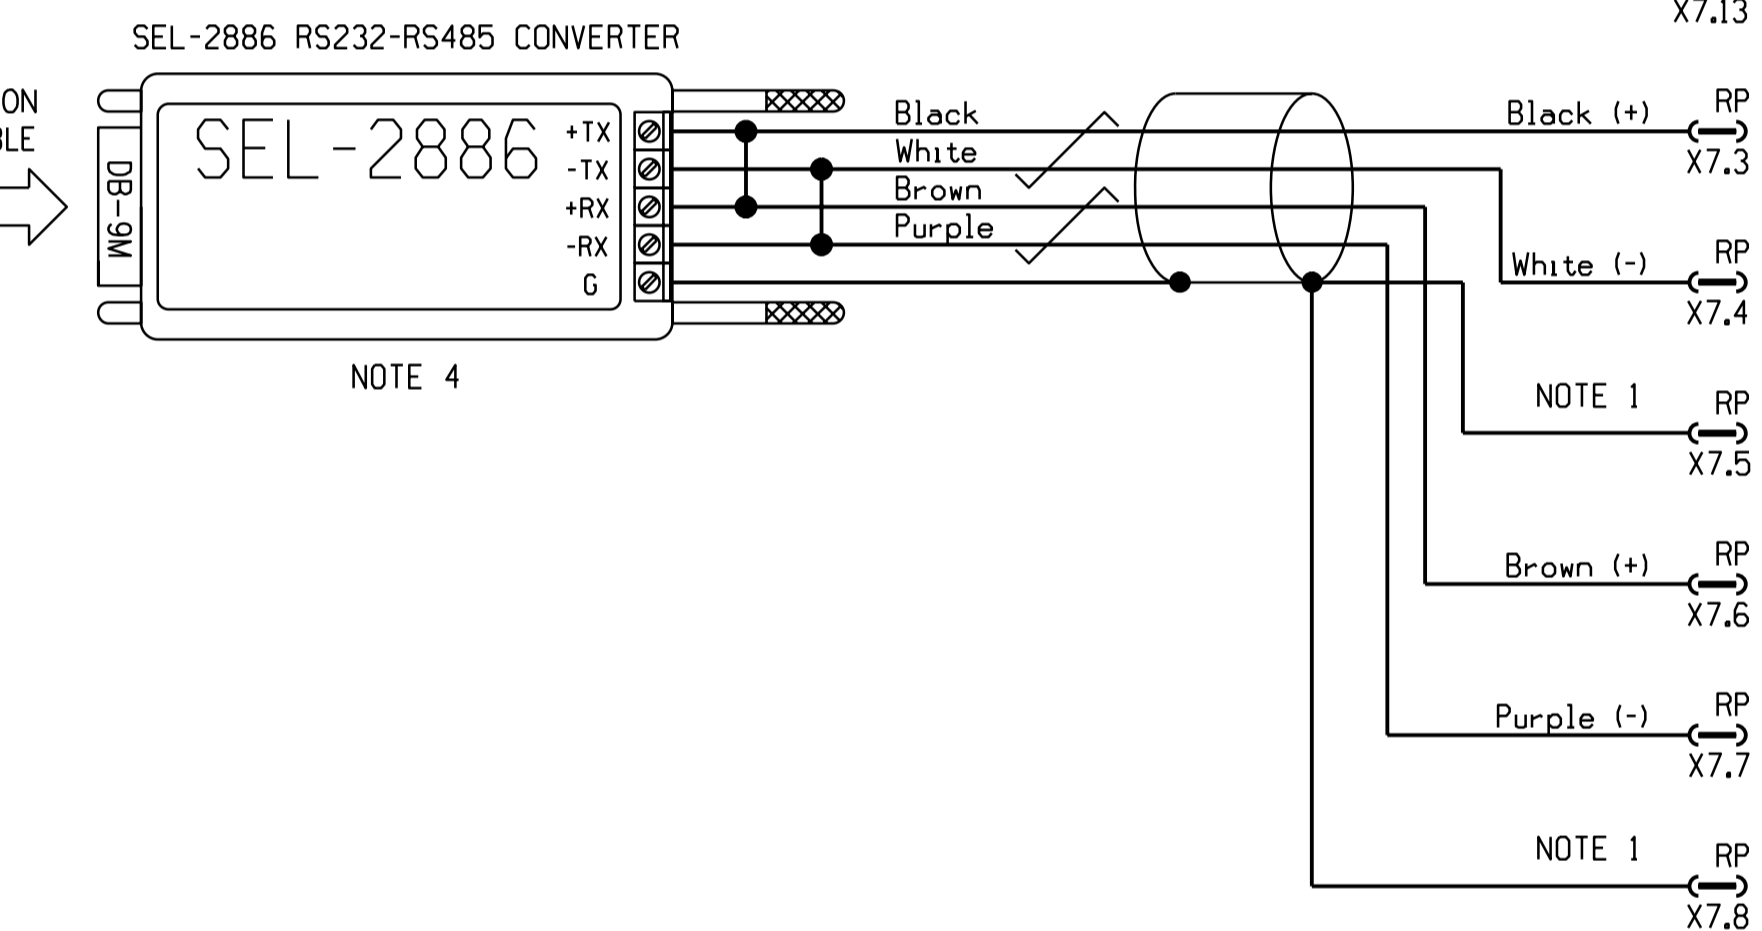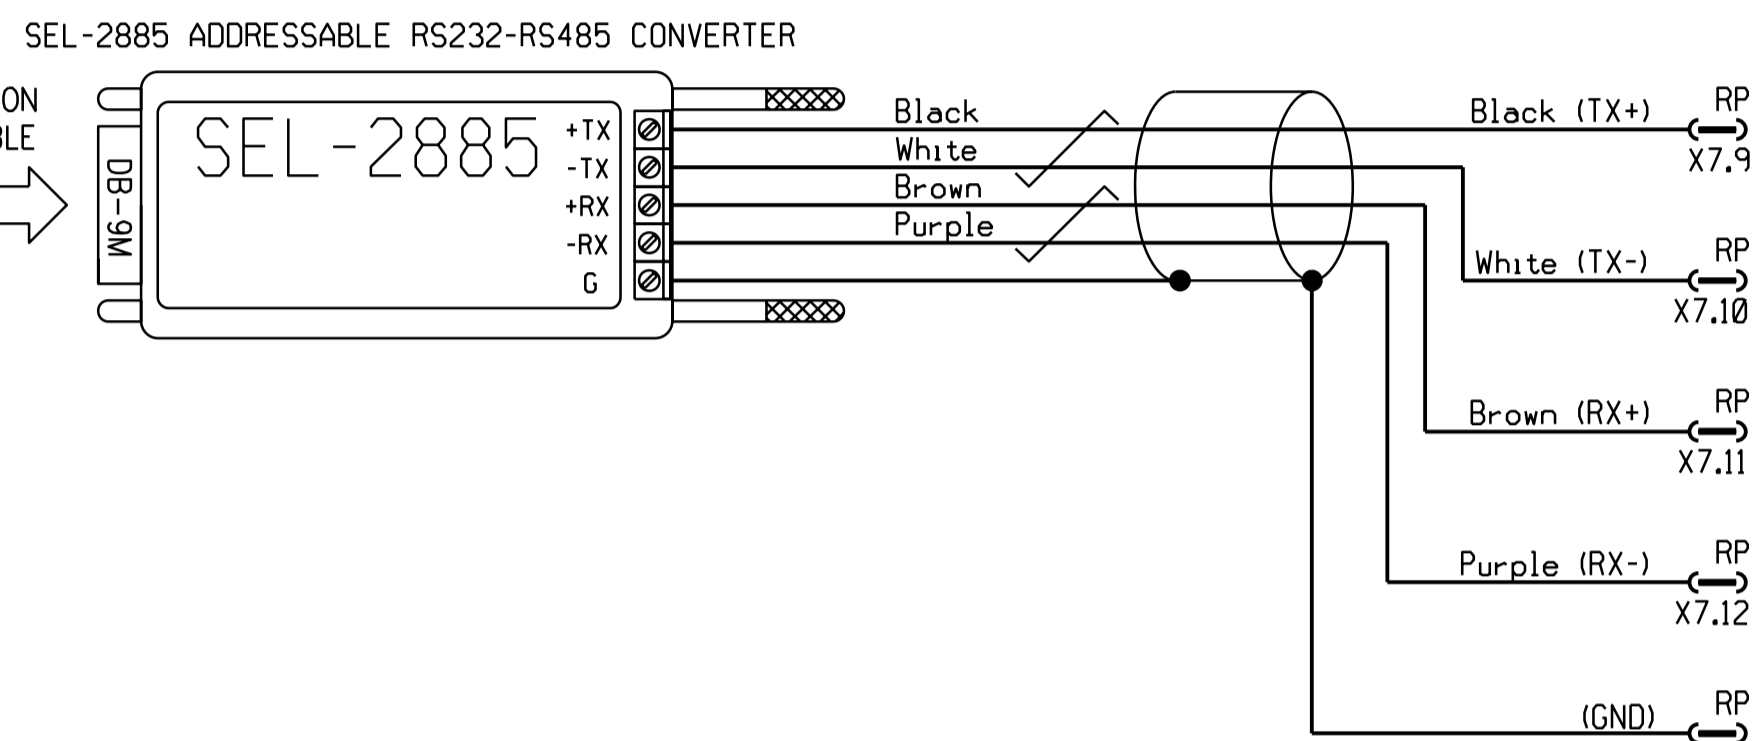


TIME SYNCHRONISATION
IRIG-B

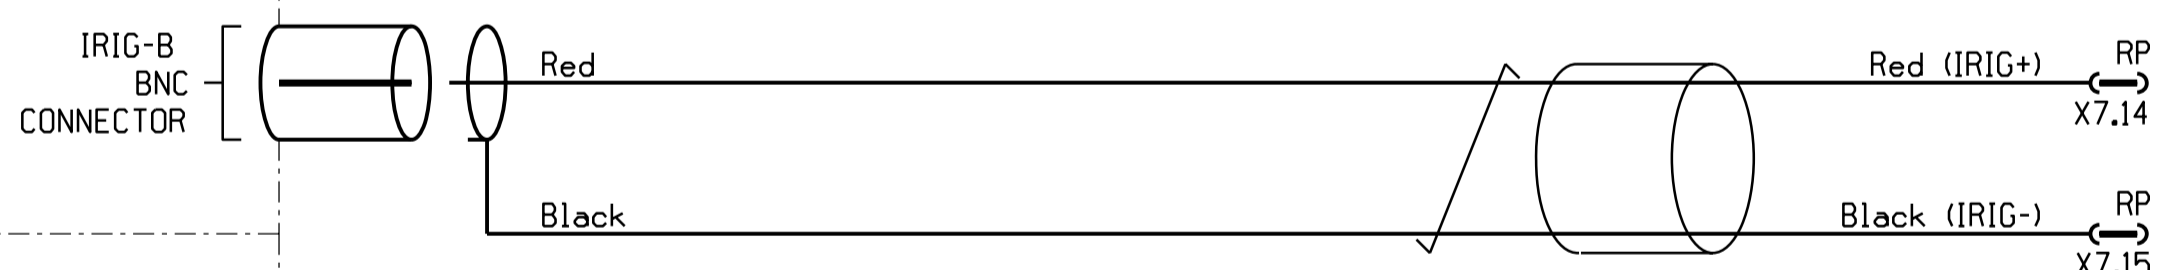

ETHERNET CARD
(ORDERING OPTION)
PORTS SUPPORTING DNP3 OR IEC 61850 AS PER ORDER

FIBRE OPTIC (ST CONNECTORS)
820nm MULTIMODE FIBRE

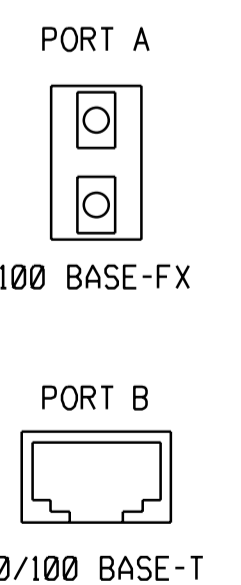

COPPER (RJ45 CONNECTOR)

NOTES

- RS485 COMMUNICATION CIRCUITS TO BE EARTHED AT ONE POINT ONLY.
- THE SEL-2886 PRODUCT MANUAL INDICATES THAT TERMINATING RESISTORS SHOULD SELDOM BE REQUIRED ON THE RS485 CIRCUITS (e.g. COMMUNICATION AT UP TO 115200bps CAN BE ACHIEVED OVER A 230M CABLE RUN WITHOUT THE NEED FOR RESISTORS). WHERE REQUIRED, REFER TO THE PRODUCT MANUAL FOR RESISTOR SIZING AND INSTALLATION PRACTICE NOTES.
- THE SEL-2885 AND SEL-2886 CONVERTERS REQUIRE A +5Vdc AUXILIARY SUPPLY. THIS IS PROVIDED VIA PIN 1 OF THE SEL-487E COMM PORT. SEE MAIN PC BOARD JUMPER SETTINGS, TOP RIGHT.
- SEL-2886 CONVERTERS ARE CAPABLE OF 2- OR 4-WIRE RS485 MULTI-DROP CONNECTIONS. THE SEL-2886 IS WIRED FOR 2-WIRE CONNECTION IN THE STANDARD SCHEME APPLICATION.



CAPE TOWN OFFICE
WATERSIDE PLACE, SOUTH GATE
TYGER WATERFRONT
CARL CROWE DRIVE
TEL: +27 (0)21 950 7500
FAX: +27 (0)21 950 7502
REG. No. 1966/006628/07

REV	REVISION DESCRIPTION	BY	CHKD	AUTH	DATE	PROJECT NUMBER
1	AS BUILT SITE MODIFICATIONS IMPLEMENTED.	AVS	KRR	C.KING	18/02/2015	3487A
0	FIRST ISSUE. SUBSTATION REFURBISHED.	/	/	/	/	3487A

PROJECT APPROVED	DESIGN APPROVED
C. PYM	S.J. van ZYL
DATE 25/06/21	DATE 11/06/10
PROJECT CHECKED	DESIGN CHECKED
B. HOMANN	P.A. GERBER
DATE 25/06/21	DATE 11/06/10
DRAWN BY	DRAWN BY
K. STEYNBERG	S.J. van ZYL
DATE 25/06/21	DATE 17/09/09

Eskom

ISCOR SUBSTATION

66/11 kV TRANSFORMER 1

SUPERVISORY/COMMS KEY DIAGRAM


D-WC-7104 81 18 1

SET NUMBER SHEET NUMBER REVISION

REV	AUTH	DATE	REVISION DESCRIPTION	BY	CHKD	SCALE
1	SvZ	15/11/2010	CHANGES AS PER SHEET 0 - COVER SHEET.	SvZ	PAG	DATE 25/06/21
			REVISION TO MASTER			DATE 17/09/09

SHEET	DESCRIPTION
SHEET 25	RED670 REFERENCE DIAGRAM
SHEET 24	RED670 AC/DC & SUP. KEY DIAGRAM
SHEET 23	HV CT JB CABLING DIAGRAM
SHEET 22	PANEL CABLING DIAGRAM
SHEET 21	PANEL CABLING DIAGRAM
SHEET 20	PANEL CABLING DIAGRAM
SHEET 19	REFERENCE DIAGRAM
SHEET 18	SUPERVISORY/COMMS KEY DIAG
SHEET 17	SPR REW. DC AC KEY DIAGRAM
SHEET 16	BACK-UP DC KEY DIAGRAM
SHEET 15	BACK-UP DC KEY DIAGRAM
SHEET 14	BACK-UP DC KEY DIAGRAM
SHEET 13	MAIN DC KEY DIAGRAM
SHEET 12	MAIN DC KEY DIAGRAM
SHEET 11	VT SUPPLY KEY DIAGRAM
SHEET 10	AC KEY DIAGRAM
SHEET 9	AC KEY DIAGRAM
SHEET 8	AC KEY DIAGRAM
SHEET 7	RELAY LOGIC DIAGRAM
SHEET 6	RELAY LOGIC DIAGRAM
SHEET 5	RELAY LOGIC DIAGRAM
SHEET 4	RELAY LOGIC DIAGRAM
SHEET 3	SCHEME LOGIC DIAGRAM
SHEET 2	FRONT PANEL LABELS
SHEET 1	PANEL EQUIPMENT LAYOUT
SHEET 0	COVER SHEET

MASTER TRACING FILED UNDER D-DT-15202 SHEET 18 OF 26 REVISION 1

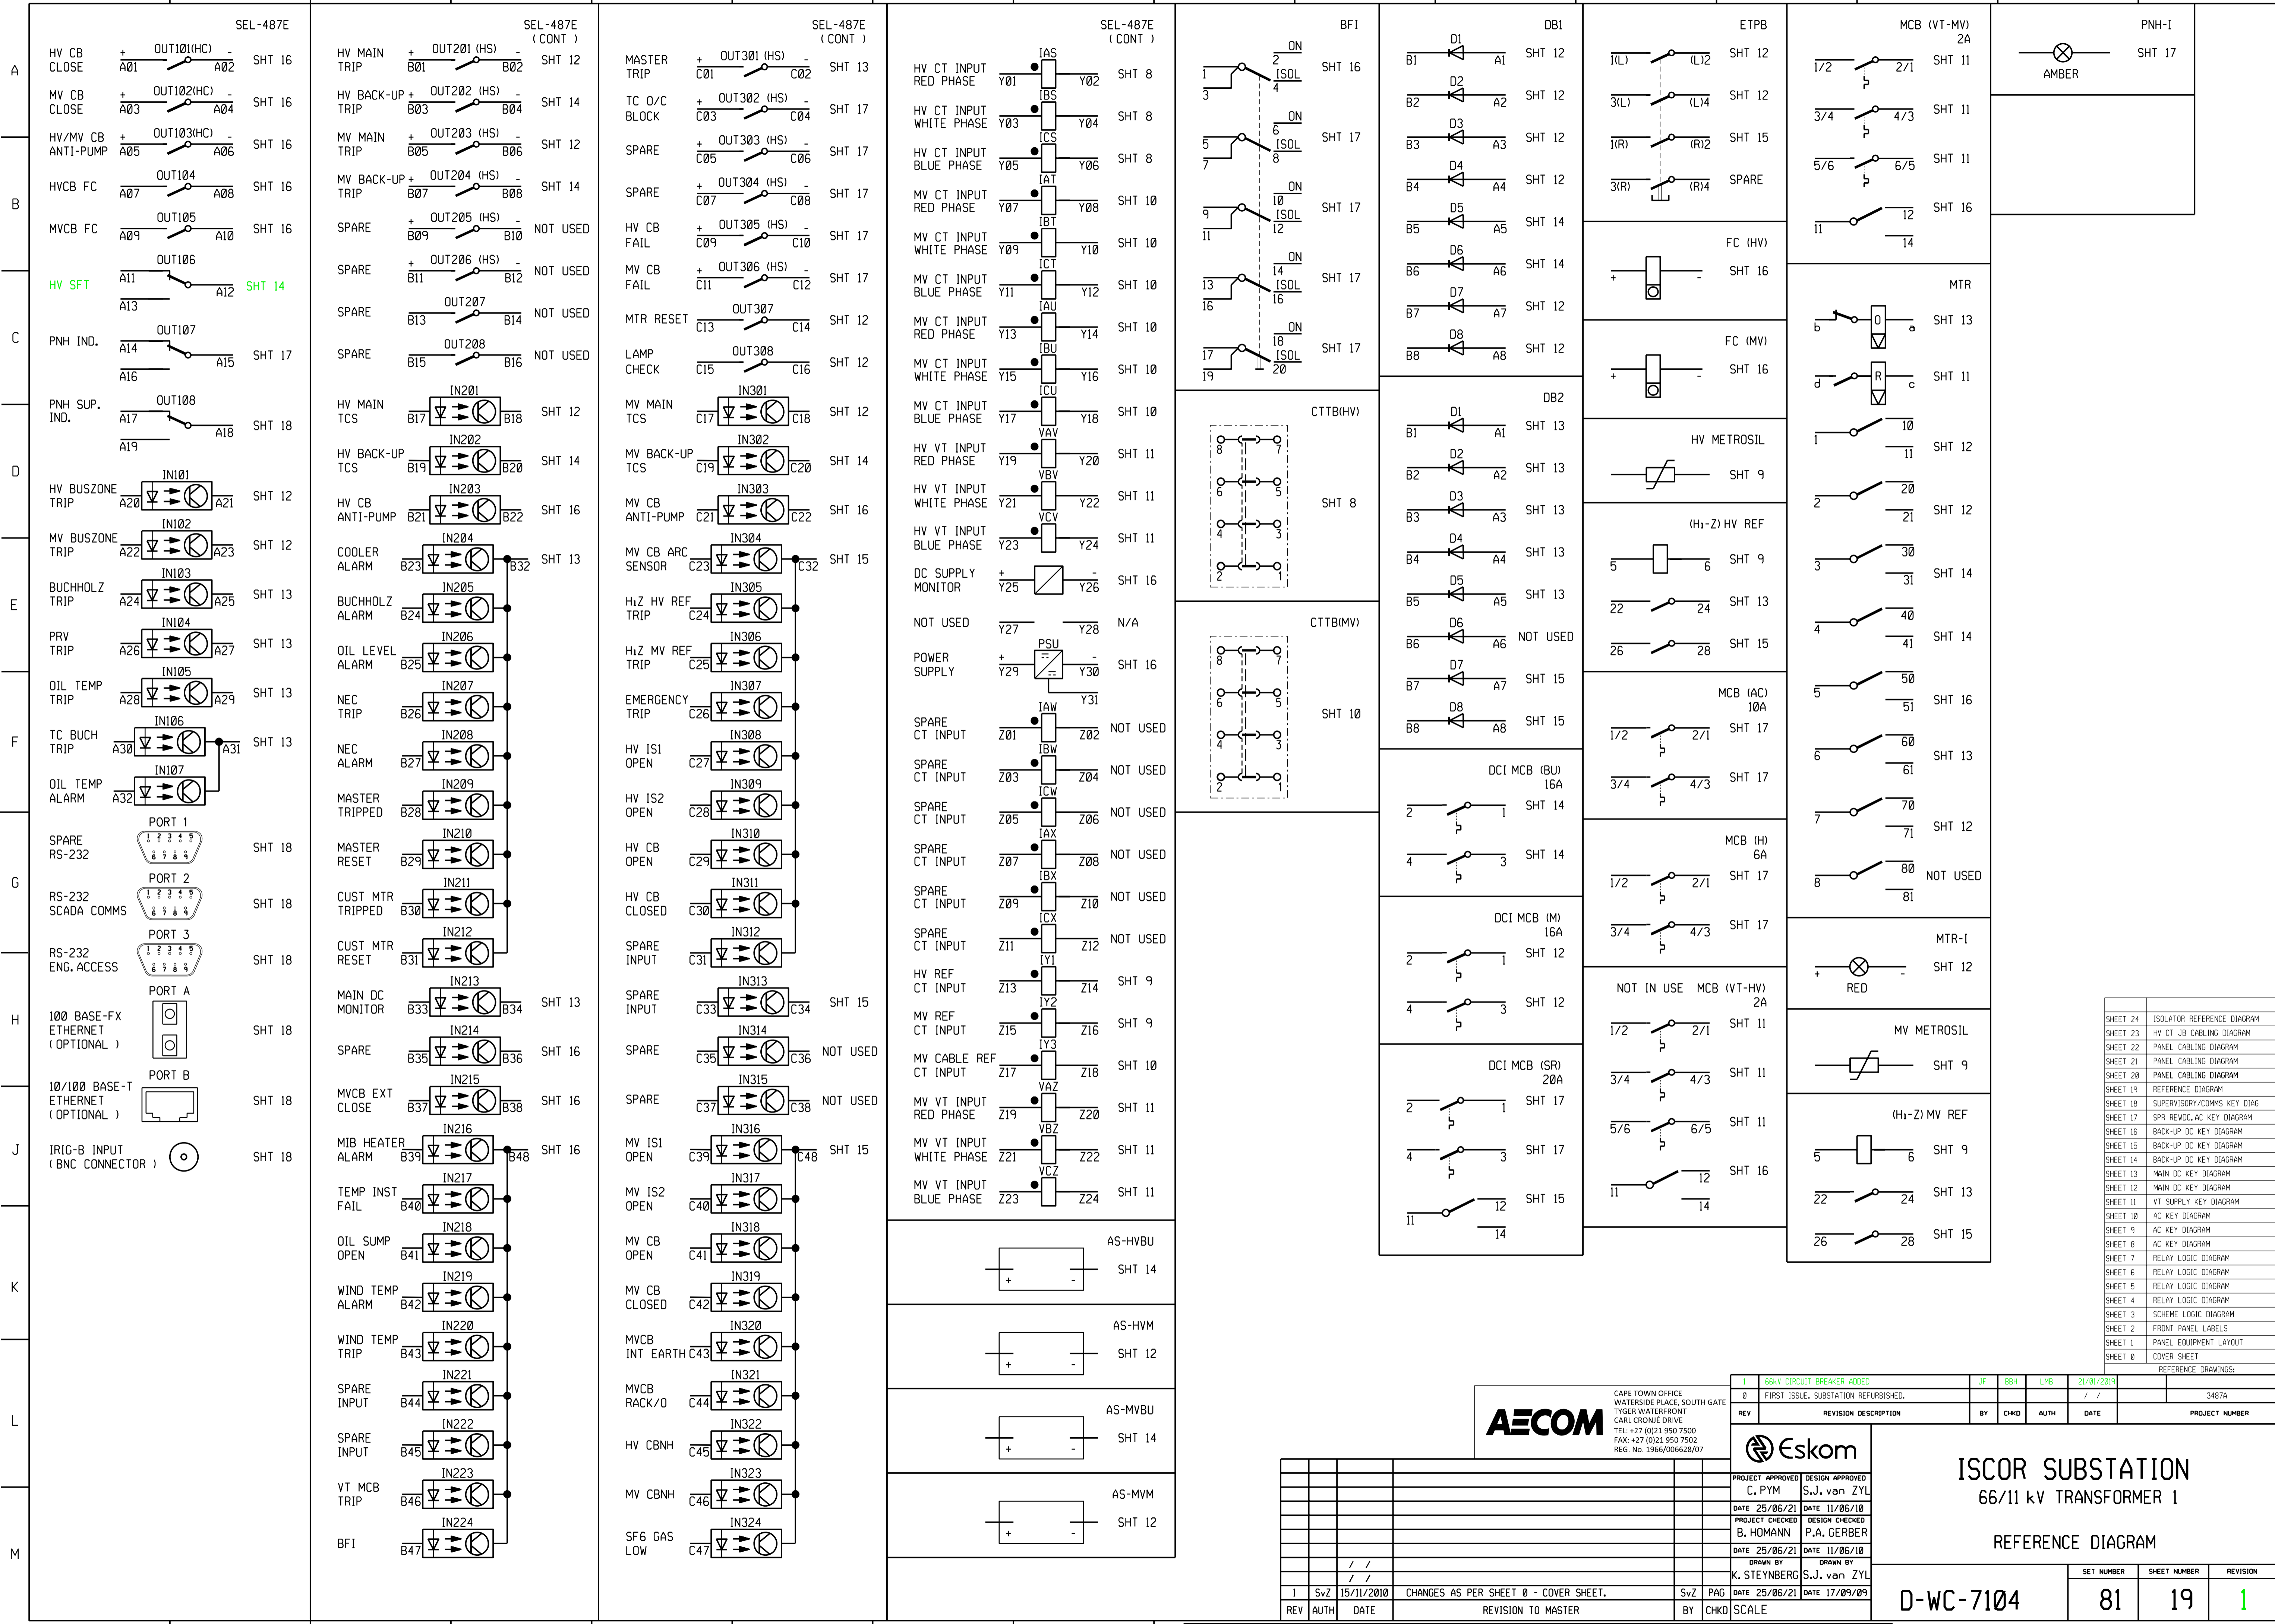

SHEET 24	ISOLATOR REFERENCE DIAGRAM
SHEET 23	HV CT JB CABLING DIAGRAM
SHEET 22	PANEL CABLING DIAGRAM
SHEET 21	PANEL CABLING DIAGRAM
SHEET 20	PANEL CABLING DIAGRAM
SHEET 19	REFERENCE DIAGRAM
SHEET 18	SUPERVISORY/COMMS KEY DIAG
SHEET 17	SPR REWOC. AC KEY DIAGRAM
SHEET 16	BACK-UP DC KEY DIAGRAM
SHEET 15	BACK-UP DC KEY DIAGRAM
SHEET 14	BACK-UP DC KEY DIAGRAM
SHEET 13	MAIN DC KEY DIAGRAM
SHEET 12	MAIN DC KEY DIAGRAM
SHEET 11	VT SUPPLY KEY DIAGRAM
SHEET 10	AC KEY DIAGRAM
SHEET 9	AC KEY DIAGRAM
SHEET 8	AC KEY DIAGRAM
SHEET 7	RELAY LOGIC DIAGRAM
SHEET 6	RELAY LOGIC DIAGRAM
SHEET 5	RELAY LOGIC DIAGRAM
SHEET 4	RELAY LOGIC DIAGRAM
SHEET 3	SCHEME LOGIC DIAGRAM
SHEET 2	FRONT PANEL LABELS
SHEET 1	PANEL EQUIPMENT LAYOUT
SHEET 0	COVER SHEET

CAPE TOWN OFFICE
WATERSIDE PLACE, SOUTH GATE
TYGER WATERHOF FRONT
CARL CROUWE DRIVE
TEL: +27 (0)21 950 7500
FAX: +27 (0)21 950 7502
REG. No. 1966/006628/07

AECOM

1	66kV CIRCUIT BREAKER ADDED	JF	BBH	LMB	21/01/2019		3487A
0	FIRST ISSUE. SUBSTATION REFURBISHED.				/ /		
REV	REVISION DESCRIPTION	BY	CHKD	AUTH	DATE		PROJECT NUMBER

PROJECT APPROVED: C. PYM
DESIGN APPROVED: S.J. van ZYL
DATE 25/06/21
DATE 11/06/10
PROJECT CHECKED: B. HOMANN
DESIGN CHECKED: P.A. GERBER
DATE 25/06/21
DATE 11/06/10
DRAWN BY: K. STEYNBERG
DRAWN BY: S.J. van ZYL



Eskom

ISCOR SUBSTATION
66/11 kV TRANSFORMER 1
REFERENCE DIAGRAM

SET NUMBER	SHEET NUMBER	REVISION
D-WC-7104	81	19

15/11/2010 CHANGES AS PER SHEET 0 - COVER SHEET. SvZ PAG
25/06/21 REVISION TO MASTER SvZ PAG
DATE 25/06/21 DATE 17/09/09
BY CHKD SCALE

MASTER TRACING FILED UNDER D-DT-15202 SHEET 19 OF 26 REVISION 1

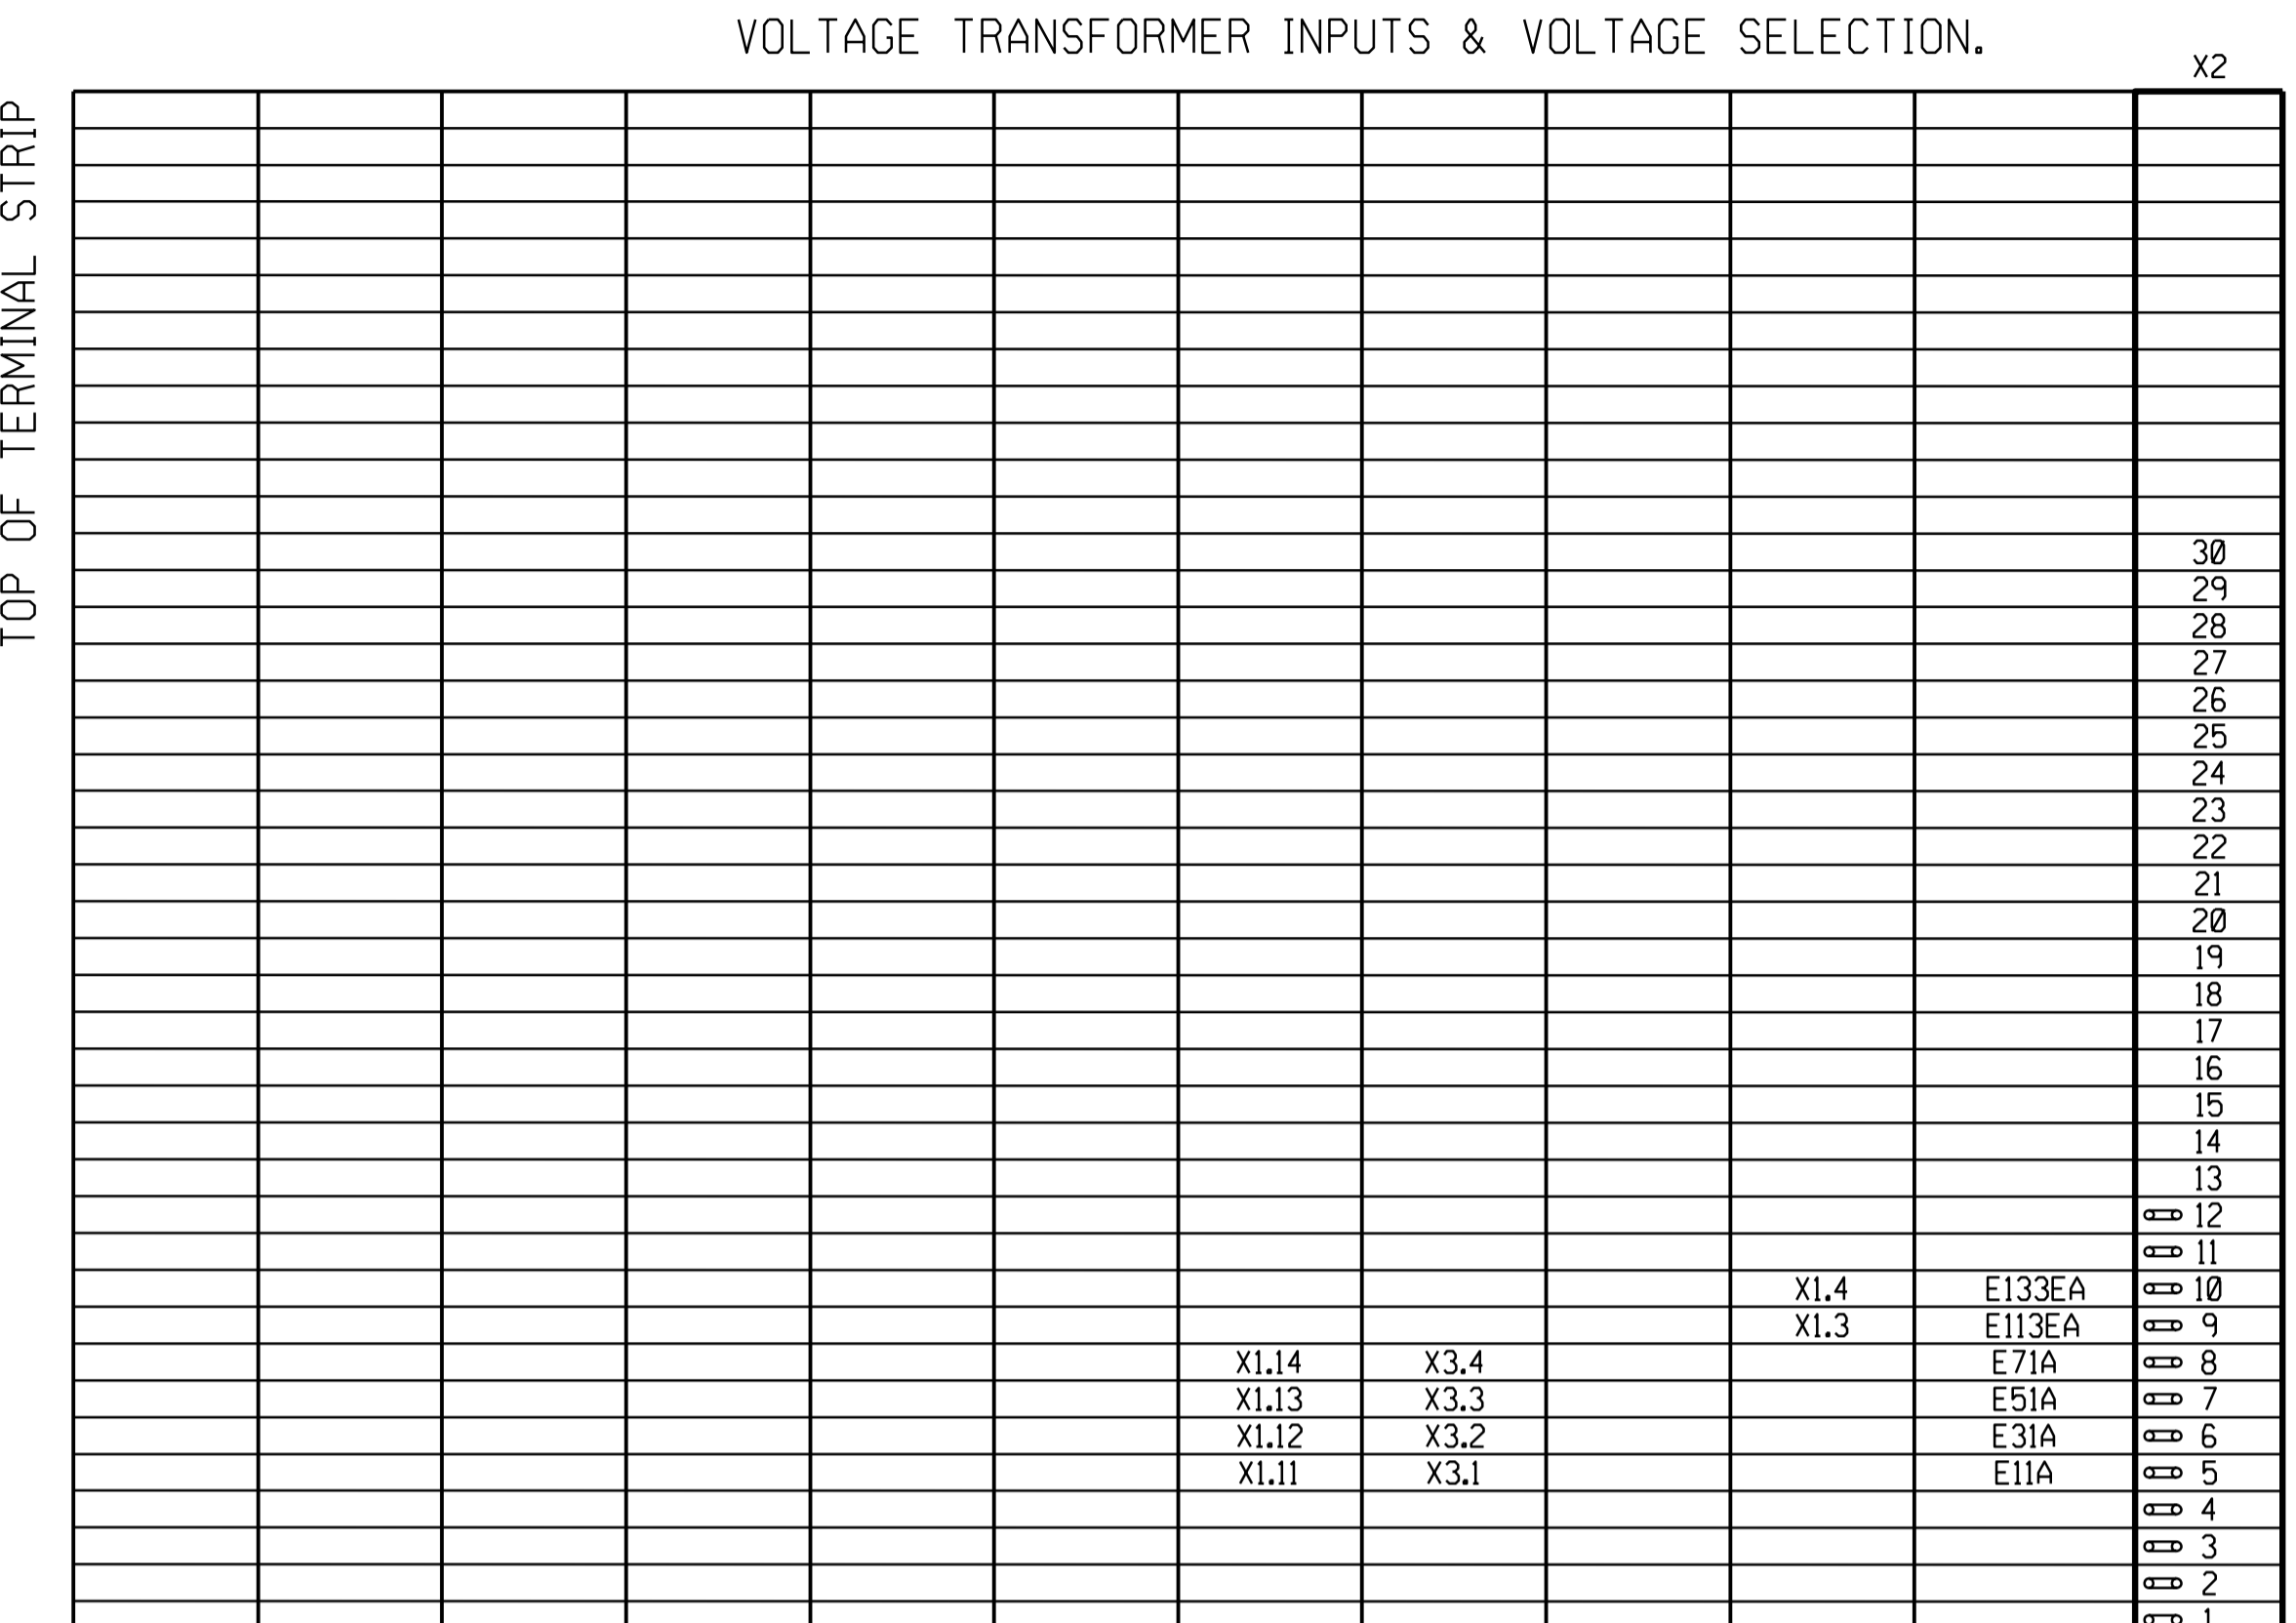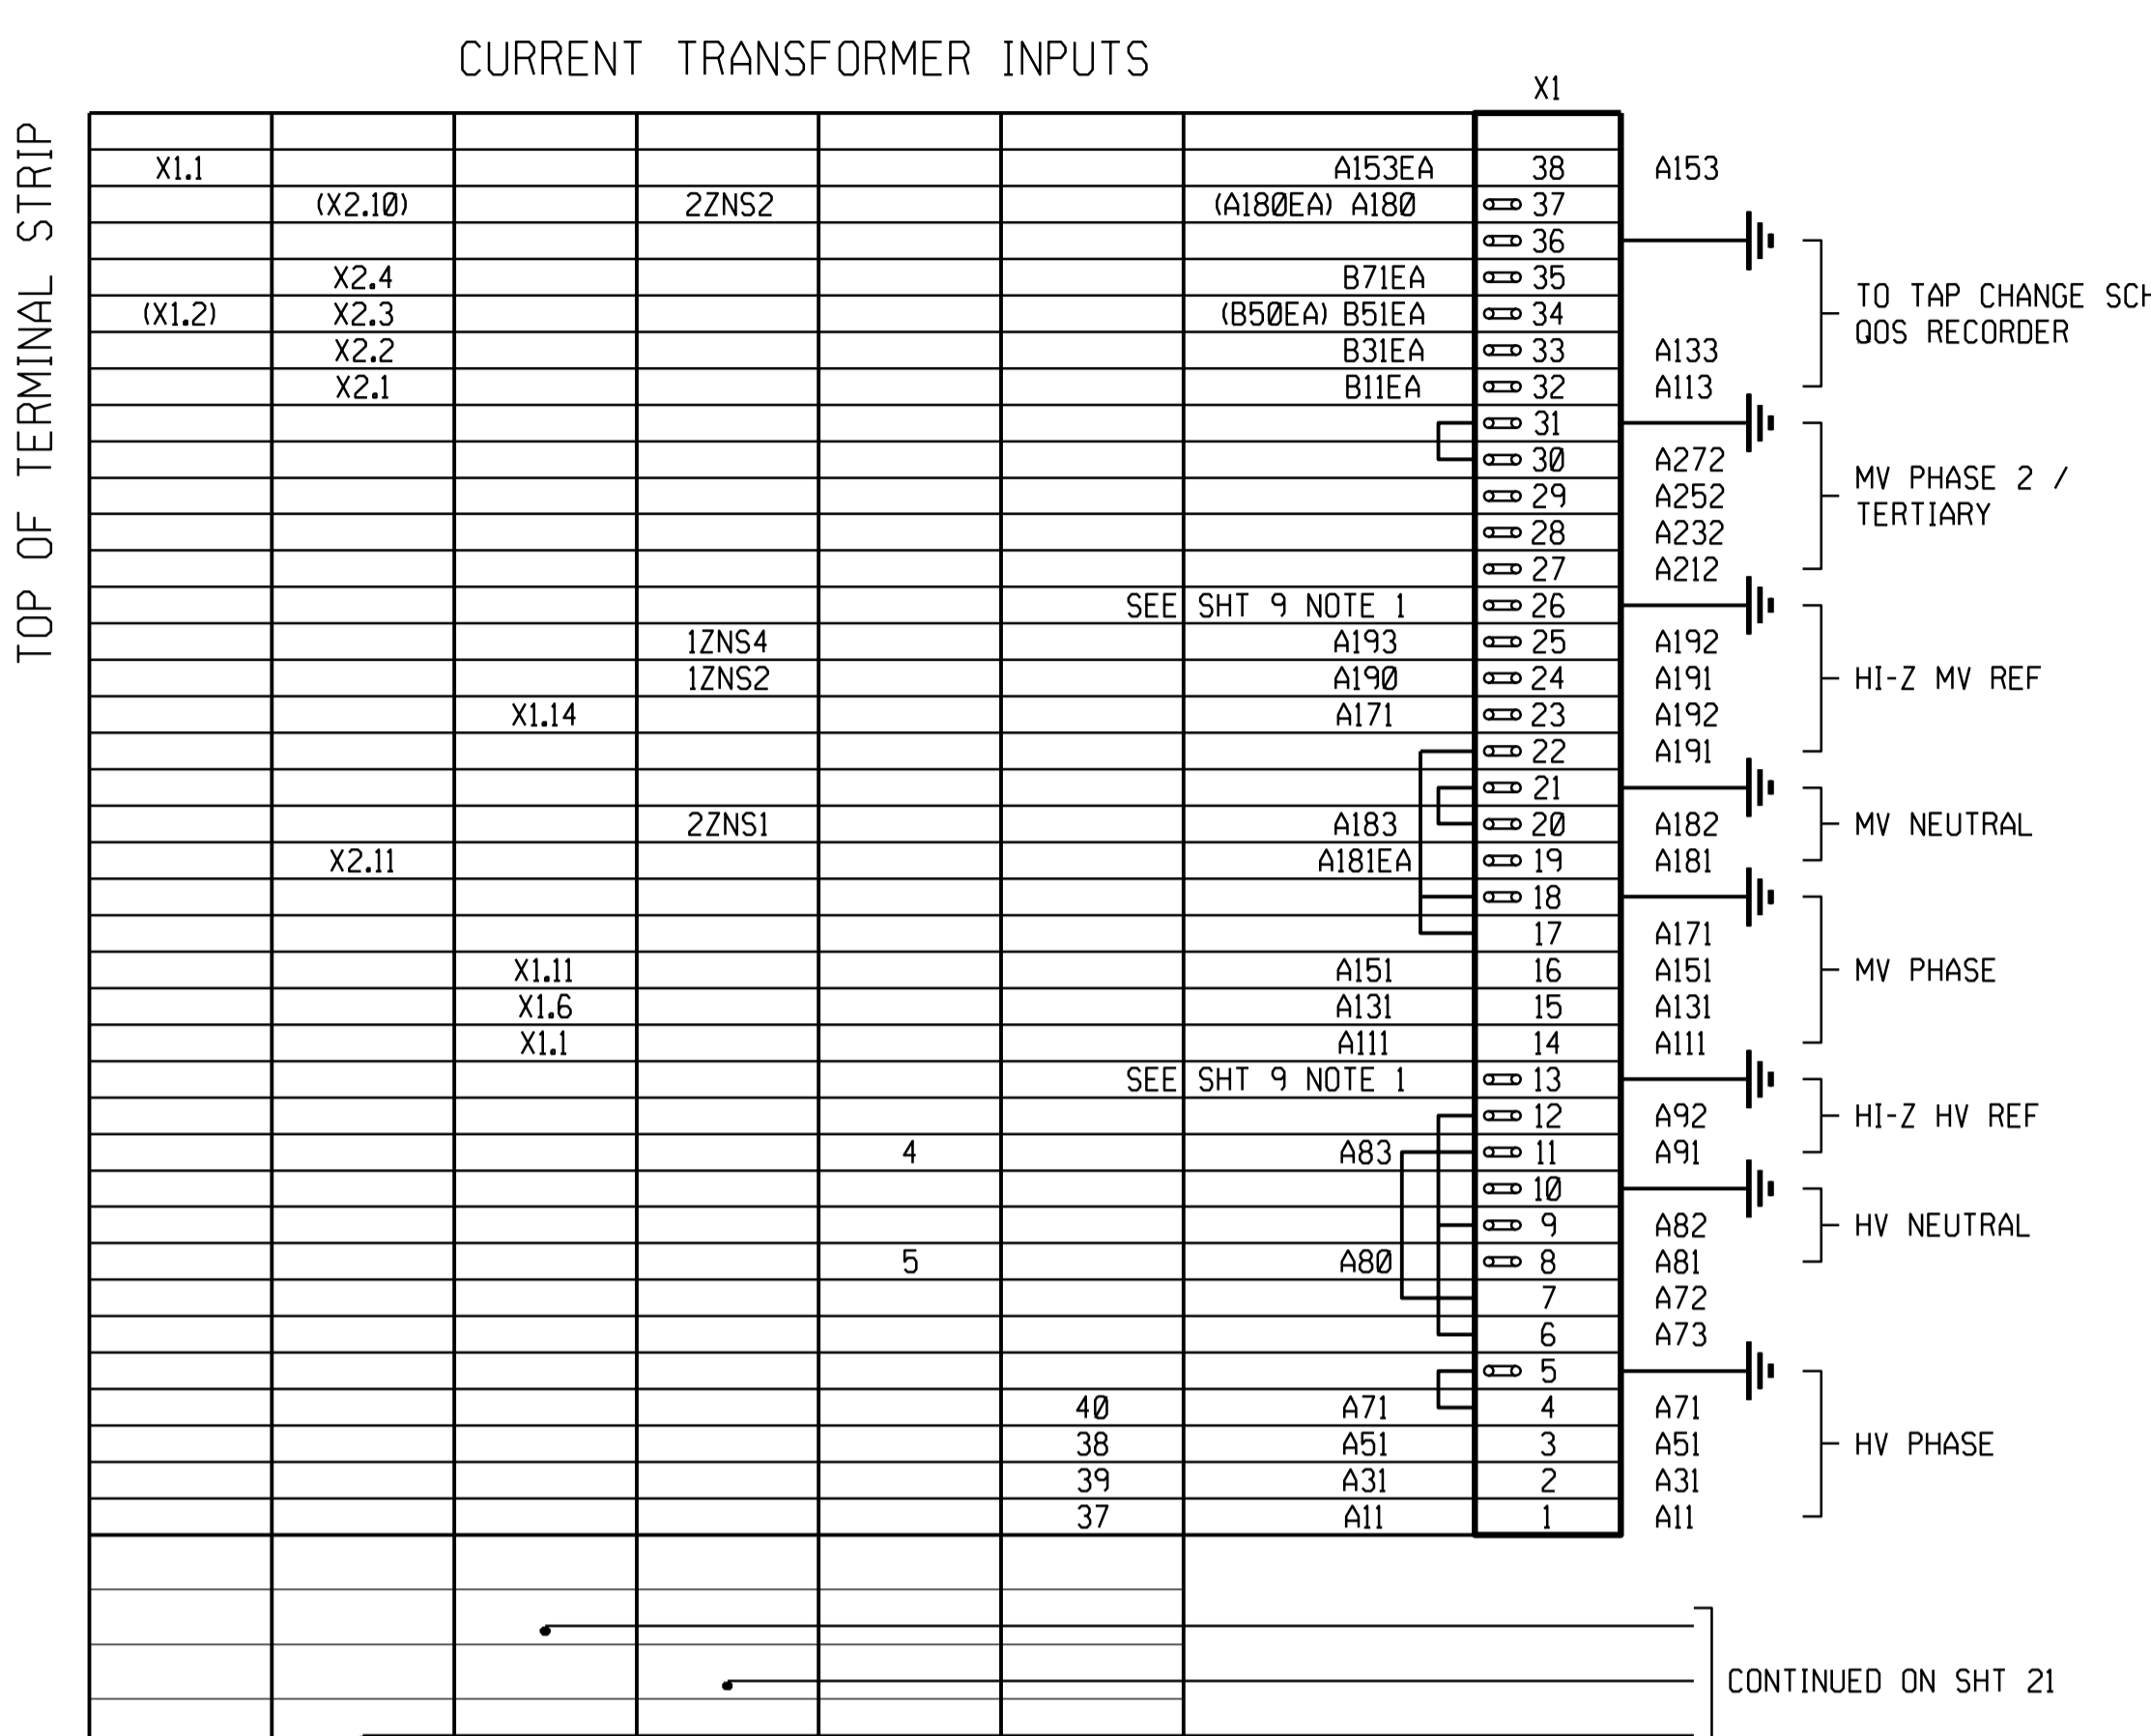

EA522	EA508	EA506	EA514	EA512	EA504	CABLE NUMBER
12	19	19	12	12	12	CABLE SIZE
4	3	4	5	10	8	NUMBER OF SPARES
OLT C PANEL 66/11 kV TRFR 1 OLT C RACK	11 kV BUS PROTECTION PANEL	11 kV BREAKER MECH BOX RT TERMINALS	NECRT	TRANSFORMER MIB	66 kV CT JUNCTION BOX	DESTINATION


EA522	EA508	EA506	EA514	EA512	EA504	CABLE NUMBER
29	28					CABLE SIZE
0	0					NUMBER OF SPARES
11 kV FEEDER 10 RELAY PANEL (LOOP CABLE)	11 kV BUSBAR 1A 11 kV VT RT (LOOP CABLE)					DESTINATION

LOOPED TERMINALS

66 kV CT JB	40-41-42; 43-44-45-46-47-48-EARTH; 49-50-51-52-53-54-EARTH; 58-59-60; 61-62-62-64-65-66-EARTH; 67-68-69-70-71-72-EARTH;
MIB	1-18-7-261-6-4-5-263; 11-10; 262-264-8-9;
NECRT	K1-K3-K5-L1-L3; K2-K4-K6; L2-L4
11 kV BKR MB RT TERMINALS	X1.4-X1.9-X1.14; X1.17-X1.20-X1.21-X1.24-X1.25-X1.28-X1.29-EARTH; X1.33-X1.37-X1.41; X2.15-X2.9; X2.10-X2.31; X2.5-X2.32; X3.9-X2.41-X2.33-X3.13; X2.47-X2.27;
66 kV LINE ISOLATOR	X1.50-X1.24;

- NOTES:**
- (2) INDICATES TWO LEADS IN PARALLEL.
 - SPARE CABLE LEADS TO BE LEFT LONG ENOUGH TO REACH THE FURTHEST TERMINAL.
 - LEAD NUMBERS SHOWN THUS
P7 INDICATES NO CHANGE IN LEAD NUMBER.
P7 P7A INDICATES CHANGE IN LEAD NUMBER.
 - SEE CABLE BLOCK DIAGRAM FOR PREFIXING.
 - SLIDING LINK TERMINALS ARE TO BE ORIENTED SUCH THAT THE LINK FALLS/REMAINS CLOSED WHEN THE SECURING SCREW IS LOOSENED.
- UNLESS INDICATED OTHERWISE, STANDARD TERMINALS: ENTRELEC M10/10.RS
ENTRELEC D6/8-ST1-RS SLIDING LINK TEST TERMINAL

NOTE: * INDICATES TERMINAL NUMBER TO BE DETERMINED ON SITE.

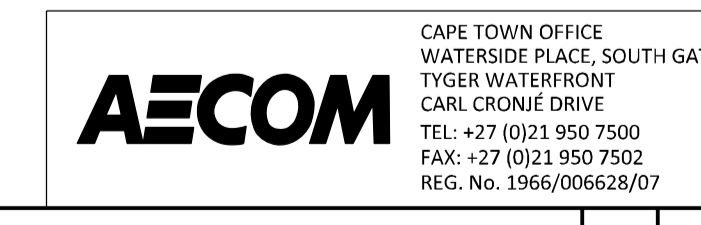

ISCOR SUBSTATION
66/11 kV TRANSFORMER 1
PANEL CABLING DIAGRAM

D-WC-7104

SET NUMBER	SHEET NUMBER	REVISION
81	20	2

PANEL TYPE DESIGNATION 4TM710MOD.F.ZD SIZE 0000TTE A1L

MASTER TRACING FILED UNDER D-DT-15202 SHEET 20 OF 26 REVISION 1

SHEET 25	RED670 REFERENCE DIAGRAM
SHEET 24	RED670 AC/DC & SUP. KEY DIAGRAM
SHEET 23	HV CT JB CABLING DIAGRAM
SHEET 22	PANEL CABLING DIAGRAM
SHEET 21	PANEL CABLING DIAGRAM
SHEET 20	PANEL CABLING DIAGRAM
SHEET 19	REFERENCE DIAGRAM
SHEET 18	SUPERVISORY/COMMS KEY DIAG
SHEET 17	SPR REV DC AC KEY DIAGRAM
SHEET 16	BACK-UP DC KEY DIAGRAM
SHEET 15	BACK-UP DC KEY DIAGRAM
SHEET 14	BACK-UP DC KEY DIAGRAM
SHEET 13	MAIN DC KEY DIAGRAM
SHEET 12	MAIN DC KEY DIAGRAM
SHEET 11	VT SUPPLY KEY DIAGRAM
SHEET 10	AC KEY DIAGRAM
SHEET 9	AC KEY DIAGRAM
SHEET 8	AC KEY DIAGRAM
SHEET 7	RELAY LOGIC DIAGRAM
SHEET 6	RELAY LOGIC DIAGRAM
SHEET 5	RELAY LOGIC DIAGRAM
SHEET 4	RELAY LOGIC DIAGRAM
SHEET 3	SCHEME LOGIC DIAGRAM
SHEET 2	FRONT PANEL LABELS
SHEET 1	PANEL EQUIPMENT LAYOUT
SHEET 0	COVER SHEET

2	66 kV VT ADDED.	KS	BH	C.PYM	25/06/2021	
1	AS BUILT SITE MODIFICATIONS IMPLEMENTED.	AVS	KRR	C.KING	18/02/2015	3487A
0	FIRST ISSUE. SUBSTATION REFURBISHED.				/ /	3487A

REV	DESCRIPTION	BY	CHKD	AUTH	DATE	PROJECT NUMBER
1	CHANGES AS PER SHEET 0 - COVER SHEET.	SvZ			15/11/2010	
2	REVISION TO MASTER					

PROJECT APPROVED	DESIGN APPROVED
C. PYM	S.J. van ZYL
DATE 25/06/21	DATE 11/06/10
PROJECT CHECKED	DESIGN CHECKED
B. HOMANN	P.A. GERBER
DATE 25/06/21	DATE 11/06/10
DRAWN BY	DRAWN BY
K. STEYNBERG	S.J. van ZYL
DATE 15/11/2010	DATE 25/06/21
DATE 25/06/21	DATE 17/09/09

MV CIRCUIT-BREAKER & ISOLATORS, CUST MTR, BUS ZONE.

TERMINAL	DESCRIPTION	TERMINAL	DESCRIPTION	TERMINAL	DESCRIPTION
	X1.44		X2.11		K7EA
	X2.50				P117EA
	X2.49				P107EA
	X1.24/X1.30				K113EA
	X1.23/X1.29				K101EA
					K101
			X2.4		M102B
			X2.3		M101B
					K359A
			X2.28		
					K355
			X2.48		K353
			X2.47		K301
					K315
					K301
			X3.15		K347
			X3.14		K345
					K301
			X2.32		K343
			X2.42		K341
					K301
			X3.10		K339
			X3.9		K301
					K337
			X2.16		K301
			X2.15		K101
			X2.12		K384A
					K383EA
			X2.63		K309A
			X2.8		K302A
			X2.7		K307A
			X2.61		K109A
			X2.6		K102A
			X2.5		K107A

- SPARE
- P117
- P107
- K113
- K101
- P17
- P7
- K111
- K101
- M102
- M101
- K359
- K355
- K353
- K301
- K315
- K301
- K347
- K345
- K301
- K343
- K341
- K301
- K339
- K301
- K337
- K301
- K102
- K101
- K384
- K383
- K309
- K302
- K307
- K109
- K102
- K107

SCADA ALARM & COMMS

TERMINAL	DESCRIPTION	TERMINAL	DESCRIPTION	TERMINAL	DESCRIPTION
					X20
					X19
					X18
					X17
					X16
					X15
					X14
					X13
					X12
					X11
					X10
					X9
					X8
					X7
					X6
					X5
					X4
					X3
					X2
					X1

- SPARE
- RED670 RS-485 SEE SHEET 18
- IRIG-B TIME SYNCH INPUT
- RS-485 REMOTE ACCESS
- RS-485/DNP3 SCADA COMMS
- PNH SCADA ALARM

TERMINAL STRIP TO BE MODIFIED BY ESKOM.

TERMINAL	DESCRIPTION	TERMINAL	DESCRIPTION
			X34
			X33
			X32
			X31
			X30
			X29
			X28
			X27
			X26
			X25
			X24
			X23
			X22
			X21
			X20
			X19
			X18
			X17
			X16
			X15
			X14
			X13
			X12
			X11
			X10
			X9
			X8
			X7
			X6
			X5
			X4
			X3
			X2
			X1

TERMINAL	DESCRIPTION	TERMINAL	DESCRIPTION	TERMINAL	DESCRIPTION
					X7.5
					X7.4
					X7.3
					X7.8
					X7.7
					X7.6
					X7.2
					X7.1

AC SUPPLIES

TERMINAL	DESCRIPTION	TERMINAL	DESCRIPTION	TERMINAL	DESCRIPTION
					X10
					X9
					X8
					X7
					X6
					X5
					X4
					X3
					X2
					X1

- MIB HEATER
- MV CB HEATER
- HV CB HEATER
- AC SUPPLIES

TERMINAL	DESCRIPTION	TERMINAL	DESCRIPTION	TERMINAL	DESCRIPTION
					X6
					X5
					X4
					X3
					X2
					X1

- MIB HEATER
- MV CB HEATER
- HV CB HEATER
- AC SUPPLIES

- NOTES:
- (2) INDICATES TWO LEADS IN PARALLEL.
 - SPARE CABLE LEADS TO BE LEFT LONG ENOUGH TO REACH THE FURTHEST TERMINAL.
 - LEAD NUMBERS SHOWN THUS
P7 INDICATES NO CHANGE IN LEAD NUMBER.
P7 P7A INDICATES CHANGE IN LEAD NUMBER.
 - SEE CABLE BLOCK DIAGRAM FOR PREFIXING.
 - SLIDING LINK TERMINALS ARE TO BE ORIENTED SUCH THAT THE LINK FALLS/REMAINS CLOSED WHEN THE SECURING SCREW IS LOOSENEED.
TERMINAL DISCONNECTORS ARE TO PIVOT FROM THE BOTTOM SIDE OF THE TERMINAL RAIL.

UNLESS INDICATED OTHERWISE, STANDARD TERMINALS: ENTRELEC M10/10.RS
 ▽ ENTRELEC D6/8-ST1-RS SLIDING LINK TEST TERMINAL
 ⊗ ENTRELEC M4/6.SNTS SPRING LOADED TERMINAL WITH DISCONNECTOR



CAPE TOWN OFFICE
 WATERSIDE PLACE, SOUTH GATE
 TYGER WATERFRONT
 CARL CRONJE DRIVE
 TEL: +27 (0)21 950 7500
 FAX: +27 (0)21 950 7502
 REG. No. 1966/006628/07

REV	REVISION DESCRIPTION	BY	CHKD	AUTH	DATE	PROJECT NUMBER
2	66kV VT ADDED.	KS	BH	C.PYM	25/06/2021	
1	AS BUILT SITE MODIFICATIONS IMPLEMENTED.	AVS	KRR	C.KING	18/02/2015	3487A
0	FIRST ISSUE. SUBSTATION REFURBISHED.				/ /	3487A

PROJECT APPROVED	DESIGN APPROVED
C. PYM	S.J. van ZYL
DATE 25/06/21	DATE 11/06/10
PROJECT CHECKED	DESIGN CHECKED
B. HOMANN	P.A. GERBER
DATE 25/06/21	DATE 11/06/10
DRAWN BY	DRAWN BY
K. STEYNBERG	S.J. van ZYL

ISCOR SUBSTATION
 66/11 kV TRANSFORMER 1
 PANEL CABLING DIAGRAM

REV	AUTH	DATE	REVISION TO MASTER	BY	CHKD	SCALE
1	SvZ	15/11/2010	CHANGES AS PER SHEET 0 - COVER SHEET.	SvZ	PAG	DATE 25/06/21 DATE 17/09/09


SET NUMBER	SHEET NUMBER	REVISION
D-WC-7104	81	22
		2

SHEET	DESCRIPTION
25	RED670 REFERENCE DIAGRAM
24	RED670 AC/DC & SUP. KEY DIAGRAM
23	HV CT JB CABLING DIAGRAM
22	PANEL CABLING DIAGRAM
21	PANEL CABLING DIAGRAM
20	PANEL CABLING DIAGRAM
19	REFERENCE DIAGRAM
18	SUPERVISORY/COMMS KEY DIAG
17	SPR REV DC, AC KEY DIAGRAM
16	BACK-UP DC KEY DIAGRAM
15	BACK-UP DC KEY DIAGRAM
14	BACK-UP DC KEY DIAGRAM
13	MAIN DC KEY DIAGRAM
12	MAIN DC KEY DIAGRAM
11	VT SUPPLY KEY DIAGRAM
10	AC KEY DIAGRAM
9	AC KEY DIAGRAM
8	AC KEY DIAGRAM
7	RELAY LOGIC DIAGRAM
6	RELAY LOGIC DIAGRAM
5	RELAY LOGIC DIAGRAM
4	RELAY LOGIC DIAGRAM
3	SCHEME LOGIC DIAGRAM
2	FRONT PANEL LABELS
1	PANEL EQUIPMENT LAYOUT
0	COVER SHEET

NOTE: * INDICATES TERMINAL NUMBER TO BE DETERMINED ON SITE.

MASTER TRACING FILED UNDER D-DT-15202 SHEET 22 OF 26 REVISION 1

TOP OF TERMINAL STRIP

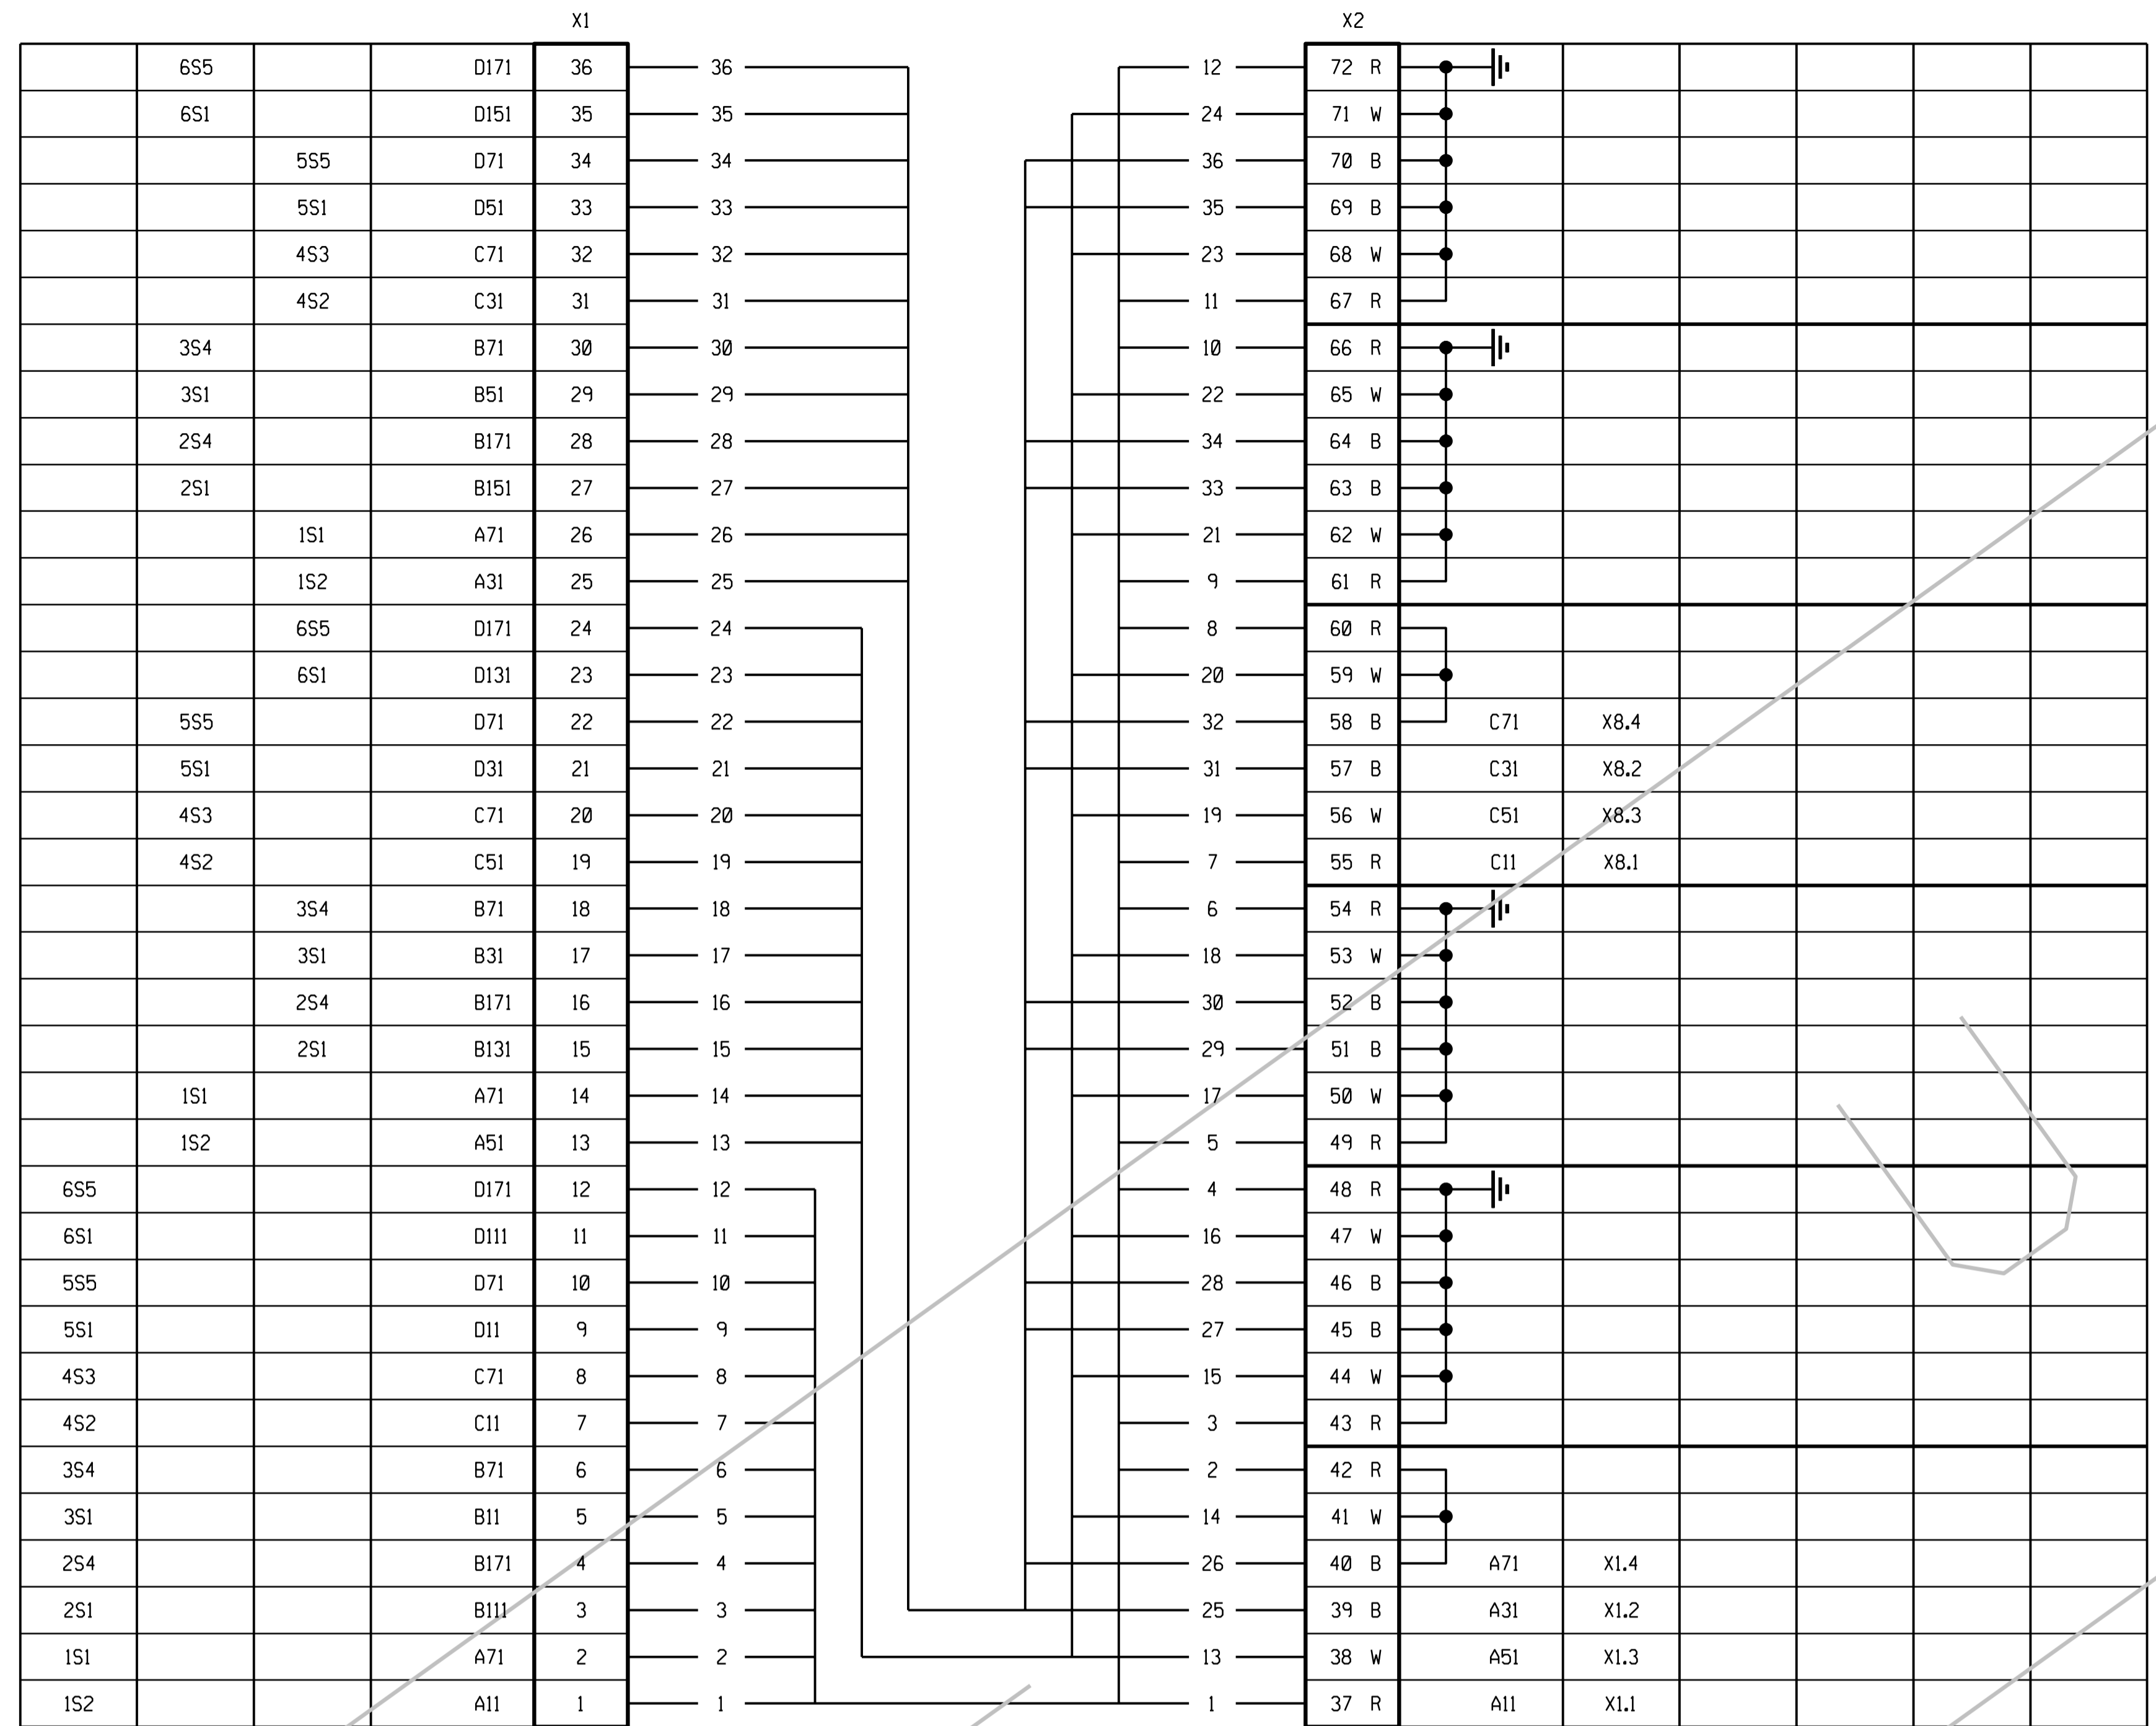

NOTE : ALL SPARE CABLE CORES TO BE EARTHED ON ONE END ONLY.
NOTE: USE JUNCTION BOX VRW 6 CORE CT INSERT DRG D-DT-5404

EB501	EB502	EB503	CABLE NUMBER
12	12	12	CABLE SIZE
0	0	0	NUMBER OF SPARES
			DESTINATION

CABLE NUMBER	EA504
CABLE SIZE	12
NUMBER OF SPARES	4
	DESTINATION



REV	REVISION DESCRIPTION	BY	CHKD	AUTH	DATE	PROJECT NUMBER
2	66kV VT ADDED.	KS	BH	C.PYM	25/06/2021	
1	AS BUILT SITE MODIFICATIONS IMPLEMENTED.	AVS	KRR	C.KING	18/02/2015	3487A
0	FIRST ISSUE. SUBSTATION REFURBISHED.	/	/	/	/	3487A



ISCOR SUBSTATION
66/11 kV TRANSFORMER 1
HV CT JB CABLING DIAGRAM

PROJECT APPROVED	DESIGN APPROVED						
C. PYM	S.J. van ZYL						
DATE 25/06/21	DATE 11/06/10						
PROJECT CHECKED	DESIGN CHECKED						
B. HOMANN	P.A. GERBER						
DATE 25/06/21	DATE 11/06/10						
DRAWN BY	DRAWN BY						
K. STEYNBERG	S.J. van ZYL						
DATE 25/06/21	DATE 17/09/09						
REV	AUTH	DATE	CHANGES AS PER SHEET 0 - COVER SHEET.	SvZ	PAG	DATE 25/06/21	DATE 17/09/09
1	SvZ	15/11/2010	CHANGES AS PER SHEET 0 - COVER SHEET.	SvZ	PAG	DATE 25/06/21	DATE 17/09/09
			REVISION TO MASTER	BY	CHKD	SCALE	

D-WC-7104	SET NUMBER	SHEET NUMBER	REVISION
D-WC-7104	81	23	2

SHEET 25	RED670 REFERENCE DIAGRAM
SHEET 24	RED670 AC/DC & SUP. KEY DIAGRAM
SHEET 23	HV CT JB CABLING DIAGRAM
SHEET 22	PANEL CABLING DIAGRAM
SHEET 21	PANEL CABLING DIAGRAM
SHEET 20	PANEL CABLING DIAGRAM
SHEET 19	REFERENCE DIAGRAM
SHEET 18	SUPERVISORY/COMMS KEY DIAG
SHEET 17	SPR REV DC, AC KEY DIAGRAM
SHEET 16	BACK-UP DC KEY DIAGRAM
SHEET 15	BACK-UP DC KEY DIAGRAM
SHEET 14	BACK-UP DC KEY DIAGRAM
SHEET 13	MAIN DC KEY DIAGRAM
SHEET 12	MAIN DC KEY DIAGRAM
SHEET 11	VT SUPPLY KEY DIAGRAM
SHEET 10	AC KEY DIAGRAM
SHEET 9	AC KEY DIAGRAM
SHEET 8	AC KEY DIAGRAM
SHEET 7	RELAY LOGIC DIAGRAM
SHEET 6	RELAY LOGIC DIAGRAM
SHEET 5	RELAY LOGIC DIAGRAM
SHEET 4	RELAY LOGIC DIAGRAM
SHEET 3	SCHEME LOGIC DIAGRAM
SHEET 2	FRONT PANEL LABELS
SHEET 1	PANEL EQUIPMENT LAYOUT
SHEET 0	COVER SHEET
	REFERENCE DRAWINGS:

