



GEYSER REF. No.	G-1	G-2	G-3
QTY	2	11	7
TYPE OF UNIT	HORIZONTAL GEYSER	HORIZONTAL GEYSER	HORIZONTAL GEYSER
SIZE (L)	100	150	200
ELEMENT SIZE (kW)	2.8	3.0	4.0
ELECTRICAL POWER SUPPLY	230V/1ϕ0	230V/1ϕ0	230V/1ϕ0

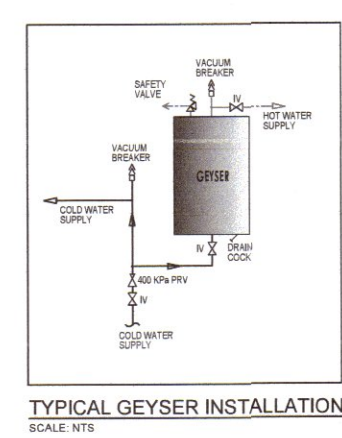

TYPICAL GEYSER INSTALLATION
SCALE: NTS

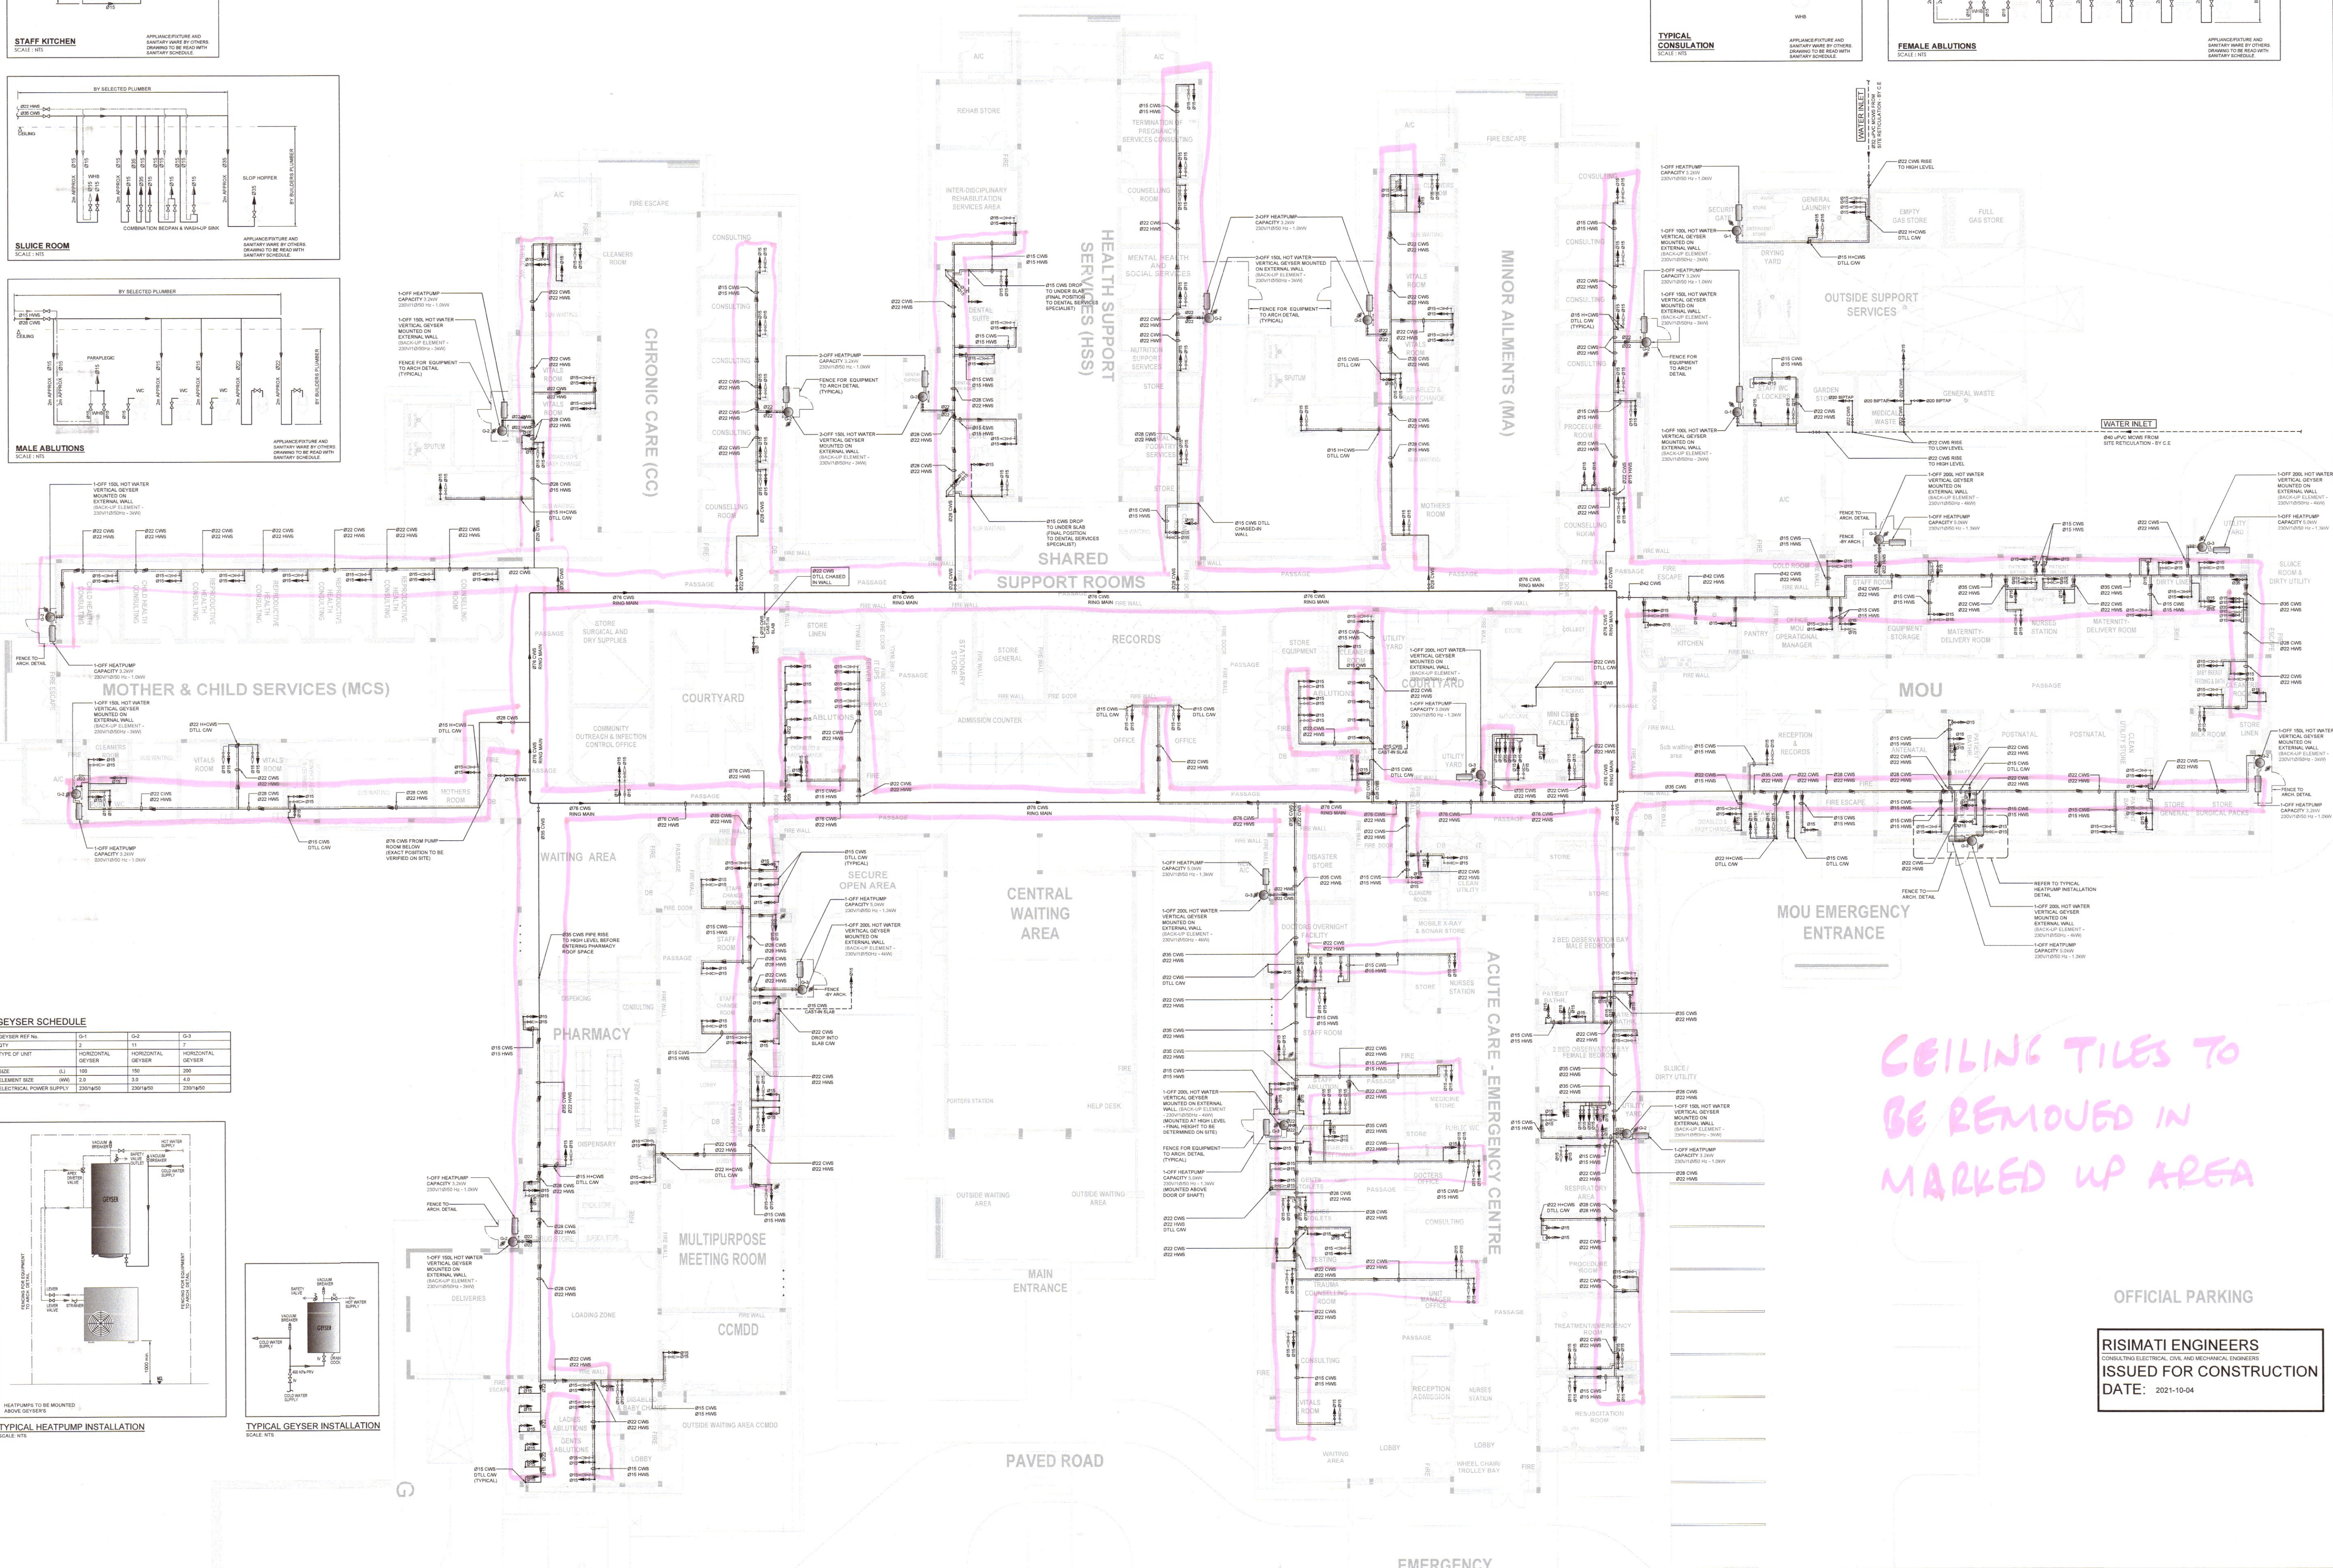

CEILING TILES TO
BE REMOVED IN
MARKED UP AREA

OFFICIAL PARKING

RISIMATI ENGINEERS
CONSULTING ELECTRICAL, CIVIL AND MECHANICAL ENGINEERS
ISSUED FOR CONSTRUCTION
DATE: 2021-10-04

[illegible]